

**MOORE PUBLIC SCHOOLS -
CENTRAL JUNIOR HIGH SCHOOL –
STEM CLASSROOM ADDITION**


Moore Public Schools - Moore, Oklahoma
AGP - Moore, Oklahoma

CONSTRUCTION BULLETIN NO. 6

January 22, 2026

1. CLARIFIED / REVISED NEW / EXISTING WATERLINE SERVICE AT EAST SIDE OF EXISTING BUILDING AND NEW ADDITION AS PER ATTACHED REVISED SHEETS C1.00, C2.00, AND C5.00 INCLUDING NEW WATER METER.
2. REVISED REFLECTED PLAN SHEETS A107 AND A108 AS INDICATED ADDING LIGHT FIXTURES, GRILLS AND REGISTERS, ETC. CM SHALL COORDINATE WITH THE APPLICABLE CONSULTANTS AND THE ARCHITECT TO CONFIRM ALL ITEMS AS PER THE CONTRACT DOCUMENTS AND APPLICABLE ADDENDUMS ARE NOTED AND PROVIDED.
3. CLARIFIED / REVISED WATER SERVICE TO EXISTING BUILDING AND NEW ADDITION AS PER THE ATTACHED REVISED PLUMBING DRAWINGS P101, P102, P110, P111, AND P302.

END OF CONSTRUCTION BULLETIN NO. 6

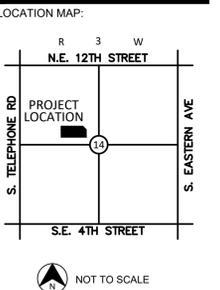

CENTRAL JUNIOR HIGH CLASSROOM ADDITION

400 N. BROADWAY ST.
 MOORE, OKLAHOMA

PROJECT NUMBER: 25031
 DRAWING DATE: 06.02.25
 ISSUE DATE: 06.02.25

SEAL:



SUBMITAL:

PERMIT SET

REVISIONS:

01.22.25 CB # 6

MARK DATE DESCRIPTION

THESE PLANS AND DRAWINGS ARE NOT TO BE REPRODUCED, CHANGED OR COPIED IN ANY FORM OR MANNER WHATSOEVER WITHOUT FIRST OBTAINING THE WRITTEN PERMISSION AND CONSENT OF CEDAR CREEK CONSULTING INC. THIS SHEET IS NOT TO BE USED FOR CONSTRUCTION UNLESS THE ISSUE DATE IN THE TITLE BLOCK COINCIDES WITH OR POST DATES THE DRAWING DATE. ANY CHANGES MADE FROM THESE PLANS WITHOUT CONSENT OF CEDAR CREEK CONSULTING INC. ARE UNAUTHORIZED AND SHALL RELIEVE CEDAR CREEK CONSULTING OF RESPONSIBILITY FOR ALL CONSEQUENCES ARISING OUT OF SUCH CHANGES.

DRAWING TITLE:

DEMOLITION PLAN

SHEET:

C1.00


LEGEND

---	EXISTING 1' CONTOUR	---	EXISTING 5' CONTOUR
---	PROPOSED 1' CONTOUR	---	PROPOSED 5' CONTOUR
---	BOUNDARY LINE	---	RIGHT OF WAY LINE
---	EASEMENT LINE	---	EXISTING CURB AND GUTTER
---	PROPOSED CURB AND GUTTER	---	PROPOSED FIRE LANE STRIPING
---	OVERHEAD ELECTRIC LINE	---	UNDERGROUND ELECTRIC LINE
---	GAS LINE	---	UNDERGROUND TELEPHONE LINE
---	UNDERGROUND FIBER OPTIC LINE	---	SANITARY SEWER LINE
---	WATERLINE	---	RETAINING WALL
---	SCREEN WALL	---	WIRE FENCE
---	CHAIN LINK FENCE	---	BENCHMARK
---	PROP. FIRE HYDRANT	---	PROP. WHEEL STOP
---	PROP. WATER VALVE	---	PROP. FES
---	PROP. WATER METER	---	PROP. HC RAMP
---	PROP. ELECT. METER	---	PROP. POWER POLE
---	PROP. LIGHT POLE	---	PROP. SS MANHOLE
---	PROP. BOLLARD	---	PROP. GAS METER
---	PROP. TRANSFORMER	---	PROP. SIGN
---	PROP. PARKING COUNT	---	PROP. FIRE ROUTE SIGN
---	PROP. INLETS (SEE GRADING PLAN FOR TYPE)		
---	VERTICAL SEPARATION REQUIREMENT		

*NOTE: REFER TO SURVEYING LEGEND FOR EXISTING STRUCTURES IDENTIFICATION

DEMOLITION NOTES

- THE CONTRACTOR SHALL ABIDE BY ALL FEDERAL, STATE AND LOCAL CODES FOR THE DEMOLITION AND DISPOSAL OF ALL MATERIALS.
- CEDAR CREEK CONSULTING, INC. SHALL NOT BE LIABLE FOR ANY DEMOLITION PROCEDURES, SCHEDULING, AND DISPOSING OF ANY MATERIALS.
- IT SHALL BE THE RESPONSIBILITY OF THE CONTRACTOR TO MAKE SURE THAT THE PROPERTY IS NOT DAMAGED AND IS ACCESSIBLE AT ALL TIMES, AND THAT CONSTRUCTION DOES NOT CREATE ANY HARDSHIP TO LAND OWNERS.
- THE CONTRACTOR IS RESPONSIBLE FOR THE DEMOLITION, REMOVAL, AND DISPOSING IN A LOCATION APPROVED BY ALL GOVERNING AUTHORITIES, OF ALL STRUCTURES, PADS, WALLS, FLUMES, FOUNDATIONS, PARKING, DRIVES, DRAINAGE, UTILITIES, ETC., SUCH THAT THE IMPROVEMENTS SHOWN ON THE REMAINING PLANS CAN BE CONSTRUCTED. ALL FACILITIES TO BE REMOVED SHALL BE UNDERCUT TO SUITABLE MATERIAL AND BROUGHT TO GRADE WITH SUITABLE COMPACTED FILL MATERIAL PER THE SPECIFICATIONS.
- THE CONTRACTOR SHALL COORDINATE WITH RESPECTIVE UTILITY COMPANIES PRIOR TO THE DISCONNECTION, REMOVAL AND RELOCATION OF ALL UTILITIES. THE CONTRACTOR SHALL COORDINATE WITH THE UTILITY COMPANY CONCERNING PORTIONS OF WORK WHICH MAY BE PERFORMED BY THE UTILITY COMPANY'S FORCES AND ANY FEES WHICH ARE TO BE PAID TO THE UTILITY COMPANY FOR SERVICES. THE CONTRACT IS RESPONSIBLE FOR PAYING ALL FEES AND CHARGES.
- THE CONTRACTOR IS RESPONSIBLE FOR REMOVING EXISTING IRRIGATION SYSTEM IN THE AREAS OF PROPOSED IMPROVEMENTS. THE CONTRACTOR SHALL CAP THE EXISTING IRRIGATION SYSTEM TO REMAIN SUCH THAT THE REMAINING SYSTEM SHALL CONTINUE TO FUNCTION PROPERLY.
- THE LOCATIONS OF ALL EXISTING UTILITIES SHOWN ON THIS PLAN HAVE BEEN DETERMINED FROM THE BEST INFORMATION AVAILABLE AND ARE GIVEN FOR THE CONVENIENCE OF THE CONTRACTOR. THE ENGINEER ASSUMES NO RESPONSIBILITY FOR THEIR ACCURACY. PRIOR TO THE START OF ANY DEMOLITION ACTIVITY, THE CONTRACTOR SHALL NOTIFY THE UTILITY COMPANIES FOR ONSITE LOCATIONS OF EXISTING UTILITIES.
- ALL EXISTING SEWERS, PIPING AND UTILITIES SHOWN ARE NOT TO BE INTERPRETED AS THE EXACT LOCATION, OR AS THE ONLY OBSTACLES THAT MAY OCCUR ON THE SITE. VERIFY EXISTING CONDITIONS AND PROCEED WITH CAUTION AROUND ANY ANTICIPATED FEATURES. GIVE NOTICE TO ALL UTILITY COMPANIES REGARDING DESTRUCTION AND REMOVAL OF ALL SERVICE LINES AND CAP ALL LINES BEFORE PROCEEDING WITH WORK. UTILITIES DETERMINED TO BE ABANDONED AND LEFT IN PLACE SHALL BE GROUTED IF UNDER BUILDINGS.
- ELECTRICAL, TELEPHONE, CABLE, WATER, FIBER OPTIC CABLE AND/OR GAS LINES NEEDING TO BE REMOVED OR RELOCATED SHALL BE COORDINATED WITH THE AFFECTED UTILITY COMPANY. ADEQUATE TIME SHALL BE PROVIDED FOR RELOCATION AND CLOSE COORDINATION WITH THE UTILITY COMPANY IS NECESSARY TO PROVIDE A SMOOTH TRANSITION IN UTILITY SERVICE.
- THE CONTRACTOR MUST PROTECT THE PUBLIC AT ALL TIMES WITH FENCING, BARRICADES, ENCLOSURES, ETC.
- ALL EROSION CONTROL DEVICES ARE TO BE INSTALLED PRIOR TO DEMOLITION.
- THE CONTRACTOR MAY LIMIT SAW-CUT AND PAVEMENT REMOVAL TO ONLY THOSE AREAS WHERE IT IS REQUIRED AS SHOWN ON THE CONSTRUCTION PLANS BUT IF ANY DAMAGE IS INCURRED ON ANY OF THE SURROUNDING PAVEMENT, ETC., THE CONTRACTOR SHALL BE RESPONSIBLE FOR ITS REMOVAL AND REPAIR.
- THE CONTRACTOR SHALL MAINTAIN ALL EXISTING PARKING, SIDEWALKS, DRIVES, ETC. CLEAR AND FREE FROM ANY CONSTRUCTION ACTIVITY INCLUDING FENCING AND CONSTRUCTION TRAILER AND/OR MATERIAL TO ENSURE EASY AND SAFE PEDESTRIAN AND VEHICULAR TRAFFIC TO AND FROM THE SITE.
- THE CONTRACTOR SHALL COORDINATE WATERMAIN WORK WITH THE FIRE DEPARTMENT, THE CITY UTILITY DEPARTMENT TO PLAN PROPOSED IMPROVEMENTS AND TO ENSURE ADEQUATE FIRE PROTECTION IS CONSTANTLY AVAILABLE TO THE SITE THROUGHOUT THIS SPECIFIC WORK AND THROUGH ALL PHASES OF CONSTRUCTION. CONTRACTOR WILL BE RESPONSIBLE FOR ARRANGING/PROVIDING ANY REQUIRED WATERMAIN SHUT-OFFS WITH THE CITY/COUNTY DURING CONSTRUCTION. ANY COSTS ASSOCIATED WITH WATERMAIN SHUT-OFFS WILL BE THE RESPONSIBILITY OF THE CONTRACTOR AND NO EXTRA COMPENSATION WILL BE PROVIDED.
- DAMAGE TO ALL EXISTING CONDITIONS TO REMAIN WILL BE REPLACED AT CONTRACTOR'S EXPENSE. REPAIRS SHALL RESTORE DAMAGED ITEMS TO EQUAL OR BETTER THAN EXISTING CONDITIONS. CONTRACTOR IS RESPONSIBLE FOR DOCUMENTING ALL EXISTING DAMAGE AND NOTIFYING THE CONSTRUCTION MANAGER PRIOR TO CONSTRUCTION START.
- ALL TRENCHES AND/OR EXCAVATED AREAS SHALL BE FILLED /TESTED IN ACCORDANCE WITH THE GEOTECHNICAL ENGINEERING REPORT.
- IF SEPTIC TANKS ARE FOUND PRESENT WITHIN THE LIMITS OF DISTURBANCE, THEY SHALL BE DISPOSED OF IN ACCORDANCE WITH LOCAL, STATE AND FEDERAL LAWS.
- IF THE CONTRACTOR FINDS ANY UNDERGROUND TANKS ON SITE, THEY SHALL CONTACT THE ENGINEER IMMEDIATELY.
- ALL WELLS SHALL BE CAPPED AND CLOSED IN ACCORDANCE WITH APPLICABLE STATE AND FEDERAL LAWS.
- ALL ITEMS WITHIN LIMITS OF DEMOLITION SHALL BE REMOVED UNLESS OTHERWISE NOTED.
- CONTRACTOR SHALL BEGIN CONSTRUCTION OF ANY LIGHT POLE BASES FOR RELOCATED LIGHT FIXTURES AND RELOCATION OF ELECTRICAL SYSTEM AS SOON AS DEMOLITION BEGINS. CONTRACTOR SHALL BE AWARE THAT INTERRUPTION OF POWER TO ANY LIGHT POLES OR SIGNS SHALL NOT EXCEED 24 HOURS.
- CONTRACTOR IS TO VERIFY LOCATION OF EXISTING IRRIGATION SYSTEM, VALVE BOXES, CONTROL BOXES, BACKFLOW PREVENTION DEVICES AND LIGHTING CONDUIT. IF DAMAGED THEY MUST BE REPAIRED AT CONTRACTOR'S EXPENSE.

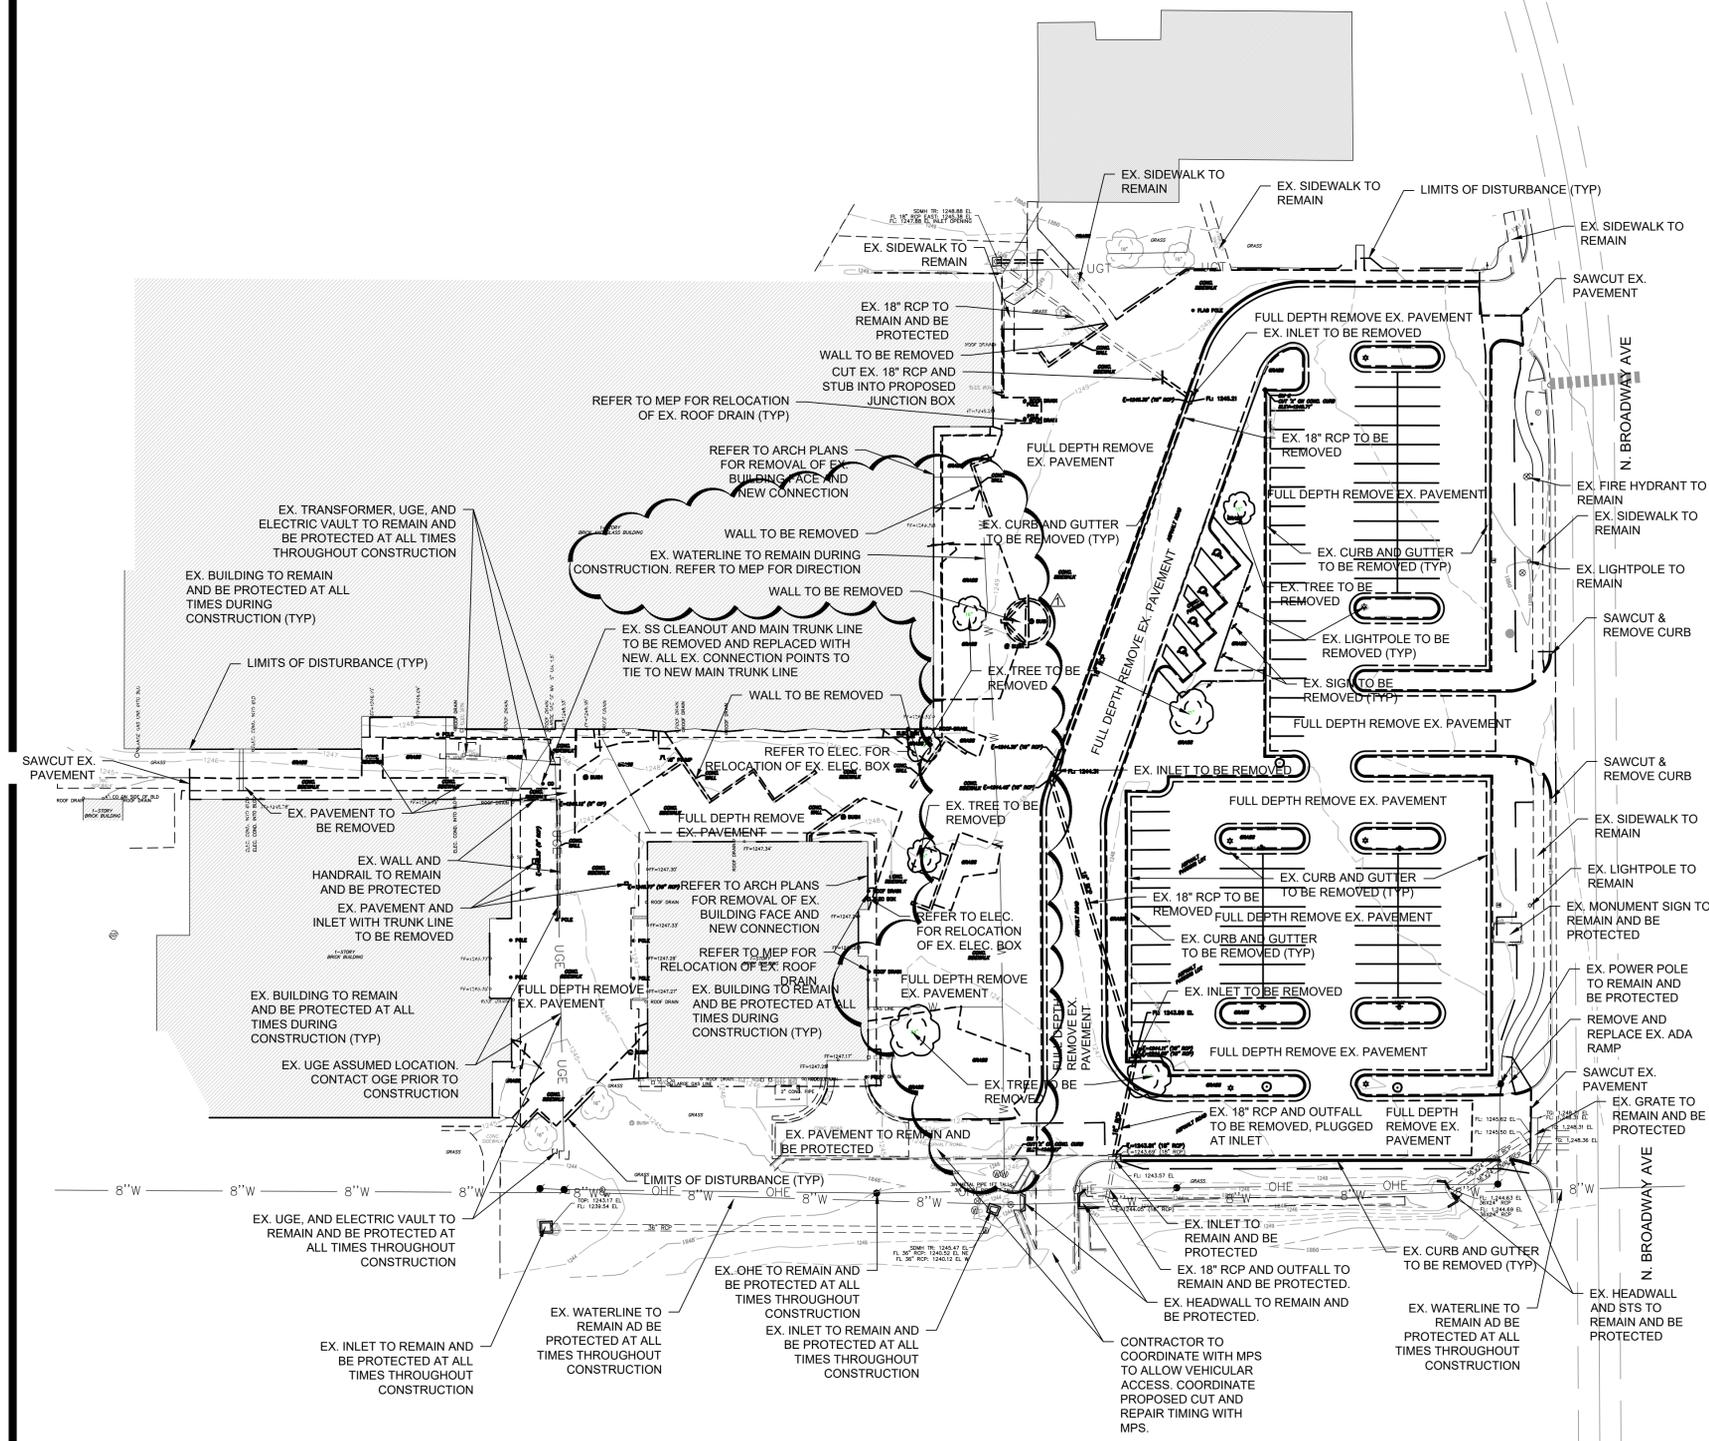


LEGEND

---	EXISTING 1' CONTOUR	---	EXISTING 5' CONTOUR
---	PROPOSED 1' CONTOUR	---	PROPOSED 5' CONTOUR
---	BOUNDARY LINE	---	RIGHT OF WAY LINE
---	EASEMENT LINE	---	EXISTING CURB AND GUTTER
---	PROPOSED CURB AND GUTTER	---	PROPOSED FIRE LANE STRIPING
---	OVERHEAD ELECTRIC LINE	---	UNDERGROUND ELECTRIC LINE
---	GAS LINE	---	UNDERGROUND TELEPHONE LINE
---	UNDERGROUND TELEPHONE LINE	---	UNDERGROUND FIBER OPTIC LINE
---	SANITARY SEWER LINE	---	WATERLINE
---	RETAINING WALL	---	SCREEN WALL
---	WIRE FENCE	---	CHAIN LINK FENCE
---	BENCHMARK	---	PROP. FIRE HYDRANT
---	PROP. FIRE HYDRANT	---	PROP. WHEEL STOP
---	PROP. WATER VALVE	---	PROP. FES
---	PROP. WATER METER	---	PROP. HC RAMP
---	PROP. ELECT. METER	---	PROP. POWER POLE
---	PROP. LIGHT POLE	---	PROP. SS MANHOLE
---	PROP. BOLLARD	---	PROP. GAS METER
---	PROP. TRANSFORMER	---	PROP. SIGN
---	PROP. PARKING COUNT	---	PROP. FIRE ROUTE SIGN
---	PROP. INLETS (SEE GRADING PLAN FOR TYPE)	---	
---	VERTICAL SEPARATION REQUIREMENT	---	

SITE NOTES

- A. CONTRACTOR SHALL REFER TO THE CONSTRUCTION DOCUMENTS INCLUDING BUT NOT LIMITED TO THE WRITTEN SPECIFICATIONS, CONSTRUCTION DRAWINGS, STORM WATER POLLUTION PLAN, AND GEOTECHNICAL REPORT.
- B. ALL CONSTRUCTION SHALL BE IN STRICT ACCORDANCE WITH THE OWNERS DESIGN GUIDELINES AND SPECIFICATIONS, AND WHERE APPLICABLE SHALL MEET THE REQUIREMENTS OF THE GOVERNING/PERMITTING AUTHORITY HAVING JURISDICTION.
- C. CONTRACTOR IS RESPONSIBLE FOR THEIR OWN HORIZONTAL AND VERTICAL CONTROL, REFERENCE POINTS AND CONSTRUCTION STAKING AS INCIDENTAL TO THE PROJECT.
- D. THE CONTRACTOR SHALL FIELD VERIFY EXISTING ELEVATIONS/PROPERTY LINES/UTILITIES/DRAINAGE PRIOR TO CONSTRUCTION START.
- E. ALL WORK NOT CLASSIFIED AS A CONTRACT PAY ITEM SHALL BE CONSIDERED AS INCIDENTAL AND THE COST THEREOF SHALL BE INCLUDED IN THE UNIT PRICE BID FOR ITEMS WHICH ARE CLASSIFIED FOR PAYMENT.
- F. CONTRACTOR SHALL REFER TO THE ARCHITECTURAL AND MEP PLANS AND SPECIFICATIONS BEING A PART OF THE CONSTRUCTION DOCUMENTS FOR THE EXACT LOCATIONS AND DIMENSIONS OF ENTRY, EXIT PORCHES, PRECISE BUILDING DIMENSIONS, EXACT BUILDING UTILITY ENTRANCE, AND DOWNSPOUT LOCATIONS/SPECIFICATIONS/DETAILS.
- G. ALL DIMENSIONS SHOWN ARE TO THE FACE OF CURB (FC) UNLESS OTHERWISE NOTED.
- H. PARKING LOT STRIPING SHALL BE 4" WIDE AND WHITE IN COLOR. HANDICAP PARKING STALLS STRIPING AND SIGNAGE SHALL BE IN STRICT ACCORDANCE WITH FEDERAL, STATE, AND LOCAL REQUIREMENTS.
- I. UNLESS OTHERWISE NOTED ALL RADII SHALL BE 3'.
- J. BUILDING DIMENSIONS ARE TO OUTSIDE OF MASONRY, UNLESS OTHERWISE SHOWN.
- K. CONTRACTOR SHALL REFER TO THE ARCHITECTURAL PLANS AND SPECIFICATIONS FOR ACTUAL LOCATION AND DETAILS OF ALL UTILITY ENTRANCES. CONTRACTOR SHALL COORDINATE INSTALLATION OF UTILITIES IN SUCH A MANNER AS TO AVOID CONFLICTS AND ASSURE PROPER DEPTHS ARE ACHIEVED, AS WELL AS COORDINATED WITH ANY UTILITY COMPANIES FOR APPROVED LOCATIONS AND SCHEDULING OF TIE-INS/CONNECTIONS TO THEIR FACILITIES.
- L. REFER TO ARCHITECTURE PLANS FOR SITE LIGHTING AND ELECTRICAL CONDUIT PLANS. POLE LOCATIONS ARE SHOWN ON THIS SHEET FOR REFERENCE ONLY. IT IS THE CONTRACTOR'S RESPONSIBILITY TO IDENTIFY AND ADJUST ANY CONSTRUCTED CONFLICTS WITH UNDERGROUND UTILITIES, SIDEWALKS, ETC.
- M. CHECK ARCHITECTURAL PLANS FOR EXACT DOWNSPOUT LOCATIONS.
- N. CONTRACTOR SHALL REFER TO LANDSCAPE AND IRRIGATION PLAN FOR LOCATION AND CONSTRUCTION DETAILS OF LANDSCAPING AND IRRIGATION.

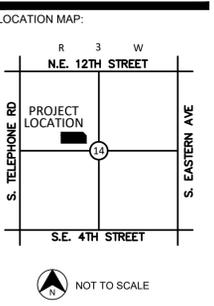

PROJECT:
CENTRAL JUNIOR HIGH CLASSROOM ADDITION
 400 N. BROADWAY ST. MOORE, OKLAHOMA
 PROJECT NUMBER: 25031
 DRAWING DATE: 06.02.25
 ISSUE DATE: 06.02.25



SUBMITTAL:
PERMIT SET

REVISIONS:


08.13.25	ADDENDUM 03
09.23.25	CB-4
10.09.25	CB-5
01.22.26	CB-6

MARK DATE DESCRIPTION

THESE PLANS AND DRAWINGS ARE NOT TO BE REPRODUCED, CHANGED OR COPIED IN ANY FORM OR MANNER WHATSOEVER WITHOUT FIRST OBTAINING THE WRITTEN PERMISSION AND CONSENT OF CEDAR CREEK CONSULTING INC. THIS SHEET IS NOT TO BE USED FOR CONSTRUCTION UNLESS THE ISSUE DATE IN THE TITLE BLOCK COINCIDES WITH OR POST DATES THE DRAWING DATE. ANY CHANGES MADE FROM THESE PLANS WITHOUT CONSENT OF CEDAR CREEK CONSULTING INC. ARE UNAUTHORIZED AND SHALL RELIEVE CEDAR CREEK CONSULTING OF RESPONSIBILITY FOR ALL CONSEQUENCES ARISING OUT OF SUCH CHANGES.


DRAWING TITLE:
SITE PLAN


SHEET:
C2.00

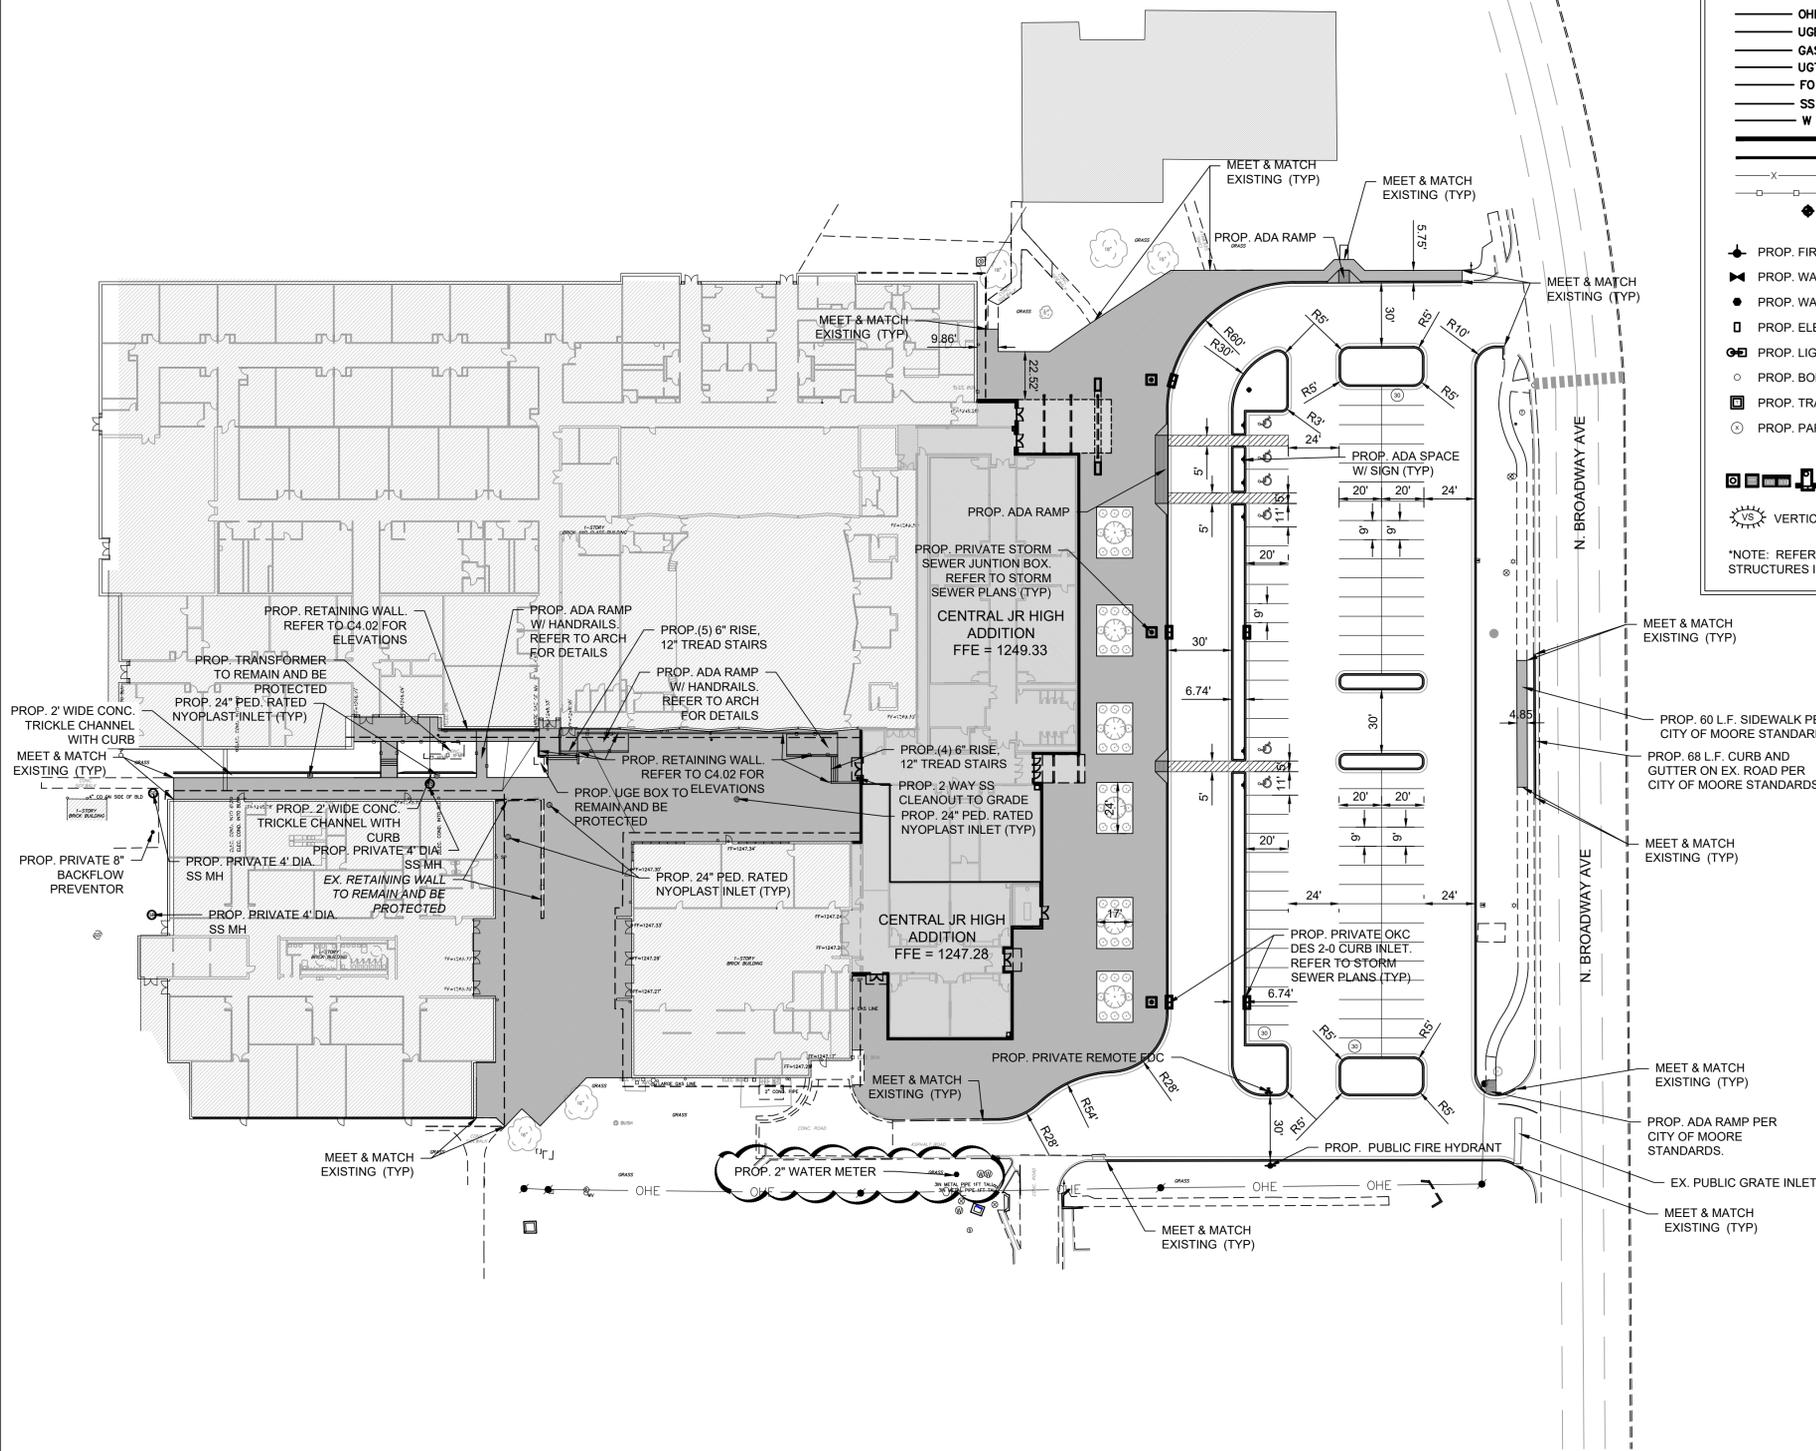

NOTE: CONTRACTOR IS RESPONSIBLE FOR ENSURING THAT ALL PROPOSED WORK MEETS ADA REQUIREMENTS. REFER TO www.access-board.gov/ada-aba/ada-standards-doj.cfm

NOTE: CONTRACTOR SHALL CONSTRUCT AND INSTALL WHEEL STOPS, SIGNS, AND ADA RAMP AT ALL HANDICAP SPACES.

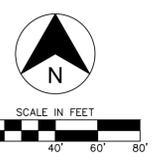

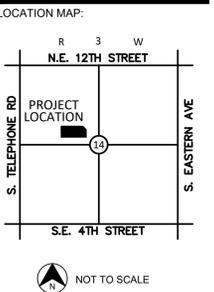

PROJECT:

CENTRAL JUNIOR HIGH CLASSROOM ADDITION

400 N. BROADWAY ST.
 MOORE, OKLAHOMA

PROJECT NUMBER: 25031
 DRAWING DATE: 06.02.25
 ISSUE DATE: 06.02.25

SEAL:



SUBMITTAL:
 PERMIT SET

REVISIONS:

08.13.25	ADDENDUM 03
01.22.26	CB #6

MARK DATE DESCRIPTION

THESE PLANS AND DRAWINGS ARE NOT TO BE REPRODUCED, CHANGED OR COPIED IN ANY FORM OR MANNER WHATSOEVER WITHOUT FIRST OBTAINING THE WRITTEN PERMISSION AND CONSENT OF CEDAR CREEK CONSULTING INC. THIS SHEET IS NOT TO BE USED FOR CONSTRUCTION UNLESS THE ISSUE DATE IN THE TITLE BLOCK COINCIDES WITH OR POST DATES THE DRAWING DATE. ANY CHANGES MADE FROM THESE PLANS WITHOUT CONSENT OF CEDAR CREEK CONSULTING INC. ARE UNAUTHORIZED AND SHALL RELIEVE CEDAR CREEK CONSULTING OF RESPONSIBILITY FOR ALL CONSEQUENCES ARISING OUT OF SUCH CHANGES.

DRAWING TITLE:

UTILITY PLAN



SHEET:
C5.00

- ### UTILITY NOTES
- CONTRACTOR SHALL REFER TO THE CONSTRUCTION DOCUMENTS INCLUDING BUT NOT LIMITED TO THE WRITTEN SPECIFICATIONS, CONSTRUCTION DRAWINGS, STORM WATER POLLUTION PLAN, AND GEOTECHNICAL REPORT.
 - ALL CONSTRUCTION SHALL BE IN STRICT ACCORDANCE WITH THE OWNERS DESIGN GUIDELINES AND SPECIFICATIONS, AND WHERE APPLICABLE SHALL MEET THE REQUIREMENTS OF THE GOVERNING/PERMITTING AUTHORITY HAVING JURISDICTION.
 - CONTRACTOR IS RESPONSIBLE FOR THEIR OWN HORIZONTAL AND VERTICAL CONTROL, REFERENCE POINTS AND CONSTRUCTION STAKING AS INCIDENTAL TO THE PROJECT.
 - THE CONTRACTOR SHALL FIELD VERIFY EXISTING ELEVATIONS/PROPERTY LINES/UTILITIES/DRAINAGE PRIOR TO CONSTRUCTION START.
 - ALL WORK NOT CLASSIFIED AS A CONTRACT PAY ITEM SHALL BE CONSIDERED AS INCIDENTAL AND THE COST THEREOF SHALL BE INCLUDED IN THE UNIT PRICE BID FOR ITEMS WHICH ARE CLASSIFIED FOR PAYMENT.
 - CONTRACTOR SHALL REFER TO THE ARCHITECTURAL AND MEP PLANS AND SPECIFICATIONS BEING A PART OF THE CONSTRUCTION DOCUMENTS FOR THE EXACT LOCATIONS AND DIMENSIONS OF ENTRY, EXIT PORCHES, PRECISE BUILDING DIMENSIONS, EXACT BUILDING UTILITY ENTRANCE, AND DOWNSPOUT LOCATIONS/SPECIFICATIONS/DETAILS.
 - REFER TO ARCHITECTURE PLANS FOR SITE LIGHTING/LIGHT POLE BASES AND ELECTRICAL CONDUIT PLACEMENT AND SPECIFICATIONS. POLE LOCATIONS ARE SHOWN ON THIS SHEET FOR REFERENCE ONLY. IT IS THE CONTRACTOR'S RESPONSIBILITY TO IDENTIFY AND ADJUST ANY CONSTRUCTED CONFLICTS WITH UNDERGROUND UTILITIES, SIDEWALKS, ETC.
 - CONTRACTOR IS REQUIRED TO CALL ONE CALL AS WELL AS THE APPROPRIATE UTILITY COMPANY AT LEAST 48 HOURS BEFORE ANY EXCAVATION/CONSTRUCTION ACTIVITIES TAKE PLACE. IT SHALL BE THE RESPONSIBILITY OF THE CONTRACTOR TO RELOCATE ALL EXISTING UTILITIES WHICH ARE IN CONFLICT WITH PROPOSED IMPROVEMENTS.
 - CONTRACTOR SHALL ENSURE ALL CONSTRUCTED UTILITIES MEET THE MINIMUM SEPARATION AND COVER REQUIREMENTS SET FORTH BY THE PROVIDER, FEDERAL/STATE/LOCAL REGULATIONS, OR SPECIFICATIONS. IN THE EVENT THERE IS A CONFLICT THE MOST STRINGENT SHALL APPLY.
 - GENERAL CONTRACTOR TO PROVIDE 2'X2'X6" THICK CONCRETE APRON AT ALL CLEANOUTS, VALVES AND METERS OUTSIDE OF BUILDING.
 - GENERAL CONTRACTOR SHALL BE RESPONSIBLE FOR ALL TAP AND TIE ON FEES REQUIRED, AS WELL AS COST OF UNDERGROUND SERVICE CONNECTIONS TO THE BUILDINGS.
 - THRUST BLOCKING SHALL BE PROVIDED AT ALL BENDS, TEES, AND FIRE HYDRANTS.
 - DIMENSIONS SHOWN ARE TO CENTERLINE OF PIPE OR FITTING.
 - ALL WATER AND SANITARY SEWER LEADS TO BUILDING SHALL END 5' OUTSIDE THE BUILDING LIMITS AS SHOWN ON PLAN AND SHALL BE PROVIDED WITH A TEMPORARY PLUG AT END.
 - ALL FIRE HYDRANTS SHALL BE PROVIDED WITH AN APPROVED GATE VALVE A MAXIMUM OF 5' UNLESS OTHERWISE SPECIFIED BY CITY OFFICIAL) FROM HYDRANT.
 - CONTRACTOR SHALL COMPLY COMPLETELY WITH THE LATEST STANDARDS OF OSHA DIRECTIVES OR ANY OTHER AGENCY HAVING JURISDICTION FOR EXCAVATION AND TRENCHING PROCEDURES. THE CONTRACTOR SHALL USE SUPPORT SYSTEMS, SLOPING, BENCHING AND OTHER MEANS OF PROTECTION. THIS IS TO INCLUDE, BUT NOT LIMITED FOR ACCESS AND EGRESS FROM ALL EXCAVATION AND TRENCHING. CONTRACTOR IS RESPONSIBLE FOR COMPLYING WITH PERFORMANCE CRITERIA AS REQUIRED BY OSHA.
 - REFER TO FIRE PROTECTION SHEETS FOR LOCATION AND DETAIL OF FIRE LINE LEAD IN. FIRE LINE SHALL BE STUBBED UP 1' ABOVE FFE IN SPRINKLER ROOM.
 - REFER TO PLUMBING SHEETS FOR LOCATION AND DETAILS OF SEWER, DOMESTIC, AND IRRIGATION CONNECTIONS.
 - CONTRACTOR SHALL REFER TO IRRIGATION PLANS FOR ACTUAL LOCATION, SIZE, LENGTH AND DEPTH. TEMPORARILY PLUG BOTH ENDS. IRRIGATION CONTRACTOR WILL REMOVE TEMPORARY PLUGS, INSTALL LINES AND PROPERLY SEAL BOTH ENDS.
 - THE FIRE DEPARTMENT CONNECTION (FDC) SHALL BE LOCATED ON THE STREET SIDE OF ANY STRUCTURE. THE FDC SHALL BE LOCATED AND ARRANGED SO THAT THE HOSE LINES CAN BE READILY ATTACHED TO THE INLETS WITHOUT INTERFERENCE FROM OBJECTS.
 - IT IS THE CONTRACTOR'S RESPONSIBILITY TO COORDINATE THE EXTENSIONS OF ALL UTILITY SERVICE LINES TO THE MAIN UTILITY LINES.
 - ALL CONDUIT SHALL BE SCHEDULE 40 PVC, UNLESS OTHERWISE NOTED.
 - CONTRACTOR SHALL REFER TO LANDSCAPE AND IRRIGATION PLAN FOR LOCATION AND CONSTRUCTION DETAILS OF LANDSCAPING AND IRRIGATION.

LEGEND

---	EXISTING 1' CONTOUR	---	EXISTING 5' CONTOUR
---	PROPOSED 1' CONTOUR	---	PROPOSED 5' CONTOUR
---	BOUNDARY LINE	---	RIGHT OF WAY LINE
---	EASEMENT LINE	---	EXISTING CURB AND GUTTER
---	PROPOSED CURB AND GUTTER	---	PROPOSED FIRE LANE STRIPING
---	OHE	---	OVERHEAD ELECTRIC LINE
---	UGE	---	UNDERGROUND ELECTRIC LINE
---	GAS	---	GAS LINE
---	UGT	---	UNDERGROUND TELEPHONE LINE
---	FO	---	UNDERGROUND FIBER OPTIC LINE
---	SS	---	SANITARY SEWER LINE
---	W	---	WATERLINE
---	RETAINING WALL	---	SCREEN WALL
---	WIRE FENCE	---	CHAIN LINK FENCE
---	BENCHMARK	---	PROP. FIRE HYDRANT
---	PROP. FIRE HYDRANT	---	PROP. WHEEL STOP
---	PROP. WATER VALVE	---	PROP. FES
---	PROP. WATER METER	---	PROP. HC RAMP
---	PROP. ELECT. METER	---	PROP. POWER POLE
---	PROP. LIGHT POLE	---	PROP. SS MANHOLE
---	PROP. BOLLARD	---	PROP. GAS METER
---	PROP. TRANSFORMER	---	PROP. SIGN
---	PROP. PARKING COUNT	---	PROP. FIRE ROUTE SIGN
---	PROP. INLETS (SEE GRADING PLAN FOR TYPE)	---	
---	VERTICAL SEPARATION REQUIREMENT	---	

*NOTE: REFER TO SURVEYING LEGEND FOR EXISTING STRUCTURES IDENTIFICATION

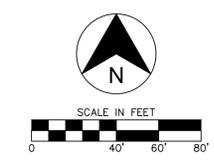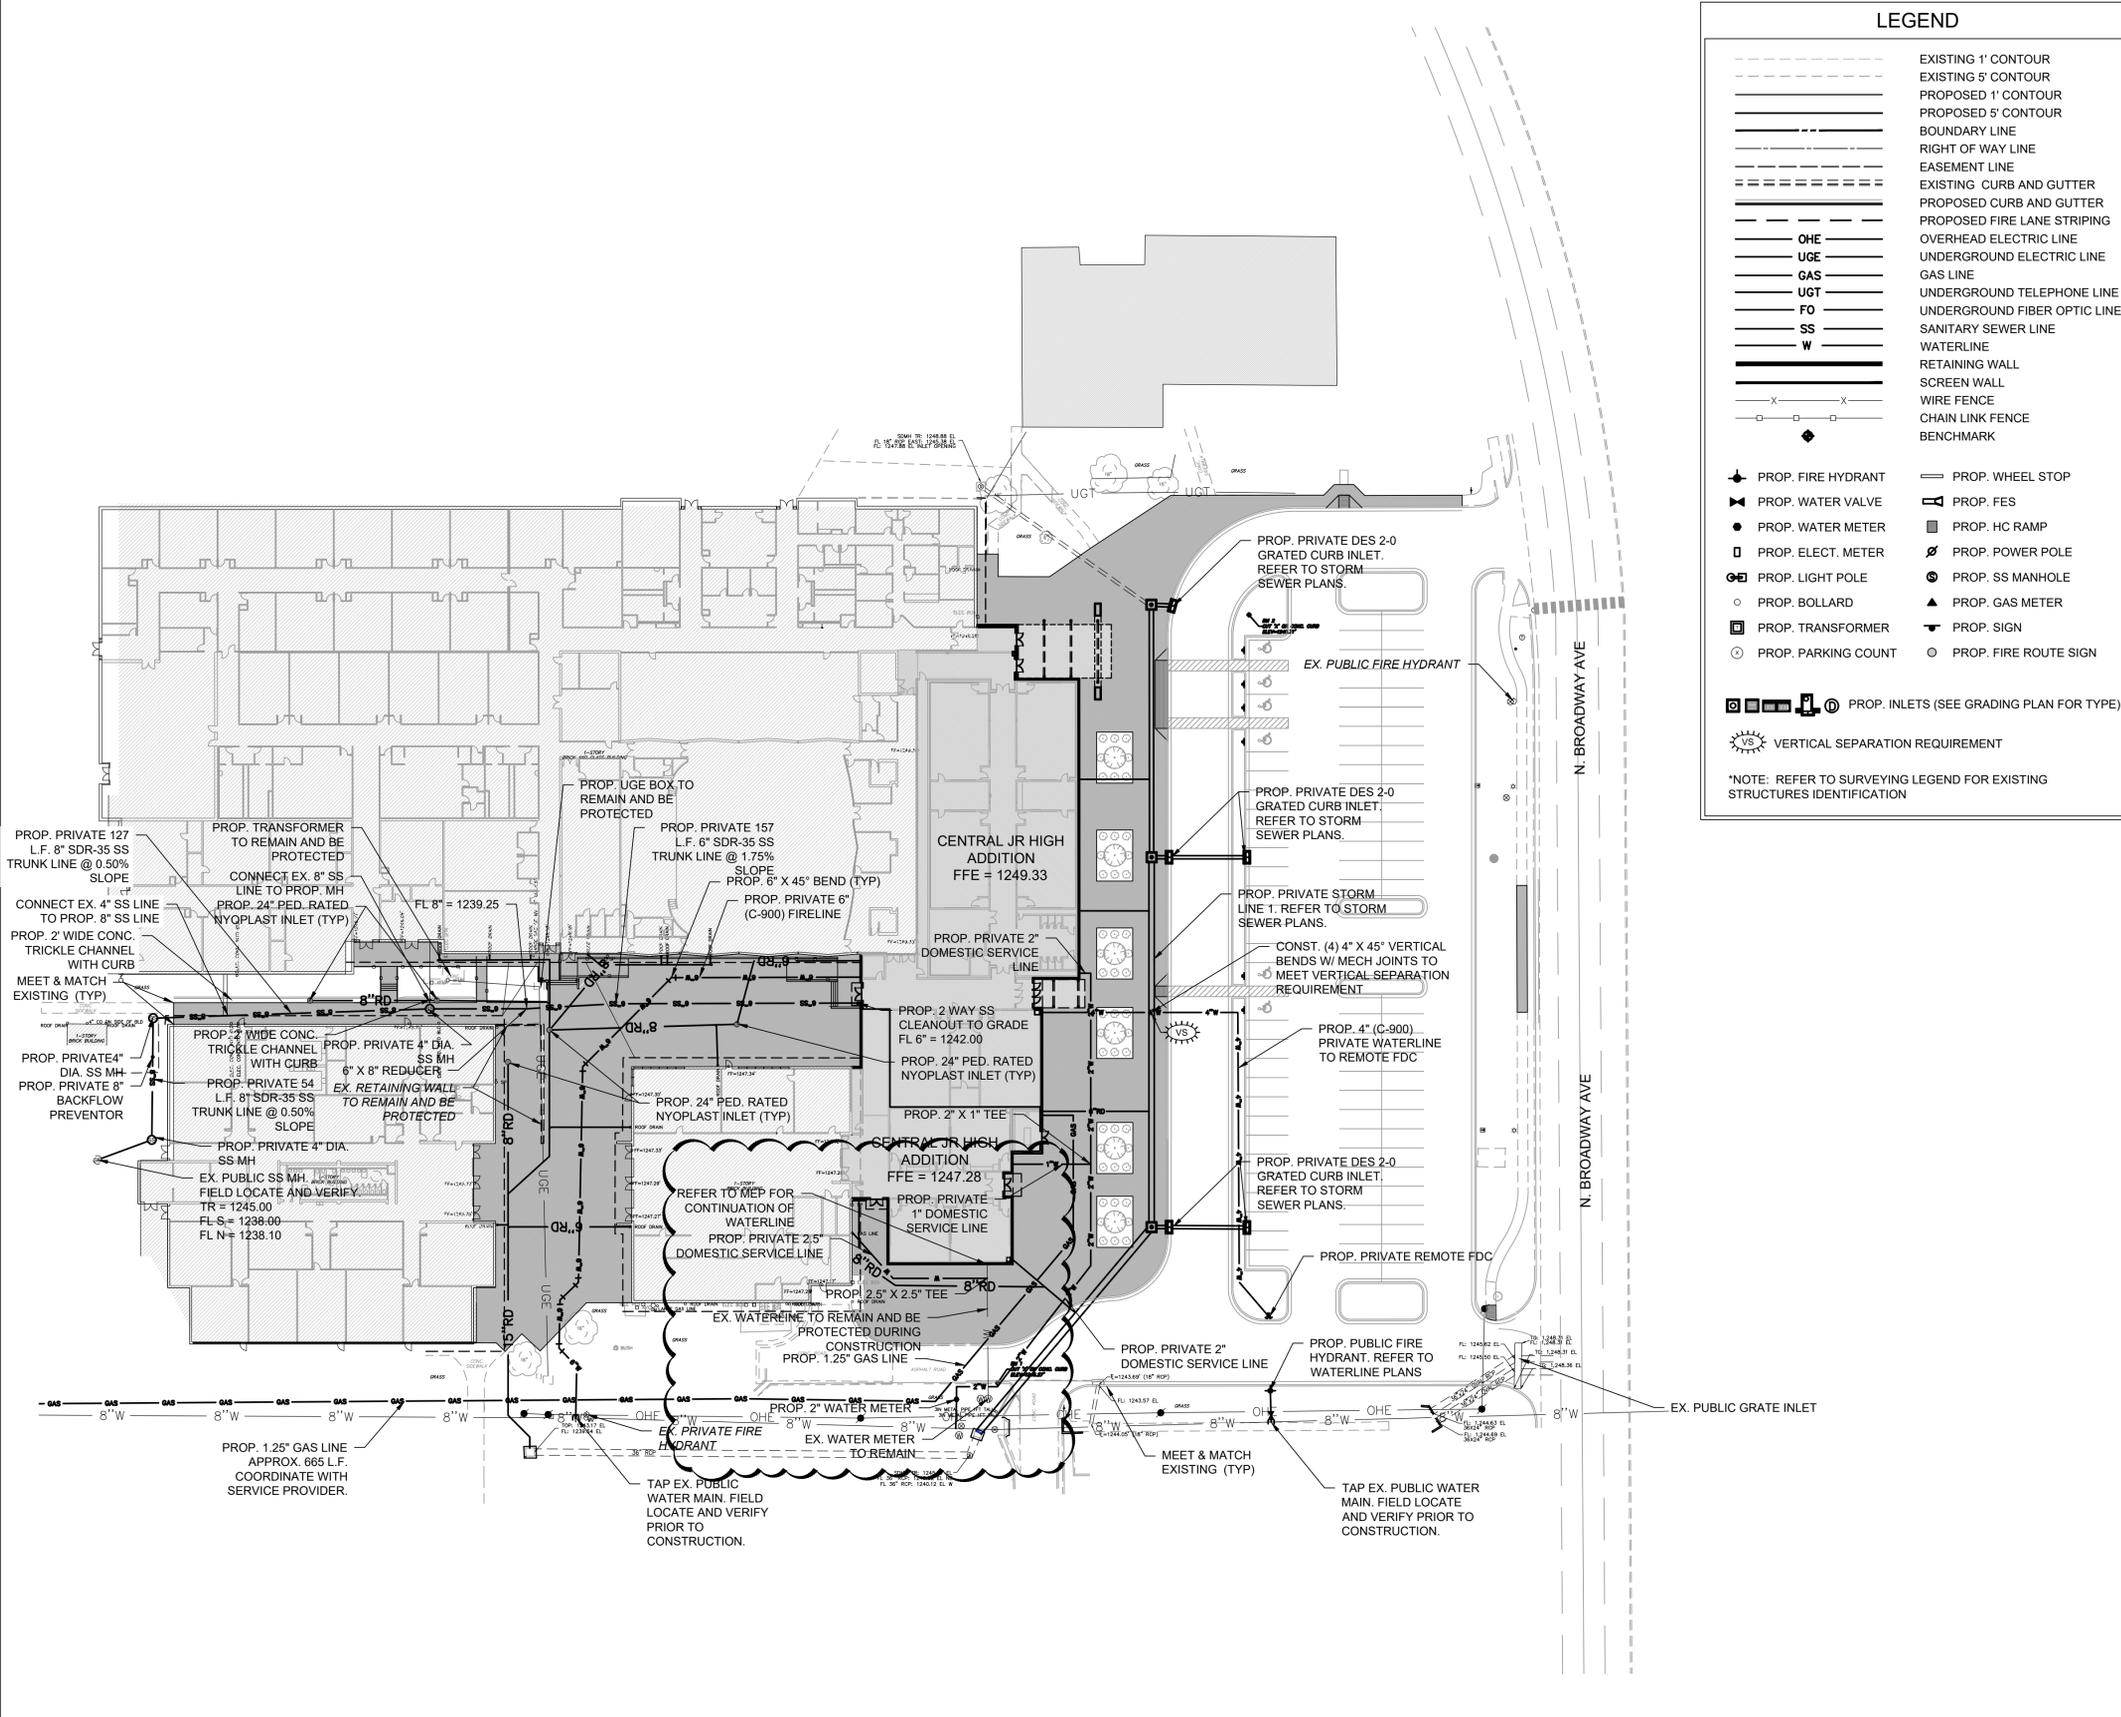



CG
drawn by
MA
checked by
APRIL 2025
date

- revisions
- 1 ADDENDUM #1
 - 2 ADDENDUM #2
 - 3 CB-6



MOORE
PUBLIC SCHOOLS

MOORE PUBLIC SCHOOLS
BOARD OF EDUCATION
MOORE, OKLAHOMA


CLASSROOM ADDITION
CENTRAL JUNIOR
HIGH SCHOOL

sheet no:

A107

REFLECTED CEILING PLAN

OWNERSHIP USE OF DOCUMENTS:
AGP EXPRESSLY RESERVES ITS
COPYRIGHT AND OTHER PROPERTY
RIGHTS OF ALL PLANS AND DRAWINGS
DESIGNED AND/OR PRODUCED. PLANS
AND DRAWINGS ARE NOT TO BE
REPRODUCED IN ANY FORM OR MANNER
WITHOUT THE EXPRESSED WRITTEN
CONSENT OF AGP.




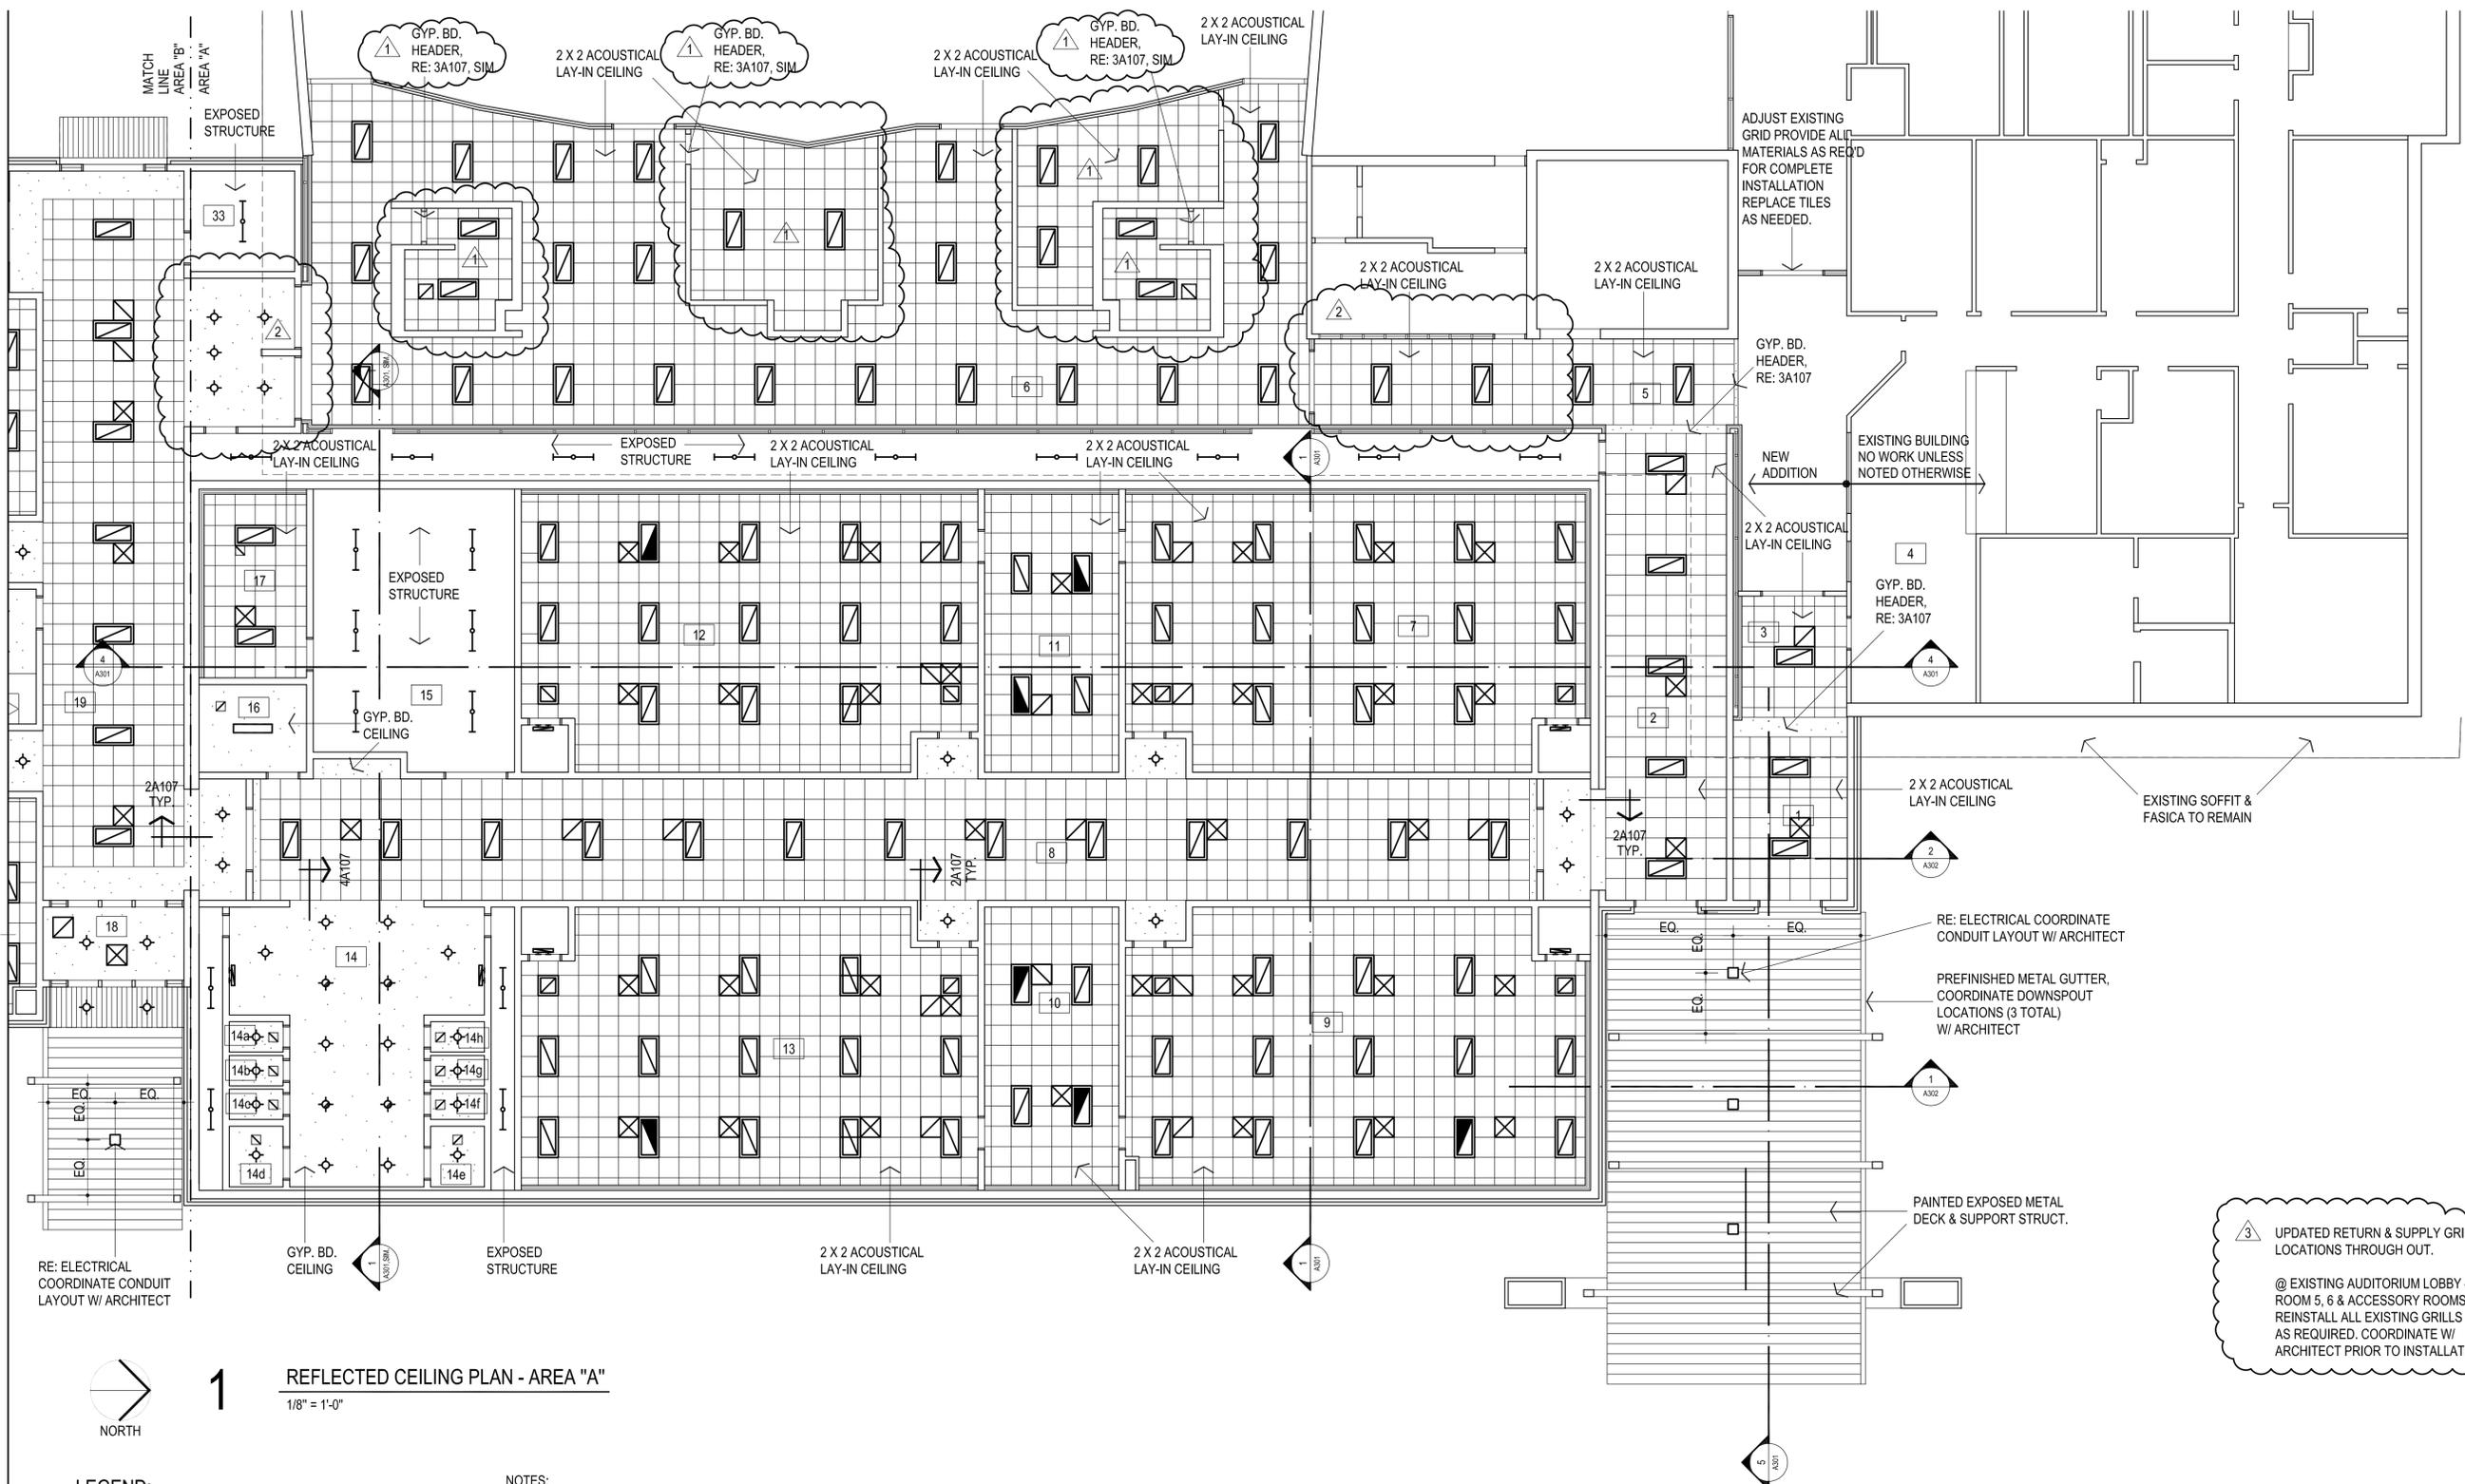


3 UPDATED RETURN & SUPPLY GRILL LOCATIONS THROUGH OUT.
@ EXISTING AUDITORIUM LOBBY - ROOM 5, 6 & ACCESSORY ROOMS, REINSTALL ALL EXISTING GRILLS AS REQUIRED. COORDINATE W/ ARCHITECT PRIOR TO INSTALLATION.

1 REFLECTED CEILING PLAN - AREA "A"
1/8" = 1'-0"
NORTH

- LEGEND:**
- MECHANICAL OPENINGS
 - ELECTRICAL FIXTURES
 - CEILING MOUNTED SMOKE DETECTOR, RE: ELEC
 - INDICATES AREA / ROOM TO RECEIVE GYP. BD. CEILING
 - INDICATES AREA / ROOM TO RECEIVE 2X2 LAY-IN CEILING

- NOTES:**
1. REFER MECHANICAL & ELECTRICAL FOR ANY ADDITIONAL CEILING MOUNTED FIXTURES
 2. REFER TO SHEET A100 FOR LOCATIONS OF FIRE-RATED WALLS
 3. DO NOT SCALE DRAWINGS TO OBTAIN MATERIAL QUANTITIES. USE DRAWINGS WHICH ARE DIMENSIONED OR COORDINATE W/ EXISTING CONDITIONS &/OR ARCHITECT & ENGINEERS.

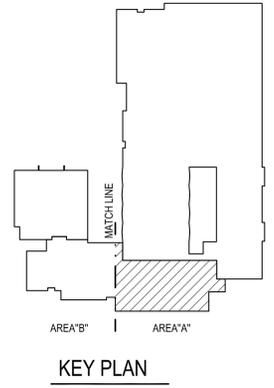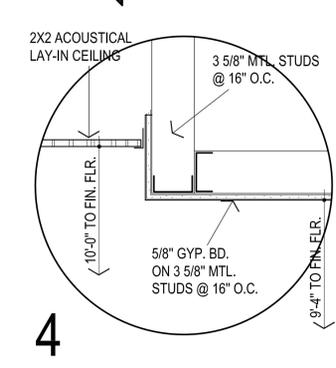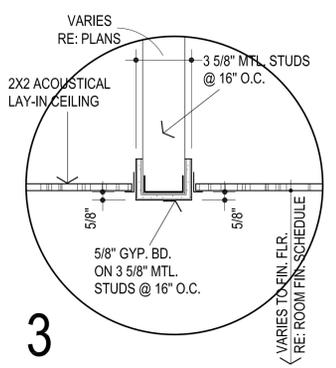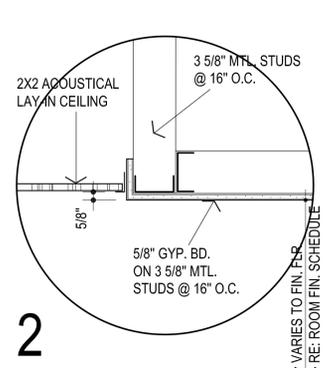



CG

drawn by

MA

checked by

APRIL 2025

date

revisions

1 CB-6



MOORE
PUBLIC SCHOOLS

MOORE PUBLIC SCHOOLS
BOARD OF EDUCATION
MOORE, OKLAHOMA

CLASSROOM ADDITION
CENTRAL JUNIOR
HIGH SCHOOL


sheet no:

A108

REFLECTED CEILING PLAN

OWNERSHIP USE OF DOCUMENTS:

AGP EXPRESSLY RESERVES ITS
COPYRIGHT AND OTHER PROPERTY
RIGHTS OF ALL PLANS AND DRAWINGS
DESIGNED AND/OR PRODUCED. PLANS
AND DRAWINGS ARE NOT TO BE
REPRODUCED IN ANY FORM OR MANNER
WITHOUT THE EXPRESSED WRITTEN
CONSENT OF AGP.

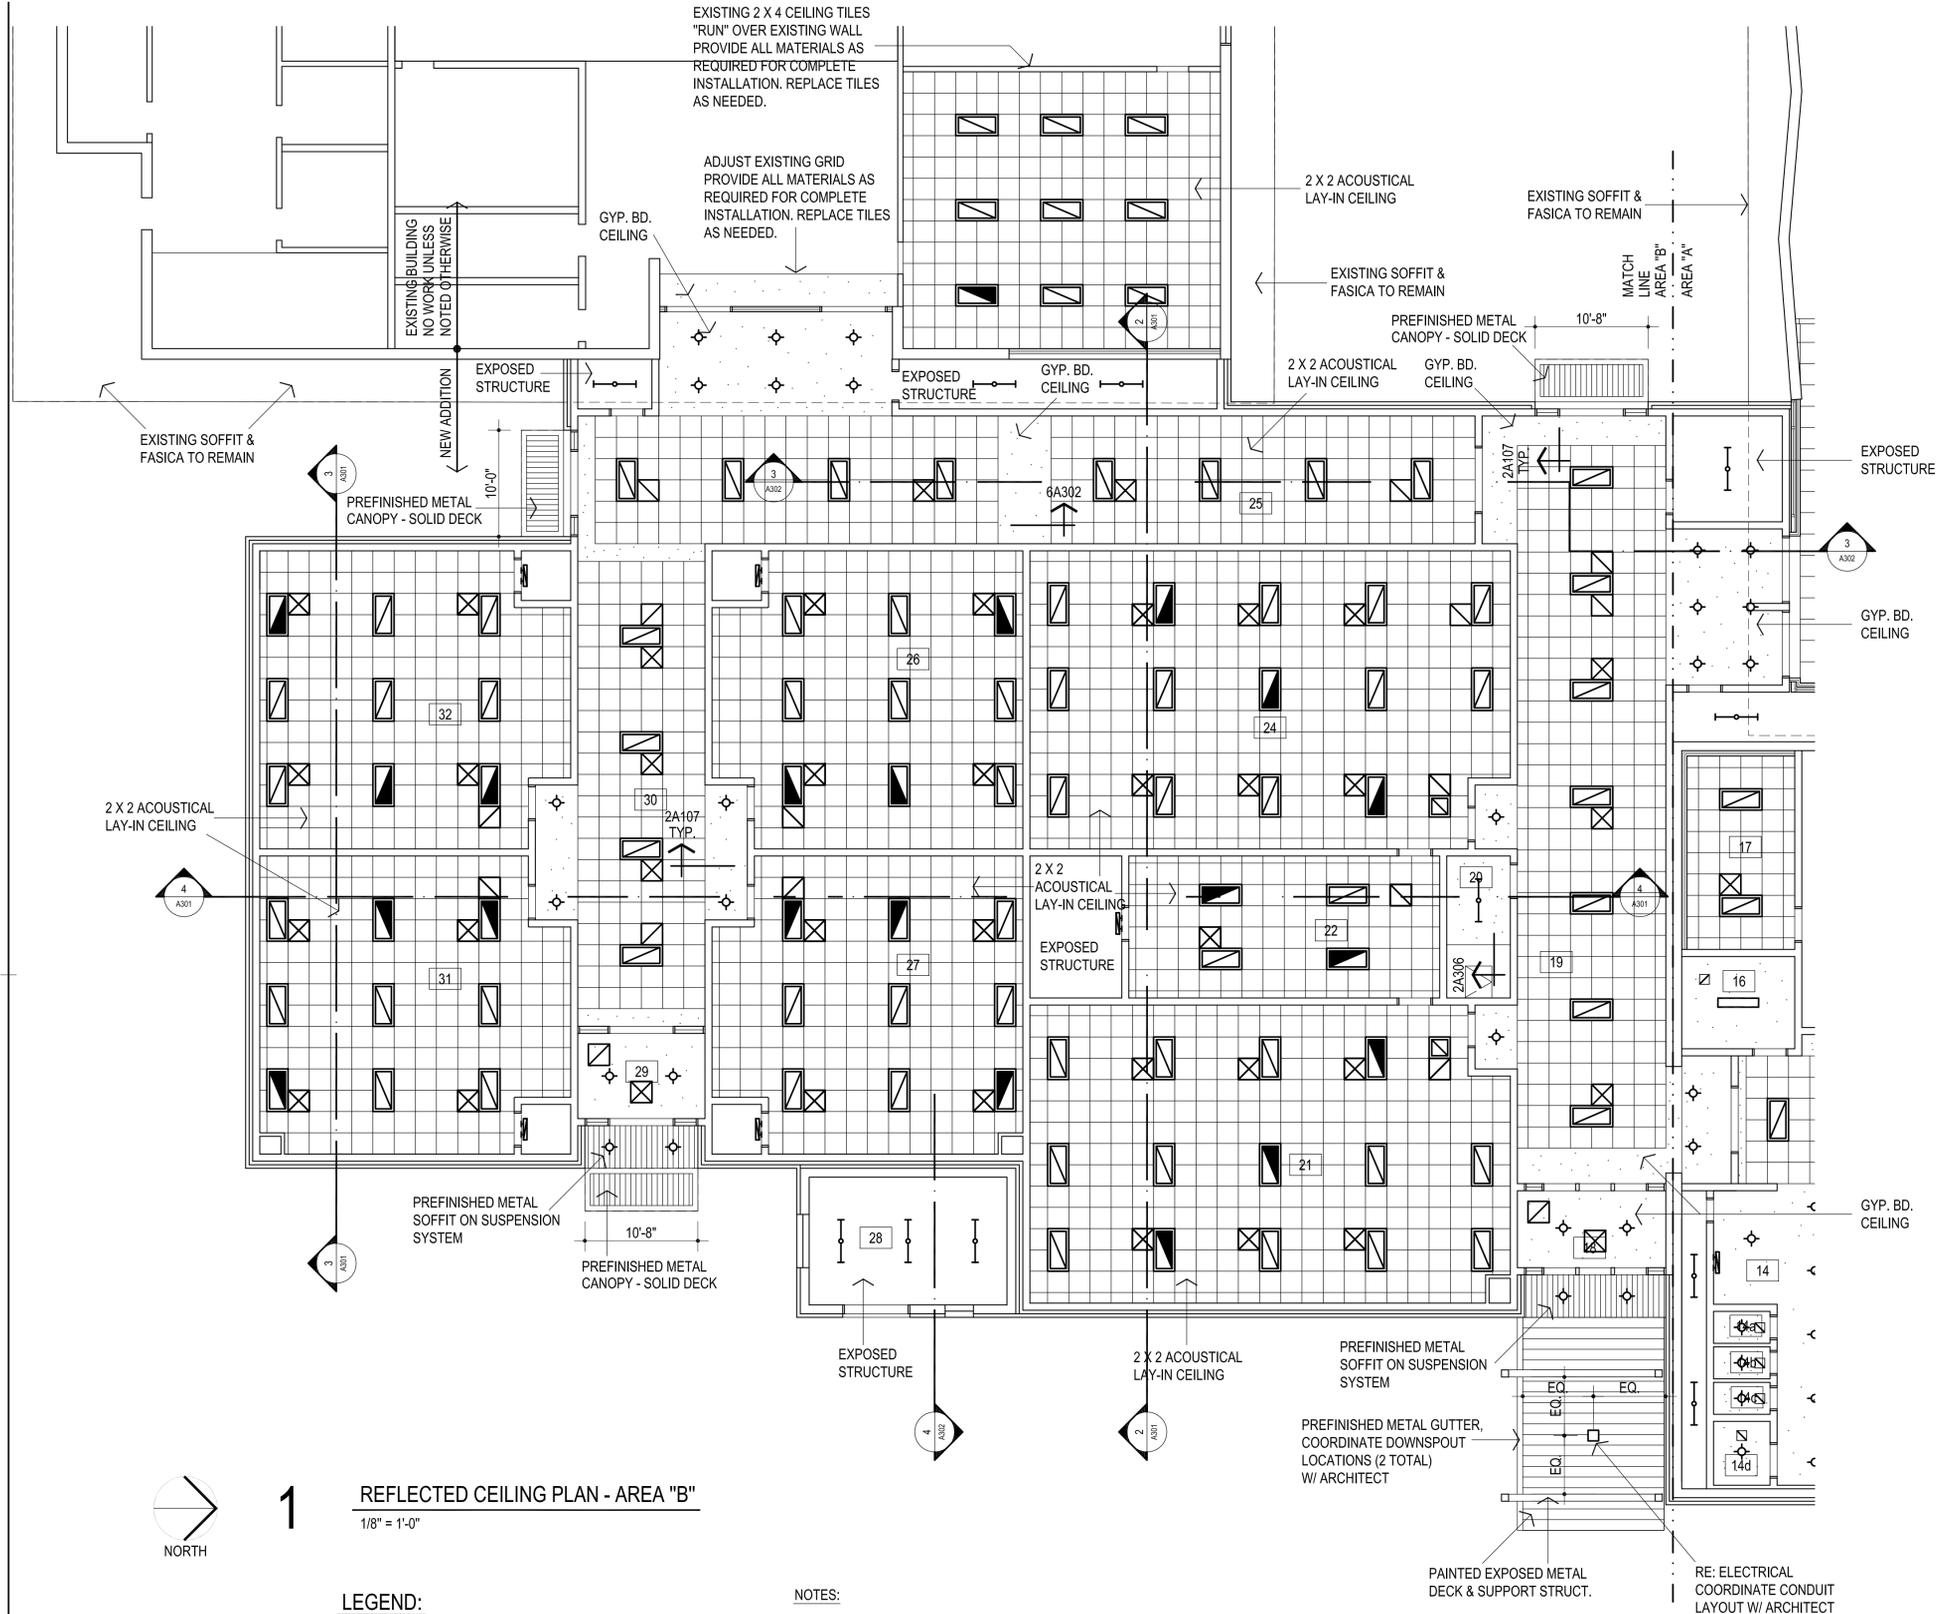

1 UPDATED RETURN & SUPPLY GRILL LOCATIONS THROUGH OUT.




1 REFLECTED CEILING PLAN - AREA "B"
1/8" = 1'-0"

LEGEND:

- MECHANICAL OPENINGS
- ELECTRICAL FIXTURES
- CEILING MOUNTED SMOKE DETECTOR, RE: ELEC
- INDICATES AREA / ROOM TO RECEIVE GYP. BD. CEILING
- INDICATES AREA / ROOM TO RECEIVE 2X2 LAY-IN CEILING

NOTES:

1. REFER MECHANICAL & ELECTRICAL FOR ANY ADDITIONAL CEILING MOUNTED FIXTURES
2. REFER TO SHEET A100 FOR LOCATIONS OF FIRE-RATED WALLS
3. DO NOT SCALE DRAWINGS TO OBTAIN MATERIAL QUANTITIES. USE DRAWINGS WHICH ARE DIMENSIONED OR COORDINATE W/ EXISTING CONDITIONS &/OR ARCHITECT & ENGINEERS.

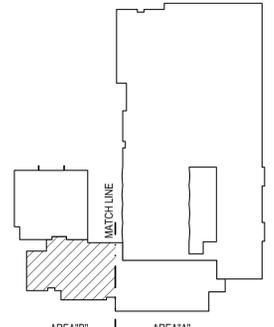

KEY PLAN

Construction Bulletin # 06

Client: Abla Griffin Partnership
 Project Name: Central JH STEM and Saferoom
 Project Number: 2550-00564-00

January 20, 2026

Requested by: Owner
 Contractor:
 Salas O'Brien:




To: Mike Abla, Clay Griffin

This Construction Bulletin is issued to:

- Offer additional information for clarification or supplemental drawings for layout assistance.
- Request cost and time impact to initiate a change to the Contract Documents. Owner approval is required, do not commence with revisions unless directed in writing. Avoid Work in areas that may be affected by proposed change until approved or rejected. Once approved, forward Change Order documentation as required by the Contract Documents.
- Direct a required change in the Contract Documents. Proceed with change(s) as indicated. Forward Change Order documentation as required by the Contract Documents.
- Response to RFI _____.

Item No.	Description	Attachment
1	Refer to clouds and deltas.	P101
2	Refer to clouds and deltas.	P102
3	Refer to clouds and deltas.	P110
4	Refer to clouds and deltas.	P111
5	Refer to clouds and deltas.	P302

END OF CB-06

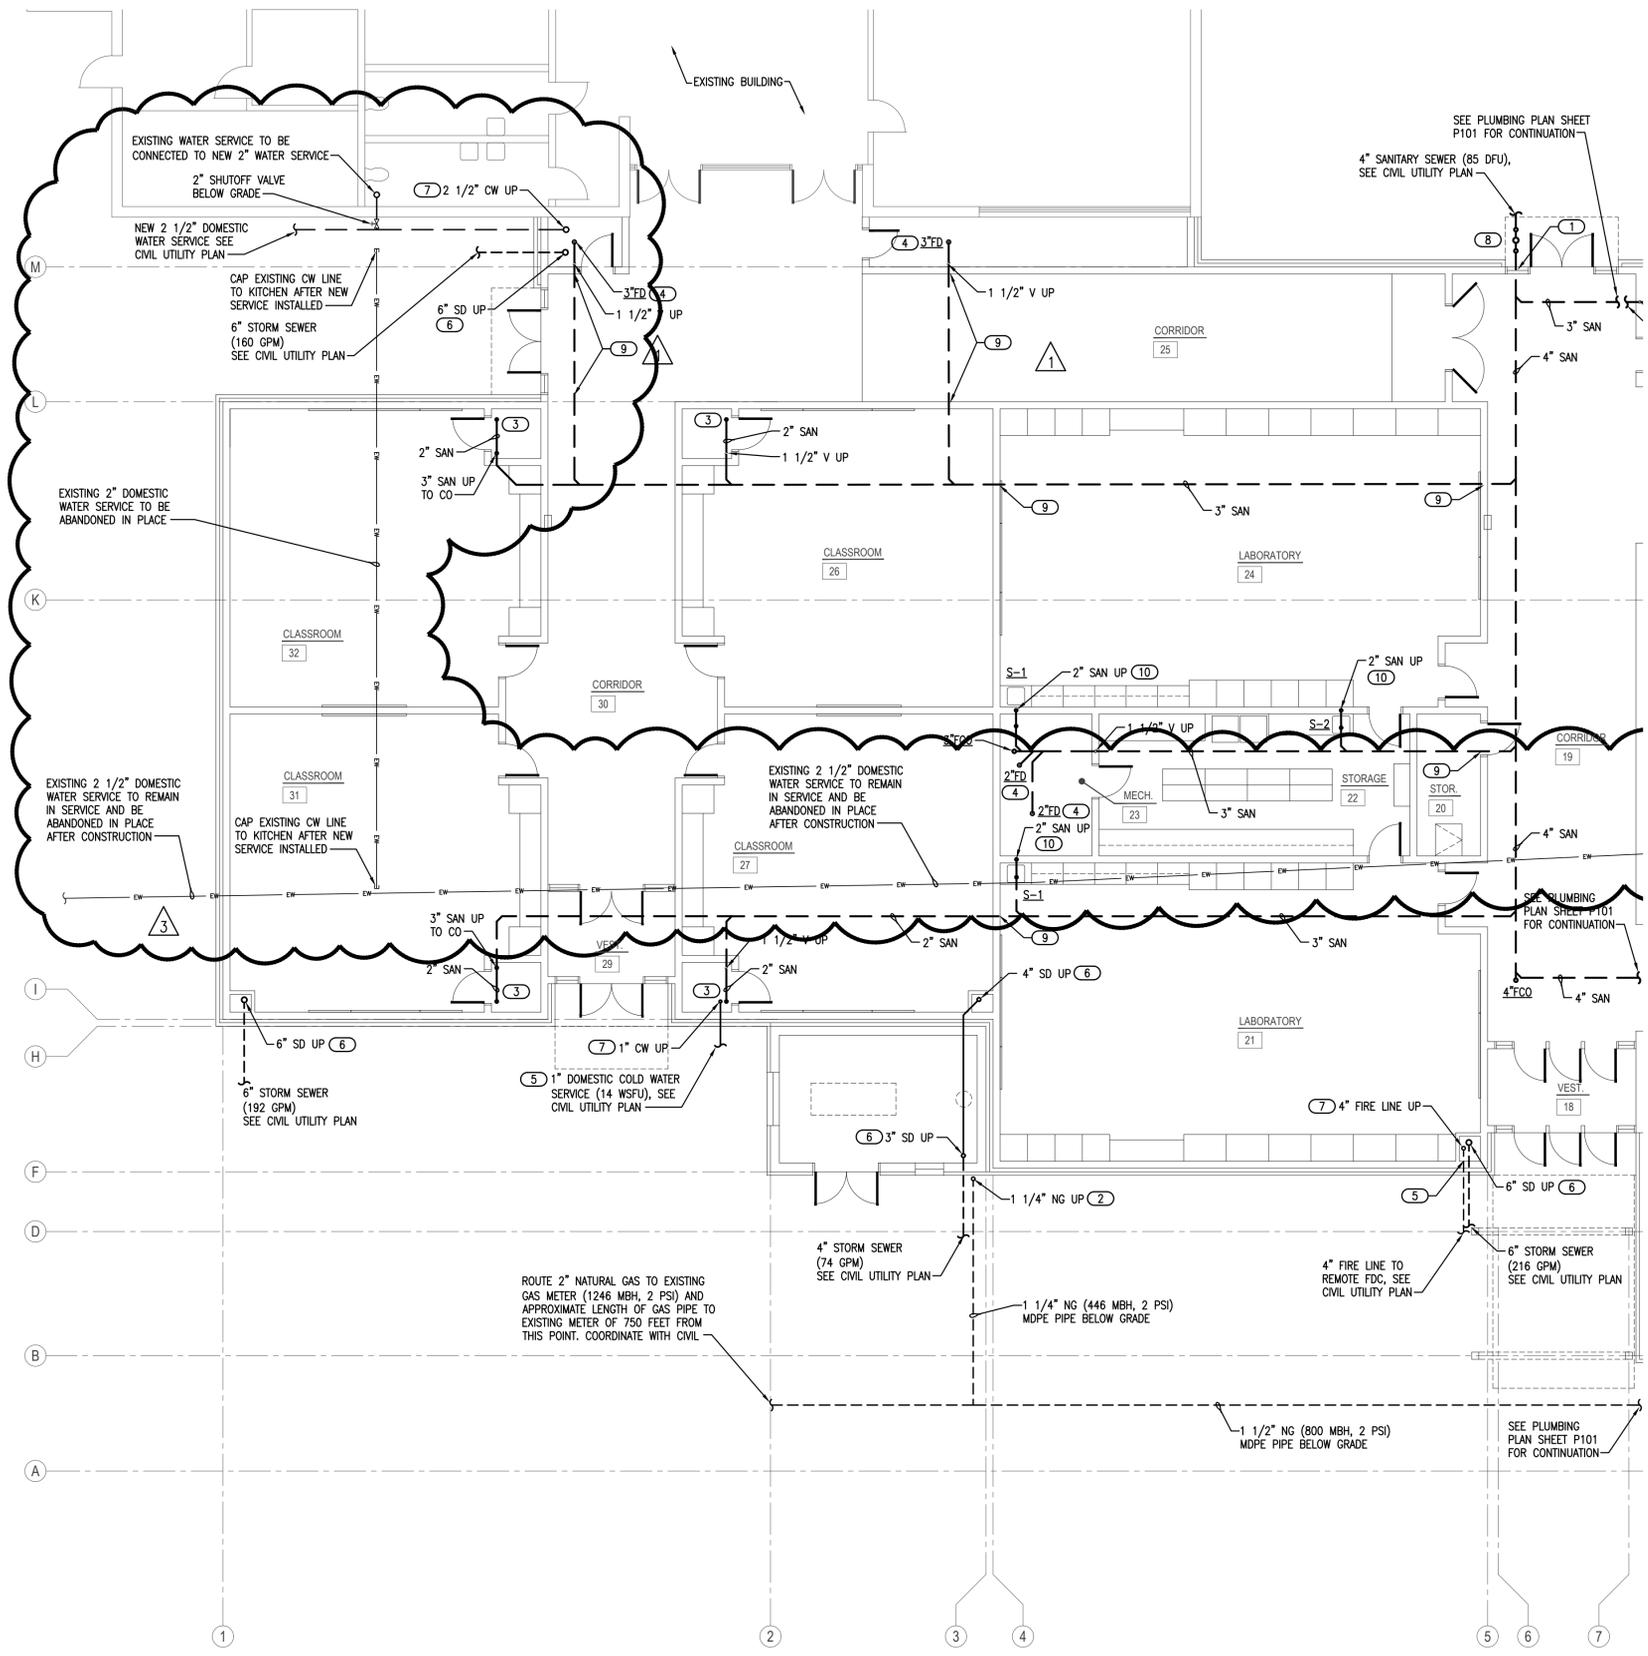

- ### GENERAL NOTES
- COORDINATE WORK WITH ALL OTHER TRADES ON SITE.
 - COORDINATE ALL BELOW GRADE PIPE ROUTING WITH STRUCTURAL FOUNDATIONS AND REQUIRED PIPE SLEEVES THRU FOUNDATION PENETRATIONS.
 - FIELD VERIFY EXISTING CONDITIONS PRIOR TO COMMENCING WORK.
 - PRIOR TO COMMENCING WORK, COORDINATE WITH SITE CONTRACTOR FOR SANITARY SEWER AND WATER INVERT ELEVATIONS.
 - REFER TO PLUMBING FIXTURE SCHEDULE ON SHEET P601 FOR FIXTURE ROUGH-IN PIPE SIZES AND ISOMETRIC SHEET P301.
 - PIPE TRENCHES SHALL HAVE SAND BEDDING TO A MINIMUM POINT 6" ABOVE THE TOP OF PIPE. REFER TO SPECIFICATIONS.
 - INSTALL BELOW FLOOR 1/2" CW LINE TYPE K COPPER OR PEX-g FOR TRAP PRIMER TO FLOOR DRAINS. SLOPE LINE CONTINUOUSLY TOWARDS DRAIN. SEE DETAIL 1/P501.
 - INSTALL CAUTION TAPE AND TRACER WIRE ABOVE ALL NON-METALLIC GAS PIPING.
 - CLASSROOMS DESIGNATED AS LABORATORY WILL NOT UTILIZE CHEMICALS FOR CLASSROOM ACTIVITIES IN ANY FORM AS COMMUNICATED BY THE DISTRICT. THE PLUMBING SANITARY SYSTEM IS DESIGNED AROUND THIS DIRECTIVE FROM THE OWNER.

- ### KEYED NOTES
- PROVIDE CAST IRON PIPE SLEEVE FOR SANITARY PIPE BELOW GRADE BEAM. INSTALL FOAM SPACER BLOCKS TO MAINTAIN PIPE IN CENTER OF SLEEVE. COORDINATE PIPE SLEEVE INSTALLATION WITH STRUCTURAL.
 - PROVIDE ANODELESS GAS RISER FOR TRANSITION FROM BELOW GRADE MDPE TUBING TO ABOVE GRADE BLACK IRON PIPE. COORDINATE GAS PIPE INSTALLATION WITH SITE CONTRACTOR.
 - ROUTE 2" SANITARY LINE UP TO 2" AFF AND INSTALL 2x4 FITTING FOR HUB DRAIN. COORDINATE INSTALLATION WITH MC. ROUTE TRAP PRIMER LINE TO HUB DRAIN. MC TO ROUTE FURNACE CONDENSATE DRAIN LINES TO HUB DRAIN. SEE DETAIL 11/P501.
 - INSTALL ABOVE FLOOR 1/2" CW LINE TYPE K COPPER OR PEX-g FOR TRAP PRIMER TO FLOOR DRAINS. SLOPE LINE CONTINUOUSLY TOWARDS DRAIN. SEE DETAIL 1/P501.
 - PROVIDE PVC PIPE SLEEVE FOR WATER LINE BELOW OR THRU FOUNDATION WALL. INSTALL FOAM PIPE INSULATION ON WATER LINE IN SLEEVE AND SEAL SLEEVE OPENINGS WATERTIGHT. COORDINATE PIPE SLEEVE INSTALLATION WITH STRUCTURAL.
 - PROVIDE CAST IRON PIPE SLEEVE FOR STORM PIPE BELOW OR THRU GRADE BEAM. INSTALL FOAM SPACER BLOCKS TO MAINTAIN PIPE IN CENTER OF SLEEVE. COORDINATE PIPE SLEEVE INSTALLATION WITH STRUCTURAL.
 - PROVIDE PVC PIPE SLEEVE THRU CONCRETE FLOOR AND STUB UP 2" AFF FOR WATER LINE. INSTALL FOAM PIPE INSULATION ON WATER LINE IN SLEEVE AND SEAL SLEEVE OPENINGS WATERTIGHT. COORDINATE PIPE SLEEVE INSTALLATION WITH STRUCTURAL.
 - INSTALL 4" SANITARY BACKWATER VALVE AND 4" EXTERIOR CLEANOUTS. PROVIDE CONCRETE PAD AT GRADE. SEE DETAIL 4/P501.
 - PROVIDE CAST IRON PIPE SLEEVE FOR SANITARY PIPE THRU OR BELOW GRADE BEAM. INSTALL FOAM SPACER BLOCKS TO MAINTAIN PIPE IN CENTER OF SLEEVE. COORDINATE PIPE SLEEVE INSTALLATION WITH STRUCTURAL.
 - COORDINATE WITH STRUCTURAL FOR ROUTING 2" SANITARY PIPE TO ABOVE GRADE BEAM, BELOW FINISHED FLOOR AND UP IN WALL ABOVE.



drawn by
KS
checked by
KP
APRIL 2025
date

revisions
 1 08/19/2025 AD 08
 2 08/25/2025 CB 01
 3 01/16/2026 CB 06


MOORE PUBLIC SCHOOLS
BOARD OF EDUCATION
MOORE, OKLAHOMA



CLASSROOM ADDITION
CENTRAL JUNIOR
HIGH SCHOOL

sheet no:

P102

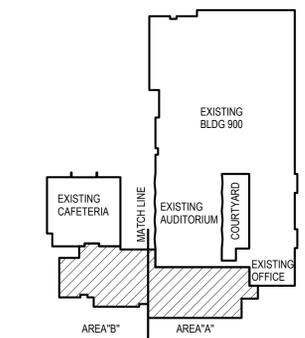

KEYPLAN
NO SCALE

1 PLUMBING PLAN - BELOW GRADE - AREA B
SCALE: 1/8" = 1'-0"



Salas O'Brien
 2900 S. Telephone Road, Suite 120
 Moore, OK 73160
 Salas O'Brien Registration: CA# 7058
 Expiration Date: 6/30/2025
 Salas O'Brien Project Number: 2550-00564-00



OWNERSHIP USE OF DOCUMENTS:
 AGP EXPRESSLY RESERVES ITS COPYRIGHT AND OTHER PROPERTY RIGHTS OF ALL PLANS AND DRAWINGS DESIGNED AND/OR PRODUCED. PLANS AND DRAWINGS ARE NOT TO BE REPRODUCED IN ANY FORM OR MANNER WITHOUT THE EXPRESSED WRITTEN CONSENT OF AGP.



- ### KEYED NOTES
- PROVIDE 1/2" CW WITH STRAINER TO TRAP PRIMER (TP-2) IN ACCESSIBLE LOCATION IN CHASE. ROUTE 1/2" LINE FROM UNIT TO FLOOR DRAINS IN THIS AREA (6 FLOOR DRAINS TOTAL). COORDINATE POWER WITH EC. SEE DETAIL 1/P501.
 - PROVIDE 1/2" CW WITH STRAINER TO TRAP PRIMER (TP-1) IN ACCESSIBLE LOCATION IN MECHANICAL/ELECTRICAL ROOM. ROUTE (2) 1/2" LINES FROM UNIT TO FLOOR SINK AND FLOOR DRAIN. COORDINATE POWER WITH EC. SEE DETAIL 1/P501.
 - COORDINATE WITH STRUCTURAL FOR DEBRIS SHROUD AT 4" STORM DRAIN PIPE PENETRATION OF STORM SHELTER ROOF.
 - COORDINATE WITH STRUCTURAL FOR DEBRIS SHROUD AT GAS WATER HEATER CONCENTRIC VENT AT PENETRATION OF STORM SHELTER ROOF.
 - PROVIDE 1/2" CW WITH STRAINER TO TRAP PRIMER (TP-1) IN ACCESSIBLE LOCATION IN FIRE RISER ROOM. ROUTE 1/2" LINE FROM UNIT TO FLOOR DRAIN IN THIS AREA. COORDINATE POWER WITH EC. SEE DETAIL 1/P501.
 - PROVIDE 1/2" CW WITH STRAINER TO TRAP PRIMER (TP-1) IN ACCESSIBLE LOCATION IN CHASE. ROUTE 1/2" LINE FROM UNIT TO FLOOR DRAIN IN THIS AREA. COORDINATE POWER WITH EC. SEE DETAIL 1/P501.

- ### GENERAL NOTES
- COORDINATE WORK WITH ALL OTHER TRADES ON SITE.
 - PROVIDE WATER HAMMER ARRESTORS (HA) ON WATER LINES TO FLUSH VALVES, SENSOR FAUCETS AND QUICK CLOSING VALVES. LOCATE UNITS IN ACCESSIBLE LOCATIONS.
 - SINK AND LAVATORY WATER SUPPLY STUB OUTS SHALL BE COPPER PIPE WITH SUPPORT BRACKET FASTENED IN WALL CAVITY.
 - FIRE SEAL ALL PENETRATIONS THRU RATED STRUCTURES TO MAINTAIN FIRE RATING.
 - REFER TO PLUMBING FIXTURE SCHEDULE ON SHEET P601 FOR FIXTURE ROUGH-IN PIPE SIZES AND ISOMETRIC SHEETS P301 AND P302.
 - PROVIDE ACCESS PANELS FOR ALL VALVES/DEVICES ABOVE HARD CEILINGS AND BEHIND WALLS.
 - ALL GAS PIPE SHALL COMPLY WITH IFGC. BRANCH LINES SHALL TAP OFF TOP OF GAS MAINS AND INSTALL SHUT-OFF VALVE ON BRANCH LINE.
 - TRAP PRIMER LINES SHALL BE COPPER TYPE "K" OR PEX-a TUBING WITH CONTINUOUS SLOPE TOWARDS DRAIN CONNECTION.
 - COORDINATE HEIGHT OF EXTERIOR FREEZELESS WALL HYDRANT (FWH) WITH GC AND/OR ARCHITECT. SEAL FIXTURE FLANGE WATERIGHT.
 - INSULATE STORM DRAIN AND SLOPE DOWN AT 1/8" PER FOOT.
 - CONTRACTOR SHALL COORDINATE ALL SAFEROOM SHELTER PENETRATIONS WITH STRUCTURAL. REFER TO STRUCTURAL DETAIL SHEET FOR PENETRATION PROTECTION FOR RECTANGULAR OPENINGS GREATER THAN 3.5 SQUARE INCHES AND CIRCULAR OPENINGS GREATER THAN 2.125 INCHES PER 2014 ICC-500.
 - CLASSROOMS DESIGNATED AS LABORATORY WILL NOT UTILIZE CHEMICALS FOR CLASSROOM ACTIVITIES IN ANY FORM AS COMMUNICATED BY THE DISTRICT. THE PLUMBING SANITARY SYSTEM IS DESIGNED AROUND THIS DIRECTIVE FROM THE OWNER.


- ### KEYED NOTES
- INSTALL THERMOSTATIC MIXING VALVE (TMV-1) BELOW SINK. LABORATORY SINKS SEE DETAIL 8/P501. STORAGE ROOM SINKS SEE DETAIL 5/P501.
 - PROVIDE 1/2" CW WITH STRAINER TO TRAP PRIMER (TP-1) IN ACCESSIBLE LOCATION IN FURNACE CLOSET. ROUTE 1/2" LINE FROM UNIT TO HUB DRAIN. COORDINATE POWER WITH EC. SEE DETAILS 1/P501 AND 11/P501.
 - ROUTE DOMESTIC WATER SERVICE DOWN WITH PRV-1 AND BALL VALVE AT 24" A.F.F. AND ROUTE DOWN TO BELOW FLOOR. SEE SHEET P101 FOR CONTINUATION.
 - COORDINATE CHASE SIZE WITH GC FOR STORM DRAIN PIPE DOWN TO BELOW FLOOR. INSTALL WALL CLEANOUT AT MINIMUM 20" AFF. SEE SHEET P101 FOR CONTINUATION.
 - ROUTE 3/4" NATURAL GAS (2 PSI) LINE TO FURNACE. PROVIDE BALL VALVE, DRIP LEG, PRESSURE REGULATOR AND FINAL UNIT CONNECTION. COORDINATE CONNECTION WITH MC. SEE DETAIL 7/P501.
 - COORDINATE WITH STRUCTURAL FOR DEBRIS SHROUD AT PLUMBING VENT PENETRATION OF STORM SHELTER ROOF.
 - PROVIDE 3/4" CW WITH BALL VALVE TO CONNECTION FOR ROOF HYDRANT (FRH). COORDINATE WITH STRUCTURAL FOR DEBRIS SHROUD AT ROOF PENETRATION.
 - PROVIDE 1/2" CW BRANCH LINE IN CHASE TO SERVE LAVATORY. ROUTE 1 1/4" HW DOWN IN CHASE AND BACK UP TO CEILING. CONNECT 1/2" HW TO LAVATORY. INSTALL THERMOSTATIC MIXING VALVE (TMV-1) BELOW FIXTURE. SEE DETAIL 6/P501.
 - COORDINATE WITH GC FOR LOCATION OF OVERFLOW STORM DRAIN PIPE. INSTALL FLOOR PIPE SUPPORT FOR ELBOW NEAR FLOOR. INSTALL BOTTOM OF DOWNSPOUT NOZZLE AT 12" ABOVE GRADE. COORDINATE HEIGHT WITH GC.
 - PROVIDE 1/2" CW WITH STRAINER TO TRAP PRIMER (TP-2) IN ACCESSIBLE LOCATION IN CHASE. ROUTE 1/2" LINES FROM UNIT TO FLOOR DRAINS IN THIS AREA (7 FLOOR DRAINS TOTAL). COORDINATE POWER WITH EC. SEE DETAIL 1/P501.

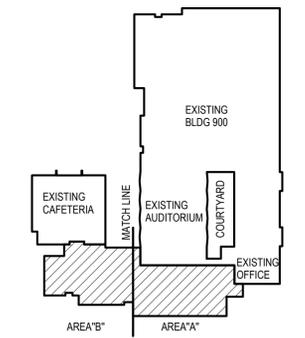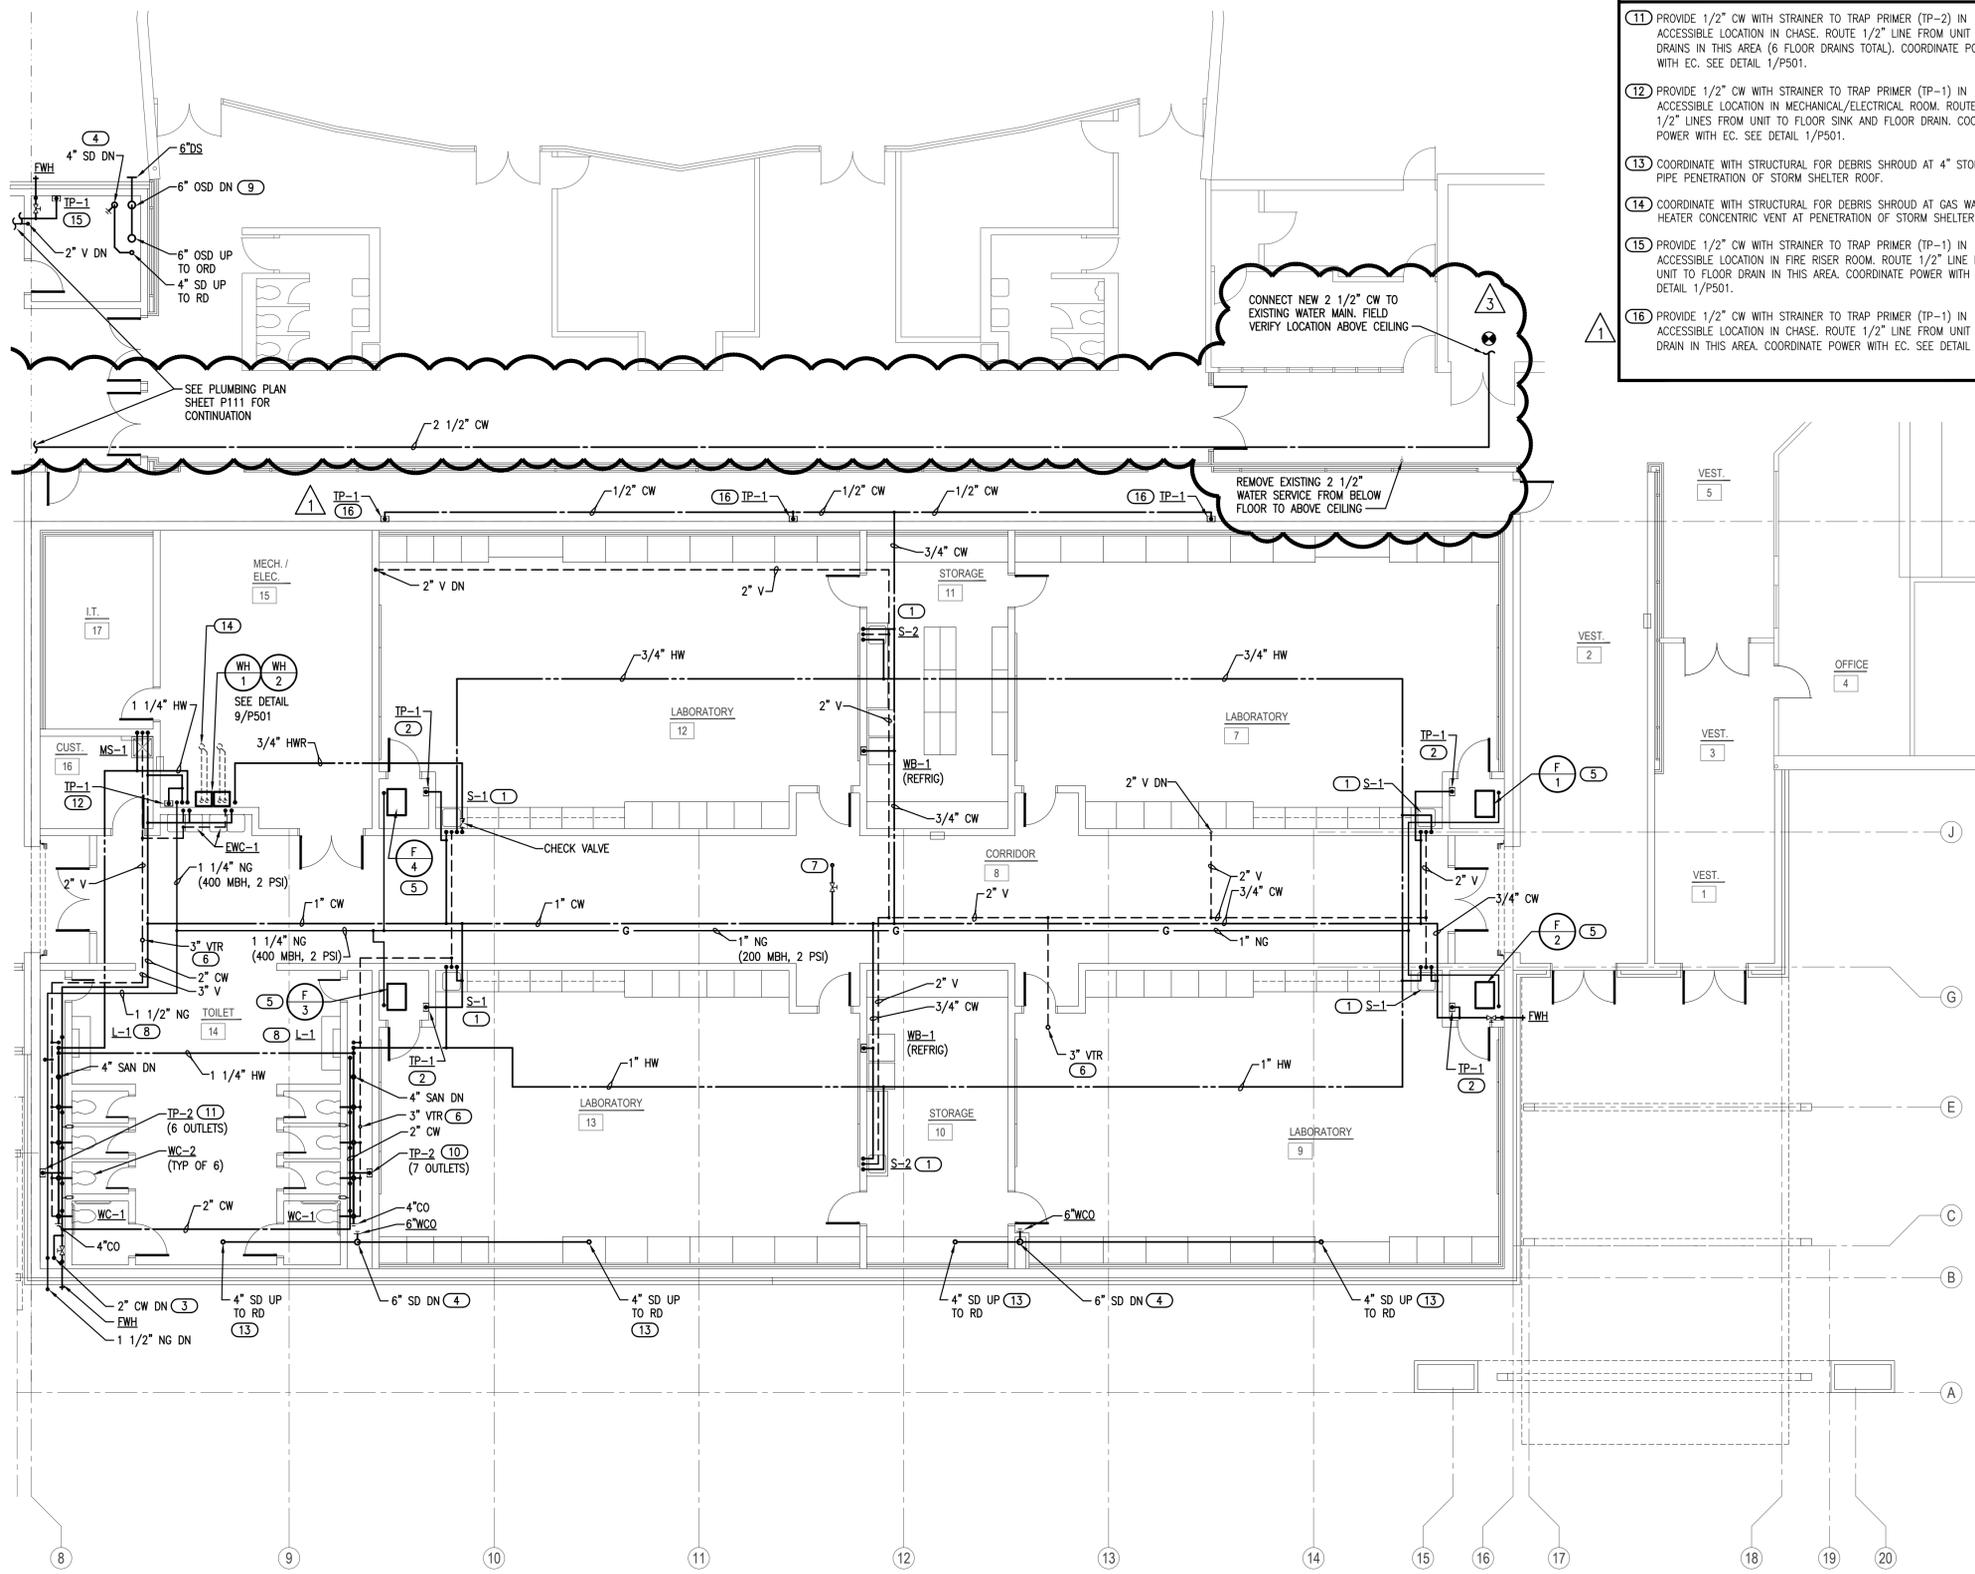

1 PLUMBING PLAN - ABOVE GRADE - AREA A
SCALE: 1/8" = 1'-0"

Salas O'Brien
2900 S. Telephone Road, Suite 120
Moore, OK 73160
Salas O'Brien Registration: CA# 7058
Expiration Date: 6/30/2025
Salas O'Brien Project Number: 2550-00564-00

OWNERSHIP USE OF DOCUMENTS:
AGP EXPRESSLY RESERVES ITS COPYRIGHT AND OTHER PROPERTY RIGHTS OF ALL PLANS AND DRAWINGS DESIGNED AND/OR PRODUCED. PLANS AND DRAWINGS ARE NOT TO BE REPRODUCED IN ANY FORM OR MANNER WITHOUT THE EXPRESSED WRITTEN CONSENT OF AGP.

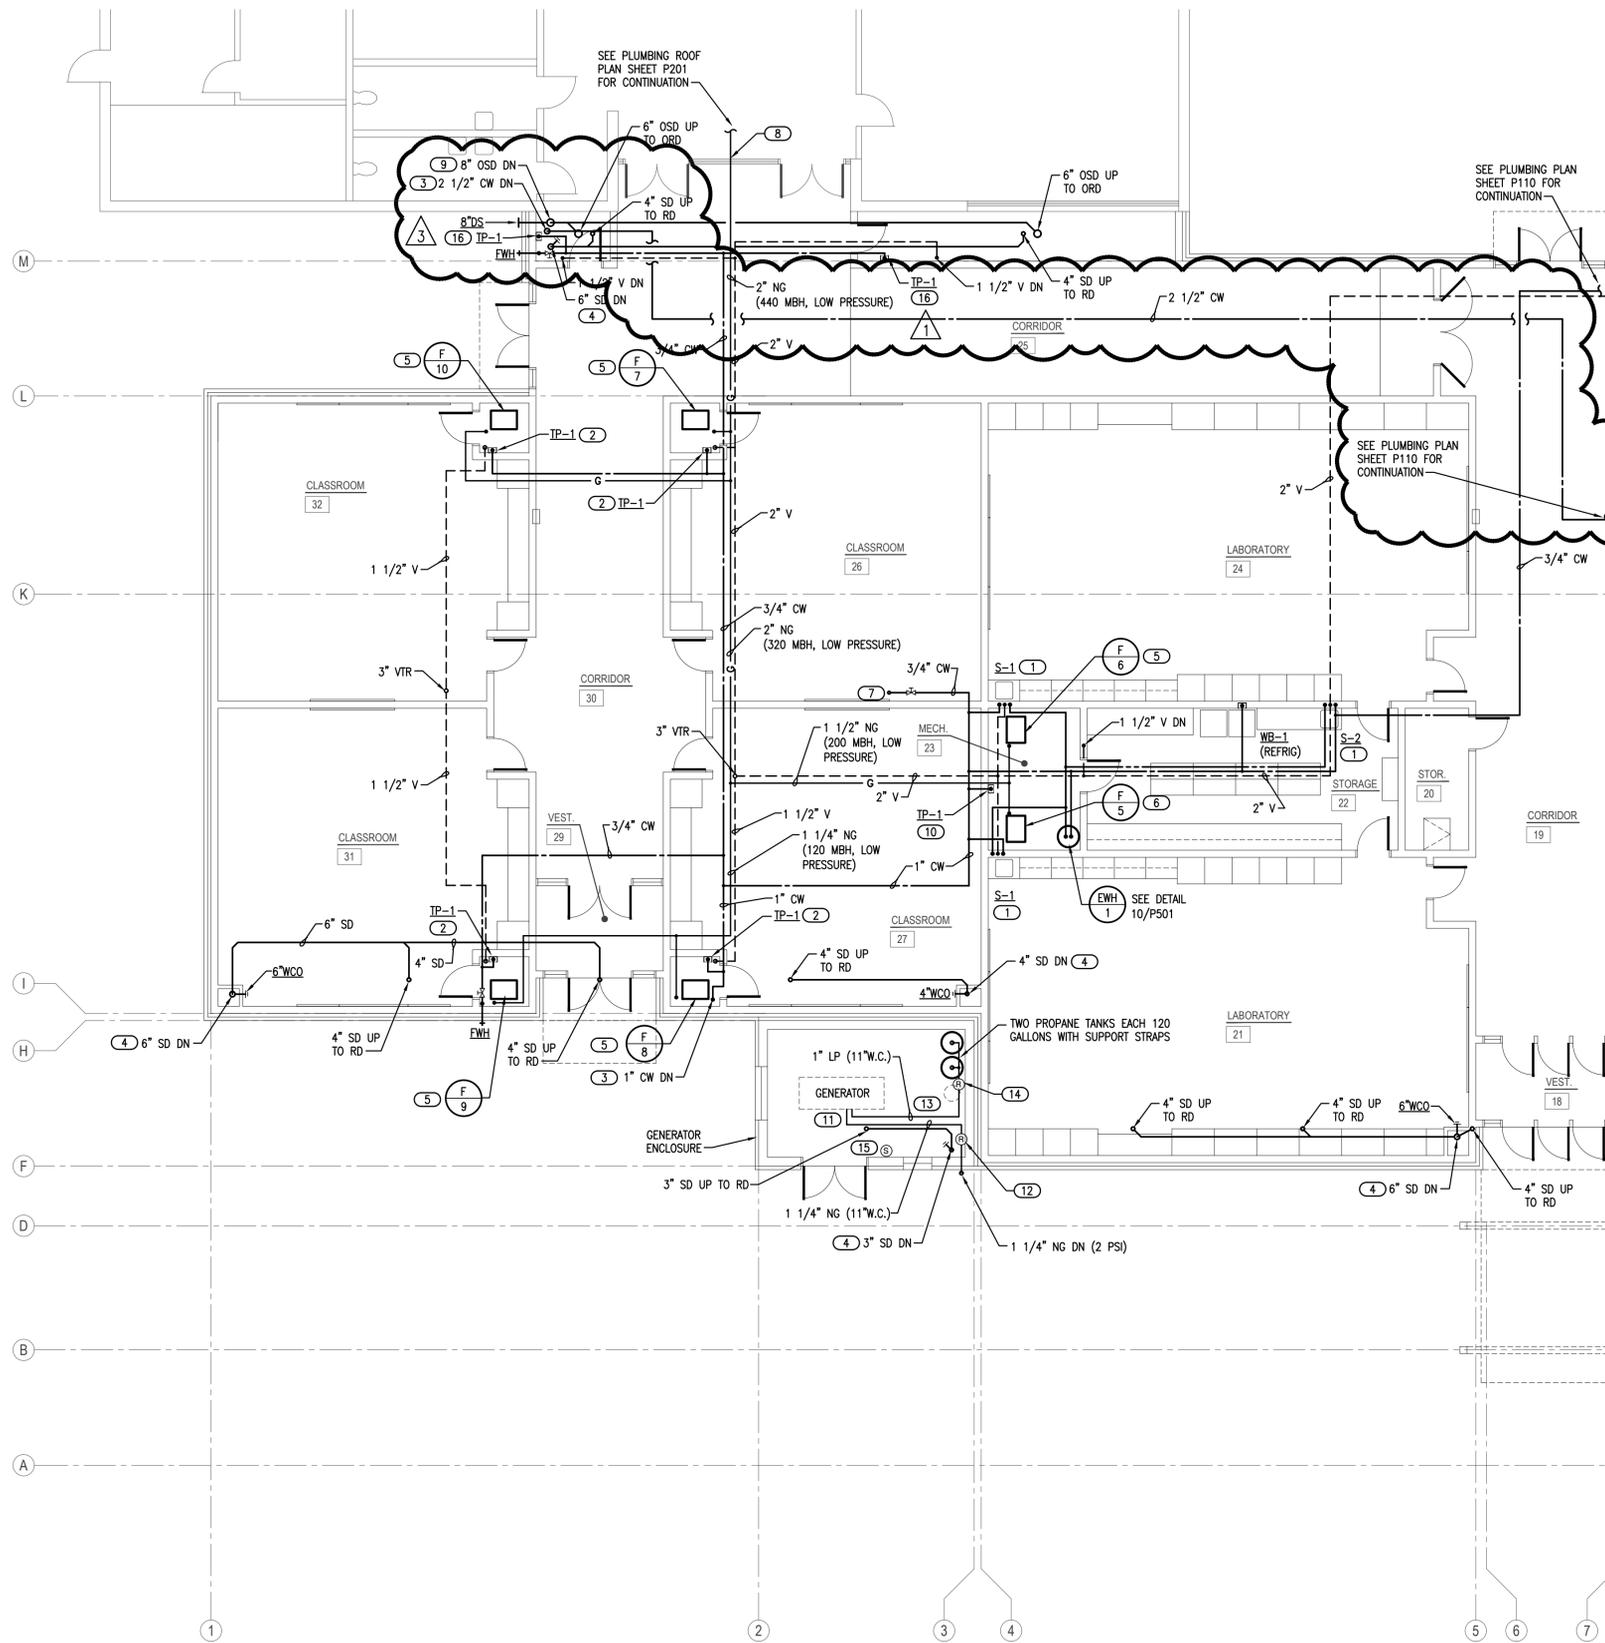

- ### KEYED NOTES
- INSTALL THERMOSTATIC MIXING VALVE (TMV-1) BELOW SINK. LABORATORY SINKS SEE DETAIL 8/P501. STORAGE ROOM SINKS SEE DETAIL 5/P501.
 - PROVIDE 1/2" CW WITH STRAINER TO TRAP PRIMER (TP-1) IN ACCESSIBLE LOCATION IN FURNACE CLOSET. ROUTE 1/2" LINE FROM UNIT TO HUB DRAIN. COORDINATE POWER WITH EC. SEE DETAILS 1/P501 AND 11/P501.
 - ROUTE DOMESTIC WATER SERVICE DOWN WITH PRV-2 AND BALL VALVE AT 24" A.F.F. AND ROUTE DOWN TO BELOW FLOOR. SEE SHEET P102 FOR CONTINUATION.
 - COORDINATE CHASE SIZE WITH GC FOR STORM DRAIN PIPE DOWN TO BELOW FLOOR. INSTALL WALL CLEANOUT AT MINIMUM 20" AFF. SEE SHEET P102 FOR CONTINUATION.
 - ROUTE 1" NATURAL GAS (LOW PRESSURE) LINE TO FURNACE. PROVIDE BALL VALVE, DRIP LEG, AND FINAL UNIT CONNECTION. COORDINATE CONNECTION WITH MC. SEE DETAIL 7/P501.
 - ROUTE 1 1/4" NATURAL GAS (LOW PRESSURE) LINE TO FURNACE. PROVIDE BALL VALVE, DRIP LEG, AND FINAL UNIT CONNECTION. COORDINATE CONNECTION WITH MC. SEE DETAIL 7/P501.
 - PROVIDE 3/4" CW WITH BALL VALVE TO CONNECTION FOR ROOF HYDRANT (FRH). COORDINATE WITH STRUCTURAL FOR INSTALLATION.
 - ROUTE 2" NATURAL GAS LINE (440 MBH, LOW PRESSURE) FROM EXISTING ROOF INTO NEW ADDITION. COORDINATE WITH GC AND STRUCTURAL FOR PENETRATION OF NATURAL GAS LINE THRU WALL.
 - COORDINATE CHASE SIZE WITH GC FOR STORM DRAIN PIPE. INSTALL FLOOR PIPE SUPPORT FOR ELBOW. INSTALL BOTTOM OF DOWNSPOUT NOZZLE AT 12" ABOVE GRADE. COORDINATE HEIGHT WITH GC.
 - PROVIDE 1/2" CW WITH STRAINER TO TRAP PRIMER (TP-1) IN ACCESSIBLE LOCATION IN MECHANICAL ROOM. ROUTE 1/2" LINE FROM UNIT TO FLOOR SINK IN THIS AREA. COORDINATE POWER WITH EC. SEE DETAIL 1/P501.
 - DUAL FUEL (NATURAL GAS & PROPANE) GENERATOR BY EC. ROUGH-IN AND MAKE FINAL GAS CONNECTIONS PER MANUFACTURER'S RECOMMENDATIONS.
 - 1 1/4" NG (2 PSI) WITH BALL VALVE, DRIP LEG, PRESSURE REGULATOR AND 1 1/4" NG (446 MBH, 11" W.C. PRESSURE) PIPE TO GENERATOR.
 - PROVIDE FLOOR MOUNTED PIPE SUPPORTS FOR NATURAL GAS AND PROPANE PIPES.
 - 1/2" PROPANE FROM TANKS TO 2-STAGE REGULATOR WITH 11" WATER COLUMN PRESSURE OUT (477.5 MBH). ROUTE REGULATOR VENT TO ROOF PER CODE. EMERSON FISHER REGULATOR MODEL R232A OR EQUAL.
 - INSTALL PROPANE GAS SENSOR (PCS-1) AT 4'-0" AFF AND INTERLOCK WITH RELAY PANEL. EXTERIOR ALARM BEACON MOUNTED TO RIGHT OF DOOR. SHUT-OFF BUTTON INSIDE OF DOOR AND 1" PROPANE GAS SOLENOID VALVE. COORDINATE WITH EC FOR 120V POWER TO RELAY, SENSOR AND SOLENOID VALVE.
 - PROVIDE 1/2" CW WITH STRAINER TO TRAP PRIMER (TP-1) IN ACCESSIBLE LOCATION. ROUTE 1/2" LINE FROM UNIT TO FLOOR DRAIN. COORDINATE POWER WITH EC. SEE DETAIL 1/P501.

- ### GENERAL NOTES
- COORDINATE WORK WITH ALL OTHER TRADES ON SITE.
 - CONTRACTOR SHALL COORDINATE ALL SAFEROOM SHELTER PENETRATIONS WITH STRUCTURAL. REFER TO STRUCTURAL DETAIL SHEET FOR PENETRATION PROTECTION FOR RECTANGULAR OPENINGS GREATER THAN 3.5 SQUARE INCHES AND CIRCULAR OPENINGS GREATER THAN 2.125 INCHES PER 2014 ICC-500.
 - SINK AND LAVATORY WATER SUPPLY STUB OUTS SHALL BE COPPER PIPE WITH SUPPORT BRACKET FASTENED IN WALL CAVITY.
 - FIRE SEAL ALL PENETRATIONS THRU RATED STRUCTURES TO MAINTAIN FIRE RATING.
 - REFER TO PLUMBING FIXTURE SCHEDULE ON SHEET P601 FOR FIXTURE ROUGH-IN PIPE SIZES AND ISOMETRIC SHEETS P301 AND P302.
 - PROVIDE ACCESS PANELS FOR ALL VALVES/DEVICES ABOVE HARD CEILINGS AND BEHIND WALLS.
 - ALL GAS PIPE SHALL COMPLY WITH IFGC. BRANCH LINES SHALL TAP OFF TOP OF GAS MAINS AND INSTALL SHUT-OFF VALVE ON BRANCH LINE.
 - TRAP PRIMER LINES SHALL BE COPPER TYPE "K" OR PEX-a TUBING WITH CONTINUOUS SLOPE TOWARDS DRAIN CONNECTION.
 - COORDINATE HEIGHT OF EXTERIOR FREEZELESS WALL HYDRANT (FWH) WITH GC AND/OR ARCHITECT. SEAL FIXTURE FLANGE WATERTIGHT.
 - INSULATE STORM DRAIN AND SLOPE DOWN AT 1/8" PER FOOT.
 - CLASSROOMS DESIGNATED AS LABORATORY WILL NOT UTILIZE CHEMICALS FOR CLASSROOM ACTIVITIES IN ANY FORM AS COMMUNICATED BY THE DISTRICT. THE PLUMBING SANITARY SYSTEM IS DESIGNED AROUND THIS DIRECTIVE FROM THE OWNER.

AGP

the Abila Griffin Partnership L.L.C.

313 S. E. 5th Street
MOORE, OK. 73160
405.735.3477
AGP@theAGP.net
www.theAGP.net

CEDAR CREEK
CIVIL
KFC ENGINEERING
STRUCTURAL
SALAS O'BRIEN
MECHANICAL / ELECTRICAL



drawn by
KS
checked by
KP
APRIL 2025
date

revisions
 1 08/19/2025 AD 08
 2 08/25/2025 CB 01
 3 01/16/2026 CB 06

MOORE PUBLIC SCHOOLS
BOARD OF EDUCATION
MOORE, OKLAHOMA




CLASSROOM ADDITION
CENTRAL JUNIOR
HIGH SCHOOL

sheet no:

P111

KEYPLAN
NO SCALE

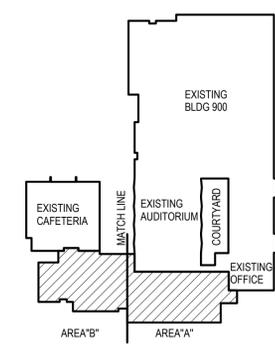

1 PLUMBING PLAN - ABOVE GRADE - AREA B
SCALE: 1/8" = 1'-0"



Salas O'Brien
2900 S. Telephone Road, Suite 120
Moore, OK 73160
Salas O'Brien Registration: CA# 7058
Expiration Date: 6/30/2025
Salas O'Brien Project Number: 2550-00564-00

OWNERSHIP USE OF DOCUMENTS:
AGP EXPRESSLY RESERVES ITS COPYRIGHT AND OTHER PROPERTY RIGHTS OF ALL PLANS AND DRAWINGS DESIGNED AND/OR PRODUCED. PLANS AND DRAWINGS ARE NOT TO BE REPRODUCED IN ANY FORM OR MANNER WITHOUT THE EXPRESSED WRITTEN CONSENT OF AGP.

