


**MOORE PUBLIC SCHOOLS -
CHILD CARE CENTER**

Moore Public Schools - Moore, Oklahoma
AGP - Moore, Oklahoma

ADDENDUM NO. 3

December 12, 2024

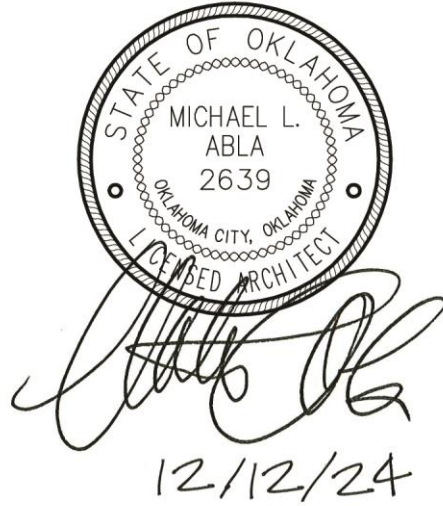

This addendum applicable to work designated herein, shall be understood to be an Addendum, and as such shall be included in the Contract Agreement.

Receipt of this Addendum shall be acknowledged by the Construction Management Firm notifying this office in writing, and by any applicable subcontractor to the CM.

This addendum consists of two (2) pages with attachments of five (5) 8.5"x11" pages and twenty-five (25) 24"x36" sheets.

A. Drawings:

General

1. Added Final Plat sheet for the Food Lion 5 Addition and current project building site.

Civil

1. Sheet C300, Site Plan – Parking Requirements: various revisions – replace sheet in its entirety. Refer to attachment.
2. Sheet C900, Site Details: added details, etc. – replace sheet in its entirety. Refer to attachment.

Structural

No changes.

Architectural

1. Sheet A100c, Detail 1, Existing Mezzanine Floor Plan: added sheet in its entirety. Refer to attachment.

2. Sheet A102, Life Safety Plan: revised Corridor Width Requirements. Refer to attachment.
3. Sheet A201, Details 1 thru 4, Exterior Elevations: revised details, cast letters at east elevation, and notes. Refer to attachment.

Mechanical, Electrical, and Plumbing

Refer to attachments.


Food Service Documents

No changes.


B. Specifications:

1. Section 10420-2.02-F.2 Cast Letters at Exterior: signage shall read **MOORE PUBLIC SCHOOLS – CHILD DEVELOPMENT CENTER** in lieu of MOORE PUBLIC SCHOOLS – CHILD CARE CENTER. Also, refer to Detail 1A201.

END OF ADDENDUM NO. 3

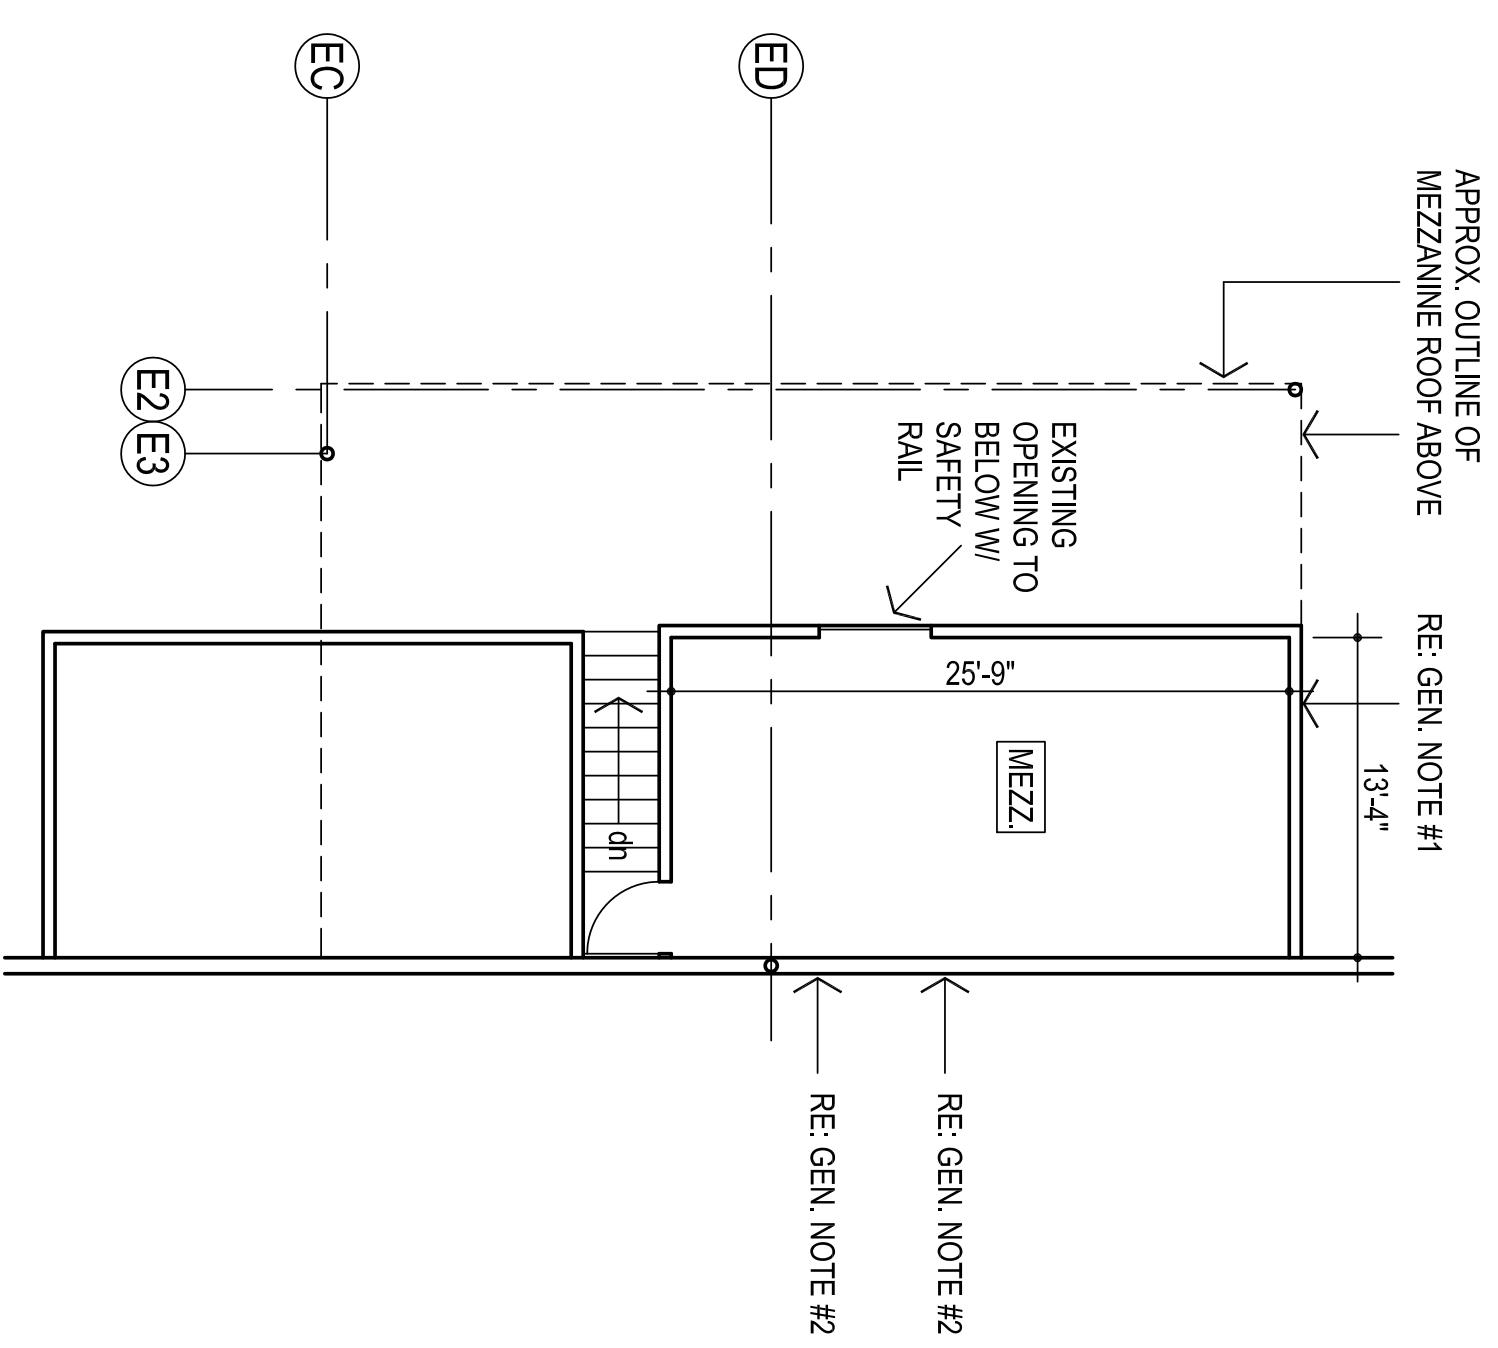

- GENERAL NOTES:
1. REMOVE EXISTING MECH. HOOD AND ASSOCIATED ASSOCIATED EQUIPMENT. PREPARE OPENING TO RECEIVE NEW IN-FILL FRAMING.
 2. REMOVE EXISTING MECH. LOUVER AND ASSOCIATED ASSOCIATED EQUIPMENT. PREPARE OPENING TO RECEIVE NEW IN-FILL FRAMING.
 3. AT ALL EXTERIOR WALLS ABOVE EXISTING ROOF DECK PROVIDE NEW 6" BATT INSULATION AND 5/8" GYP. BD. COORDINATE WITH ARCHITECT

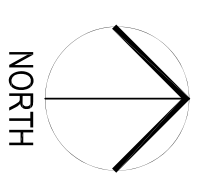

1

EXISTING MEZZANINE
1/8" = 1'-0"

AGP
the Abia Griffin
Partnership L.L.C.

313 S. E. 5th Street
MOORE, OK, 73160
405.735.3477
AGP@theACP.net
www.theACP.net


CEDAR CREEK
CIVIL

KFC ENGINEERING
STRUCTURAL

SALAS OBIEN
MECHANICAL / ELECTRICAL


Michael L. Moore
10/22/24

CG
drawn by _____
MA
checked by _____
OCTOBER 2024
date

revisions
 ADDENDUM #3




MOORE
PUBLIC SCHOOLS

CHILD CARE FACILITY
201 N. EASTERN AVE.

Sheet No.:

A100C

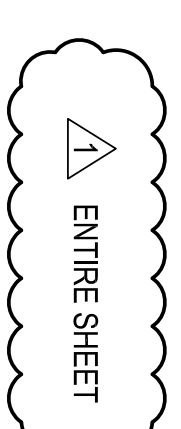

OWNERSHIP USE OF DOCUMENTS:
AGP EXPRESSLY RESERVES ITS
COPYRIGHT AND OTHER PROPERTY
RIGHTS OF ALL PLANS AND DRAWINGS
DESIGNED AND/OR PRODUCED. PLANS
AND DRAWINGS ARE NOT TO BE
REPRODUCED IN ANY FORM OR MANNER
WITHOUT THE EXPRESS WRITTEN
CONSENT OF AGP.

CONSTRUCTION DATA (TABLE 903):

OCCUPANCY -	E & I-4
CONSTRUCTION TYPE -	TYPE II - B
BASIC ALLOWABLE AREA -	E - 58,000 S.F. / I-4 - 82,000 S.F. PER FLOOR
ALLOWABLE STORIES -	3 / 3
ACTUAL STORIES -	1 / 1
ACTUAL HEIGHT -	23'-4"

BUILDING SIZES:
BUILDING : 1 STORY @ 32,200 S.F.

STRUCTURAL FIRE PROTECTION (TABLE 601):

EXTERIOR BEARING WALLS	0 HOUR
EXTERIOR NONBEARING WALLS	NONCOMBUSTIBLE
COLUMNS	NONCOMBUSTIBLE
BEAMS	0 HOUR
PERMANENT PARTITIONS	NONCOMBUSTIBLE
FLOOR ASSEMBLIES	0 HOUR
ROOF ASSEMBLIES	0 HOUR
EXTERIOR OPENINGS	N/A

PASSIVE FIRE SAFETY SYSTEM:
PORTABLE FIRE EXTINGUISHERS (REF: SHEETS A104)
TRAVEL DISTANCE = 250'-0" MAX.
ACTUAL MAX. TRAVEL DISTANCE = 170'-0"
DEADEND - 50'-0" MAX.
ACTUAL DEADEND - NONE

ACTIVE FIRE SAFETY SYSTEMS (EXISTING & NEW ADDITION):
FIRE SPRINKLER SYSTEM THROUGHOUT
FIRE ALARM SYSTEM
SMOKE DETECTION
AUTOMATIC AIR HANDLING EQUIP. SHUTDOWN
EXIT LIGHTS/EMERGENCY LIGHTS BATTERY

CODES/REGULATIONS USED (CITY OF MOORE):
2018 IBC - INTERNATIONAL BUILDING CODE
AMERICAN WITH DISABILITIES ACT ACCESSIBILITY GUIDELINES
2020 NATIONAL ELECTRICAL CODE
2018 INTERNATIONAL PLUMBING CODE
2018 INTERNATIONAL MECHANICAL CODE
2018 INTERNATIONAL FIRE CODE
2009 ENERGY CONSERVATION CODE
ASSOCIATED SUPPLEMENTS TO EACH CODE


OCCUPANT LOAD (TABLE 1004.1.1.1):
BUILDING RENOVATION: 278 CHILDREN
12 ADMIN / STAFF
40 TEACHERS
330 TOTAL OCCUPANTS

EGRESS WIDTH:
BUILDING RENOVATION: REQUIRED 66"
BUILDING RENOVATION: PROVIDED 432"

PLUMBING FIXTURES (TABLE 2902.1):

TOTAL OCCUPANT LOAD (INSTITUTIONAL) = 330	TOTAL PROVIDED
TOTAL REQUIRED:	WATER CLOSETS = 34
WATER CLOSETS = 22	URINALS = 0
LAVATORIES = 22	LAVATORIES = 49
DRINKING FOUNTAINS = 4	DRINKING FOUNTAINS = 4
SERVICE SINKS = 1	SERVICE SINKS = 2


DEVOTES 1-HR. RATED PARTITIONS CLOSE-OUT TO BOTTOM OF DECKING - CLOSE-OUT PARTITIONS TO BE CMU WHERE INDICATED ON STRUCTURAL FOR LOAD BEARING CONDITIONS. ALL OTHER INDICATED LOCATIONS TO BE CONSTRUCTED OF 1 LAYER OF 5/8" FIRE RATED GYP. BOARD EACH SIDE ON 6" METAL STUDS @ 16" O.C. STAGGER ALL JOINTS & PROVIDE FIRE TAPE SEAL. ALL PENETRATIONS W/ CONTINUOUS FIRE STOPPING INSULATION & OK SEALANT.

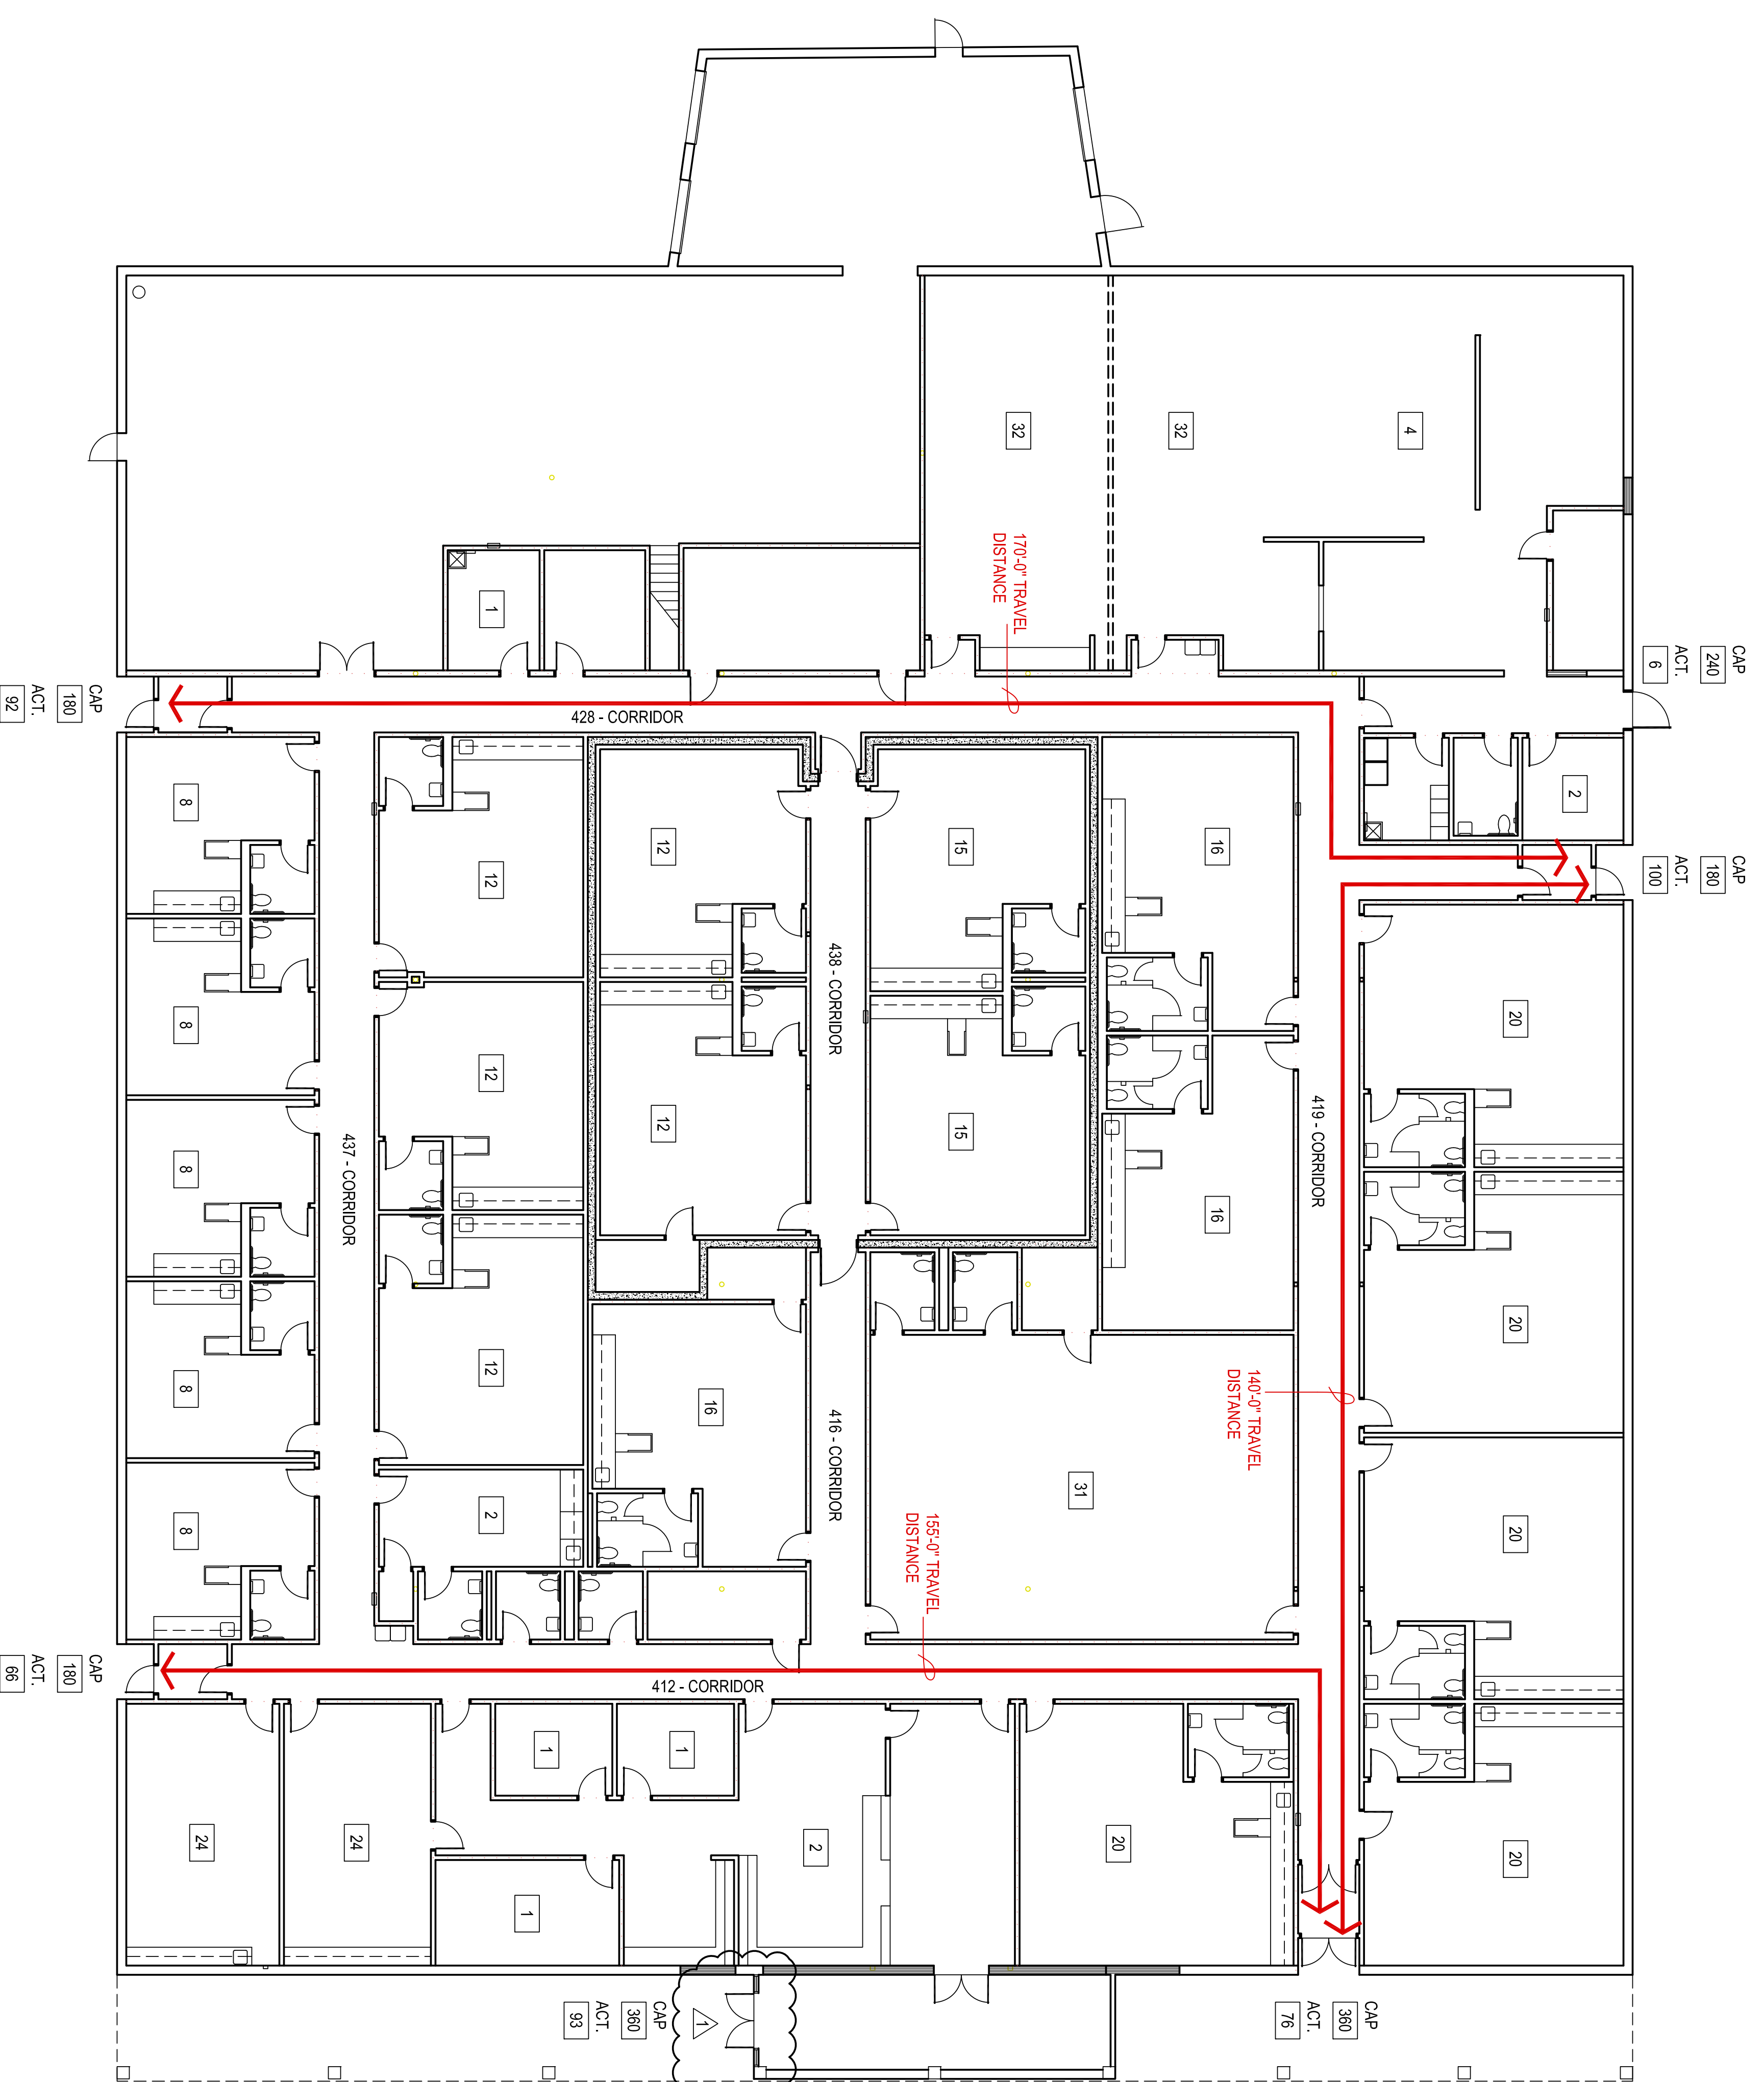

CORRIDOR WIDTH REQUIREMENTS:
*** DEVOTES NUMBER OF OCCUPANTS PER ROOM

412 - CORRIDOR : 78 MAX. OCCUPANTS X 0.20 = 16' REQD. / 72" PROVIDED
416 - CORRIDOR : 58 MAX. OCCUPANTS X 0.20 = 12' REQD. / 72" PROVIDED
419 - CORRIDOR : 100 MAX. OCCUPANTS X 0.20 = 20' REQD. / 60" PROVIDED
428 - CORRIDOR : 92 MAX. OCCUPANTS X 0.20 = 19' REQD. / 73" PROVIDED
437 - CORRIDOR : 46 MAX. OCCUPANTS X 0.20 = 10' REQD. / 72" PROVIDED

ALL CORRIDORS & EXIT DOORS EXCEED MINIMUM CLEARANCES AS REQUIRED BY IBC & ADA

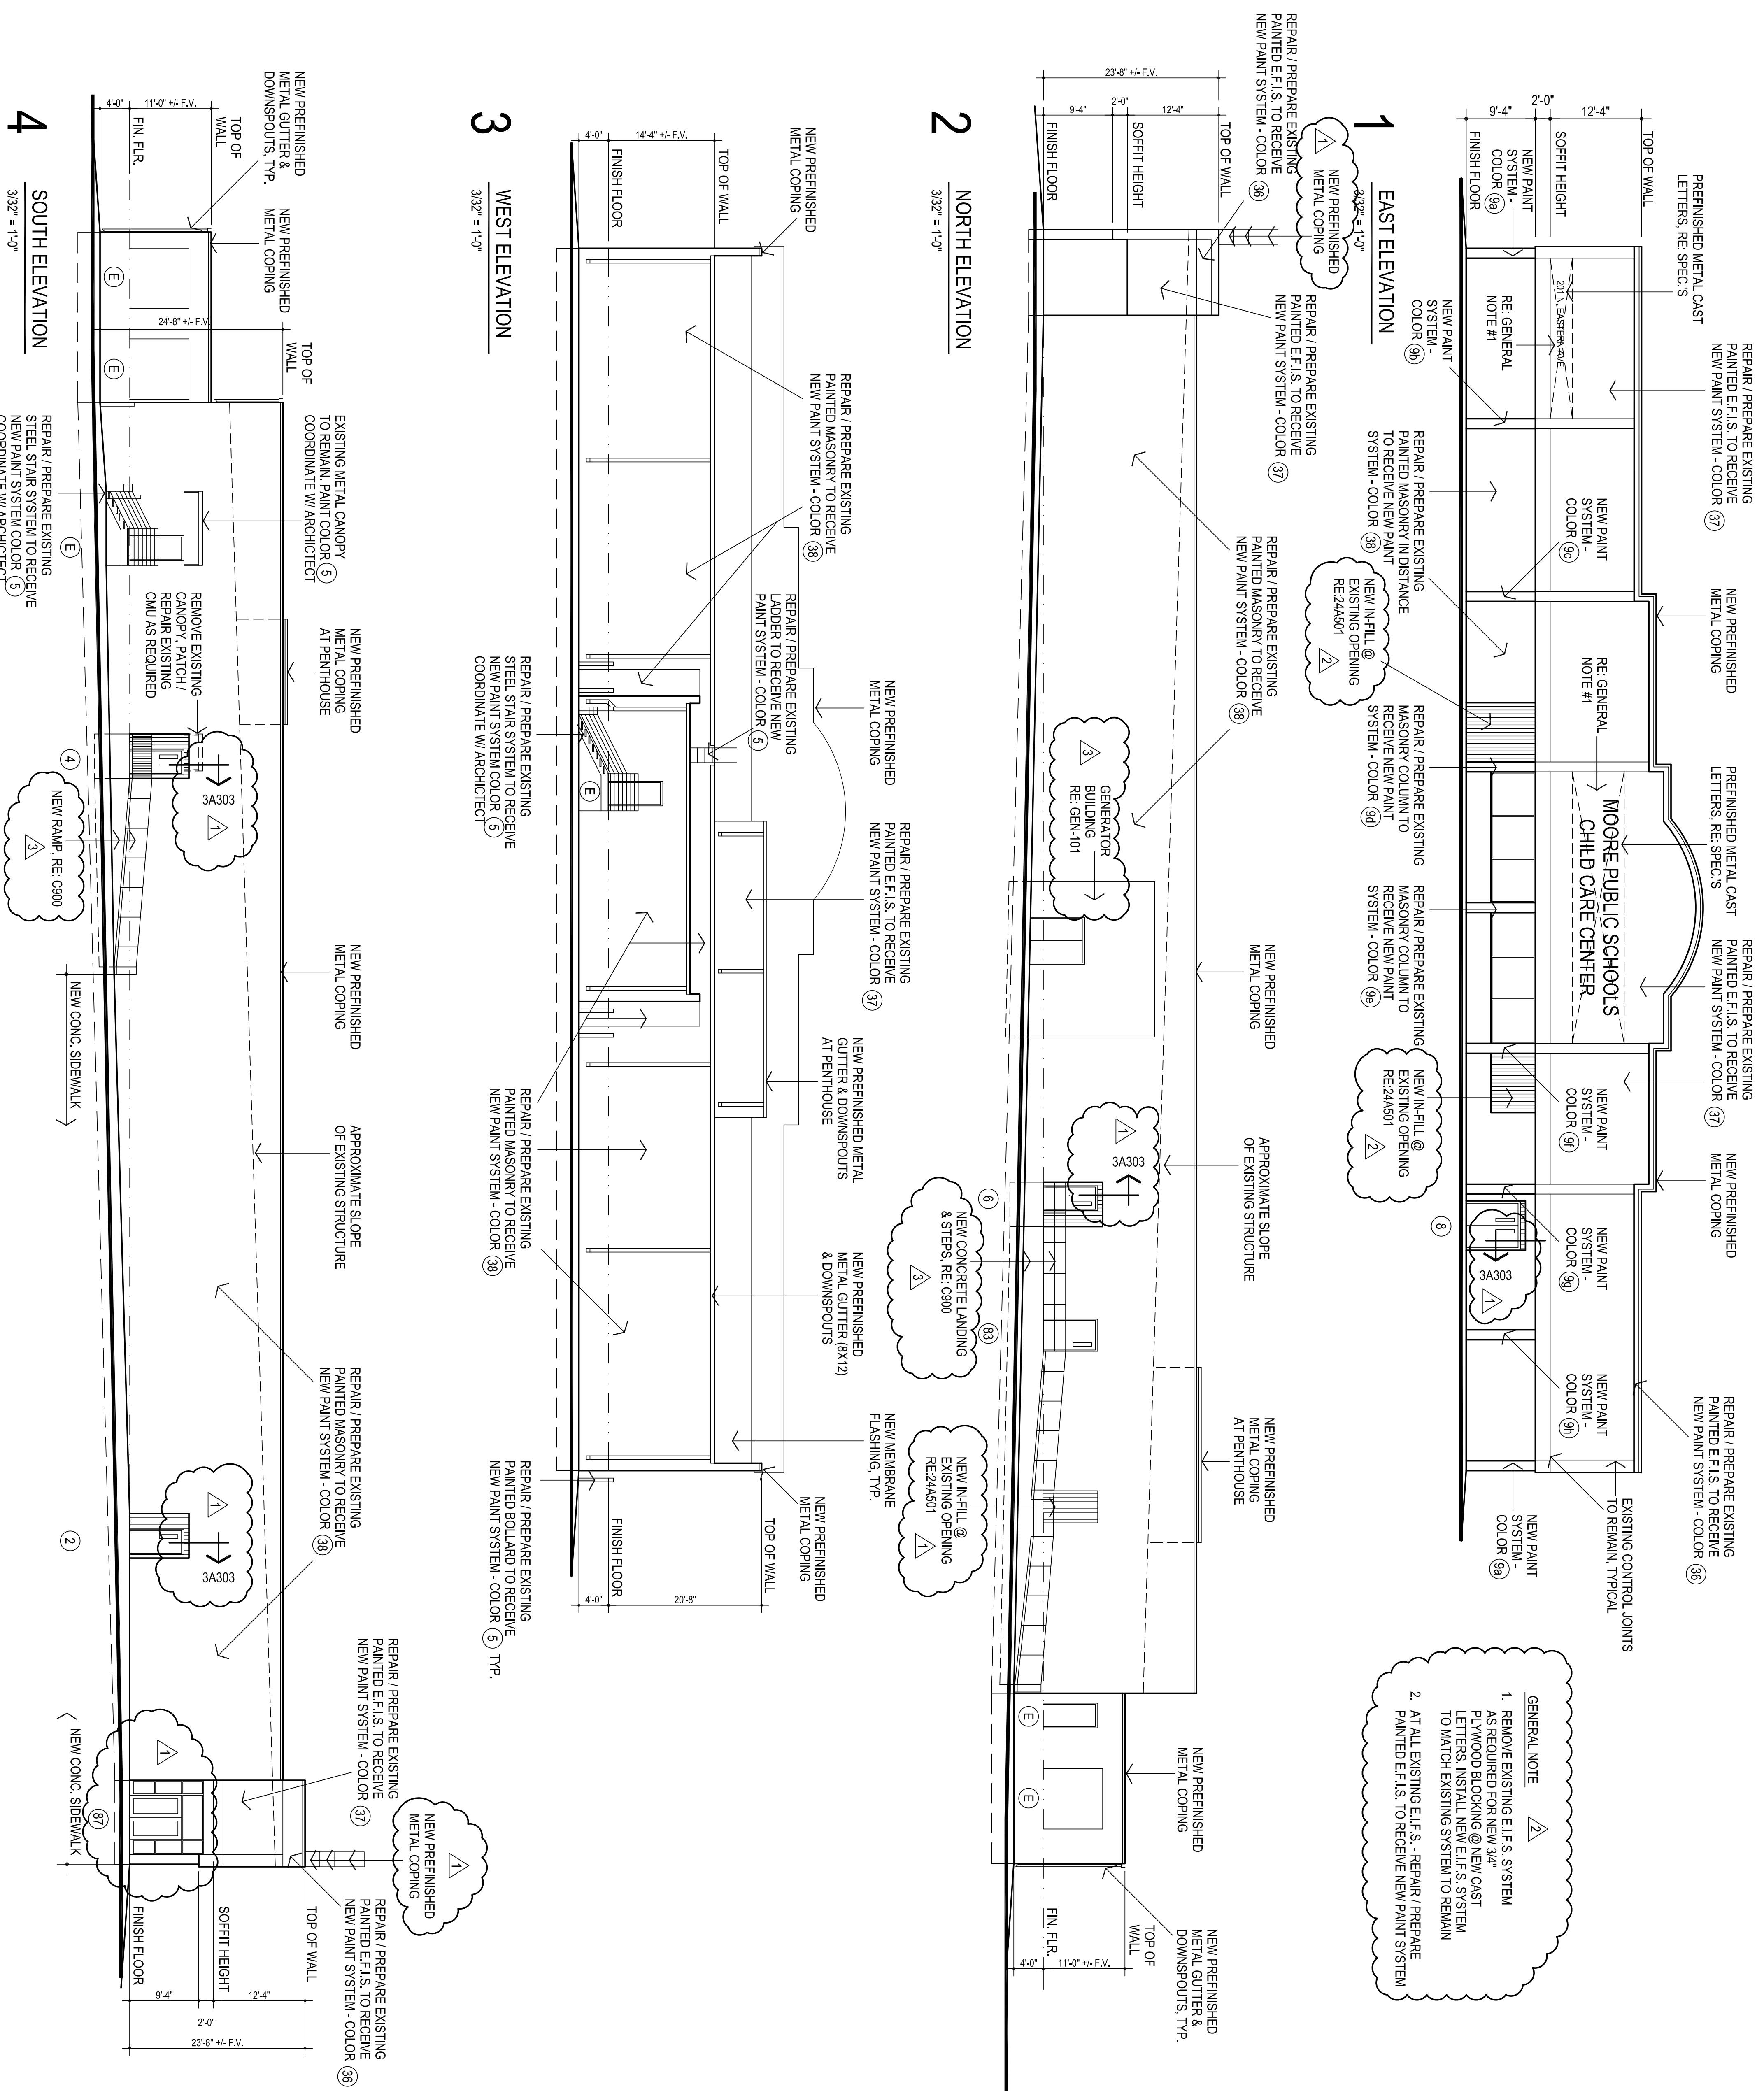

ADDENDUM 03

Issue Date: December 12, 2024

Project Information

Client: Abla Griffin Partnership
 Project Name: MPS Daycare
 Project Location: Moore, OK
 Owner: Moore Public Schools
 Engineer: Salas O'Brien, LLC

Project No. 2450-70304-00



To Prospective Bidders

This Addendum forms a part of the Contract Documents and modifies the Bidding Documents dated November 12, 2024, (and previous addenda), with amendments and additions noted below.

This Addendum consists of (3) pages and (20) attachments.

- Index of Attachments
 - Earthsmart Controls Proposal
 - M101 T403 E201 E602
 - M201 P001 E202
 - M501 P110 E203
 - M601 E000 E401
 - F101 E100 E502
 - T201 E101 E601

Acknowledge receipt of this Addendum in the space provided on the Bid Form. Failure to do so may disqualify Bidder.

CHANGES TO BIDDING REQUIREMENTS

The attached Earthsmart Temperature Control proposal shall be included as part of the mechanical bid for this project.



CHANGES TO THE DRAWINGS

Revisions have been made to the following drawings and are issued in the form of full-size plans. Edits are indicated by a revision delta and a cloud surrounding the affected portion of the drawing.

M101 – MECHANICAL FLOOR PLAN

- Refer to clouds and deltas on plan.

M201 – MECHANICAL ROOF PLAN

- Refer to clouds and deltas on plan.

M501 – MECHANICAL DETAILS

- Refer to clouds and deltas on plan.

M601 – MECHANICAL SCHEDULES

- Refer to clouds and deltas on plan.

F101 – Fire Protection Plan

- Refer to clouds and deltas on plan.

T201 – TECHNOLOGY FLOOR PLANS

- Refer to clouds and deltas on plan.

T403 – TECHNOLOGY SHEET SPECIFICATIONS

- Refer to clouds and deltas on plan.

P001 – PLUMBING SITE PLAN

- Refer to clouds and deltas on plan.

P110 – PLUMBING PLAN – ABOVE GRADE

- Refer to clouds and deltas on plan.

E000 – ELECTRICAL TITLE SHEET

- Refer to clouds and deltas on plan.

E100 – ELECTRICAL SITE PLAN

- Refer to clouds and deltas on plan.

E101 – ELECTRICAL LIGHTING PLAN

- Refer to clouds and deltas on plan.

E201 – ELECTRICAL POWER PLAN

- Refer to clouds and deltas on plan.

E202 – ELECTRICAL ROOF PLAN

- Refer to clouds and deltas on plan.



E203 – ELECTRICAL KITCHEN PLAN

- Refer to clouds and deltas on plan.

E401 – ELECTRICAL ONE-LINE DIAGRAM

- Refer to clouds and deltas on plan.

E502 – ELECTRICAL DETAILS SHEET

- Refer to clouds and deltas on plan.

E601 – ELECTRICAL SCHEDULES

- Refer to clouds and deltas on plan.

E602 – ELECTRICAL SCHEDULES

- Refer to clouds and deltas on plan.

END OF ADDENDUM [03]

EARTHSMART CONTROLS

5305 N Santa Fe Avenue
Oklahoma City, OK 73118

www.earthsmartcontrols.com

Phone: (405) 778-8008
Fax: (866) 676-5602

To: Moore Houchin Elementary Bidders
Attn: Estimator

November 26, 2024

This is a proposal to provide controls for the Moore Schools Childcare Facility project.

RTUs (16)

- Provide and install Honeywell controls.
- Install communication, controller, supply air sensor, fan status, compressor statuses, digital space temperature/humidity/ CO2 sensor to control outside air damper (damper actuator by others).
- Commission the units to ensure proper operation.

GPS Ionizers (16)

- Provide and install 16 new GPS-FC48-AC ionizers.
- Commission the unit to ensure proper operation.

Honeywell WEBS N4 Frontend

- Tie to existing WEB-8000 onsite and integrate N4 supervisor station (graphical user interface).
- Provide a 25 Device JACE to allow for future expansion.
- Provide 4 hours of user training.
- ***Provide 1-year parts and labor warranty.***
- Provide graphical representations of equipment listed above.
- Provide custom trending and alarming.
- Provide scheduling capabilities and remote access.

We thank you for the opportunity to bid and look forward to working with you soon.

If you have any questions, please feel free to contact us at (405) 778-8008.

Exclusions for total job: Any wiring above 24V, EF Controls, Kitchen equipment control, carbon monoxide sensors, smoke detectors, RTU damper actuators and anything not mentioned in this proposal.

Continued on next page...

CEARTHSMART CONTROLS

5305 N Santa Fe Avenue
Oklahoma City, OK 73118

www.earthsmartcontrols.com

Phone: (405) 778-8008
Fax: (866) 676-5602

The total price for the control work above is: \$72,710.00
Seventy-Two Thousand Seven Hundred and Ten Dollars



Erin Bevill
Controls Manager
EarthSmart Controls, LLC

Company: _____

Signature: _____

Date: _____

Printed Name: _____

Title: _____

PO #: _____



GENERAL NOTES



- COORDINATE INSTALLATION OF EQUIPMENT AND DUCTWORK WITH ALL TRADES.
- COORDINATE LOCATION OF THERMOSTATS WITH E.C. ROUGH-IN BY E.C.
- ALL PENETRATIONS OVER 3 1/2 SQUARE INCHES OR 2 1/16 INCHES IN DIAMETER IN/OUT OF SHELTER REQUIRE SHROUD. REFER TO STRUCTURAL FOR ALL SHROUD DETAILS.
- M.C. IS RESPONSIBLE TO ALL STRUCTURAL REQUIRED PENETRATION PROTECTION ITEMS FOR ALL MECHANICAL SYSTEMS PENETRATING THE SHELTER.
- E.C. TO PROVIDE, LOCATE, AND INSTALL SWITCH FOR EMERGENCY VENTILATION FAN. M.C. SHALL PROVIDE CALL OUT LETTERING "EMERGENCY VENTILATION" ON PLACARD ABOVE SWITCH WITH 3/4" LETTERING FOR INSTALLATION BY GC. COORDINATE WITH GC AND EC.

KEYED NOTES

- ROOF HOOD IS PART OF EMERGENCY VENTILATION SYSTEM. DUCT UP 16X12 TO TRANSITION INTO ROOF HOOD OPENING 18X16.
- MOTORIZED DAMPER TO BE 120V CONNECTED TO EMERGENCY POWER. DAMPER SHALL OPEN WHEN SUPPLY FAN TURNS ON.
- PROVIDE LOCKABLE COVER FOR THERMOSTAT.
- DUCT 18X20 SUPPLY AND 12X28 RETURN UP TO RTU.
- ROOF HOOD PART OF THE EMERGENCY VENTILATION SYSTEM TO PROVIDE RELIEF AIR. MOTORIZED DAMPER SHALL OPERATE ON INVERTER. INTERLOCK WITH SF-1. DUCT DOWN TO 16X12.
- MOUNT BOTTOM OF LOUVER MINIMUM 60" ABOVE LV-2. LOUVER CONNECTION FOR ENGINE EXHAUST.
- MOUNT BOTTOM OF LOUVER MINIMUM 18" AFF. LOUVER CONNECTION FOR RADIATOR EXHAUST.
- CARBON MONOXIDE DETECTOR TO BE INSTALLED ACCORDING TO ALL APPLICABLE CODES. DETECTOR SHALL BE INSTALLED CENTRALLY ON CEILING. ALSO INCLUDE BATTERY BACKUP IN EVENT PRIMARY POWER IS INTERRUPTED. ALARM SIGNAL SHALL BE ROUTED TO ADMINISTRATION OFFICE. COORDINATE WITH E.C. WITH PRIMARY POWER CONNECTION AND SYSTEM CONNECTION.
- PROVIDE EXHAUST DUCT TO GENERATOR RADIATOR CONNECTION. COORDINATE DUCT SIZE WITH GENERATOR MANUFACTURER DRAWINGS.
- PROVIDE DRYER VENT EXHAUST HOOD TERMINATION AT EXTERIOR WALL IN ACCORDANCE WITH DRYER MANUFACTURER'S REQUIREMENTS. PROVIDE WALL CAP WITH BIRD FILTER.
- DUCT 14" DIA. UP TO ROOF EXHAUST FAN OPENING. TRANSITION TO HOOD COLLAR PER KITCHEN SPECIFICATIONS.
- DOAS UNIT SHALL CYCLE DOWN TO TEMPER KITCHEN WHILE HOODS ARE OFF.
- DUCT 8"x8" MAKEUP AIR DUCT TO ROOF HOOD. INTERLOCK MOTORIZED DAMPER WITH POWER OF DRYER.
- MAKEUP AIR DUCT TO BE DUCTED DOWN BEHIND DRYERS TO 20" AFF. COVER DUCT OPENING WITH 1/4" WIRE MESH.
- PROVIDE UL-705 LISTED DRYER BOOSTER FAN OF FANTECH DBF 110 OR APPROVED EQUIVALENT. FAN SHALL PROVIDE MINIMUM OF 160 CFM. INTERLOCK FAN WITH POWER OF DRYER.
- PROVIDE EXTERNAL LINT TRAP OF FANTECH DBLT 4W OR EQUIVALENT AT DRYER EXHAUST CONNECTION.

2 MECHANICAL GENERATOR PLAN
SCALE: 1/4" = 1'-0"

SCALE: 1/4" = 1'-0"

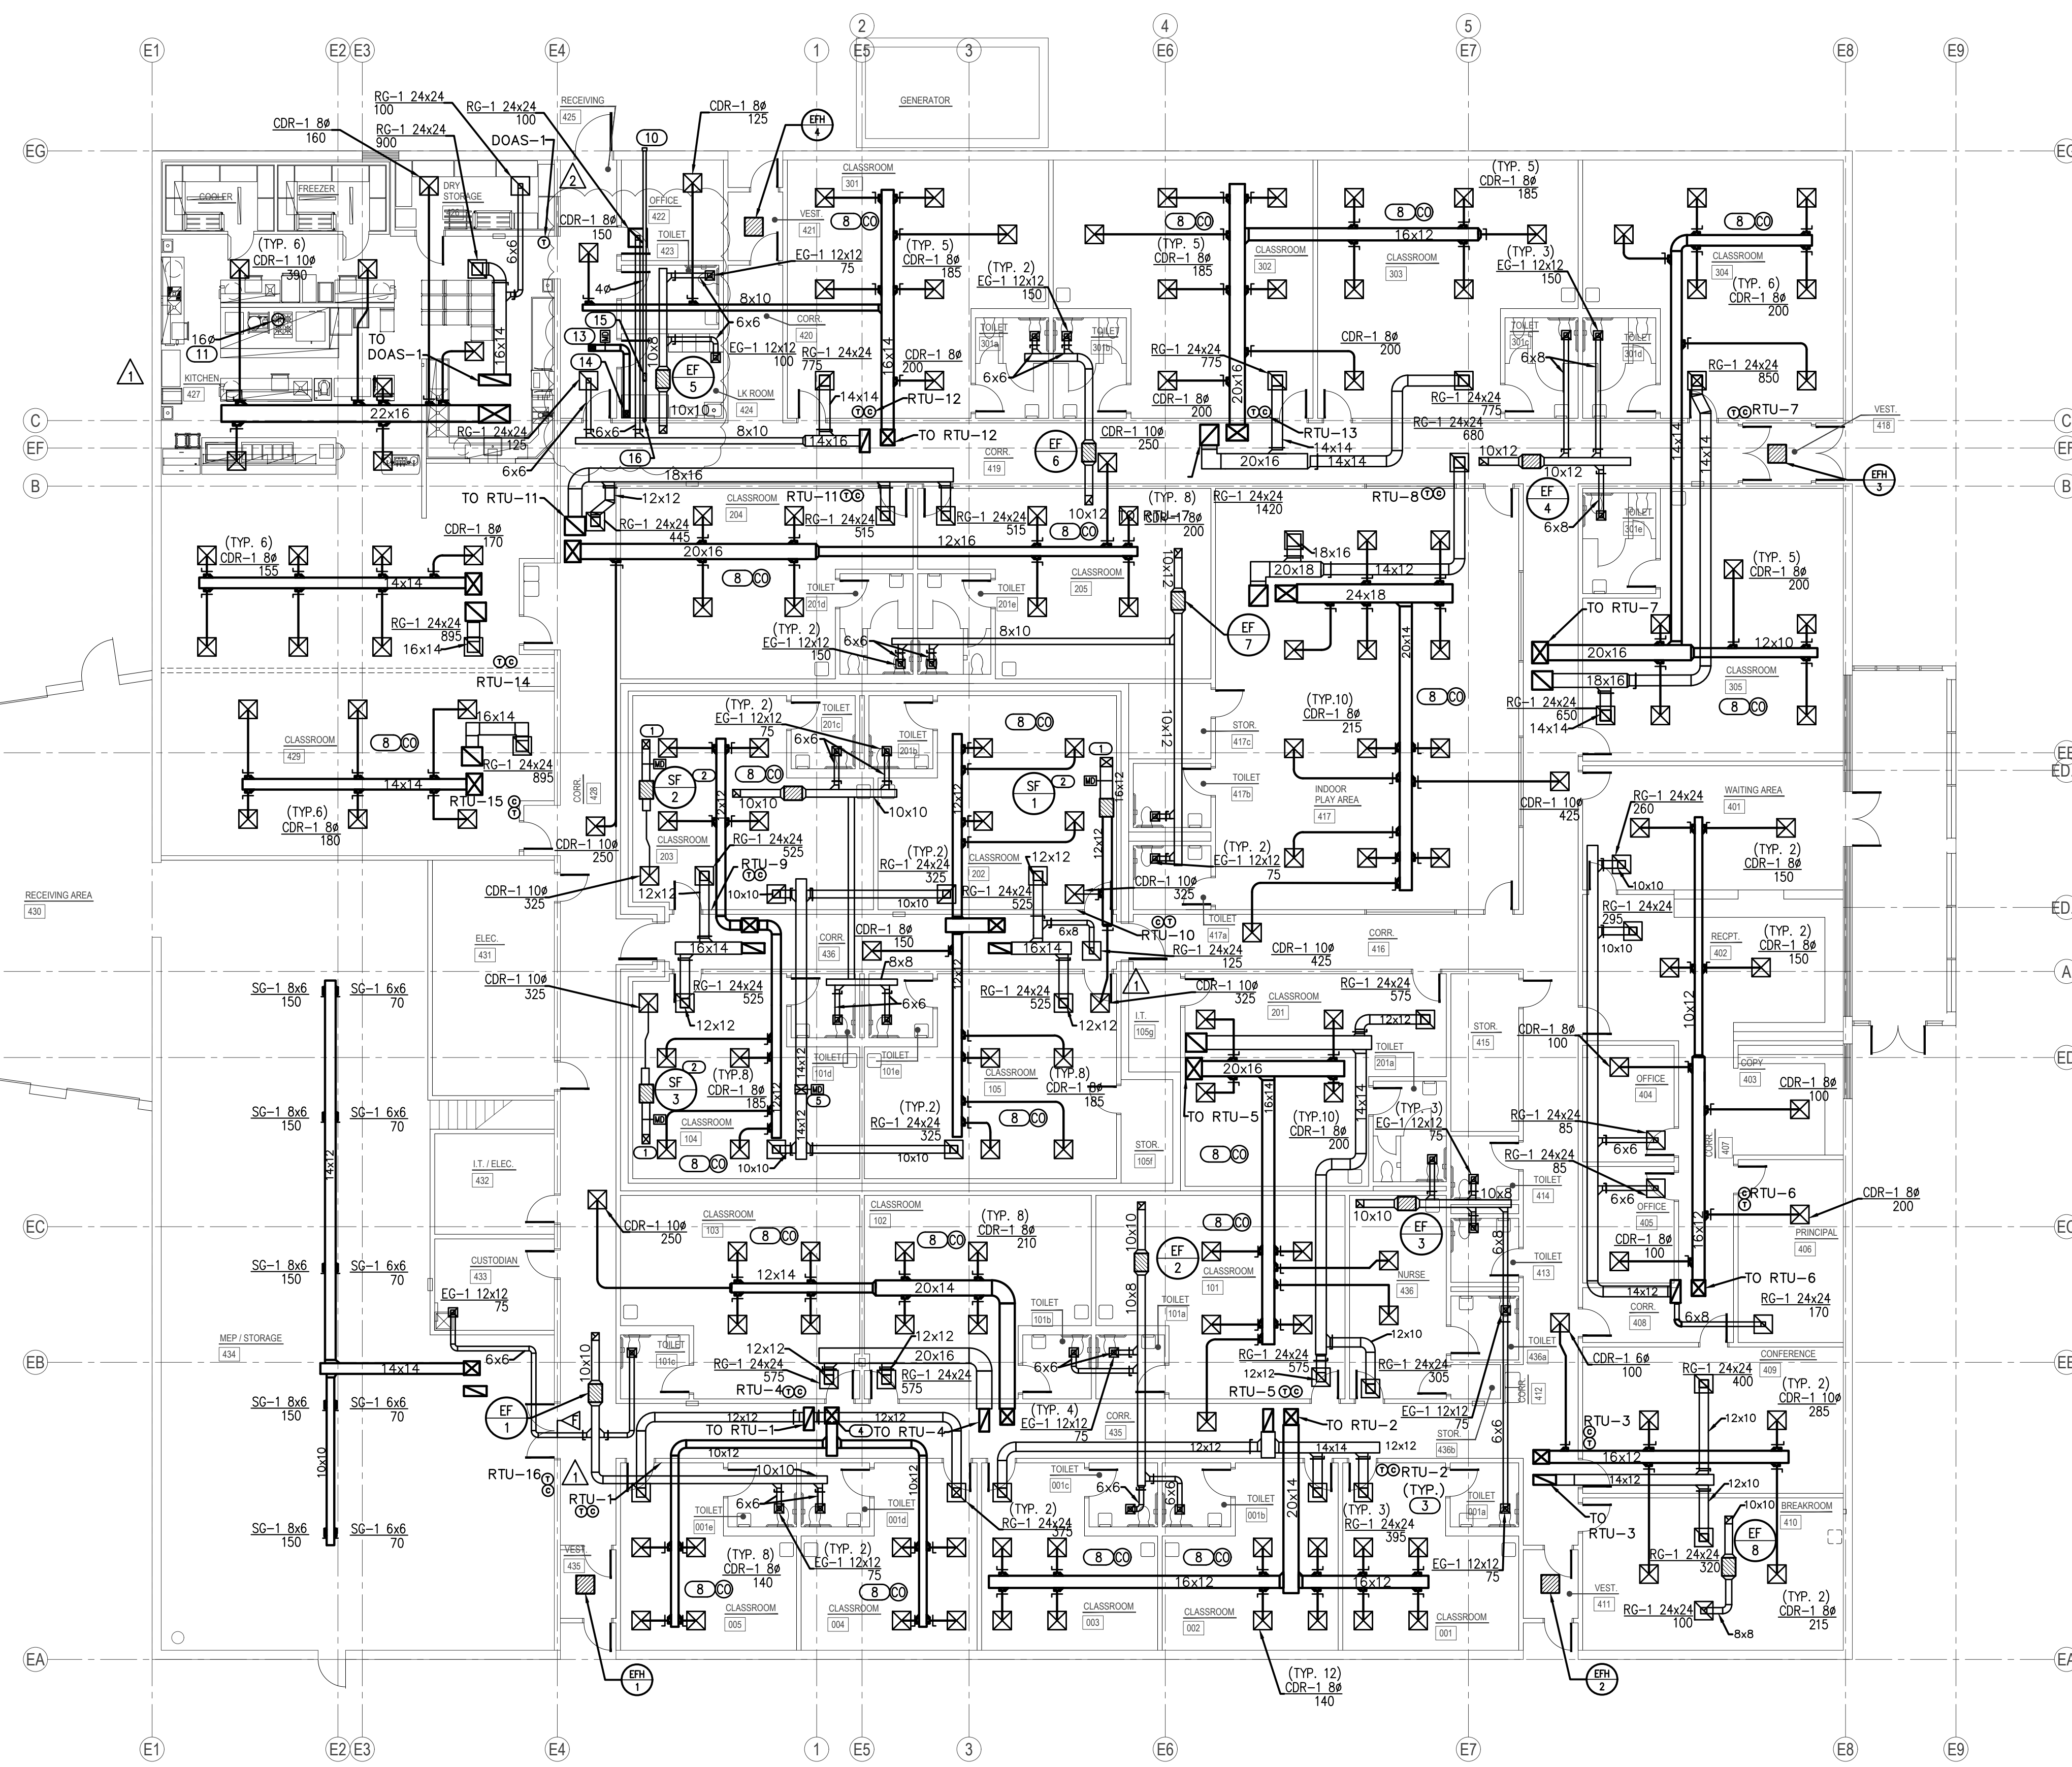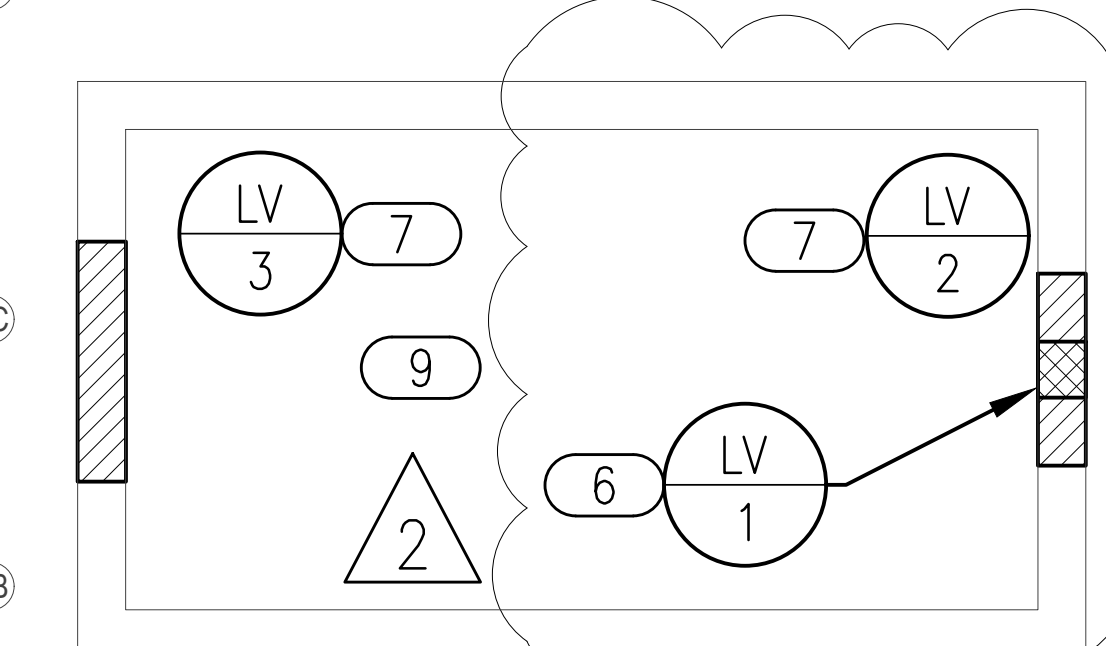


1 MECHANICAL FLOOR PLAN
SCALE: 3/32" = 1'-0"

SCALE: 3/32" = 1'-0"



Salas O'Brien
2900 S. Telephone Road, Suite 120
Moore, OK 73160
Salas O'Brien Registration: CA# 7058
Expiration Date: 6/30/2025
Salas O'Brien Project Number: 2450-70304-00

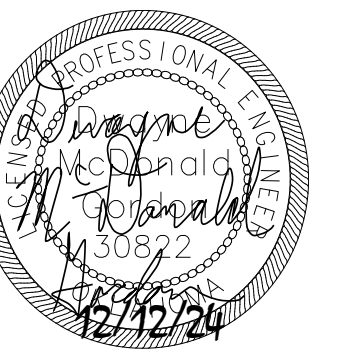

drawn by	KF
checked by	DG
date	OCTOBER 2024
revisions	
	1 11/22/2024 AD 02
	2 12/12/2024 AD 03



CHILD CARE FACILITY
201 N. EASTERN AVE.


sheet no:

M201

OWNERSHIP USE OF DOCUMENTS:
AGP EXPRESSLY RESERVES ITS COPYRIGHT AND OTHER PROPERTY RIGHTS OF ALL PLANS AND DRAWINGS DESIGNED AND/OR PRODUCED. PLANS AND DRAWINGS ARE NOT TO BE REPRODUCED IN ANY FORM OR MANNER WITHOUT THE EXPRESSED WRITTEN CONSENT OF AGP.

GENERAL NOTES

- ALL ROOF TOP EQUIPMENT TO BE LOCATED A MINIMUM OF 10'-0" AWAY FROM ROOF EDGE.
- MAINTAIN A MINIMUM OF 10'-0" HORIZONTAL CLEARANCE BETWEEN ALL EXHAUST OUTLETS AND ANY FRESH AIR INTAKES.
- MOUNT ROOF CURBS LEVEL ON PITCHED ROOF.
- ALL ROOF SUPPORT SYSTEMS ARE TO BE MANUFACTURED FOR THE ROOF MATERIAL/SYSTEM TO BE INSTALLED. REFER TO ARCH PLANS FOR THE ROOF SYSTEM. CURB INSTALLATION TO BE WARRANTED BY ROOFING CONTRACTOR.
- ALL PENETRATIONS OVER 3 1/2 SQUARE INCHES OR 2 1/16 INCHES IN DIAMETER IN/OUT OF THE SHELTER REQUIRE SHROUD. REFER TO STRUCTURAL FOR ALL SHROUD DETAILS.
- MC IS RESPONSIBLE FOR ALL STRUCTURAL REQUIRED PENETRATION PROTECTION ITEMS FOR ALL MECHANICAL SYSTEMS PENETRATING THE SHELTER.
- ROUTE ALL CONDENSATE TO NEAREST OPEN SITE DRAIN.

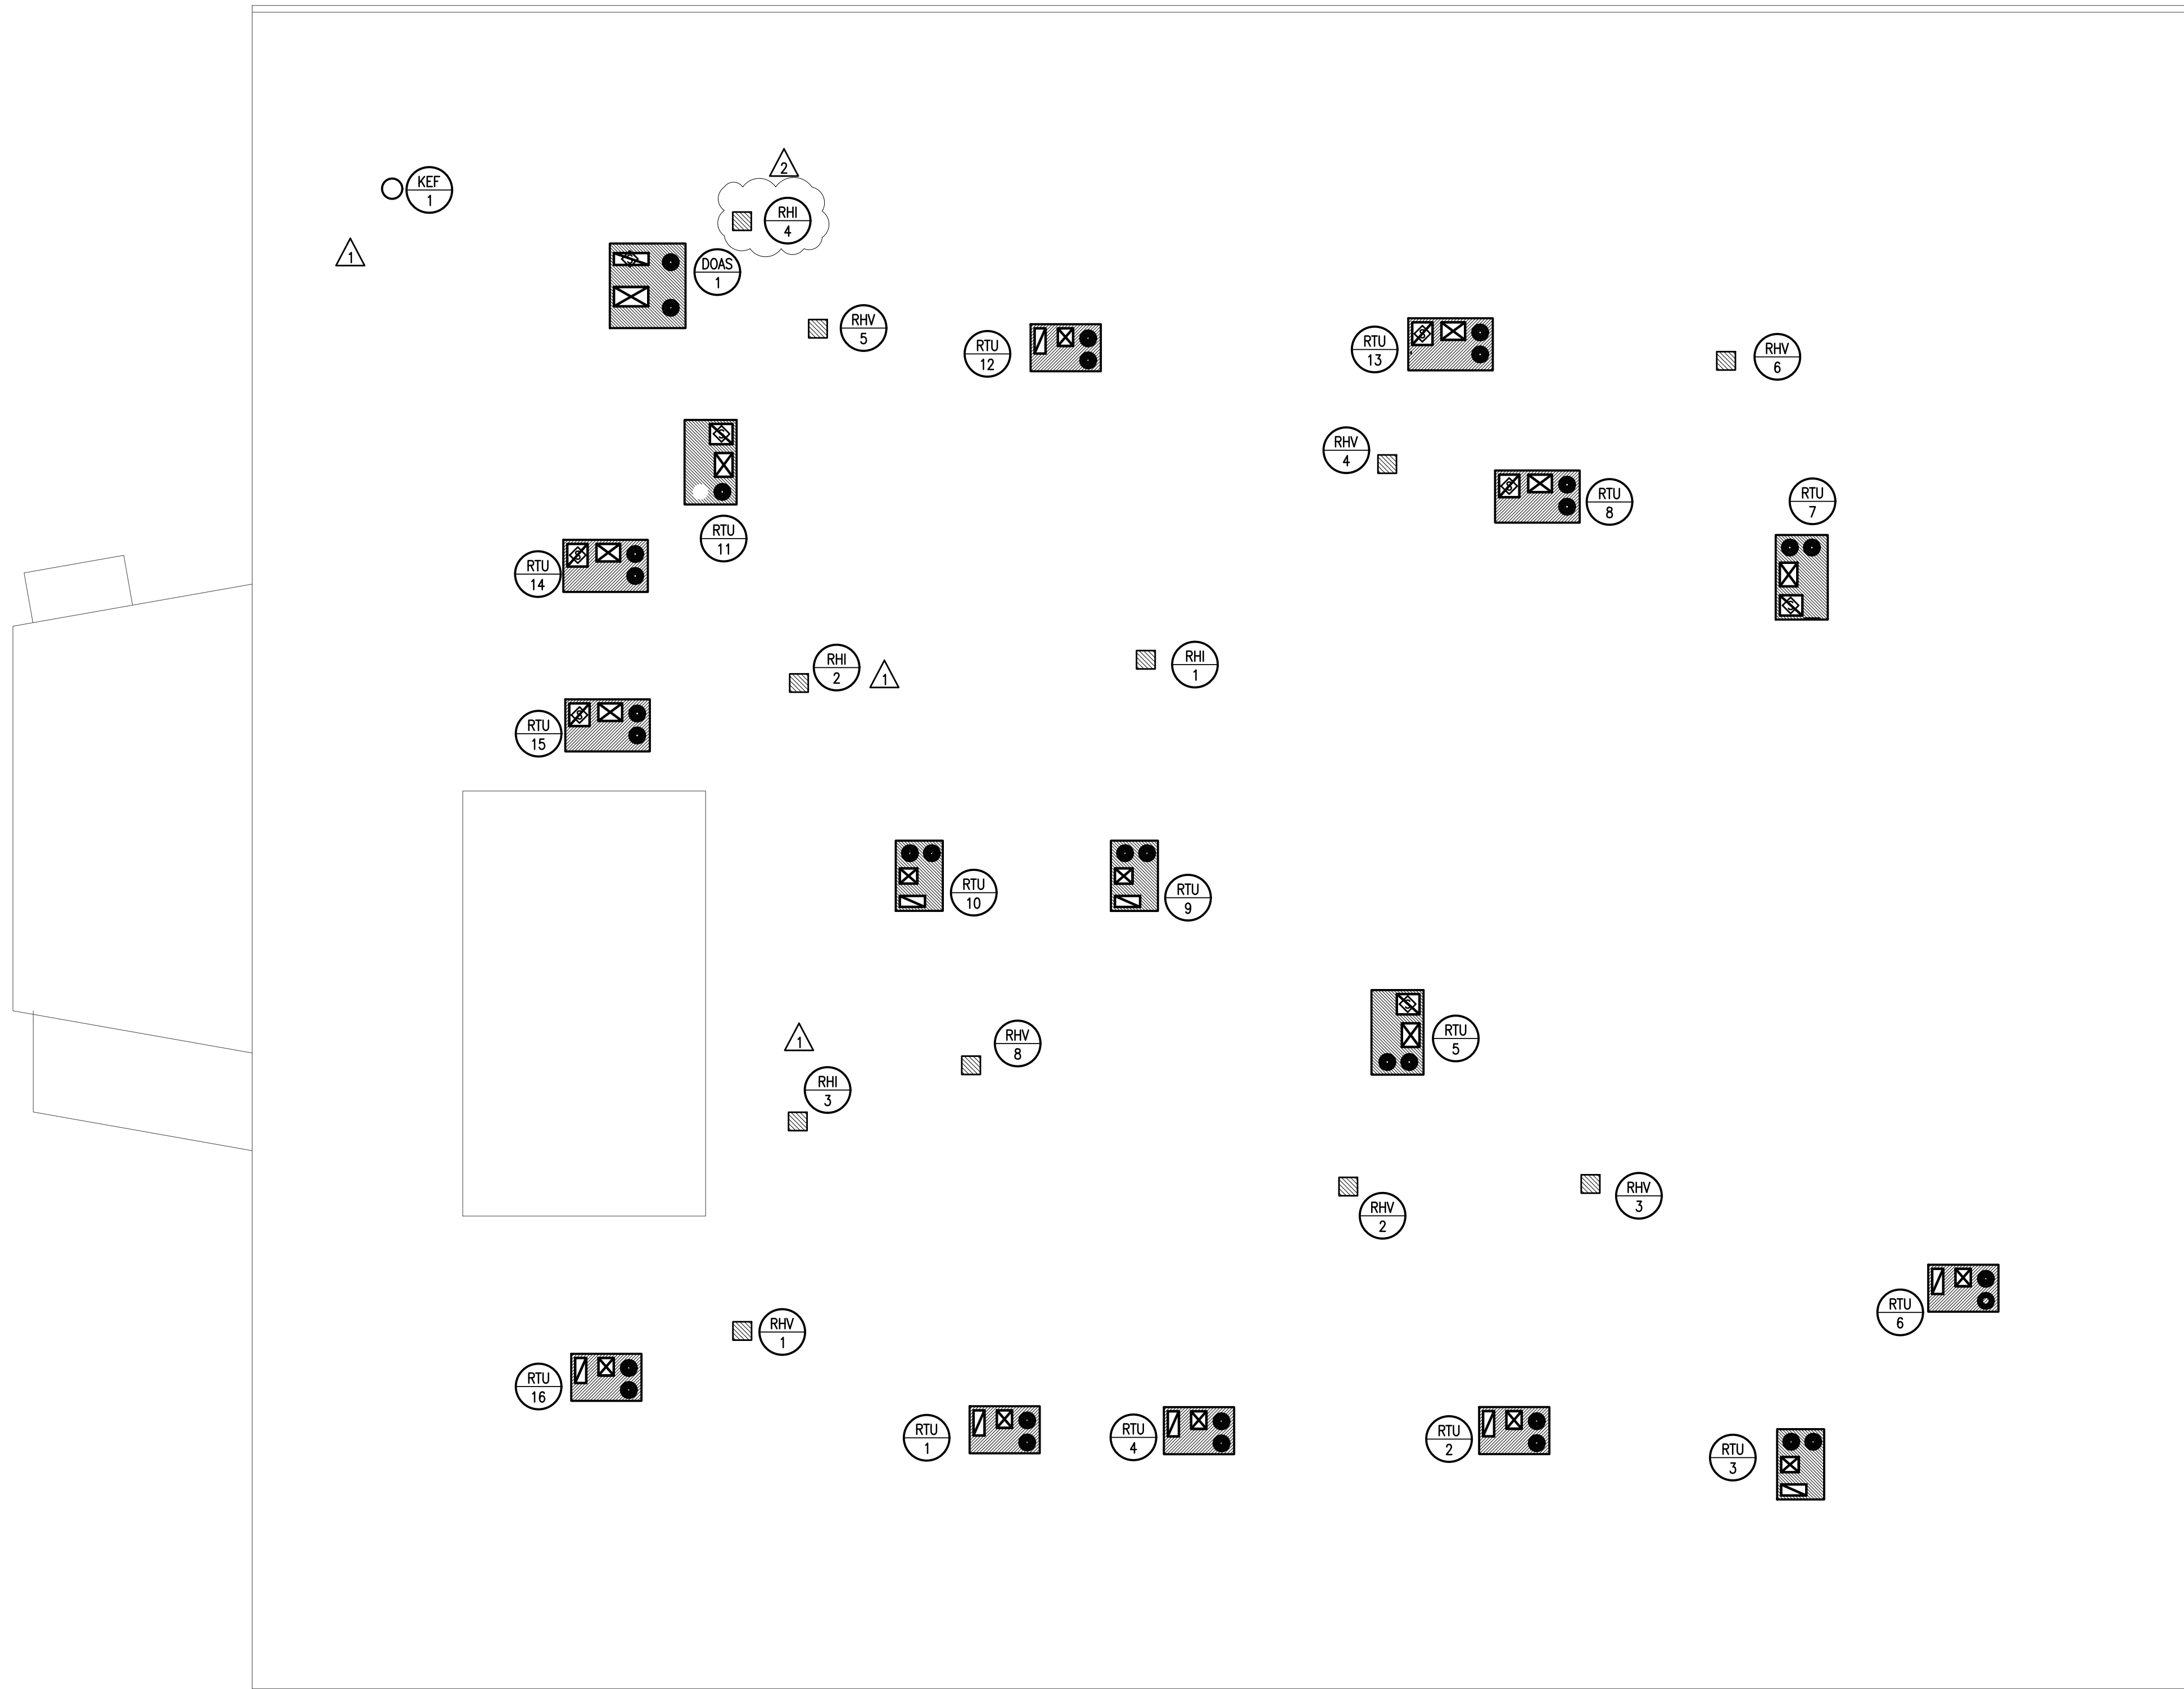

1 MECHANICAL ROOF PLAN

SCALE: 3/32" = 1'-0"



Salas O'Brien
2900 S. Telephone Road, Suite 120
Moore, OK 73160
Salas O'Brien Registration: CA# 7058
Expiration Date: 6/30/2025
Salas O'Brien Project Number: 2450-70304-00



drawn by	KF
checked by	DG
date	OCTOBER 2024
revisions	
	12/12/2024 AD 03




CHILD CARE FACILITY
201 N. EASTERN AVE.

sheet no:

M501

OWNERSHIP USE OF DOCUMENTS:
AGP EXPRESSLY RESERVES ITS COPYRIGHT AND OTHER PROPERTY RIGHTS OF ALL PLANS AND DRAWINGS DESIGNED AND/OR PRODUCED. PLANS AND DRAWINGS ARE NOT TO BE REPRODUCED IN ANY FORM OR MANNER WITHOUT THE EXPRESSED WRITTEN CONSENT OF AGP.

Salas O'Brien
2900 S. Telephone Road, Suite 120
Moore, OK 73160
Salas O'Brien Registration: CA# 7058
Expiration Date: 6/30/2025
Salas O'Brien Project Number: 2450-70304-00

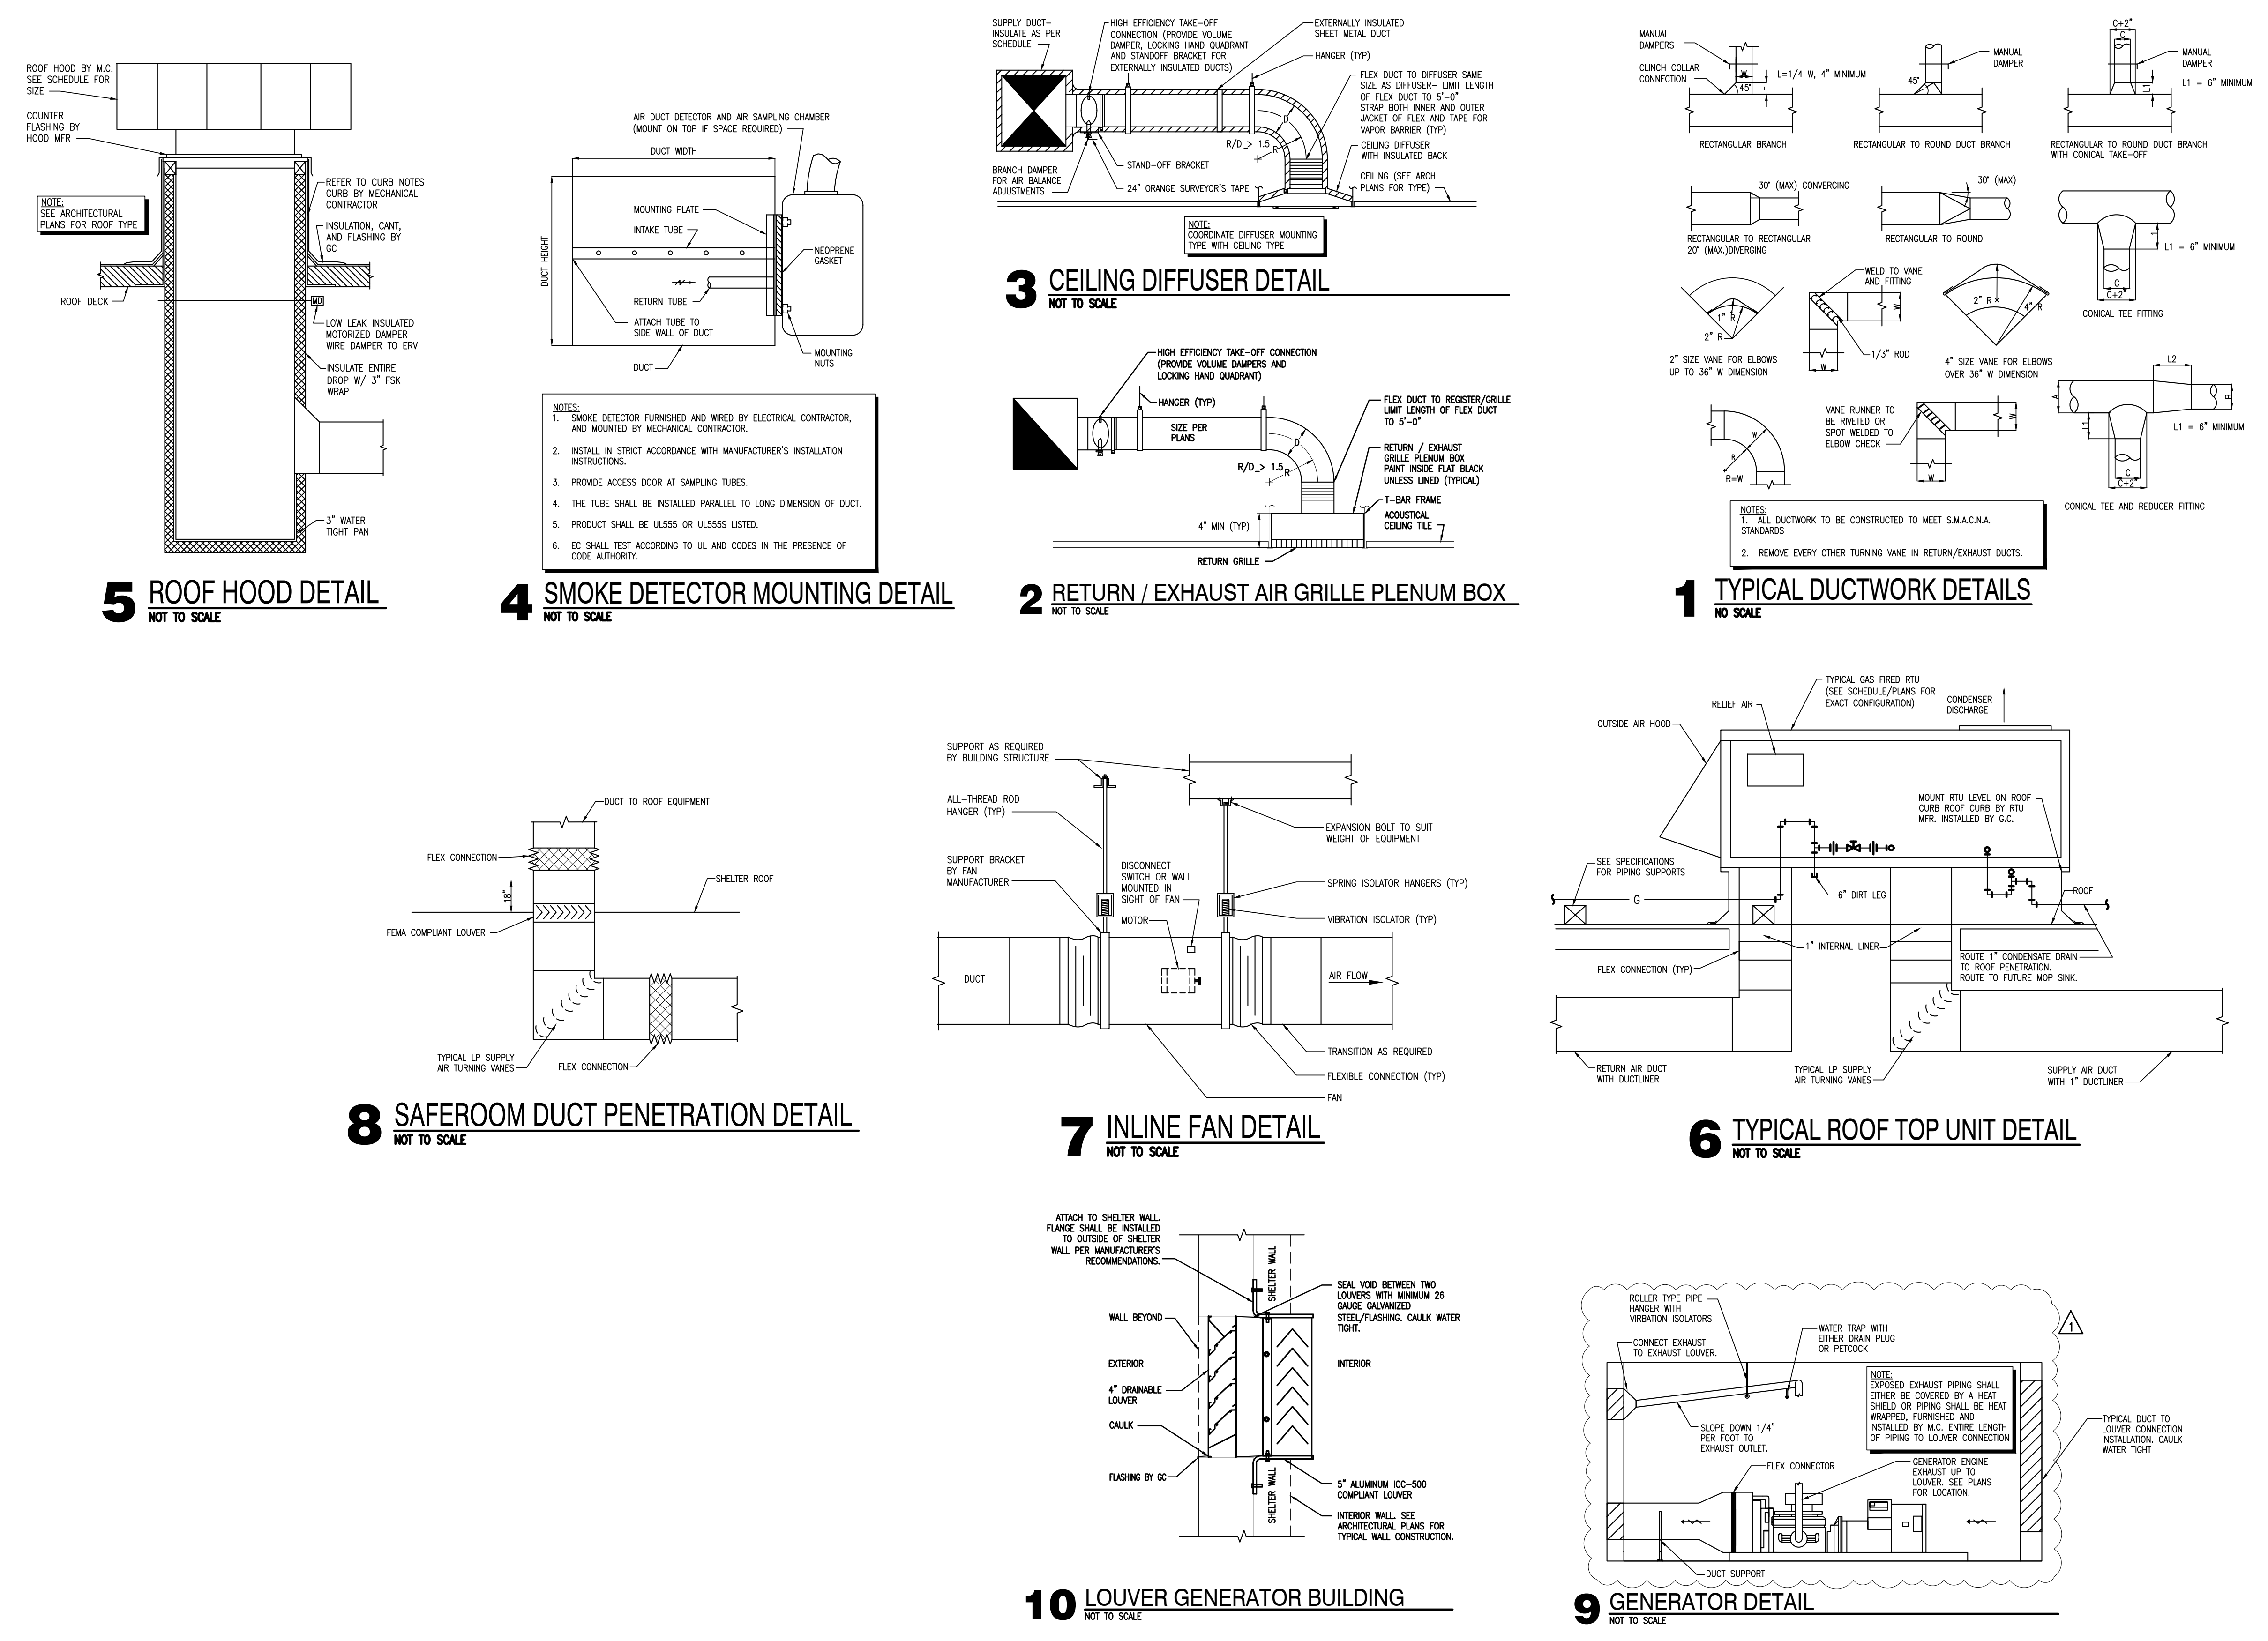

AGP EXPRESSLY RESERVES ITS COPYRIGHT AND OTHER PROPERTY RIGHTS OF ALL PLANS AND DRAWINGS DESIGNED AND/OR PRODUCED. PLANS AND DRAWINGS ARE NOT TO BE REPRODUCED IN ANY FORM OR MANNER WITHOUT THE EXPRESSED WRITTEN CONSENT OF AGP.



ROOF HOOD SCHEDULE							
ROOF HOOD SYMBOL	THROAT SIZE DIMENSION (N)	THROAT AREA (FP)	DAMPER ROD OR MOD	CONSTRUCTION	MANUFACTURER & MODEL NO.	COMMENTS	NOTES
RHH-1	14X14	1.36	MOD	ALUMINUM	GREENHECK FG	COLOR BY ARCHITECT	1-3
RHH-2	10X10	0.69	MOD	ALUMINUM	GREENHECK FG	COLOR BY ARCHITECT	1-3
RHH-3	10X10	0.69	MOD	ALUMINUM	GREENHECK FG	COLOR BY ARCHITECT	1-3
RHH-4	10X10	0.69	MOD	ALUMINUM	GREENHECK FG	COLOR BY ARCHITECT	1-3
RHV-1	10X10	0.69	MOD	ALUMINUM	GREENHECK FG	COLOR BY ARCHITECT	1-3
RHV-2	10X10	0.69	MOD	ALUMINUM	GREENHECK FG	COLOR BY ARCHITECT	1-3
RHV-3	10X10	0.69	MOD	ALUMINUM	GREENHECK FG	COLOR BY ARCHITECT	1-3
RHV-4	10X10	0.69	MOD	ALUMINUM	GREENHECK FG	COLOR BY ARCHITECT	1-3
RHV-5	10X10	0.69	MOD	ALUMINUM	GREENHECK FG	COLOR BY ARCHITECT	1-3
RHV-6	10X10	0.69	MOD	ALUMINUM	GREENHECK FG	COLOR BY ARCHITECT	1-3
RHV-7	14X14	1.36	MOD	ALUMINUM	GREENHECK FG	COLOR BY ARCHITECT	1-3

NOTES: M.C. IS RESPONSIBLE FOR PROVIDING ANY AND ALL NECESSARY DIMENSIONAL, ELECTRICAL, MECHANICAL, AND STRUCTURAL ALTERATIONS NECESSITATED BY PROVIDING ALTERNATE EQUIPMENT.
1. M.C. TO PROVIDE ROOF HOOD WITH ALUMINUM BIRDSCREEN.
2. M.C. SHALL PROVIDE ROOF CURB CURB INSTALLATION BY C.C.
3. M.C. SHALL PROVIDE LOW VOLTAGE MOTORIZED DAMPER.

LOUVER SCHEDULE								
CONNECTED TO	SIZE (N) W/OI	MINIMUM FREE AREA (FP)	FLANGE	CONSTRUCTION	INCLUDE MOD	MANUFACTURER AND MODEL NUMBER	COMMENTS	NOTES
1	GEN ENCLOSURE	18X18	0.71	YES	ALUMINUM	GREENHECK AFL-501	5" FEMA RATED LOUVER- PROVIDE ADDITIONAL DRAINABLE LOUVER (GREENHECK ESD-403)	1-2
2	GEN ENCLOSURE	48X30	4.33	YES	ALUMINUM	GREENHECK AFL-501	5" FEMA RATED LOUVER- PROVIDE ADDITIONAL DRAINABLE LOUVER (GREENHECK ESD-403)	1-2
3	GEN ENCLOSURE	60X72	14.98	YES	ALUMINUM	GREENHECK AFL-501	5" FEMA RATED LOUVER- PROVIDE ADDITIONAL DRAINABLE LOUVER (GREENHECK ESD-403)	1-2

NOTES: M.C. IS RESPONSIBLE FOR PROVIDING ANY AND ALL NECESSARY DIMENSION, ELECTRICAL, MECHANICAL, AND STRUCTURAL ALTERATIONS NECESSITATED BY PROVIDING ALTERNATE EQUIPMENT.
1. PROVIDE PAINTED KYNAR FINISH COLOR BY ARCHITECT.
2. PROVIDE BIRD SCREEN.

AIR BALANCE SCHEDULE			
EXHAUST		OUTDOOR AIR	
SOURCE	CFM	SOURCE	CFM
KEF-1	2500	DOAS-1	2400
EF-1	225	RTU-1	350
EF-2	300	RTU-2	520
EF-3	375	RTU-3	280
EF-4	450	RTU-4	535
EF-5	300	RTU-5	645
EF-6	175	RTU-6	205
EF-7	300	RTU-7	700
EF-8	100	RTU-8	900
DRYER	160	RTU-9	450
-	-	RTU-10	535
-	-	RTU-11	625
-	-	RTU-12	400
-	-	RTU-13	710
-	-	RTU-14	205
-	-	RTU-15	205
-	-	RTU-16	205
TOTAL:	4885		9870

PACKAGED ROOFTOP GAS/ELECTRIC UNIT SCHEDULE																
LOCATION	INPUT MBH	OUTPUT MBH	COOLING NOMINAL TONS	AMBIENT TEMP. DB/MB	WALL EER	CAPACITY STAGES	TOTAL CFM	MIN F.A. CFM	ELEC. CHGR	MCA	MOCP	ESP (N)	WEIGHT	MANUFACTURER & MODEL NUMBER	NOTES	
1	ROOF-SEE PLANS	65	52	3	104 / 74	14.3	2(H)/1(C)	1100	350	208 / 3	19	25	1.0	900	LENNOX LGM036USE	1,2,4-12
2	ROOF-SEE PLANS	108	87	5	104 / 74	12.5	2(H)/1(C)	1880	520	208 / 3	26	40	1.0	905	LENNOX LGM060USE	1,2,4-12
3	ROOF-SEE PLANS	65	52	3	104 / 74	14.3	2(H)/1(C)	1100	280	208 / 3	19	25	1.0	900	LENNOX LGM036USE	1,2,4-12
4	ROOF-SEE PLANS	108	87	5	104 / 74	12.5	2(H)/1(C)	1700	535	208 / 3	26	40	1.0	905	LENNOX LGM060USE	1,2,4-12
5	ROOF-SEE PLANS	180	144	7.5	104 / 74	12.5	2(H)/1(C)	2100	645	208 / 3	46	50	1.0	1500	LENNOX LGM092USE	1-12
6	ROOF-SEE PLANS	65	52	3	104 / 74	14.3	2(H)/1(C)	1100	205	208 / 3	19	25	1.0	900	LENNOX LGM036USE	1,2,4-12
7	ROOF-SEE PLANS	180	144	7.5	104 / 74	12.5	2(H)/1(C)	2200	700	208 / 3	46	50	1.0	1500	LENNOX LGM092USE	1-12
8	ROOF-SEE PLANS	180	144	8.5	104 / 74	12.5	2(H)/1(C)	3000	900	208 / 3	48	50	1.0	1500	LENNOX LGM102USE	1-12
9	ROOF-SEE PLANS	108	87	4	104 / 74	13.2	2(H)/1(C)	1500	450	208 / 3	25	35	1.0	905	LENNOX LGM048USE	1,2,4-12
10	ROOF-SEE PLANS	108	87	5	104 / 74	12.5	2(H)/1(C)	1700	535	208 / 3	26	40	1.0	905	LENNOX LGM060USE	1,2,4-12
11	ROOF-SEE PLANS	180	144	7.5	104 / 74	12.5	2(H)/1(C)	2100	625	208 / 3	46	50	1.0	1500	LENNOX LGM092USE	1-12
12	ROOF-SEE PLANS	108	87	4	104 / 74	13.2	2(H)/1(C)	1400	400	208 / 3	25	35	1.0	905	LENNOX LGM048USE	1,2,4-12
13	ROOF-SEE PLANS	180	144	7.5	104 / 74	12.5	2(H)/1(C)	2200	710	208 / 3	46	50	1.0	1500	LENNOX LGM092USE	1-12
14	ROOF-SEE PLANS	65	52	3	104 / 74	14.3	2(H)/1(C)	1100	205	208 / 3	19	25	1.0	900	LENNOX LGM036USE	1,2,4-12
15	ROOF-SEE PLANS	65	52	3	104 / 74	14.3	2(H)/1(C)	1100	205	208 / 3	19	25	1.0	900	LENNOX LGM036USE	1,2,4-12
16	ROOF-SEE PLANS	65	52	3	104 / 74	14.3	2(H)/1(C)	1100	205	208 / 3	19	25	1.0	900	LENNOX LGM036USE	1,2,4-12

NOTES: M.C. IS RESPONSIBLE FOR PROVIDING ANY AND ALL NECESSARY DIMENSIONAL, ELECTRICAL, MECHANICAL, AND STRUCTURAL ALTERATIONS NECESSITATED BY PROVIDING ALTERNATE EQUIPMENT.
1. PROVIDE CONDENSER COIL HALL GUARD.
2. PROVIDE FACTORY-INSTALLED UNIT DISCONNECT SWITCH.
3. PROVIDE FACTORY-INSTALLED RETURN DUCT SMOKE DETECTOR WITH REMOTE TEST STATION TO BE LOCATED IN OCCUPIED SPACE. INSTALLATION OF REMOTE TEST STATION AND CONNECTION TO FIRE ALARM SYSTEM BY E.C.
4. PROVIDE FACTORY-INSTALLED 120V GFCI CONVENIENCE OUTLET. GFCI POWERED FROM UNIT. RECEPTACLE SHALL BE COMPLIANT WITH NEC 210.63.
5. PROVIDE ANTI-SHORT CYCLE TIMER AND LOW AMBIENT CONTROLS.
6. PROVIDE FACTORY ROOF CURB SO THAT THE BOTTOM OF THE ROOFTOP UNIT IS A MINIMUM OF 14" ABOVE FINISHED ROOF. MINIMUM LEVEL ON SLOPED ROOF.
7. PROVIDE HINGED AND TOOL-LESS ACCESS DOORS.
8. PROVIDE PHASE MONITOR.
9. PROVIDE FULL ENTHALPHY ECONOMIZER WITH POWERED EXHAUST.
10. PROVIDE DIGITAL, W-FI ACCESSIBLE 7-DAY PROGRAMMABLE THERMOSTAT WITH OCCUPIED/UNOCCUPIED SETTINGS CAPABLE OF CONTROLLING THE H/C STAGES OF SPECIFIED UNIT.
11. PROVIDE UNIT WITH HGRN.
12. MODULATE OUTSIDE AIR BASED ON DEMAND REPORTED BY CO2 SENSOR.

GRILLE, REGISTER, AND DIFFUSER SCHEDULE					
PLAN SYMBOL	DESCRIPTION	MANUFACTURER & MODEL NO.	MATERIAL	FINISH	NOISE CRITERIA
GR-1	SQUARE FACE, ROUND NECK, 4-WAY DEFLECTION CEILING DIFFUSER, SPRING LOCK INNER CORE, FOR LAY-IN CEILING INSTALLATION.	PRICE SCD (4C)	STEEL	WHITE	-
SG-1	DOUBLE DEFLECTION SIDEWALL GRILLE, ADJUSTABLE DEFLECTION BLADES, 3/4" O.C. FLAT FRAME WITH 1 1/4" MARGIN, HORIZONTAL FRONT.	PRICE 520	STEEL	COLOR BY ARCHITECT	-
RG-1	SQUARE PATTERN GRILLE, FIXED CORE OF 1/2"x1/2"x1/2" FABRICATED ALUMINUM SQUARES, FLAT FRAME WITH 1 1/4" MARGIN, FOR LAY-IN CEILING INSTALLATION.	PRICE 80	ALUMINUM	WHITE	-
RG-2	SQUARE PATTERN GRILLE, ZERO DEGREE DEFLECTION, FLAT STEEL FRAME WITH 1 1/4" BORDER, FOR SURFACE MOUNT INSTALLATION.	PRICE 80	STEEL	WHITE	-
EG-1	SQUARE PATTERN GRILLE, FIXED CORE OF 1/2"x1/2"x1/2" FABRICATED ALUMINUM SQUARES, FLAT FRAME WITH 1 1/4" MARGIN, FOR LAY-IN CEILING INSTALLATION.	PRICE 80	ALUMINUM	WHITE	-

NOTES:
SEE PLANS FOR QUANTITY AND SIZES.
M.C. TO FIELD VERIFY CEILING TYPE FOR ALL GRD BEFORE PURCHASING EQUIPMENT. PROVIDE REQUIRED MOUNTING.

SYSTEM	LOW PRESSURE			MED. PRESS.			HIGH PRESS.			INSULATION			NOTES
	MAX. PRES.	SEAL		MAX. PRES.	SEAL		MAX. PRES.	SEAL		INTERNAL THICKNESS	EXTERNAL THICKNESS		
		A	B		A	B		A	B				
SUPPLY AIR WITHIN 10' OF UNIT	2"	X	-	-	-	-	-	-	YES	1"	NO	-	-
SUPPLY AIR BEYOND 10' OF UNIT	2"	X	-	-	-	-	-	-	NO	-	YES	2" FSK	-
RETURN AIR WITHIN 10' OF UNIT	2"	-	X	-	-	-	-	-	YES	1"	NO	-	-
RETURN AIR BEYOND 10' OF UNIT	2"	-	X	-	-	-	-	-	NO	-	YES	2" FSK	-
OUTSIDE AIR/MIXED AIR	2"	-	X	-	-	-	-	-	NO	-	YES	3" FSK	-
EXHAUST AIR	2"	-	X	-	-	-	-	-	NO	-	YES	2" FSK	-
GREASE AIR	2"	X	-	-	-	-	-	-	NO	-	YES	SEE NOTE	1

NOTES:
1. PROVIDE CODE-COMPLIANT FIRE WRAP.

FAN SCHEDULE															
CFM	SP	FAN RPM	ELECTRICAL				DAMPER BDD OR MOD	DRIVE	FAN TYPE	INTERLOCK/CONTROL	WEIGHT	MANUFACTURER & MODEL NUMBER	NOTES		
			VOLTAGE & PHASE	H.P.	FLA/AMPS	MCA								MOCP	
EF-1	225	0.5	1253	115/1	0.25	3.5	4	15	BDD	DIRECT	INLINE	SWITCH	50	GREENHECK SO-98-VG	1,2,3
EF-2	300	0.5	1321	115/1	0.25	3.5	4	15	BDD	DIRECT	INLINE	SWITCH	50	GREENHECK SO-98-VG	1,2,3
EF-3	375	0.5	1435	115/1	0.25	3.5	4	15	BDD	DIRECT	INLINE	SWITCH	50	GREENHECK SO-98-VG	1,2,3
EF-4	450	0.5	1532	115/1	0.25	3.5	4	15	BDD	DIRECT	INLINE	SWITCH	50	GREENHECK SO-99-VG	1,2,3
EF-5	300	0.5	1321	115/1	0.25	3.5	4	15	BDD	DIRECT	INLINE	SWITCH	50	GREENHECK SO-98-VG	1,2,3
EF-6	175	0.5	1489	115/1	0.25	3.5	4	15	BDD	DIRECT	INLINE	SWITCH	50	GREENHECK SO-97-VG	1,2,3
EF-7	300	0.5	1321	115/1	0.25	3.5	4	15	BDD	DIRECT	INLINE	SWITCH	50	GREENHECK SO-98-VG	1,2,3
EF-8	100	0.3	1670	115/1	0.07	1.3	2	15	BDD	DIRECT	INLINE	SWITCH	30	GREENHECK SO-60-VG	1,2,3
SF-1	750	0.5	1089	115/1	0.5	6.4	8	15	MOD	DIRECT	INLINE	SWITCH	65	GREENHECK SO-120-VG	4-7
SF-2	325	0.5	1354	115/1	0.25	3.5	4	15	MOD	DIRECT	INLINE	SWITCH	50	GREENHECK SO-98-VG	4-7
SF-3	325	0.5	1354	115/1	0.25	3.5	4	15	MOD	DIRECT	INLINE	SWITCH	50	GREENHECK SO-98-VG	4-7

NOTES: M.C. IS RESPONSIBLE FOR PROVIDING ANY AND ALL NECESSARY DIMENSIONAL, ELECTRICAL, MECHANICAL, AND STRUCTURAL ALTERATIONS NECESSITATED BY PROVIDING ALTERNATE EQUIPMENT.
1. PROVIDE ELECTRONIC SPEED CONTROL MOUNTED ABOVE ACCESSIBLE CEILING.
2. M.C. SHALL PROVIDE AND INSTALL LOW VOLTAGE MOTORIZED DAMPER.
3. OPERATION OF DEVICE ON OCCUPIED MODE OF RTU OR SWITCH WITH LIGHTS. SEE INTERLOCK/CONTROL COLUMN FOR TYPE.
4. PROVIDE UNIT MOUNTED DISCONNECT.
5. FAN AND MOTORIZED DAMPER ARE PART OF EMERGENCY POWER SYSTEM. COORDINATE ALL CIRCUITS WITH EC.
6. ALL WIRING TO FAN AND DAMPER SHALL BE BY EC.
7. PROVIDE 120 V DAMPER.

ELECTRIC FAN FORCED HEATER SCHEDULE												
ROOM NO.	CFM	WALL OR CEILING	KW	MOUNTING	ELECTRICAL CHGR	AMPS	SPEEDS	CONTROL	RPM	MANUFACTURER & MODEL NUMBER	NOTES	
1	VEST	300	CEILING	2	RECESSED	208 / 1	9.6	1	INT STAT	1400	BERKO FFCH-548	1-3
2	VEST	300	CEILING	2	RECESSED	208 / 1	9.6	1	INT STAT	1400	BERKO FFCH-548	1-3
3	VEST	300	CEILING	2	RECESSED	208 / 1	9.6	1	INT STAT	1400	BERKO FFCH-548	1-3
4	VEST	300	CEILING	2	RECESSED	208 / 1	9.6	1	INT STAT	1400	BERKO FFCH-548	1-3

NOTES: M.C. IS RESPONSIBLE FOR PROVIDING ANY AND ALL NECESSARY DIMENSIONAL, ELECTRICAL, MECHANICAL, AND STRUCTURAL ALTERATIONS NECESSITATED BY PROVIDING ALTERNATE EQUIPMENT.
1. PROVIDE INTERNAL THERMOSTAT.
2. RECESSED MOUNTED UNIT. PROVIDE RECESSED MOUNTING KIT.
3. PROVIDE BUILT-IN DISCONNECT.

FIRE PROTECTION ABBREVIATIONS			
AG	ABOVE GRADE	FT	FOOT (FEET)
ADD	ADDENDUM	GAL	GALLON
ADJL	ADDITIONAL	GC	GENERAL CONTRACTOR
ADJ	ADJUSTABLE	GPM	GALLONS PER MINUTE
AF	ABOVE FINISH FLOOR	MC	MECHANICAL CONTRACTOR
AFG	ABOVE FINISH GRADE	MECH	MECHANICAL
ALT	ALTERNATE	MIN	MINIMUM
BG	BELOW GRADE	NTS	NOT TO SCALE
CI	CAST IRON	PC	PLUMBING CONTRACTOR
COL	COLUMN	PLBC	PLUMBING
CW	COLD WATER	QTY	QUANTITY
DN	DOWN	SCH	SCHEDULE
EC	ELECTRICAL CONTRACTOR	SPEC	SPECIFICATIONS
FD	FLOOR DRAIN	SS	STAINLESS STEEL
FDC	FIRE DEPARTMENT CONNECTION	TEMP	TEMPERATURE
FLR	FLOOR	TYP	TYPICAL
FP	FIRE PROTECTION	W/	WITH

FIRE PROTECTION SYMBOL LEGEND	
	SHUTOFF VALVE
	CHECK VALVE
	DOUBLE CHECK VALVE
	END CAP
	FIRE DEPARTMENT CONNECTION (FDC)
	BELL


FIRE PROTECTION PIPING LINETYPES	
LINETYPE	DESCRIPTION
	NEW - ABOVE GRADE
	NEW - BELOW GRADE

- ### FIRE PROTECTION GENERAL NOTES
- CONTRACTOR SHALL PROVIDE DESIGN FOR SPRINKLER SYSTEM FOR REMODELED EXISTING SPACE.
 - COORDINATE INSTALLATION OF SPRINKLER PIPING AND ALL COMPONENTS WITH OTHER TRADES, OWNER, AND GENERAL CONTRACTOR.
 - FIRE PROTECTION SYSTEM TO COMPLY WITH NFPA 13, INSURANCE CARRIER AND ALL APPLICABLE STATE AND LOCAL CODES.
 - CUTTING OF STRUCTURAL AND/OR ARCHITECTURAL MEMBERS TO BE DONE ONLY WITH THE WRITTEN APPROVAL OF THE ARCHITECT AND STRUCTURAL ENGINEER.
 - PROVIDE MINIMUM 10 PSI SAFETY FACTOR.
 - WORK DRAWINGS INDICATING SPRINKLER HEAD LOCATIONS AND EXPOSED AND CONCEALED PIPING ROUTING SHALL BE PROVIDED TO THE ARCHITECT/ENGINEER PRIOR TO INSTALLATION FOR APPROVAL.
 - FIRE PROTECTION CONTRACTOR IS RESPONSIBLE FOR ORGANIZING A COORDINATION MEETING WITH OTHER TRADES AND OWNER PRIOR TO INSTALLATION.
 - SYSTEM PIPING LOCATION: WET SYSTEM PIPING SHALL BE INSTALLED AT HIGHEST ELEVATION POSSIBLE. PIPING SHALL BE INSTALLED ABOVE ALL MECHANICAL EQUIPMENT, DUCTWORK, AND ALL PLUMBING SYSTEM PIPING. PROVIDE ADEQUATE CLEARANCE TO MECHANICAL UNITS. FIRE PROTECTION CONTRACTOR SHALL COORDINATE FIRE PROTECTION PIPING PRIOR TO INSTALLATION.
 - PROPERLY TORQUE MECHANICAL TEES TO MANUFACTURER'S RECOMMENDATIONS.
 - FIRE PROTECTION PLANS ARE FOR REFERENCE ONLY. OCCUPANCIES AND AREAS OF PROTECTION NOTED ON THE PLANS SHALL BE CONFIRMED WITH NFPA 13 AND AUTHORITIES HAVING JURISDICTION. THIS CONTRACTOR SHALL COMPLY WITH ANY CODE REQUIREMENTS AS REQUIRED.
 - ALL AREA HORIZONTAL FOUR SQUARE FEET IN SIZE OR ABOVE NEED TO BE SPRINKLED.

FIRE PROTECTION SHEET INDEX

F101	FIRE PROTECTION PLAN
------	----------------------

- ### KEYED NOTES
- LIGHT HAZARD AREA - REFER TO ARCHITECTURAL PLANS FOR CEILING TYPE AND HEIGHT.
 - ORDINARY HAZARD GROUP 1. REFER TO ARCHITECTURAL PLANS FOR CEILING TYPE AND HEIGHT.
 - ORDINARY HAZARD GROUP 1. COORDINATE WITH FREEZER/COOLER SUPPLIER OR MANUFACTURER FOR SPRINKLER HEAD INSTALLATION. PROVIDE DRY SPRINKLER HEADS IN FREEZER/COOLERS.
 - STORM SHELTER - HATCHED AREA - SHELTER WALL PENETRATIONS OF PIPING SHALL HAVE AN OFFSET AND BE PROTECTED WITH DEBRIS GUARD. COORDINATE DEBRIS GUARDS WITH STRUCTURAL CONTRACTOR FOR STORM SHELTER WALL PENETRATIONS OF SPRINKLER PIPING. FIRESAL PENETRATIONS TO MAINTAIN FIRE RATING. ALL PENETRATIONS 2-1/16 INCH DIAMETER AND LARGER IN/OUT SHELTER REQUIRE FEMA SHROUD. REFER TO STRUCTURAL FOR ALL SHROUD DETAILS.
 - ALL SPRINKLER PIPING PENETRATING STORM SHELTER SHALL HAVE AUTOMATIC WATER SHUT-OFF VALVE TO PROTECT AGAINST LEAKAGE INTO SHELTER.

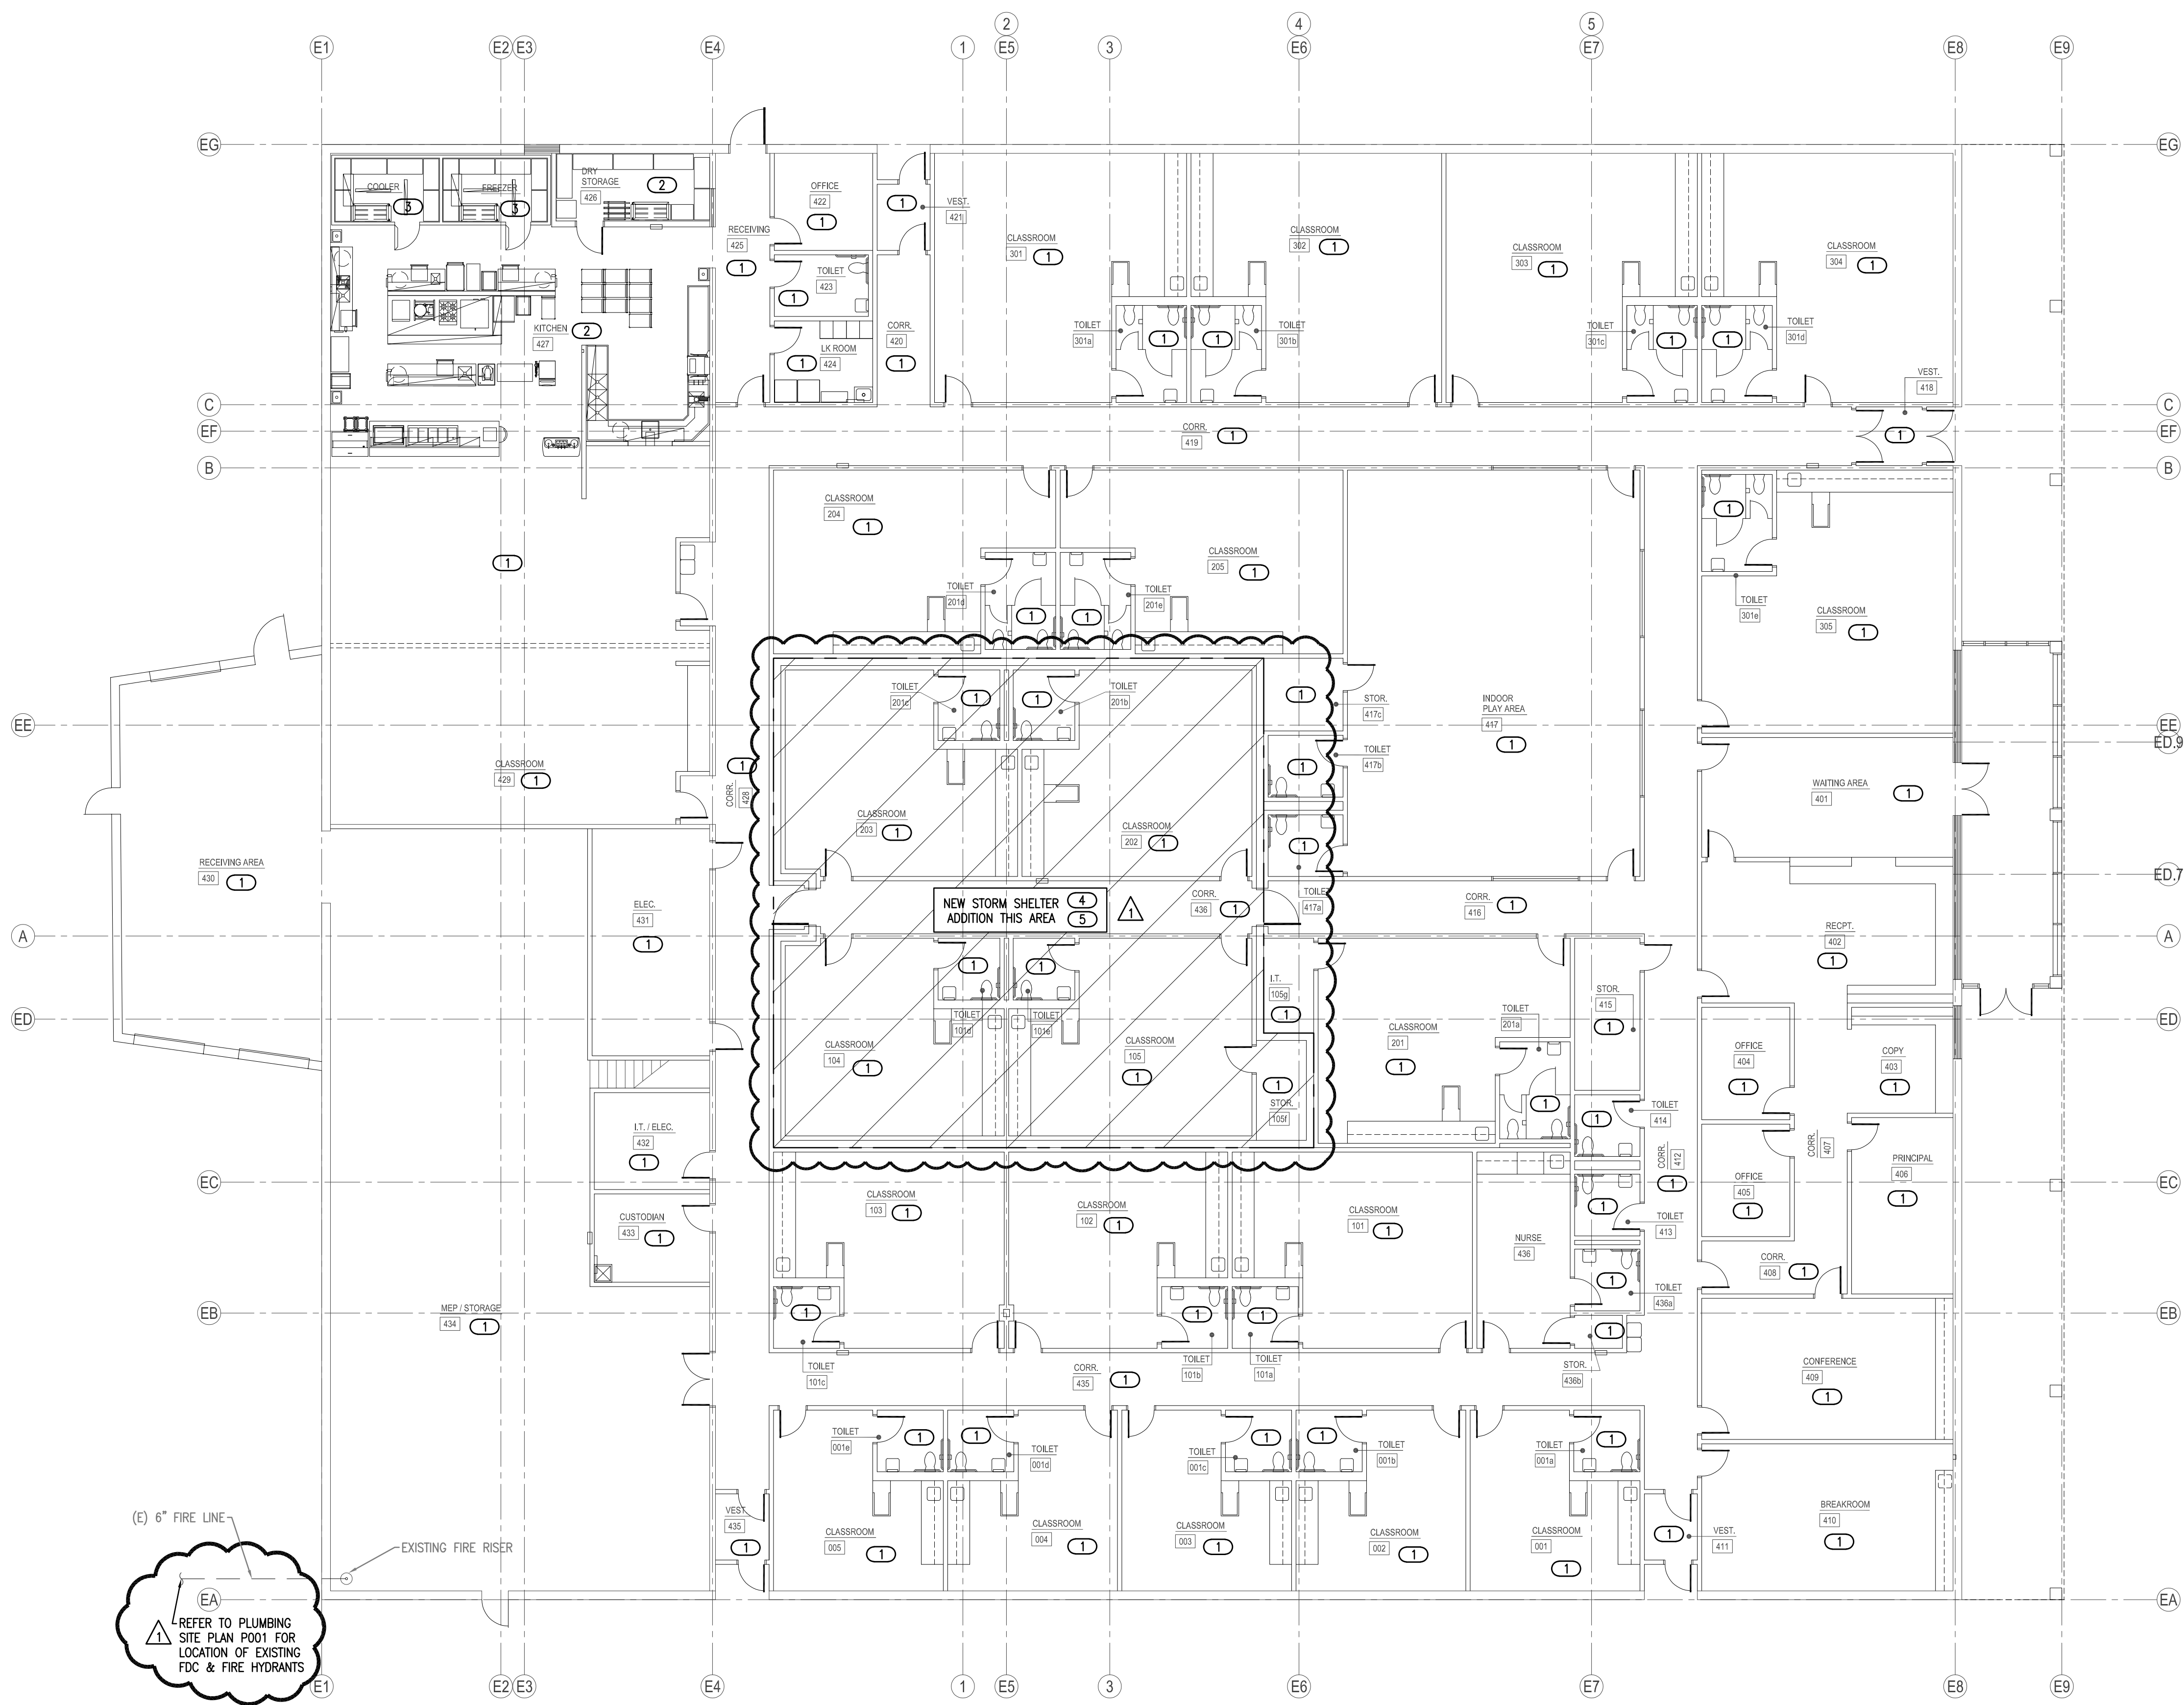

1 FIRE PROTECTION PLAN
SCALE: 3/32" = 1'-0"

KFC ENGINEERING
STRUCTURAL

SALAS O'BRIEN
MECHANICAL / ELECTRICAL



KS
drawn by
KP
checked by
OCTOBER 2024
date
revisions
12/12/2024 AD 03



CHILD CARE FACILITY
201 N. EASTERN AVE.

sheet no:
F101

Salas O'Brien
2900 S. Telephone Road, Suite 120
Moore, OK 73160
Salas O'Brien Registration: CA# 7058
Expiration Date: 6/30/2025
Salas O'Brien Project Number: 2450-70304-00

OWNERSHIP USE OF DOCUMENTS:
AGP EXPRESSLY RESERVES ITS COPYRIGHT AND OTHER PROPERTY RIGHTS OF ALL PLANS AND DRAWINGS DESIGNED AND/OR PRODUCED. PLANS AND DRAWINGS ARE NOT TO BE REPRODUCED IN ANY FORM OR MANNER WITHOUT THE EXPRESSED WRITTEN CONSENT OF AGP.

SAFEROOM NOTE

PER ICC 500-2014, 309.1:

PENETRATIONS THROUGH THE STORM SHELTER ENVELOPE THAT ARE LARGER THAN:

- 3.5" SQUARE INCHES IN AREA FOR RECTANGULAR OPENINGS, OR
- 2 1/16" IN DIAMETER

SHALL BE CONSIDERED AN OPENING AND SHALL BE PROVIDED WITH AN OPENING PROTECTIVE DEVICE (SHROUD). REFERENCE STRUCTURAL DRAWINGS FOR A SAMPLE SHROUD DETAIL. THIS INCLUDES PENETRATIONS FOR BUNDLES OF CONDUIT.

GENERAL NOTES

- FIRE ALARM: CONNECT NEW FIRE ALARM DEVICES TO NEW SILENT KNIGHT 6820XL SUPPLY 6820XL PANEL AND ALL NAC PANELS, POWER SUPPLIES, ETC. NEEDED TO MAKE A COMPLETE AN CODE COMPLIANT SYSTEM. SYSTEM SHALL USE SK PROTOCOL DEVICES ONLY. SEE SPECIFICATIONS FOR APPROVED PART NUMBERS.
- SECURITY ALARM: CONNECT ALL NEW SECURITY ALARM DEVICES TO NEW DMP SECURITY ALARM PANEL. SUPPLY DMP PANEL AND ALL ZONE EXPANDERS, POWER SUPPLIES, ETC. NEEDED TO MAKE A COMPLETE SYSTEM. SYSTEM SHALL BE WIRED WITH 2 ZONES PER SINGLE DOOR OR DOUBLE DOOR. ONE ZONE FOR SECURITY ALARM AND ONE ZONE FOR DOOR HOLD OPEN ALERTS. SEE SPECIFICATIONS FOR APPROVED PART NUMBERS.
- INTERCOM: INTERCOM DEVICES SHALL BE RAULAND. CONNECT ALL NEW INTERCOM DEVICES TO EXISTING RAULAND TELECENTER U IP. SUPPLY ALL MASTER CONSOLES, AMPLIFIERS, POWER SUPPLIES, MODULES, CALL BUTTONS, ETC. NEEDED TO MAKE A COMPLETE SYSTEM. ROOM SPEAKERS AND RESTROOM SPEAKERS SHALL BE TIED TOGETHER ON ONE TALK ZONE PER ROOM CALL BUTTON. EACH ROOM WITH A CALL BUTTON SHALL HAVE A STATUS LIGHT INSTALLED ABOVE ROOM DOOR ON HALLWAY SIDES. SEE SPECIFICATIONS FOR APPROVED PART NUMBERS.
- CLOCKS: CLOCKS SHALL BE RAULAND. SEE SHEET SPECIFICATIONS FOR APPROVED PART NUMBERS.
- ACCESS CONTROL: CONNECT ALL NEW ACCESS CONTROL DEVICES TO NEW KEYSCAN CONTROLLERS. SUPPLY KEYSCAN CONTROLLERS AND ALL POWER SUPPLIES, READERS, STRIKES, ETC. NEEDED TO FURNISH A COMPLETE SYSTEM. SEE SPECIFICATIONS FOR APPROVED PART NUMBERS.
- CAMERA: CONNECT ALL NEW CAMERAS TO NEW MDF. CAMERA SYSTEM IS AVIGILON. CONTRACTOR TO PROVIDE DELL AVIGILON SERVER IN MDF ROOM LOCATED ON 2 POST RACK. CONTACT JACK PHILLIPS WITH MOORE PUBLIC SCHOOLS @ 405-473-5225 FOR EXACT CAMERA MOUNTING LOCATIONS AND SPECIFICATIONS. SEE SPECIFICATIONS FOR APPROVED PART NUMBERS.
- DATA: CONNECT NEW DATA, WIFI AND CAMERA NETWORK DROPS TO NEW MDF. CONNECT NEW DATA/MDF TO EXISTING IDF LOCATED IN MOORE HIGH SCHOOL CCC VIA FIBER AND CAT 6 CABLE. SEE SPECIFICATIONS FOR APPROVED PART NUMBERS.

AGP
the Abila Griffin
Partnership L.L.C.

201 N. BROADWAY
SUITE 210
MOORE, OK. 73160
405.735.3477
AGP@theAGP.net
www.theAGP.net

KFC ENGINEERING
STRUCTURAL

SALAS O'BRIEN
MECHANICAL / ELECTRICAL

KEYED NOTES

- CONTRACTOR TO EXTEND ENTRANCE CONDUIT ABOVE CEILING. CONTRACTOR TO MATCH NEW CONDUIT SIZE WITH EXISTING CONDUIT SIZE.
- CONTRACTOR TO PROVIDE AND INSTALL INNERDUCT ABOVE CEILING AT THE INDICATED ROUTE TO THE NEW IT ROOM. PENETRATE AND SEAL WALLS AS NEEDED.
- INDICATES NEW DEMARC LOCATION. PLYWOOD IS RESERVED FOR SERVICE PROVIDER EQUIPMENT.
- INDICATES THE LOCATION OF A 8" TALL, 3/4" FIRE RATED PLYWOOD CONTRACTOR TO PROVIDE AND INSTALL PLYWOOD AND ALL REQUIRED MOUNTING HARDWARE. PLYWOOD SHALL BE PAINTED WHITE WITH FIRE RATED PAINT. TYPICAL FOR ALL SHOWN ON DRAWING.
- INDICATES THE LOCATION OF A NEW WALL MOUNTED TELECOMMUNICATION GROUND BUS BAR (TGBB). CABLING CONTRACTOR TO PROVIDE BUS BAR AND ALL REQUIRED MATERIAL TO MOUNT AT THE LOCATION SHOWN. TGBB TO BE MOUNTED AT +93" A.F.F.
- PROVIDE AND INSTALL A 12" WIDE, UNIVERSAL LADDER TRAY AND ALL REQUIRED MOUNTING HARDWARE. LADDER TRAY SHALL BE BLACK IN COLOR. TYPICAL FOR ALL SHOWN ON ENTIRE PROJECT.
- PROVIDE AND INSTALL ONE (1) 2-POST, FLOOR MOUNTED, 7' RELAY RACK (BLACK IN COLOR). PROVIDE BONDING WASHERS, BOLTS, AND NUTS AT ALL MECHANICALLY CONNECTED LOCATIONS OF THE RACK TO ENSURE THAT ALL PIECES OF THE RACK ARE COMPLETELY BONDED. SECURING PAINT FROM RACKS TO MAKE A BOND WILL NOT BE ACCEPTED. ALL RACK MOUNTED COMPONENTS SHALL BE MOUNTED WITH BONDING SCREWS AND THE CONTRACTOR SHALL PROVIDE THE OWNER WITH (50) ADDITIONAL BONDING SCREWS FOR THE INSTALLATION OF OWNER EQUIPMENT. NO DASHY CHAINING GROUNDS FROM RACK TO CABLE TRAY OR TO OTHER RACKS WILL BE ACCEPTED. ALL GROUNDS SHALL BE HOME RUN TO THE TELECOMMUNICATIONS GROUND BUS BAR (TGBB). TYPICAL FOR ALL SHOWN ON THE ENTIRE PROJECT.
- PROVIDE AND INSTALL ONE (1) 7'X6", FRONT AND REAR MANAGED, VERTICAL CABLE MANAGER (BLACK IN COLOR). CABLE MANAGERS SHALL BE INSTALLED ON EACH END OF THE RACK SYSTEMS AND BETWEEN EACH RACK. CABLE MANAGERS SHALL HAVE A SINGLE, SOLID, FULL HEIGHT HINGED DOOR IN THE FRONT AND WIDE SPACED CABLE RINGS WITH SPIN-OPEN LATCHES IN THE REAR. TYPICAL FOR ALL SHOWN IN THE ENTIRE PROJECT.
- DOOR HARDWARE SPECIFIED FOR INDICATED DOORS SHOULD HAVE KEY ACCESS FROM BOTH SIDES ALLOWING EACH SIDE TO BE LOCKED AND UNLOCKED INDEPENDENTLY.
- CONTRACTOR TO PROVIDE AND INSTALL A DMP WIRELESS HOLD UP BUTTON AT EACH LOCATION INDICATED.

NY
drawn by

NY
checked by

OCTOBER 2024
date

revisions

12/12/2024 AD 03



11/22/2024 AD 02



CHILD CARE FACILITY
201 N. EASTERN AVE.

sheet no:
T201

OWNERSHIP USE OF DOCUMENTS:
AGP EXPRESSLY RESERVES ITS COPYRIGHT AND OTHER PROPERTY RIGHTS OF ALL PLANS AND DRAWINGS DESIGNED AND/OR PRODUCED. PLANS AND DRAWINGS ARE NOT TO BE REPRODUCED IN ANY FORM OR MANNER WITHOUT THE EXPRESSED WRITTEN CONSENT OF AGP.

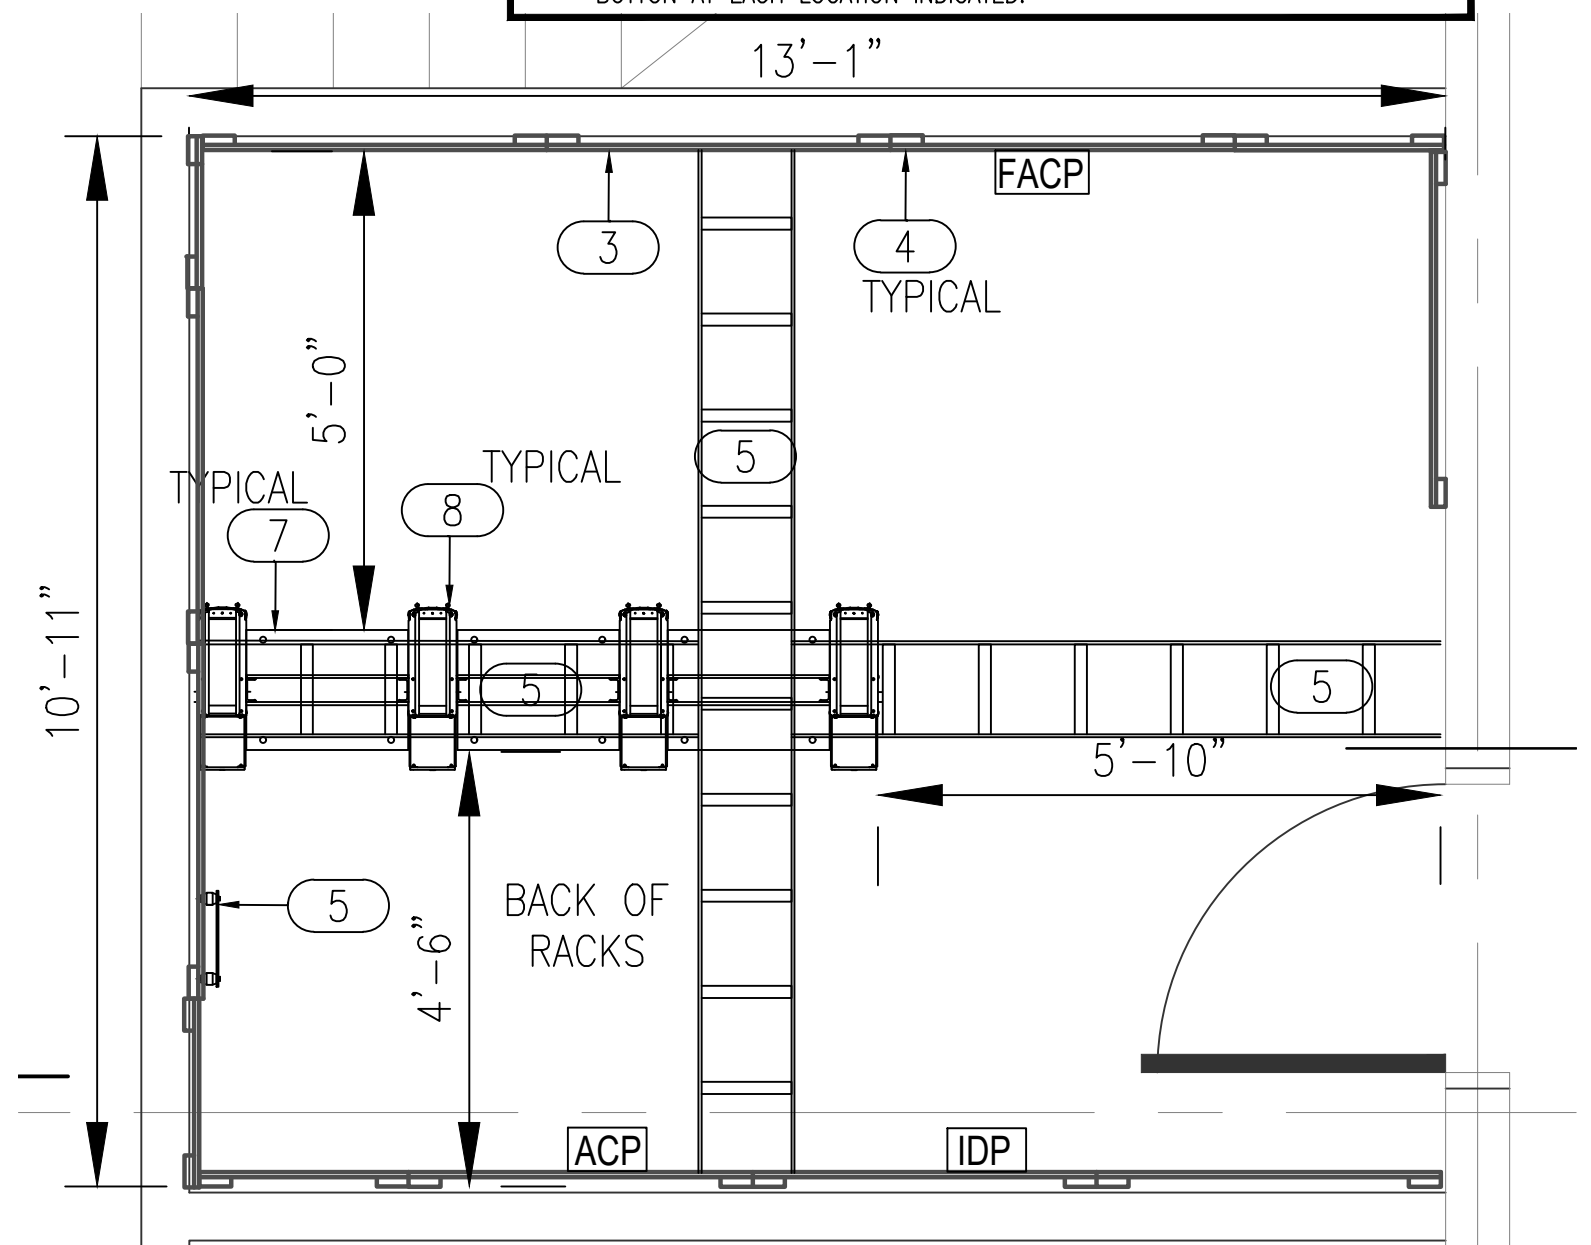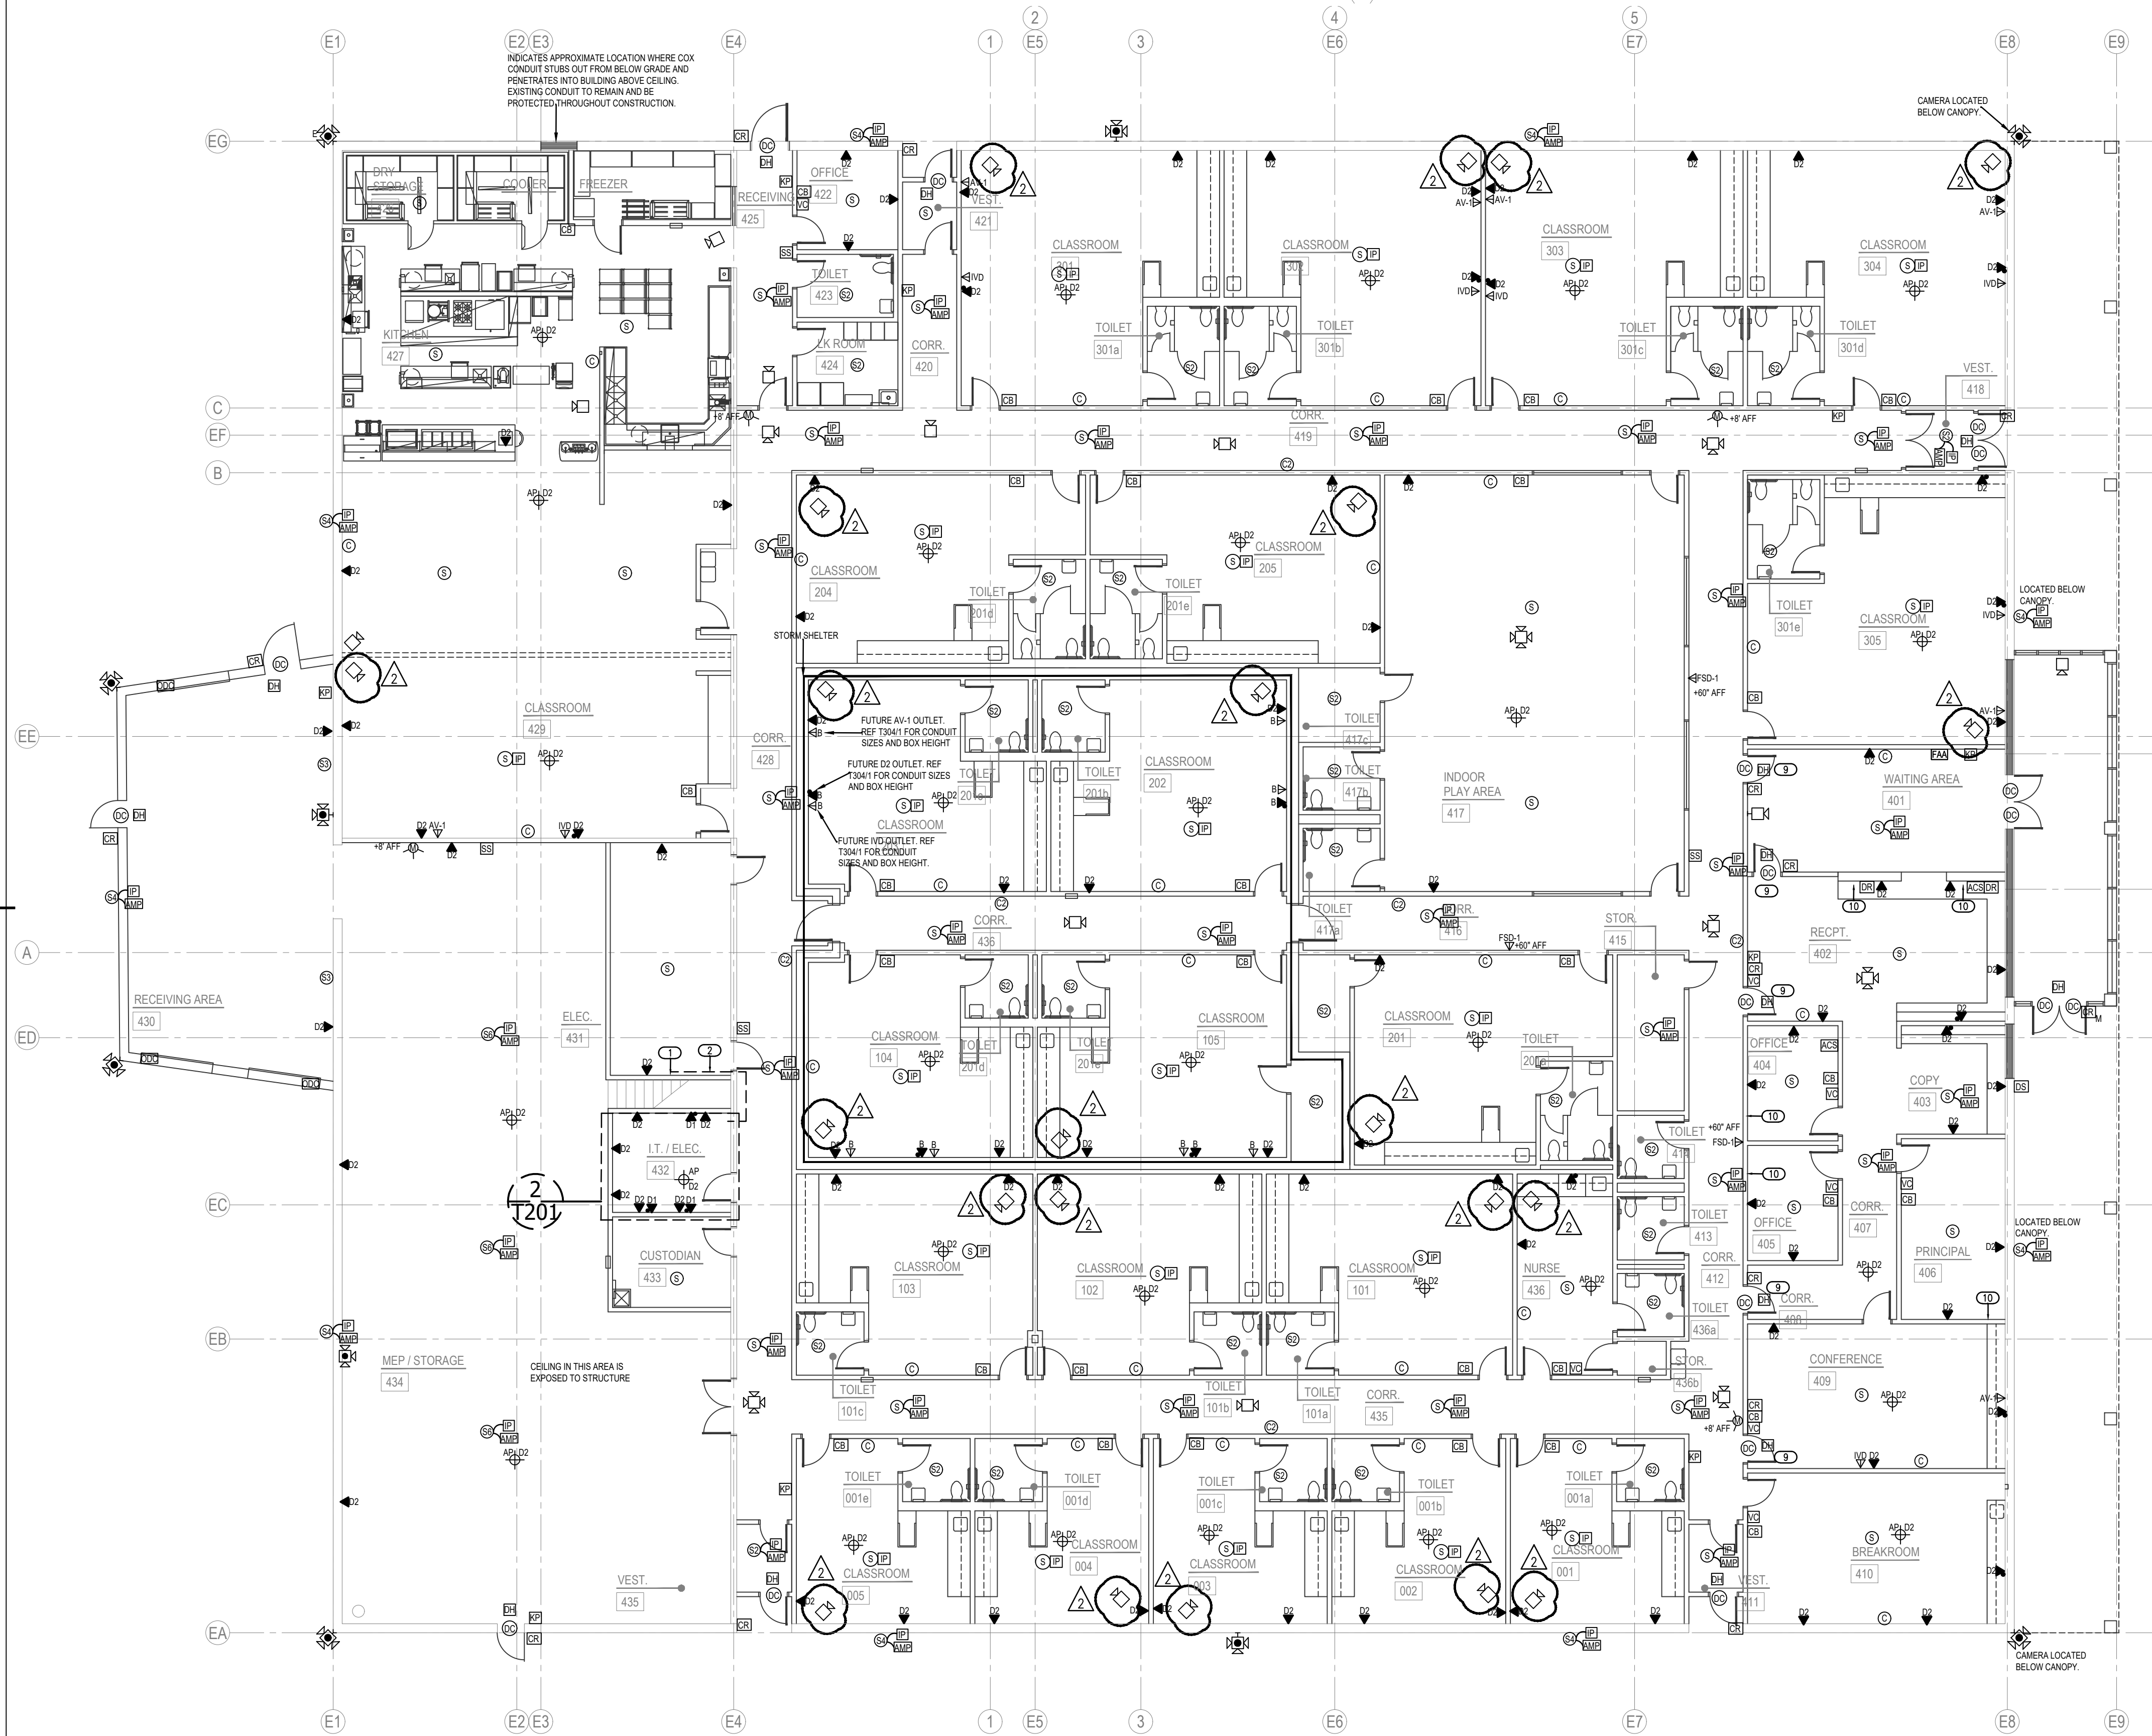

1 TECHNOLOGY FLOOR PLANS
SCALE: 3/32" = 1'-0"

2 TECHNOLOGY ENLARGED PLAN - I.T./ELEC. 432
SCALE: 1/2" = 1'-0"

Salas O'Brien
2900 S. Telephone Road, Suite 120
Moore, OK 73160
Salas O'Brien Registration: CA# 7058
Expiration Date: 6/30/2025
Salas O'Brien Project Number: 2450-70304-00

4.03 Products Installed but not Supplied Under This Section

- All conduit and EMT required for Fire cabling pathway in/out of closets and in/out of wall cavities at the work or Conduit for pathways shall have no more than two 90 degree sweeps and no continuous section over 100'.
- All core holes and poke through devices in the floor for the installation of cabling.
- All core holes and EMT sleeves between floors for the routing of cabling.
- Back boxes for the mounting of Devices.
- Drag line or pull string at the back boxes fished through EMT or conduit to the other end for installing Cabling.

4.04 References

- NFPA-70 National Electrical Code 2008 edition
- NFPA-72 National Fire Alarm Code
- UL 1666 - Standard for Safety of Flame Propagation Height
- NFPA 262 - Flame Travel and Smoke of Wires and Cables
- Local Authority Having Jurisdiction

4.05 Definitions

AWG - American Wire Gauge
 BICSI - Building Industry Consulting Service International
 EIA - Electronics Industry Alliance
 FCC - Federal Communications Commission
 NECA - National Electrical Contractors Association
 NFPA - National Fire Protection Agency
 UL - Underwriters Laboratory

4.06 Delivery, Storage, and Protection

- Contractor shall ensure that materials delivery to work area shall be coordinated with construction site manager responsible for materials distribution to all trades.
- Contractor is responsible for all materials, tools and vehicles left on the job site.
- Follow Manufacturer's recommendations for handling of materials.

4.07 Project Conditions

4.07.1 Environmental Requirements

- Contractor shall ensure that any pollutants produced during the Work are disposed off according to local, state or national regulations. Follow the most stringent guidelines.
- It is preferred that the Contractor recycle any used or un-used components during the course of the construction project.

4.07.2 Field Measurements

- Contractor shall coordinate with electrical engineer on project that the main electrical service ground has a resistance to earth of less than 5 ohms.
- Contractor shall ensure that all field testers have been calibrated from the Manufacturer within 1 year.
- All field test results will be documented and submitted to Moore Public Schools, Technology Department.

4.08 Sequencing

- Contractor shall coordinate with Owner's project manager on sequencing of various trades and construction items for the lifecycle of the project.

4.09 Scheduling

- Contractor shall provide a detailed construction schedule with hard dates for completion of roughing in cables, terminations and testing once scheduling sequence has been determined to the Owner's Project Manager.

4.10 Warranty

- Contractor shall provide a 1 year parts and labor warranty against defective workmanship and/or system component failure. (1 year warranty shall begin at job completion)

4.11 Source Quality Control

- Materials shall be purchased from Distributors authorized by system Manufacturers to sell new and unused components.

Part 5 -

5.01 Field Quality Control

- Contractor shall make available all ceiling and termination work for inspection by Manufacturer's representative or owner's representative.
- Contractor shall replace all defective components.

5.02 Adjusting

- No additional work outside of the contract scope of work shall be completed without the approval of the Owner or Owner's representative.

5.03 Cleaning

- Contractor shall sweep and mop the floors of all equipment rooms or connection point closets prior to turnover to the Owner.

5.04 Protection

- It is the responsibility of the Contractor to ensure equipment is protected from dust and water during the project with appropriate materials.
- Remove all protective covers and protective materials from equipment prior to turnover to Owner.

5.05 Schedules

- Coordinate work with Owner's project manager and follow scheduling sequence as established by Owner's project manager.
- It is recommended that the Contractor schedule closely with any other systems contractor to ensure turnover date is met.
- Contractor bidding will work closely with the electrical and/or masonry contractors to ensure conduit, back boxes, door frame access conduit, etc. are in the proper locations and accessible.

End of Section

Moore Public Schools Fire System Specifications SK & SD Protocol

Part 1 - General
2.01 Manufacturers

- Fire System Manufacturer shall be Silent Knight. (No Substitutions)
- Notification appliance Manufacturer shall be System Sensor. (No Substitutions)
- Device Manufacture shall be as specified in equipment description. (No Substitutions)
- Cable Manufacturer shall be Genesis. (Or Equivalent)

1.03 Fire Systems Equipment Description

- NOTE:** Contractor shall use SK Protocol devices on all new installations except when the existing system has SD protocol devices connected. In these instances, SD protocol devices shall be used. Contractor shall not combine SD & SK protocol devices to one system.
- Fire alarm control shall be Silent Knight Model # 5820 or 6820. (No Substitutions)
- Fire alarm distributed power module NAC Expansion shall be Silent Knight SK-PS6 / SK-PS10 or Fire-Lite Model #'s FL-PS6 / FL-PS10. (No Substitutions)
- Fire alarm intelligent power supply shall be Silent Knight Model # 5895XL. (No Substitutions)
 NOTE: The 5895XL NAC circuits will not sync with the main control panels NAC circuits. If new NAC circuit synchronization is required with existing NAC circuits, use the SK-PS6/FL-PS6 or SK-PS10/FL-PS10
- Fire alarm remote Annunciator shall be Silent Knight Model # 5860 (Grey) and surface mount trim ring 5860TG (Grey) shall be used if surface mounted. (No Substitutions)
- Fire Alarm signaling line circuit expander shall be Silent Knight Model # 5815XL for SD protocol devices & 6815 for SK protocol devices. (No Substitutions)

SK Protocol Devices Shall Be

- Fire alarm addressable manual pull station shall be Silent Knight Model # SK-PULL-DA. (No Substitutions)
- Fire alarm addressable photoelectric smoke detector shall be Silent Knight Model # SK-PHOTO-W. (No Substitutions)
- Fire alarm addressable heat detector shall be Silent Knight Model # SK-HEAT-W. (No Substitutions)
- Fire alarm base shall be Silent Knight Model # B300-6. (No Substitutions)
- Smoke Detectors in areas that require a CO Detector shall be SK-FIRE-CO-W. (No Substitutions)
- Fire alarm addressable input module shall be Silent Knight Model # SK-MONITOR or SK-MONITOR-2. (No Substitutions)
- Fire alarm addressable relay module shall be a Silent Knight Model # SK-RELAY. (No Substitutions)
- Fire alarm SLC line isolator shall be Silent Knight Model # SK-ISO. (No Substitutions)
- Fire alarm Duct detectors and Duct Detector Remote Test Stations shall be Silent Knight Model #'s SK-DUCT and RTS151KEY. If a Form-C relay is required, please add an SK-RELAY. (No Substitutions)

SD Protocol Devices Shall Be

- Fire alarm addressable manual pull station shall be Silent Knight Model # SD500-PSDA. (No Substitutions)
- Fire alarm addressable photoelectric smoke detector shall be Silent Knight Model # SD505-PHOTO. (No Substitutions)
- Fire alarm addressable heat detector shall be Silent Knight Model # SD505-HEAT. (No Substitutions)
- Fire alarm base for Silent Knight Model #'s SD505-PHOTO and SD505-HEAT shall be Silent Knight Model # SD505-6AB. (No Substitutions)
- CO Detector shall be System Sensor Model # CO1224T. (No Substitutions) An SD500-AIM shall be installed on each CO1224T and shall be accessible and visible from the finished floor.
- Fire alarm addressable input module shall be Silent Knight Model # SD500-AIM. (No Substitutions)
- Fire alarm addressable relay module shall be a Silent Knight Model # SD500-ARM. (No Substitutions)
- Fire alarm SLC line isolator shall be Silent Knight Model # SD500-LIM. (No Substitutions)
- Fire alarm Duct detectors and Duct Detector Remote Test Stations shall be Silent Knight Model #'s SD505-DUCTR and SD505-DTS-K. (No Substitutions) Remote test station shall be accessible and visible from the finished floor.
- Fire alarm Horn / Strobe signaling device shall be System Sensor Model # P2WL. (Model PC2WL can be substituted if mounted on non-stainable ceiling tile. No other Substitutions)
- Fire alarm Strobe signaling device shall be System Sensor Model # SWL. (Model SCWL can be substituted if mounted on non-stainable ceiling tile. No other Substitutions)
- Fire alarm strobe synch module shall be System Sensor Model # MDL3. (Not needed on version 9 panels or newer) (No Substitutions)
- Fire alarm Outdoor strobe signaling device shall be System Sensor Model # P2RK. (No Substitutions)
- Fire alarm Speaker / Strobe signaling device shall be System Sensor Model # SPSWL. (Model SPSCWL can be substituted if mounted on non-stainable ceiling tile. No other Substitutions)
- Fire alarm Speaker signaling device shall be System Sensor Model # SPWL. (No Substitutions)
- Fire alarm 50-watt Voice Evac system shall be as needed Silent Knight SKE-450 (Single Zone), SKE-450-ZN4 (4 Zone) or SKE-450-ZN6 (6 Zone). (No Substitutions)

1.01 Systems Installation

- All fire alarm junctions and or splices shall be soldered and insulated.
- All Ceiling mounted devices shall be mounted on non-stainable ceiling tiles.
- All circuits and wiring shall be labeled at all terminating ends.
- All fire system wiring shall be RED in color and non-shielded.
- All devices shall be mounted according to the manufacture's specifications.
- All devices shall be properly adjusted and tested prior to job completion.
- All fire pulls shall be dual action.
- All Initiating Devices shall be labeled with their corresponding module and point number. Smoke detector label shall be on smoke detector and smoke detector base and be clearly visible from the finished floor.
- Each Initiating Device Circuits (IDC) shall have Line Isolator Modules installed at the SLC Head End.
- All Initiating Device Circuits (IDC) shall be wired Class B (NFPA Style B).
- All Initiating Device Circuits (IDC) shall be wired with minimum 18 AWG gauge red **NON-Shielded cable.**

- All duct detectors shall be connected to fire system and shall have remote test stations installed accessible and visible from the finished floor. They shall be labeled with their corresponding module and point number.
- All duct detector ARM / AIM shall be installed adjacent to the remote test stations and shall be accessible and visible from the finished floor. They shall be labeled with their corresponding module and point number. (ARM/AIM should not be needed when using SD505-DUCTR duct det.)
- Each CO 1224T detectors shall have an SD500 AIM installed (No doubling). All CO1224T & SD500 AIM shall be labeled with their corresponding module and point number and shall be accessible and visible from the finished floor.
- All modules shall have their corresponding module number.
- All notification devices shall be wall mounted where possible. Where wire is exposed decorative wire molding shall be installed from the ceiling to the device. If ceiling mount devices are used, they shall be mounted on a non-stainable ceiling tile.
- All notification devices shall be labeled with their corresponding module, circuit number and device number. Label shall be on the base and be clearly visible from the finished floor. EOL Device shall be labeled as such.
- All horn / strobes and strobes shall be synchronized.
- All Notification Appliance Circuits (NAC) shall be wired Class B (NFPA Style Y).
- All Notification Appliance Circuits (NAC) shall be wired with minimum 16 AWG gauge red **NON-Shielded cable.**
- Protective grommets shall be installed on all conduits to protect wire.
- All SBUS and SLC circuits shall be wired with red **NON-shielded cable.**
- All wire shall be run in J hooks above ceiling with a minimum space of 6" from ceiling deck. All wire shall be in separate pathways 6" from other system wiring. No wire ties allowed. No wire shall be run between the red iron and roof deck.
- Main control panel shall have a CAT 6 cable ran between the main control and the phone company DMARC for monitoring purposes.
- All wire ran between building shall be in conduit and shall be **Non-shielded** direct burial cable. It shall be a minimum of 4 conductor 16 AWG copper.
- Installer shall have a commercial fire technician on the job site at all times during the installation.
- Installer shall supply the electrical and/or masonry contractors with specialty back boxes such as remote annunciator recessed back boxes etc. and coordinate with them to ensure that all necessary conduits, back boxes, etc. are installed in the proper locations.
- Follow and adhere to installation practices specified by the applicable NFPA 72 standards.
- Follow and adhere to installation practices specified by NFPA-70 National Electric Code, Edition 2008.
- Follow and adhere to installation practices specified by the Manufacturers.

End of Section

- IP camera Specifications
- Moore Public Schools IP camera Specifications**
- IP CAMERA MANUFACTURE is AVIGILON (NO SUBSTITUTIONS).**
- AVIGILON EQUIPMENT**
- INDOOR DOME SINGLE HEAD CAMERA REQUIRED EQUIPMENT LIST**
- 4.0C-H5A-D1-IR
- ACC7-ENT LICENSE - 1 per camera
- INDOOR MULTI-HEAD 3 HEAD CAMERA REQUIRED EQUIPMENT LIST
- 9C-H4A-3MH-180 (3x3MP)
- POE-INJ2-60W-NA Power Injector
- ACC7-ENT LICENSE - 1 per camera
- H4AMH-AD-CEIL1
- H4AMH-DC-COVR1
- INDOOR MULTI-HEAD 4 HEAD CAMERA REQUIRED EQUIPMENT LIST
- 12C-H4A-3MH-360 (4x3MP)
- POE-INJ2-60W-NA Power Injector
- ACC7-ENT LICENSE - 1 per camera
- H4AMH-AD-CEIL1
- H4AMH-DC-COVR1
- OUTDOOR DOME SINGLE HEAD CAMERA REQUIRED EQUIPMENT LIST
- 6.0C-H5A-DO1-IR
- ACC7-ENT LICENSE - 1 per camera
- OUTDOOR MULTI-HEAD 3 HEAD CAMERA CORNER MOUNT REQUIRED EQUIPMENT LIST
- 15C-H4A-3MH-270 (3x5MP)
- POE-INJ2-60W-NA Power Injector
- ACC7-ENT LICENSE - 1 per camera
- H4AMH-AD-PEND1
- H4AMH-DO-COVR1
- H4AMH-AD-IR1L1
- H4-MT-CRNR1
- OUTDOOR MULTI-HEAD 3 HEAD CAMERA WALL MOUNT REQUIRED EQUIPMENT LIST
- 15C-H4A-3MH-180 (3x5MP)
- POE-INJ2-60W-NA Power Injector
- ACC7-ENT LICENSE - 1 per camera
- H4AMH-AD-PEND1
- H4AMH-DO-COVR1
- H4AMH-AD-IR1L1

1.02 Products Installed but not Supplied Under This Section

- All conduit and EMT required for Fire cabling pathway in/out of closets and in/out of wall cavities at the work area. EMT or Conduit for pathways shall have no more than two 90-degree sweeps and no continuous section over 100'.
- All core holes and poke through devices in the floor for the installation of Fire cabling.
- All core holes and EMT sleeves between floors for the routing of Fire cabling.
- Back boxes for the mounting of Fire Devices.
- Drag line or pull string at the back boxes fished through EMT or conduit to the other end for installing Fire Cabling.

1.03 Quality Assurance

- 1.03.01 Qualifications**
- Install all components as directed by Manufacturer's installation guidelines.
- All products shall bear the mark of UL or ETL for performance level.
- System installation shall meet all applicable Local/State codes and safety requirements where project is located.
- All products shall be new and un-used in original packaging.
- 1.03.02 Bidder/Installer Qualifications**
- Bidding contractor shall be a local licensed Commercial Fire Alarm Company with licensed Commercial Fire Alarm technician(s) on staff.
- Bidding contractor shall have a minimum of one year experience installing Silent Knight Addressable fire panels.
- Bidding contractor shall have a minimum of 5 years experience installing commercial fire alarms.
- Bidding contractor shall be able to provide insurance at the request of the owner.
- Bidding contractor shall have a commercial fire technician on the job site at all times during the installation.

1.04 Sequencing

- Contractor shall coordinate with Owner's project manager on sequencing of various trades and construction teams for the lifecycle of the project.

1.05 Scheduling

- Contractor shall provide a detailed construction schedule with hard dates for completion of roughing in cables, terminations and testing once scheduling sequence has been determined to the Owner's Project Manager.

1.06 Warranty

- Contractor shall provide a 1-year parts and labor warranty against defective workmanship and/or system component failure. (1-year warranty shall begin at job completion)

Part 2 - Products

2.02 Source Quality Control

- Materials shall be purchased from Distributors authorized by system Manufacturers to sell new and unused components.

Part 3 -

3.01 Field Quality Control

- Contractor shall make available all ceiling and termination work for inspection by Manufacturer's representative or owner's representative.
- Contractor shall replace all defective components.

3.02 Adjusting

- No additional work outside of the contract scope of work shall be completed without the approval of the Owner or Owner's representative.

3.03 Protection

- It is the responsibility of the Contractor to ensure equipment is protected from dust and water during the project with appropriate materials.
- Remove all protective covers and protective materials from equipment prior to turnover to Owner.

End of Section

1.04 Submittals

- 1.04.01 Prior to installation**
- Show compete map of system design for approval by Owner.
- 1.04.02 Prior to final acceptance**
- Provide a soft CAD copy As-Built showing layout of panel, initiating devices, notification devices and all mounted equipment upon Substantial Completion.
- Ensure all warranties specify that the Owner is entitled to all rights guaranteed by the warranty for various components.

Fire System Installation Completion Check List

Part 1 - General

1.01 Section Includes

- Fire System Completion Check List

1.02 Completion Check List

- A map of the entire system showing device numbers and wire routes has been left inside the main control panel and a copy has been given to Jack Phillips with MPS.
- All panel programming has been checked and is correct.
- Panel(s) has been tested for proper operation.
- All zones have been tested to verify proper description at keypad.
- All zones have been tested to verify proper reporting to the monitoring station.
- All points have been tested to verify proper description at the keypad.
- All horn/strobes and strobes have been tested for proper operation.
- All smoke detectors have been tested and dust covers removed.
- All devices have been tested for proper operation.
- All cabinets are labeled on the outside with module numbers and point numbers.
- All cabinets are labeled on the inside with module numbers by the corresponding module and point descriptions.
- The monitoring station has the correct account information such as call list, zone descriptions, etc.

End of Section

IP camera Specifications

Moore Public Schools IP camera Specifications

IP CAMERA MANUFACTURE is AVIGILON (NO SUBSTITUTIONS).

AVIGILON EQUIPMENT

INDOOR DOME SINGLE HEAD CAMERA REQUIRED EQUIPMENT LIST

4.0C-H5A-D1-IR

ACC7-ENT LICENSE - 1 per camera

INDOOR MULTI-HEAD 3 HEAD CAMERA REQUIRED EQUIPMENT LIST

9C-H4A-3MH-180 (3x3MP)

POE-INJ2-60W-NA Power Injector

ACC7-ENT LICENSE - 1 per camera

H4AMH-AD-CEIL1

H4AMH-DC-COVR1

INDOOR MULTI-HEAD 4 HEAD CAMERA REQUIRED EQUIPMENT LIST

12C-H4A-3MH-360 (4x3MP)

POE-INJ2-60W-NA Power Injector

ACC7-ENT LICENSE - 1 per camera

H4AMH-AD-CEIL1

H4AMH-DC-COVR1

OUTDOOR DOME SINGLE HEAD CAMERA REQUIRED EQUIPMENT LIST

6.0C-H5A-DO1-IR

ACC7-ENT LICENSE - 1 per camera

OUTDOOR MULTI-HEAD 3 HEAD CAMERA CORNER MOUNT REQUIRED EQUIPMENT LIST

15C-H4A-3MH-270 (3x5MP)

POE-INJ2-60W-NA Power Injector

ACC7-ENT LICENSE - 1 per camera

H4AMH-AD-PEND1

H4AMH-DO-COVR1

H4AMH-AD-IR1L1

H4-MT-CRNR1

OUTDOOR MULTI-HEAD 3 HEAD CAMERA WALL MOUNT REQUIRED EQUIPMENT LIST

15C-H4A-3MH-180 (3x5MP)

POE-INJ2-60W-NA Power Injector

ACC7-ENT LICENSE - 1 per camera

H4AMH-AD-PEND1

H4AMH-DO-COVR1

H4AMH-AD-IR1L1

INDOOR CAMERA LOCATED IN CLASSROOMS REQUIRED EQUIPMENT LIST

3.0C-H6SL-D1-IR

ACC7-ENT LICENSE - 1 per camera

CAMERA SERVER INFORMATION, CONTRACTOR TO PROVIDE THE FOLLOWING:

1 - Dell Server part# NVR6-PRM-FORM-D-72TB-S22

1 - SFP fiber connector, part# NVR6-AINVR2-FORM-D-SFPPLUS-SR

INSTALLATION

- Install cameras on adjacent walls were possible. If it must be mounted on ceiling, it shall be on a water-resistant non-stainable ceiling tile. **MPS to have final determination of camera location and field of view) (Call Jack Phillips for final location and view phone 473-5225)**
- Any cameras installed on ceiling shall be mounted on a water-resistant non-stainable ceiling tile. (BIDDING CONTRACTOR SHALL PROVIDE NON-STAINABLE TILE)
- Each installed camera needs a camera license.
- All network drops shall be connected with patch cords to a switch at each rack location.
- No Substitutions.

Horizontal Cabling Requirements

- See MPS Structured Cabling Specifications for camera network cabling installation, labelling and testing requirements.

Warranty

- Communications Contractor shall provide a 1 year parts and labor warranty against defective workmanship and/or system component failure.
- Communications Contractor shall execute a Lifetime Applications Assurance Warranty for parts and labor to support stated applications from the connectivity Manufacturer.

End of Section

Audio Visual Systems for Instructional Spaces Specifications

Part 1 - General

1.01 Instructional Spaces

- Reference technology drawings and detail sheet T504 for classroom configuration and part numbers.

1.02 Special Spaces

- Reference technology drawings and one line diagrams.

1.03 Flat Panel Displays

- All non interactive Flat Panel displays shall be 43" Samsung BE Series.
- Bio Lab 37 displays shall be ceiling mounted.
- Career Tech 12 and Career Tech 15 displays shall be wall mounted 55" AFF to center of display.

End of Section



201 N. BROADWAY
 SUITE 210
 MOORE, OK. 73160
 405.735.3477
 AGP@theAGP.net
 www.theAGP.net

KFC ENGINEERING
 STRUCTURAL

SALAS O'BRIEN
 MECHANICAL / ELECTRICAL

NY
 drawn by
 NY
 checked by
 OCTOBER 2024
 date
 revisions
 12/12/2024 AD 03



CHILD CARE FACILITY
 201 N. EASTERN AVE.


sheet no:

T403

OWNERSHIP USE OF DOCUMENTS:
 AGP EXPRESSLY RESERVES ITS COPYRIGHT AND OTHER PROPERTY RIGHTS OF ALL PLANS AND DRAWINGS DESIGNED AND/OR PRODUCED. PLANS AND DRAWINGS ARE NOT TO BE REPRODUCED IN ANY FORM OR MANNER WITHOUT THE EXPRESSED WRITTEN CONSENT OF AGP.




2900 S. Telephone Road, Suite 120
 Moore, OK 73160
 Salas O'Brien Registration: CA# 7058
 Expiration Date: 6/30/2025
 Salas O'Brien Project Number: 2450-70304-00

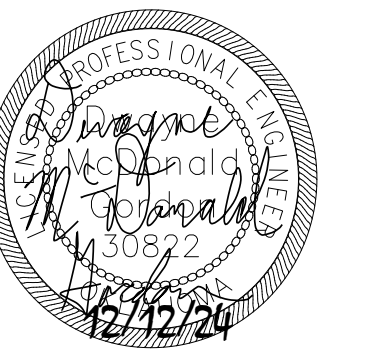

- ### GENERAL NOTES
- COORDINATE WORK WITH ALL OTHER TRADES ON SITE.
 - FIELD VERIFY EXISTING CONDITIONS PRIOR TO COMMENCING WORK.
 - PRIOR TO COMMENCING WORK, COORDINATE WITH SITE CONTRACTOR FOR SANITARY SEWER AND WATER INVERT ELEVATIONS.
 - COORDINATE ALL BELOW GRADE NATURAL GAS PIPE ROUTING WITH EXISTING SITE CONDITIONS.

- ### KEYED NOTES
- SITE CONTRACTOR TO FIELD VERIFY AND CONNECT NEW 4" SANITARY SEWER TO EXISTING MANHOLE. APPROXIMATE INVERT ELEVATION OF 7.67 FEET.
 - PLUMBING CONTRACTOR TO COORDINATE WITH SITE CONTRACTOR FOR INSTALLING NEW BELOW GRADE SANITARY SEWER PIPING.
 - PLUMBING CONTRACTOR TO COORDINATE WITH SITE CONTRACTOR FOR INSTALLING NEW EXTERIOR SEWER CLEANOUT.
 - COORDINATE WITH SITE CONTRACTOR FOR REMOVAL OF EXISTING GREASE WASTE PIPING, GREASE INTERCEPTOR, CLEANOUTS AND SEWER PIPING TO MANHOLE.
 - SITE CONTRACTOR TO FIELD VERIFY AND CONNECT NEW 4" SANITARY SEWER TO EXISTING MANHOLE. APPROXIMATE INVERT ELEVATION OF 7.69 FEET.

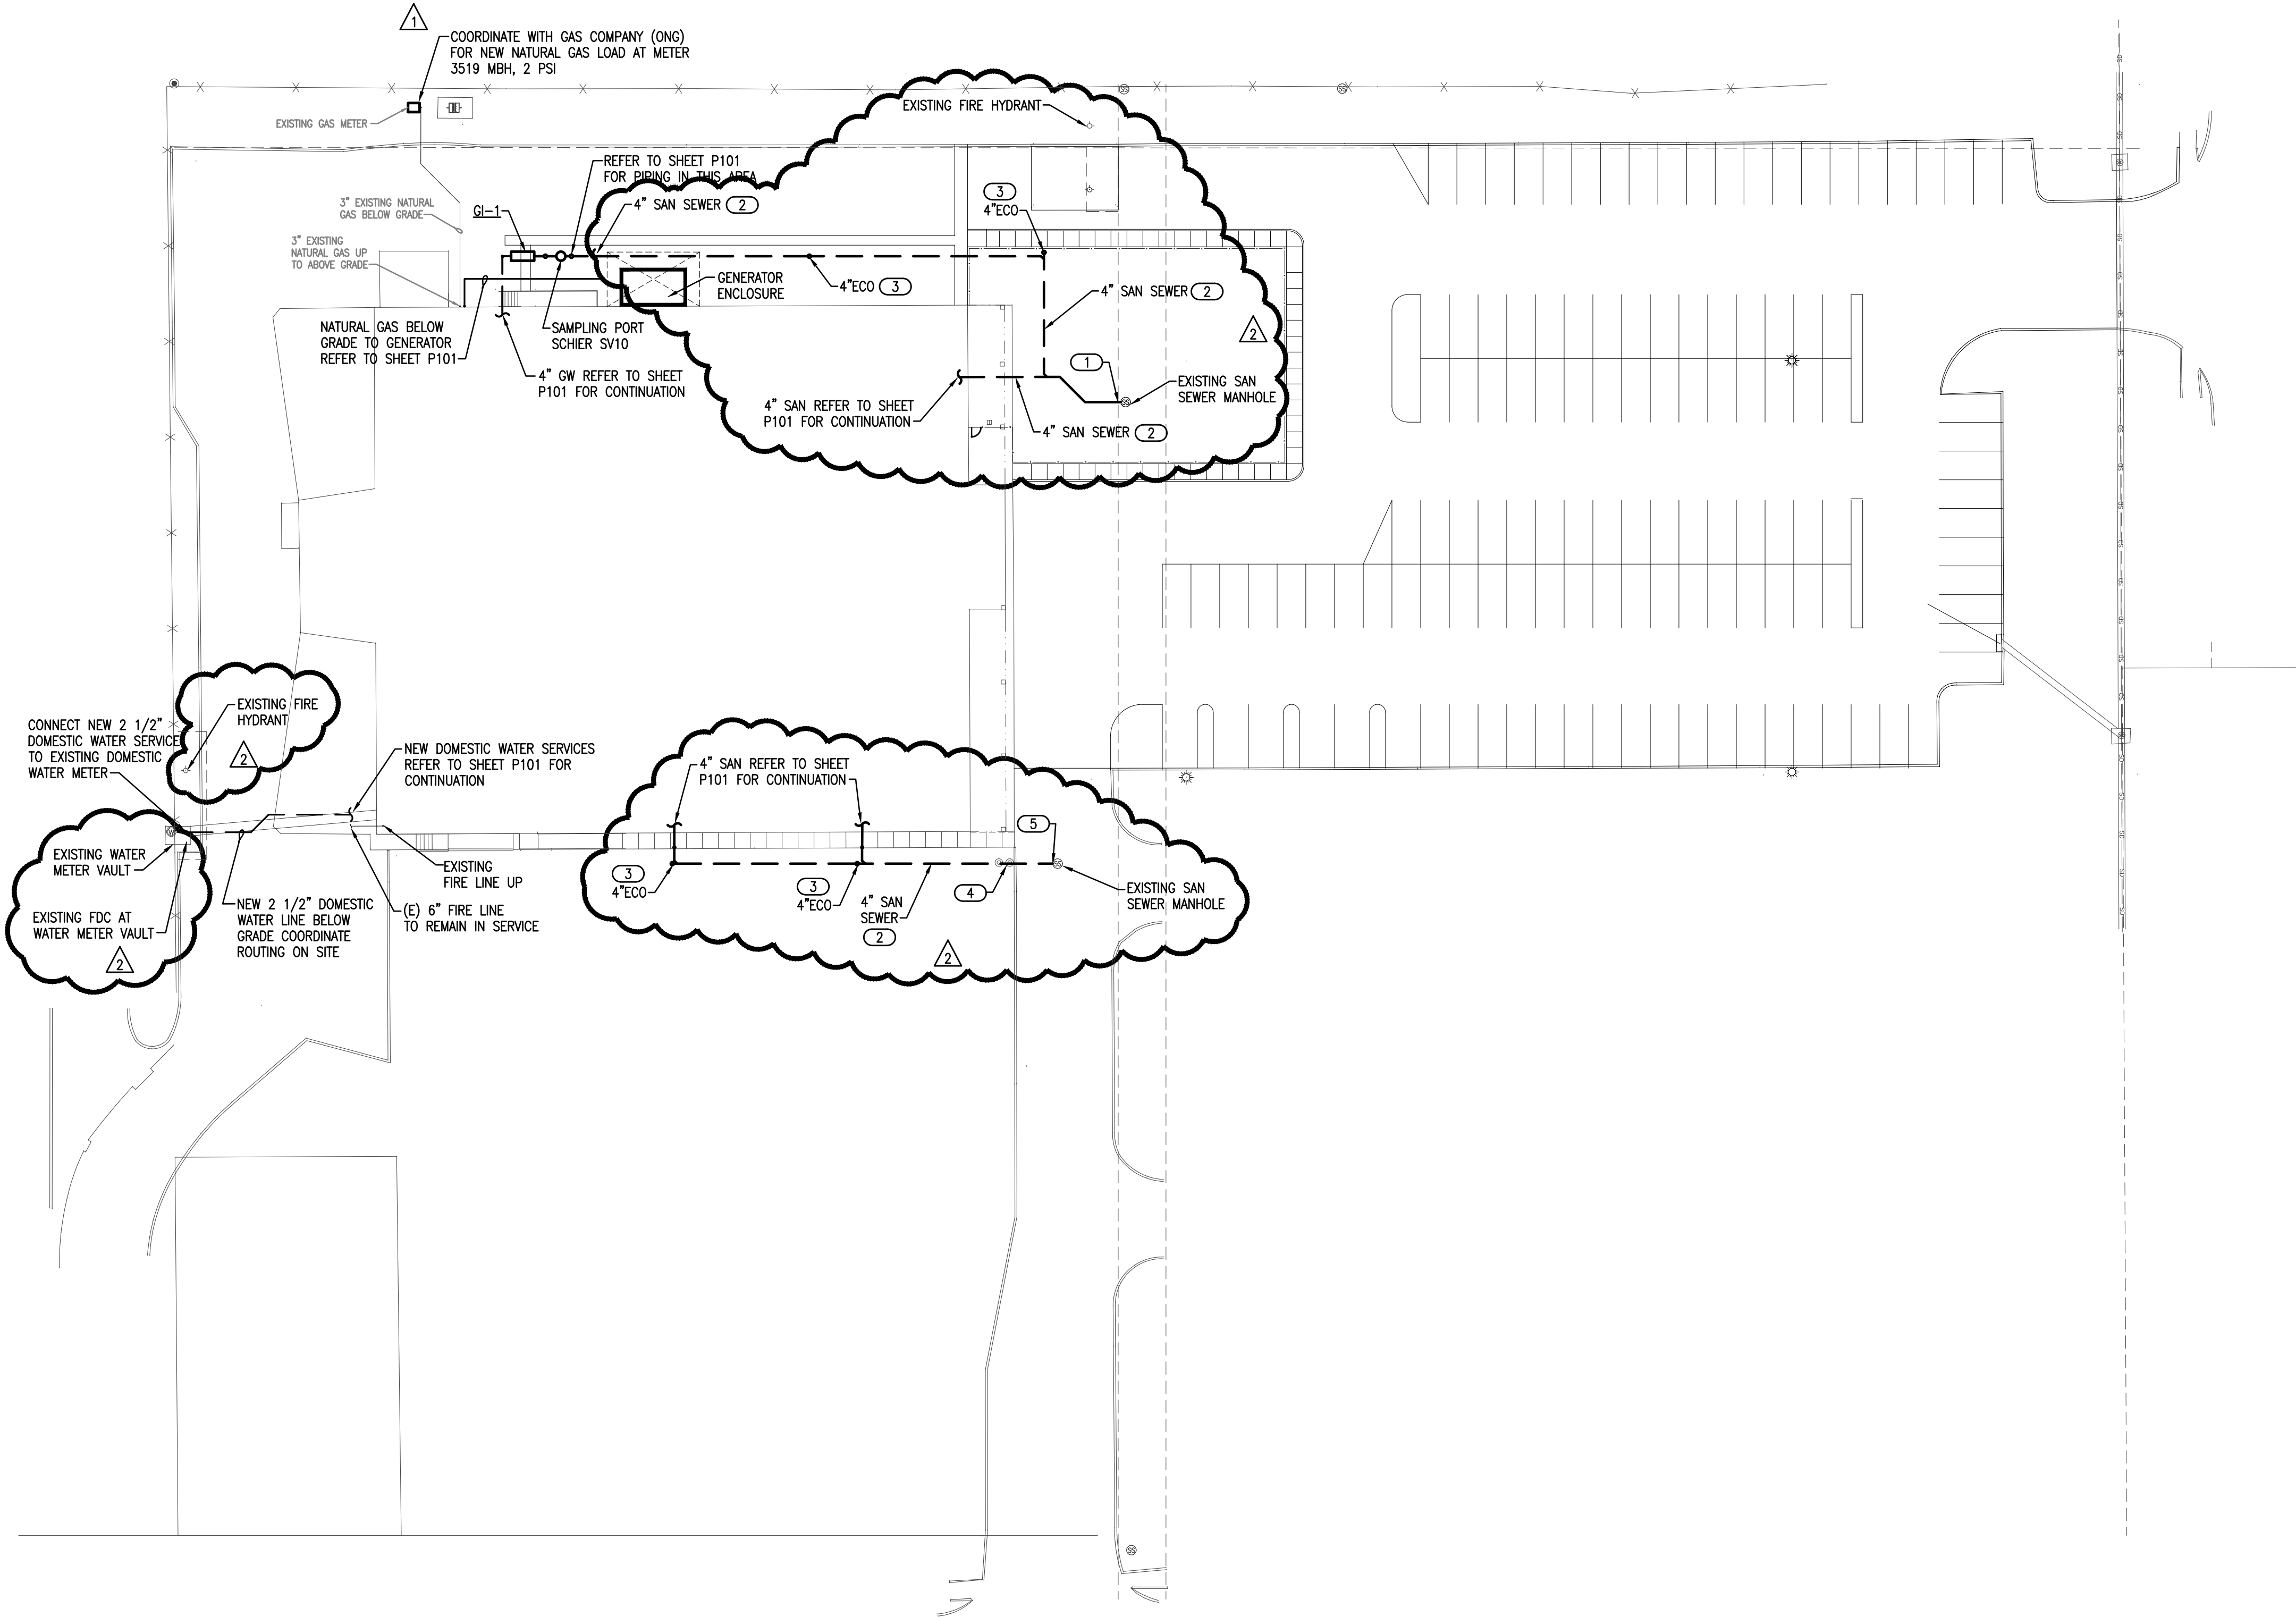

KS	drawn by
KP	checked by
OCTOBER 2024	date
revisions	
11/22/2024 AD 02	
12/12/2024 AD 03	



CHILD CARE FACILITY
201 N. EASTERN AVE.

sheet no:

P001

1 PLUMBING SITE PLAN

SCALE: 1/32" = 1'-0"



Salas O'Brien
2900 S. Telephone Road, Suite 120
Moore, OK 73160
Salas O'Brien Registration: CA# 7058
Expiration Date: 6/30/2025
Salas O'Brien Project Number: 2450-70304-00

OWNERSHIP USE OF DOCUMENTS:
AGP EXPRESSLY RESERVES ITS COPYRIGHT AND OTHER PROPERTY RIGHTS OF ALL PLANS AND DRAWINGS DESIGNED AND/OR PRODUCED. PLANS AND DRAWINGS ARE NOT TO BE REPRODUCED IN ANY FORM OR MANNER WITHOUT THE EXPRESSED WRITTEN CONSENT OF AGP.

- KEYED NOTES**
- 36 INSTALL 100 POUND PROPANE TANK WITH SUPPORT STRAP FASTENED TO WALL. INSTALL 2-STAGE PRESSURE REGULATOR WITH VENT PIPED TO ROOF WITH GOOSENECK. ROUTE 1" PROPANE GAS LINE WITH FLEXIBLE CONNECTION TO GENERATOR. (355 MBH, 10" W.C. PRESSURE). COORDINATE CONNECTION WITH GENERATOR SUPPLIER ON SITE. PRESSURE REGULATOR LOCATED 10'-0" FROM GENERATOR CONNECTION.
 - 37 DUAL FUEL GENERATOR WITH AUTOMATIC SWITCH OVER TO PROPANE WHEN UNIT SENSES LOSS OF NATURAL GAS PRESSURE IN FUEL INLET 1.
 - 38 INSTALL 2" OPEN SITE DRAIN IN CHASE FOR CONDENSATE DRAIN LINES FROM RTU'S. CONNECT TO SANITARY SERVING LAVATORY. COORDINATE ROUTING WITH MC. COORDINATE WALL ACCESS PANEL WITH GC.
 - 39 INSTALL 1 1/2" OPEN SITE DRAIN IN SINK CABINET FOR CONDENSATE DRAIN LINES FROM RTU'S. CONNECT TO SANITARY SERVING SINK. COORDINATE ROUTING WITH MC.


- KEYED NOTES**
- 32 ROUTE 1/2" CW AND 1/2" HW DOWN IN FUR OUT OF EXISTING CMU WALL TO SERVE PREP SINK #24 PROVIDED BY FSC. COORDINATE PIPE ROUTING WITH GC. ROUGH-IN AND PROVIDE FINAL UNIT CONNECTION.
 - 33 3/4" CW AND 3/4" HW DROPS IN WALL TO SERVE FAUCET AND HOSE REEL #13 PROVIDED BY FSC. ROUTE DRAIN LINE TO FLOOR SINK WITH AIR GAP. ROUGH-IN AND PROVIDE FINAL UNIT CONNECTION.
 - 34 CONNECT NEW 1" NATURAL GAS LINE (2 PSI) WITH LOCKABLE SHUT-OFF VALVE TO EXISTING 3" NATURAL GAS RISER AND ROUTE DOWN TO BELOW GRADE TO SERVE GENERATOR.
 - 35 INSTALL 1" NATURAL GAS (2 PSI) BALL VALVE, DRIP LEG, PRESSURE REGULATOR, UNION AND FINAL 1" CONNECTION (10" W.C. PRESSURE) WITH FLEXIBLE CONNECTION TO GENERATOR. COORDINATE CONNECTION WITH GENERATOR SUPPLIER ON SITE. PRESSURE REGULATOR LOCATED 10'-0" FROM GENERATOR CONNECTION.

- KEYED NOTES**
- 28 3/4" CW AND 3/4" HW DROPS IN WALL TO SERVE 2 FAUCETS AT #12 3-COMPARTMENT SINK PROVIDED BY FSC. ROUTE DRAIN LINES TO FLOOR SINK WITH AIR GAP. ROUGH-IN AND PROVIDE FINAL UNIT CONNECTION. SEE DETAIL 15/P502.
 - 29 ROUTE 3/4" CW AND 3/4" HW DOWN IN WALL TO BELOW COUNTERTOP. STUB OUT, INSTALL BALL VALVES AND CONNECT TO WATER TROUGH MIXING VALVE FURNISHED BY FSC. SEE FSC SHEET FS301.
 - 30 1/2" CW AND 1/2" HW DOWN IN WALL TO SERVE KETTLE #35 FAUCET PROVIDED BY FSC. ROUGH-IN AND PROVIDE FINAL UNIT CONNECTION.
 - 31 CONNECT 1/2" HW TO FAUCET AT SERVING COUNTER FOOD WELL. ROUTE 1/2" HW LINE DOWN WITH TRANSITION TO PEX TUBING TO BELOW FLOOR. ROUGH-IN AND PROVIDE FINAL UNIT CONNECTIONS.


- KEYED NOTES**
- 24 ROUTE 1/2" CW DOWN TO WATER FILTER AND CONNECT TO ICE MAKER #45. ROUGH-IN AND PROVIDE FINAL UNIT CONNECTION. ICE MAKER PROVIDED BY KEC. ROUTE DRAIN LINE TO FLOOR DRAIN.
 - 25 INSTALL 3/4" CW DROP IN WALL TO SERVE CONVENTION STEAMER PROVIDED BY KEC. ROUTE DRAIN LINE TO FLOOR SINK WITH AIR GAP. ROUGH-IN AND PROVIDE FINAL UNIT CONNECTION.
 - 26 ROUTE 1/2" CW, 1/2" HW AND 2" VENT DOWN IN WALL TO SERVE HAND SINK PROVIDED BY KEC. PROVIDE THERMOSTATIC MIXING VALVE TMV-1 AND PIPE WRAP UNDER FIXTURE. ROUGH-IN AND PROVIDE FINAL UNIT CONNECTION.
 - 27 1/2" CW AND 3/4" HW DROPS IN WALL TO SERVE DISHWASHER #11 PROVIDED BY KEC. ROUGH-IN AND PROVIDE FINAL UNIT CONNECTION. PROVIDE WATER ARRESTORS, PRVs AND BALL VALVES ON WATER LINES IN ACCESSIBLE LOCATION. ROUTE DRAIN LINE TO FLOOR SINK.

- GENERAL NOTES**
- COORDINATE WORK WITH ALL OTHER TRADES ON SITE.
 - PROVIDE WATER HAMMER ARRESTORS (HA) ON WATER LINES TO FLUSH VALVES, AND QUICK CLOSING VALVES. LOCATE UNITS IN ACCESSIBLE LOCATIONS.
 - SINK AND LAVATORY WATER SUPPLY STUB OUTS SHALL BE COPPER PIPE WITH SUPPORT BRACKET FASTENED IN WALL CAVITY.
 - FIRE SEAL ALL PENETRATIONS THRU RATED STRUCTURES TO MAINTAIN FIRE RATING.
 - REFER TO PLUMBING FIXTURE SCHEDULE ON SHEET P601 FOR FIXTURE ROUGH-IN PIPE SIZES. REFER TO ISOMETRIC SHEETS P301 AND P302 FOR ADDITIONAL PIPE SIZES.
 - PROVIDE ACCESS PANELS FOR ALL VALVES/DEVICES ABOVE HARD CEILINGS AND BEHIND WALLS.
 - ALL GAS PIPE SHALL COMPLY WITH IFCC. BRANCH LINES SHALL TAP OFF TOP OF GAS MAINS AND INSTALL SHUT-OFF VALVE ON BRANCH LINE.
 - TRAP PRIMER LINES SHALL BE COPPER TYPE "K" OR PEX-a TUBING WITH CONTINUOUS SLOPE TOWARDS DRAIN CONNECTION.
 - FIELD VERIFY EXISTING CONDITIONS PRIOR TO COMMENCING WORK.


- KEYED NOTES**
- INSTALL ELECTRIC TRAP PRIMER ASSEMBLY (TP-1) ABOVE LAY-IN CEILING IN ACCESSIBLE LOCATION. ROUTE (4) 1/2" DISCHARGE LINES TO FLOOR DRAINS IN THIS AREA. COORDINATE POWER WITH EC. SEE DETAIL 1/P501.
 - INSTALL ELECTRIC TRAP PRIMER ASSEMBLY (TP-1) ABOVE LAY-IN CEILING IN ACCESSIBLE LOCATION. ROUTE (3) 1/2" DISCHARGE LINES TO FLOOR DRAINS OR FLOOR SINKS IN THIS AREA. COORDINATE POWER WITH EC. SEE DETAIL 1/P501.
 - INSTALL ELECTRIC TRAP PRIMER ASSEMBLY (TP-1) ABOVE LAY-IN CEILING IN ACCESSIBLE LOCATION. ROUTE (2) 1/2" DISCHARGE LINES TO FLOOR DRAINS IN THIS AREA. COORDINATE POWER WITH EC. SEE DETAIL 1/P501.
 - FIELD VERIFY LOCATION OF EXISTING WALL HYDRANT AND CONNECT NEW 3/4" CW TO EXISTING PIPE SERVING WALL HYDRANT.
 - ROUTE INSULATED 2 1/2" CW PIPE DOWN WITH BALL VALVE AT 24" AFF. AND CONNECT TO NEW WATER SERVICE.
 - ROUTE 2" CW PIPE DOWN TO BELOW FLOOR. INSTALL ACCESS PANEL IN BACK OF CABINET FOR BALL VALVE. SEE SHEET P101 FOR CONTINUATION.
 - ROUTE 1/2" CW, 1/2" HW AND 1 1/2" VENT IN CHASE TO SERVE LAVATORY. INSTALL THERMOSTATIC MIXING VALVE (TMV-1) BELOW FIXTURE. SEE DETAIL 5/P501.
 - 1/2" CW, 1/2" HW AND 1 1/2" VENT DOWN IN WALL TO SERVE SINK. INSTALL THERMOSTATIC MIXING VALVE (TMV-1) BELOW FIXTURE. SEE DETAIL 5/P501.
 - 1/2" CW, 1/2" HW AND 1 1/2" VENT DOWN INTO FUR OUT OF EXISTING CMU WALL TO SERVE SINK. INSTALL THERMOSTATIC MIXING VALVE (TMV-1) BELOW FIXTURE. SEE DETAIL 5/P501. COORDINATE PIPE ROUTING WITH ARCHITECT AND GC.
 - INSTALL TRAP PRIMER (TP-2) UNDER LAVATORY. INSTALL PER MANUFACTURER'S RECOMMENDATIONS. SEE DETAIL 11/P501.
 - COORDINATE WITH STRUCTURAL FOR DEBRIS GUARD BELOW SHELTER ROOF FOR PLUMBING VENT ROOF PENETRATION.
 - 1/2" CW, 1/2" HW AND 1 1/2" VENT DOWN IN WALL TO SERVE LAVATORY. INSTALL THERMOSTATIC MIXING VALVE (TMV-1) BELOW FIXTURE. SEE DETAIL 5/P501.
 - 3/4" CW UP TO ROOF HYDRANT. SEE SHEET P201 FOR CONTINUATION.
 - ROUTE 1/2" CW, 3/4" HW AND 3/4" HWR DOWN IN WALL WITH PEX TUBING TO BELOW FLOOR TO SERVE ISLAND PREP SINK.
 - ROUTE 1" NG (LOW PRESS) BEHIND EQUIPMENT AND PROVIDE 3/4" GAS TO KITCHEN EQUIPMENT (33 & 34) PROVIDED BY KEC. PROVIDE SHUT-OFF VALVE AND FINAL UNIT CONNECTION. SEE DETAIL 9/P501.
 - ROUTE 1/2" CW, 1/2" HW AND 2" VENT IN FUR OUT OF EXISTING CMU WALL TO SERVE HAND SINK (#8) PROVIDED BY KEC. PROVIDE THERMOSTATIC MIXING VALVE TMV-1 AND PIPE WRAP UNDER FIXTURE. COORDINATE PIPE ROUTING WITH GC.
 - CONNECT NEW 1 1/4" NATURAL GAS LINE (2 PSI) TO EXISTING 3" NATURAL GAS RISER AND ROUTE NEW LINE INTO BUILDING.
 - ROUTE 3/4" CW DOWN IN WALL WITH TRANSITION TO PEX TUBING TO BELOW FLOOR TO SERVE ICE MAKER PROVIDED BY KEC. ROUGH-IN AND PROVIDE FINAL UNIT CONNECTION.
 - INSTALL 3/4" NATURAL GAS (2 PSI) BALL VALVE AND PRESSURE REGULATOR (KITCHEN EQUIP). INSTALL GAS SOLENOID VALVE FURNISHED BY KITCHEN EQUIPMENT SUPPLIER AND COORDINATE POWER WITH EC TO INTERLOCK WITH EXHAUST HOOD FIRE SUPPRESSION SYSTEM. ROUTE 1" NG (LOW PRESS) TO KITCHEN EQUIPMENT.
 - ROUTE 1/2" CW, 3/4" HW AND 3/4" HWR UP FROM BELOW FLOOR, TRANSITION TO COPPER PIPE AND CONNECT TO COOK'S TABLE SINK PROVIDED BY KEC. ROUGH-IN AND PROVIDE FINAL UNIT CONNECTION.
 - INSTALL 1/2" BALL VALVE AND PRESSURE REGULATOR IN NATURAL GAS LINE SUPPLYING DRYER #6. PROVIDE 1/2" LOW PRESSURE GAS DOWN IN WALL TO GAS VALVE BOX (GVB-1) AND FLEXIBLE CONNECTION TO UNIT.
 - CLOTHES WASHER FURNISHED BY OTHERS. ROUGH-IN AND MAKE FINAL CONNECTION. PROVIDE 1/2" CW AND 1/2" HW LINES DOWN IN WALL TO LAUNDRY BOX. CONNECT FLEXIBLE SUPPLY LINES TO WASHER. ROUTE WASHER DRAIN LINE INTO WALL BOX DRAIN FITTING AND SECURE. COORDINATE WITH EQUIPMENT SUPPLIER.
 - COORDINATE WITH FOOD SERVICE CONTRACTOR FOR ROUTING CONDENSATE DRAIN LINES TO FLOOR DRAIN FROM FREEZER OR COOLER. SEE SHEET FS301.

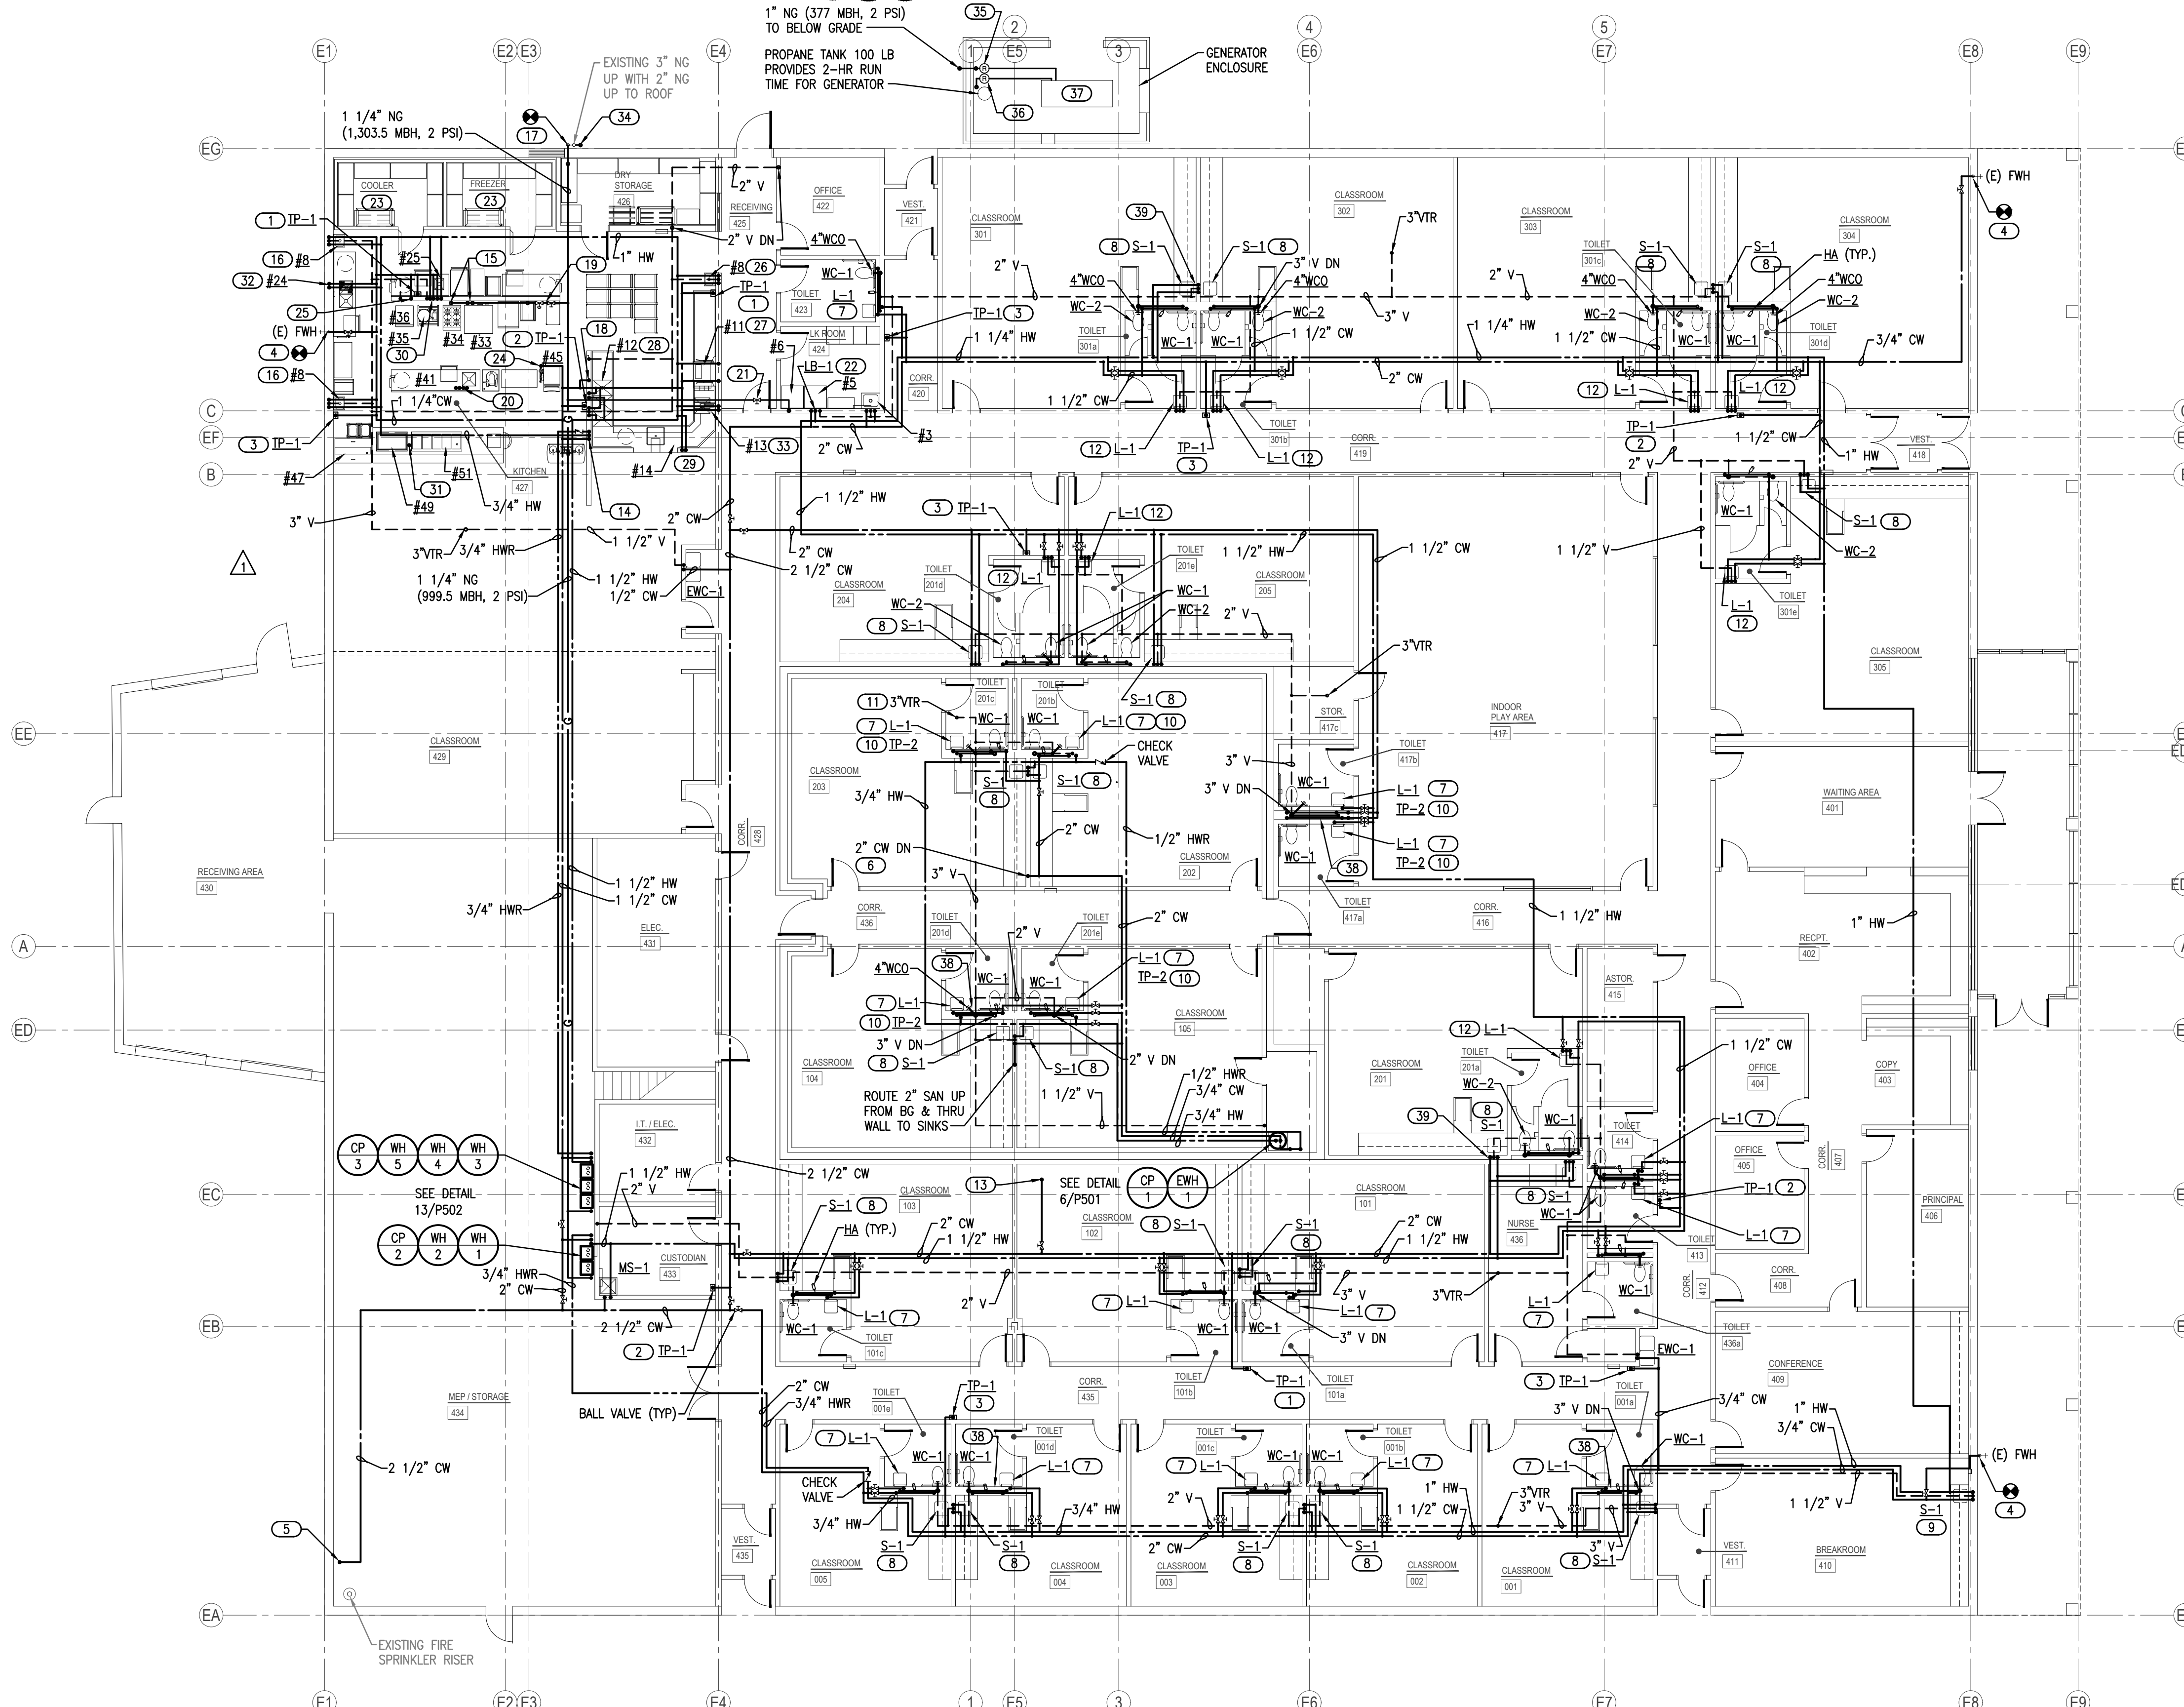

1 PLUMBING PLAN - ABOVE GRADE
SCALE: 3/32" = 1'-0"

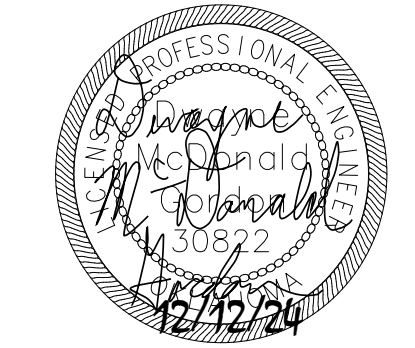

KS
drawn by
KP
checked by
OCTOBER 2024
date
revisions
11/22/2024 AD 02
12/12/2024 AD 03

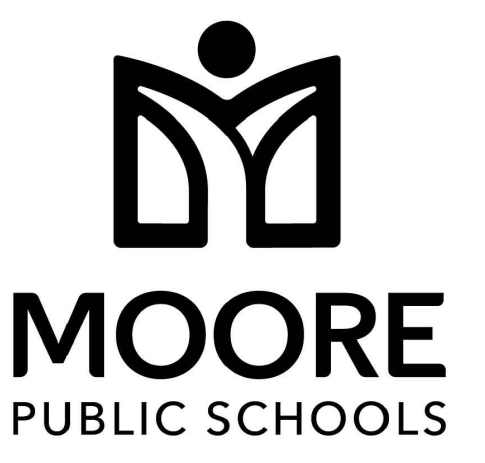


CHILD CARE FACILITY
201 N. EASTERN AVE.

sheet no:

P110

Salas O'Brien
2800 S. Telephone Road, Suite 120
Moore, OK 73160
Salas O'Brien Registration: CA# 7058
Expiration Date: 6/30/2025
Salas O'Brien Project Number: 2450-70304-00

OWNERSHIP USE OF DOCUMENTS:
AGP EXPRESSLY RESERVES ITS COPYRIGHT AND OTHER PROPERTY RIGHTS OF ALL PLANS AND DRAWINGS DESIGNED AND/OR PRODUCED. PLANS AND DRAWINGS ARE NOT TO BE REPRODUCED IN ANY FORM OR MANNER WITHOUT THE EXPRESSED WRITTEN CONSENT OF AGP.

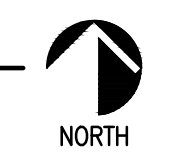

LIGHT FIXTURE SCHEDULE				
TYPE	SYMBOL	DESCRIPTION	MANUFACTURER	REFERENCE CATALOG #
A1		2X4 LED FLAT PANEL. 26W, 4000 LUMENS, 3500K CCT. 0-10V DIMMING.	LITHONIA	CPX 2X4 AL08 80CRI SSW7 SWL MVOLT
A1E		2X4 LED FLAT PANEL. 26W, 4000 LUMENS, 3500K CCT. 0-10V DIMMING. PROVIDE WITH UL924 DEVICE	LITHONIA	CPX 2X4 AL08 80CRI SSW7 SWL MVOLT
A2		2X4 LED FLAT PANEL. 36W, 5000 LUMENS, 3500K CCT. 0-10V DIMMING.	LITHONIA	CPX 2X4 AL08 80CRI SSW7 SWL MVOLT
A2E		2X4 LED FLAT PANEL. 36W, 5000 LUMENS, 3500K CCT. 0-10V DIMMING. PROVIDE WITH UL924 DEVICE.	LITHONIA	CPX 2X4 AL08 80CRI SSW7 SWL MVOLT
A3		2X4 LED FLAT PANEL. 45W, 6000 LUMENS, 3500K CCT. 0-10V DIMMING.	LITHONIA	CPX 2X4 AL08 80CRI SSW7 SWL MVOLT
A3E		2X4 LED FLAT PANEL. 45W, 6000 LUMENS, 3500K CCT. 0-10V DIMMING. PROVIDE WITH UL924 DEVICE.	LITHONIA	CPX 2X4 AL08 80CRI SSW7 SWL MVOLT
A4		2X2 LED FLAT PANEL. 35W, 4000 LUMENS, 3500K CCT. 0-10V DIMMING.	LITHONIA	CPX 2X2 AL07 80CRI SSW7 SWL MVOLT
C		6" LED RECESSED LED DOWNLIGHT. 13W, 1000 LUMEN, 3500K CCT. 0-10V DIMMING.	LITHONIA	LBR6 NCH AL02 SSW1 AR LSS WD MVOLT UG2
CE		6" LED RECESSED LED DOWNLIGHT. 13W, 1000 LUMEN, 3500K CCT. 0-10V DIMMING. PROVIDE WITH UL924 DEVICE.	LITON	LBR6 NCH AL02 SSW1 AR LSS WD MVOLT US2
EX		LED EXIT SIGN, STAINLESS STEEL FACE WITH RED LETTERS, UNIVERSAL FACE AND MOUNTING, PROVIDE WITH UL924 DEVICE.	LIFE SAFETY LIGHTING	LSXDC 3 R A A EM SDT
L		2" X 4" LED EXTERIOR FIXTURE 1028 LUMENS/FT, 4000K CCT. SURFACE MOUNT	A-LIGHT	LIN 3 SP M4 LH 40 U HE F X D
LE		2" X 4" LED EXTERIOR FIXTURE 1028 LUMENS/FT, 4000K CCT. SURFACE MOUNT PROVIDE WITH UL924 DEVICE.	A-LIGHT	LIN 3 SP M4 LH 40 U HE F X D EC
P2		6" CIRCULAR LED PENDANT. 156W, 13,000 LUMENS, 3500K CCT. 0-10V DIMMING.	DELRAY	UCDC6 W35 SR D
P2E		6" CIRCULAR LED PENDANT. 156W, 13,000 LUMENS, 3500K CCT. 0-10V DIMMING. PROVIDE WITH UL924 DEVICE.	DELRAY	UCDC6 W35 SR D
R1		SINGLE HEAD PARKING LOT FIXTURE, 7-PIN RECEPTACLE CONTROL 187W, 25,000 LUMENS, 4000K CCT.	LITHONIA	RSX2-LED-P4-40K-R3-208V-RPA-PER7-DBXD-DLL127F 1.5JU
R2		DOUBLE HEAD PARKING LOT FIXTURE, 7-PIN RECEPTACLE CONTROL (2) 187W, 25,000 LUMENS, 4000K CCT.	LITHONIA	RSX2-LED-P4-40K-R3-208V-RPA-PER7-DBXD-DLL127F 1.5JU
R2-P		PARKING LOT POLE	LITHONIA	RTS-25'-7'-0F-DM28AS-0DBXD
S		4" LED LENSED STRIP FIXTURE. 35W, 5000 LUMENS, 4000K CCT. 0-10V DIMMING.	LITHONIA	CSS L48 AL03 MVOLT SSW3 80CRI
SE		4" LED LENSED STRIP FIXTURE. 35W, 5000 LUMENS, 4000K CCT. 0-10V DIMMING. PROVIDE WITH UL924 DEVICE.	LITHONIA	CSS L48 AL03 MVOLT SSW3 80CRI
T		4" LED VAPOR TIGHT STRIP FIXTURE. 42W, 5000 LUMENS, 4000K CCT. 0-10V DIMMING.	LITHONIA	CSVT L48 AL03 MVOLT SSW3 80CRI
TE		4" LED VAPOR TIGHT STRIP FIXTURE. 42W, 5000 LUMENS, 4000K CCT. 0-10V DIMMING. PROVIDE WITH UL924 DEVICE.	LITHONIA	CSVT L48 AL03 MVOLT SSW3 80CRI
V		2" LED VANITY FIXTURE. 9W, 300 LUMENS/FT DIRECT AND INDIRECT, 3500K CCT. 0-10V DIMMING.	MARK LIGHTING	S2WID LLP 2FT MSL2 80CRI 35K 300LMF 180 135K 1300LMF AS SCT MIN10 FL MVOLT WHTT ZT
W1E		2400 LUMEN, 4000K CT, LED WALL PACK PROVIDE WITH UL924 DEVICE.	LITHONIA	WPX1 LED P2 40K MVOLT DBLXD

GENERAL NOTES:
EQUIVALENT ALTERNATE LIGHT FIXTURES MAY BE PROVIDED FOR BIDDING PURPOSES. THE ENGINEER DOES NOT TAKE RESPONSIBILITY FOR ENSURING ALTERNATE LIGHT FIXTURES USED FOR BIDDING ARE EQUAL. THE CONTRACTOR SHALL BE RESPONSIBLE FOR ENSURING ALTERNATE FIXTURES ARE EQUIVALENT TO THOSE SPECIFIED PRIOR TO BID. THE WINNING BID PACKAGE SHALL BE SUBMITTED TO THE ENGINEER FOR REVIEW IN ACCORDANCE WITH THE SPECIFICATIONS.

ELECTRICAL ABBREVIATIONS			
AC	ABOVE COUNTERTOP	MC	MECHANICAL CONTRACTOR
AFF	ABOVE FINISH FLOOR	MCA	MINIMUM CIRCUIT AMPS
AFG	ABOVE FINISH GRADE	MCB	MAIN CIRCUIT BREAKER
ANNC	ANNUNCIATOR	MDP	MAIN DISTRIBUTION PANEL
CC	CONTROLS CONTRACTOR	MLO	MAIN LUG ONLY
DF	DRINKING FOUNTAIN	MTD	MOUNTED
EC	ELECTRICAL CONTRACTOR	NIC	NOT IN CONTRACT
EF	EXHAUST FAN	OCC	OCCUPANCY
ERMS	ENERGY REDUCTION MAINTENANCE SWITCH	PC	PLUMBING CONTRACTOR
EX	EXISTING	PNL	PANEL
EXR	EXISTING RELOCATED	SPST	SINGLE POLE SINGLE THROW
GC	GENERAL CONTRACTOR	TIB	TELEPHONE TERMINAL BOARD
GFI	GROUND FAULT INTERRUPT	TYP	TYPICAL
HP	HORSEPOWER	WG	WIRE GUARD
IBC	INTERNATIONAL BUILDING CODE	WP	WEATHER PROOF
IG	ISOLATED GROUND	20A	20 AMP
LSIG	LONG TIME, SHORT TIME, INSTANTANEOUS, AND GROUND	Ø	PHASE
LV	LOW VOLTAGE	3W	3 WIRE
LVPR	LV RELAY PANEL	1P20A	SINGLE POLE 20 AMP

SWITCH LEGEND	
SYMBOL	DESCRIPTION
\$	20A, SPST SWITCH
\$ _o	20A, LETTER INDICATES GROUP
\$ ₃	20A, 3-WAY
\$ ₄	20A, 4-WAY
\$ _D	DIMMER SWITCH
\$ _K	KEY OPERATED SWITCH
\$ _{OC}	OCCUPANCY SENSOR SWITCH

GENERAL NOTE:
SEE SPECIFICATIONS FOR MANUFACTURERS

RECEPTACLE SCHEDULE	
SYMBOL	DESCRIPTION
	DUPLEX RECEPTACLE
	20A, 120V, 2P, 3W GROUNDING DUPLEX RECEPTACLE
	RECEPTACLE MTD. 6" ABOVE COUNTER OR HGT SHOWN
	GFCI RECEPTACLE
	GFCI RECEPTACLE, MTD. 6" ABOVE COUNTER OR HGT SHOWN
	20A, 120V, 2P, 3W GROUNDING DUPLEX GFCI RECEPTACLE - WEATHER PROOF (IN USE COVER)
	JUNCTION BOX, AS NOTED
	QUADPLEX RECEPTACLE

GENERAL NOTE:
SEE SPECIFICATIONS FOR MANUFACTURERS

GENERAL ELECTRICAL NOTES	
1.	CONTRACTOR TO VERIFY EXISTING ELECTRICAL CONDITIONS AND NOTIFY ARCHITECT/ENGINEER OF ANY ELECTRICAL OR CODE ISSUES PRIOR TO BID. CONTRACTOR IS RESPONSIBLE FOR PROVIDING A COMPLETE AND OPERATIONAL CODE COMPLIANT SYSTEM.
2.	ALL WORK SHALL BE IN CONFORMANCE WITH NATIONAL, STATE, AND LOCAL CODES AND/OR ORDINANCES.
3.	ELECTRICAL CONTRACTOR SHALL COORDINATE WORK WITH ALL OTHER CONTRACTORS & LOCAL UTILITY. E.G. SHALL CONTACT LOCAL UTILITY FOR EXACT SERVICE REQUIREMENTS TO INCLUDE BUT NOT LIMITED TO TRANSFORMER, METERING AND CABLING. LOCAL UTILITY REQUIREMENTS SUPERSEDE DRAWINGS AND SPECIFICATIONS.
4.	SEE ARCHITECTURAL, MECHANICAL, & PLUMBING DRAWINGS FOR ADDITIONAL REQUIREMENTS.
5.	ELECTRICAL DRAWINGS ARE DIAGRAMMATIC ONLY. THEY ARE INTENDED TO GIVE APPROXIMATE LOCATIONS AND OVERALL DESIGN INTENT. THE ELECTRICAL CONTRACTOR SHALL BE RESPONSIBLE FOR PRODUCTS, MATERIALS, AND ELECTRICAL METHODS WHICH HAVE NOT BEEN SHOWN OR INDICATED BUT ARE REQUIRED FOR A COMPLETE SYSTEM TO THE STANDARDS OF THE INDUSTRY.
6.	INSTALL LIGHTING FIXTURES IN ACCORDANCE WITH MANUFACTURER'S RECOMMENDATIONS. PROVIDE SUPPORTING DEVICES FOR ADEQUATE SUPPORT OF FIXTURES FROM STRUCTURE.
7.	UPON COMPLETION OF THE ELECTRICAL WORK, THE INSTALLATION SHALL BE TESTED FOR CONTINUITY, GROUNDS, AND SHORT CIRCUITS. THE ELECTRICAL CONTRACTOR SHALL DEMONSTRATE PROPER PERFORMANCE OF ALL SYSTEMS. ALL DEFECTIVE WORK OR MATERIALS SHALL BE REPLACED OR REPAIRED AS NECESSARY AND RETESTED.
8.	ELECTRICAL RACEWAYS THAT PENETRATE FIRE RATED ASSEMBLIES SHALL BE SLEEVED AND SEALED AS PER THE LOCAL BUILDING CODE.
9.	THE ELECTRICAL CONTRACTOR SHALL PROVIDE A TEMPORARY ELECTRICAL SYSTEM FOR THE PROJECT. AT LEAST ONE 120 VOLT SINGLE PHASE RECEPTACLE SHALL BE PROVIDED FOR EACH 500 SQUARE FEET OF FLOOR SPACE. SUFFICIENT TEMPORARY LIGHTING SHALL BE PROVIDED TO ALLOW ALL CONTRACTORS TO COMPLETE THEIR WORK. TEMPORARY ELECTRICAL CIRCUITS SHALL BE EQUIPPED WITH COMBINATION GROUND FAULT INTERRUPTER AND CIRCUIT BREAKER PER NEC. TEMPORARY ELECTRICAL SYSTEM SHALL BE INCLUDED IN THIS BID. USAGE CHARGES SHALL BE PAID FOR BY THE GENERAL CONTRACTOR.

ELECTRICAL LEGEND	
	PANEL BOARD
	DISTRIBUTION PANEL BOARD
	TRANSFORMER
	UTILITY METER
	SEPARATE CIRCUIT BREAKER
	DISCONNECT
	FUSED DISCONNECT SWITCH
	EMERGENCY FUSED DISCONNECT SWITCH
	MOTOR STARTER/CONTRACTOR
	COMBINATION MOTOR STARTER
	PUSH BUTTON STATION AS NOTED
	PULL BOX, SIZE AS REQUIRED BY CODE
	ELECTRICAL CONNECTION
	MOTOR CONNECTION
	HOME RUN TO PANEL BOARD


ELECTRICAL SHEET INDEX	
E000	ELECTRICAL TITLE SHEET
E100	ELECTRICAL SITE PLAN
E101	ELECTRICAL LIGHTING PLAN
E201	ELECTRICAL POWER PLAN
E202	ELECTRICAL ROOF PLAN
E203	ELECTRICAL KITCHEN PLAN
E401	ELECTRICAL ONE-LINE DIAGRAM
E501	ELECTRICAL DETAILS SHEET
E502	ELECTRICAL DETAILS SHEET
E601	ELECTRICAL SCHEDULES
E602	ELECTRICAL SCHEDULES





DWG
drawn by
TVO
checked by
OCTOBER 2024
date

revisions
12/12/2024 AD 03

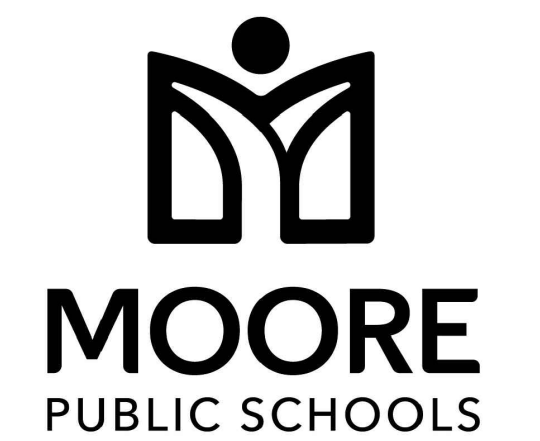

CHILD CARE FACILITY
201 N. EASTERN AVE.

sheet no:

E100


OWNERSHIP USE OF DOCUMENTS:
AGP EXPRESSLY RESERVES ITS COPYRIGHT AND OTHER PROPERTY RIGHTS OF ALL PLANS AND DRAWINGS DESIGNED AND/OR PRODUCED. PLANS AND DRAWINGS ARE NOT TO BE REPRODUCED IN ANY FORM OR MANNER WITHOUT THE EXPRESSED WRITTEN CONSENT OF AGP.

SITE GENERAL NOTES

- COORDINATE EXACT LOCATIONS OF DEVICES SHOWN WITH OTHER EQUIPMENT.
- PROVIDE (2) ELECTRONIC TIMERS WITH INTEGRAL ASTRONOMICAL TIMECLOCK AND PHOTOCELL INPUT. LOCATE PHOTOCELL WITH CLEAR VIEW OF NORTHERN SKY AND SHIELD FROM ARTIFICIAL LIGHT SOURCES. ONE TIMER SHALL CONTROL EXTERIOR WALL PACKS AND THE OTHER SHALL CONTROL THE PARKING LOT.
- THESE DRAWINGS ARE INTENDED TO BE DIAGRAMMATIC ONLY. CONSULT WITH GENERAL CONTRACTOR FOR DETAILS ON BIDDING; PROVIDE ALL PARTS AND LABOR FOR A COMPLETE AND CODE COMPLIANT FACILITY.
- ELECTRICAL CONTRACTOR TO SHOW ACTUAL ROUTING OF ALL BELOW-GRADE CONDUITS AND WIRING ON AS-BUILT DRAWINGS. ROUTES SHOWN ARE GENERAL IN NATURE AND ACTUAL ROUTE SHALL BE DETERMINED BY GENERAL CONTRACTOR AND ELECTRICAL CONTRACTOR ONSITE.
- PROVIDE GROUNDING AND BONDING AT EACH BUILDING IN ACCORDANCE WITH NEC 250.32.
- REFER TO SHEET "T-XXX" FOR ADDITIONAL CONDUIT LAYOUT INFORMATION.

KEYED NOTES

- EXISTING 208/120V 3P UTILITY TRANSFORMER.
- PROPOSED CONDUIT ROUTE. SAW CUT CONCRETE AS NECESSARY TO ENSURE CONDUIT IS ROUTED UNDER THE EXISTING CONCRETE FOUNDATION.
- PROVIDE 120V GENERATOR BLOCK HEATER CONNECTION.
- PROVIDE 120V GENERATOR BATTERY HEATER CONNECTION.
- PROVIDE 120V GENERATOR BATTERY CHARGER CONNECTION.
- MOUNT FIXTURE ON EXISTING POLE 28'-0" AFF TO BOTTOM OF LIGHT FIXTURE.
- INSTALL NEW LIGHT FIXTURE POLE AND POLE BASE. MOUNT FIXTURE 28'-0" AFF TO BOTTOM OF LIGHT FIXTURE.

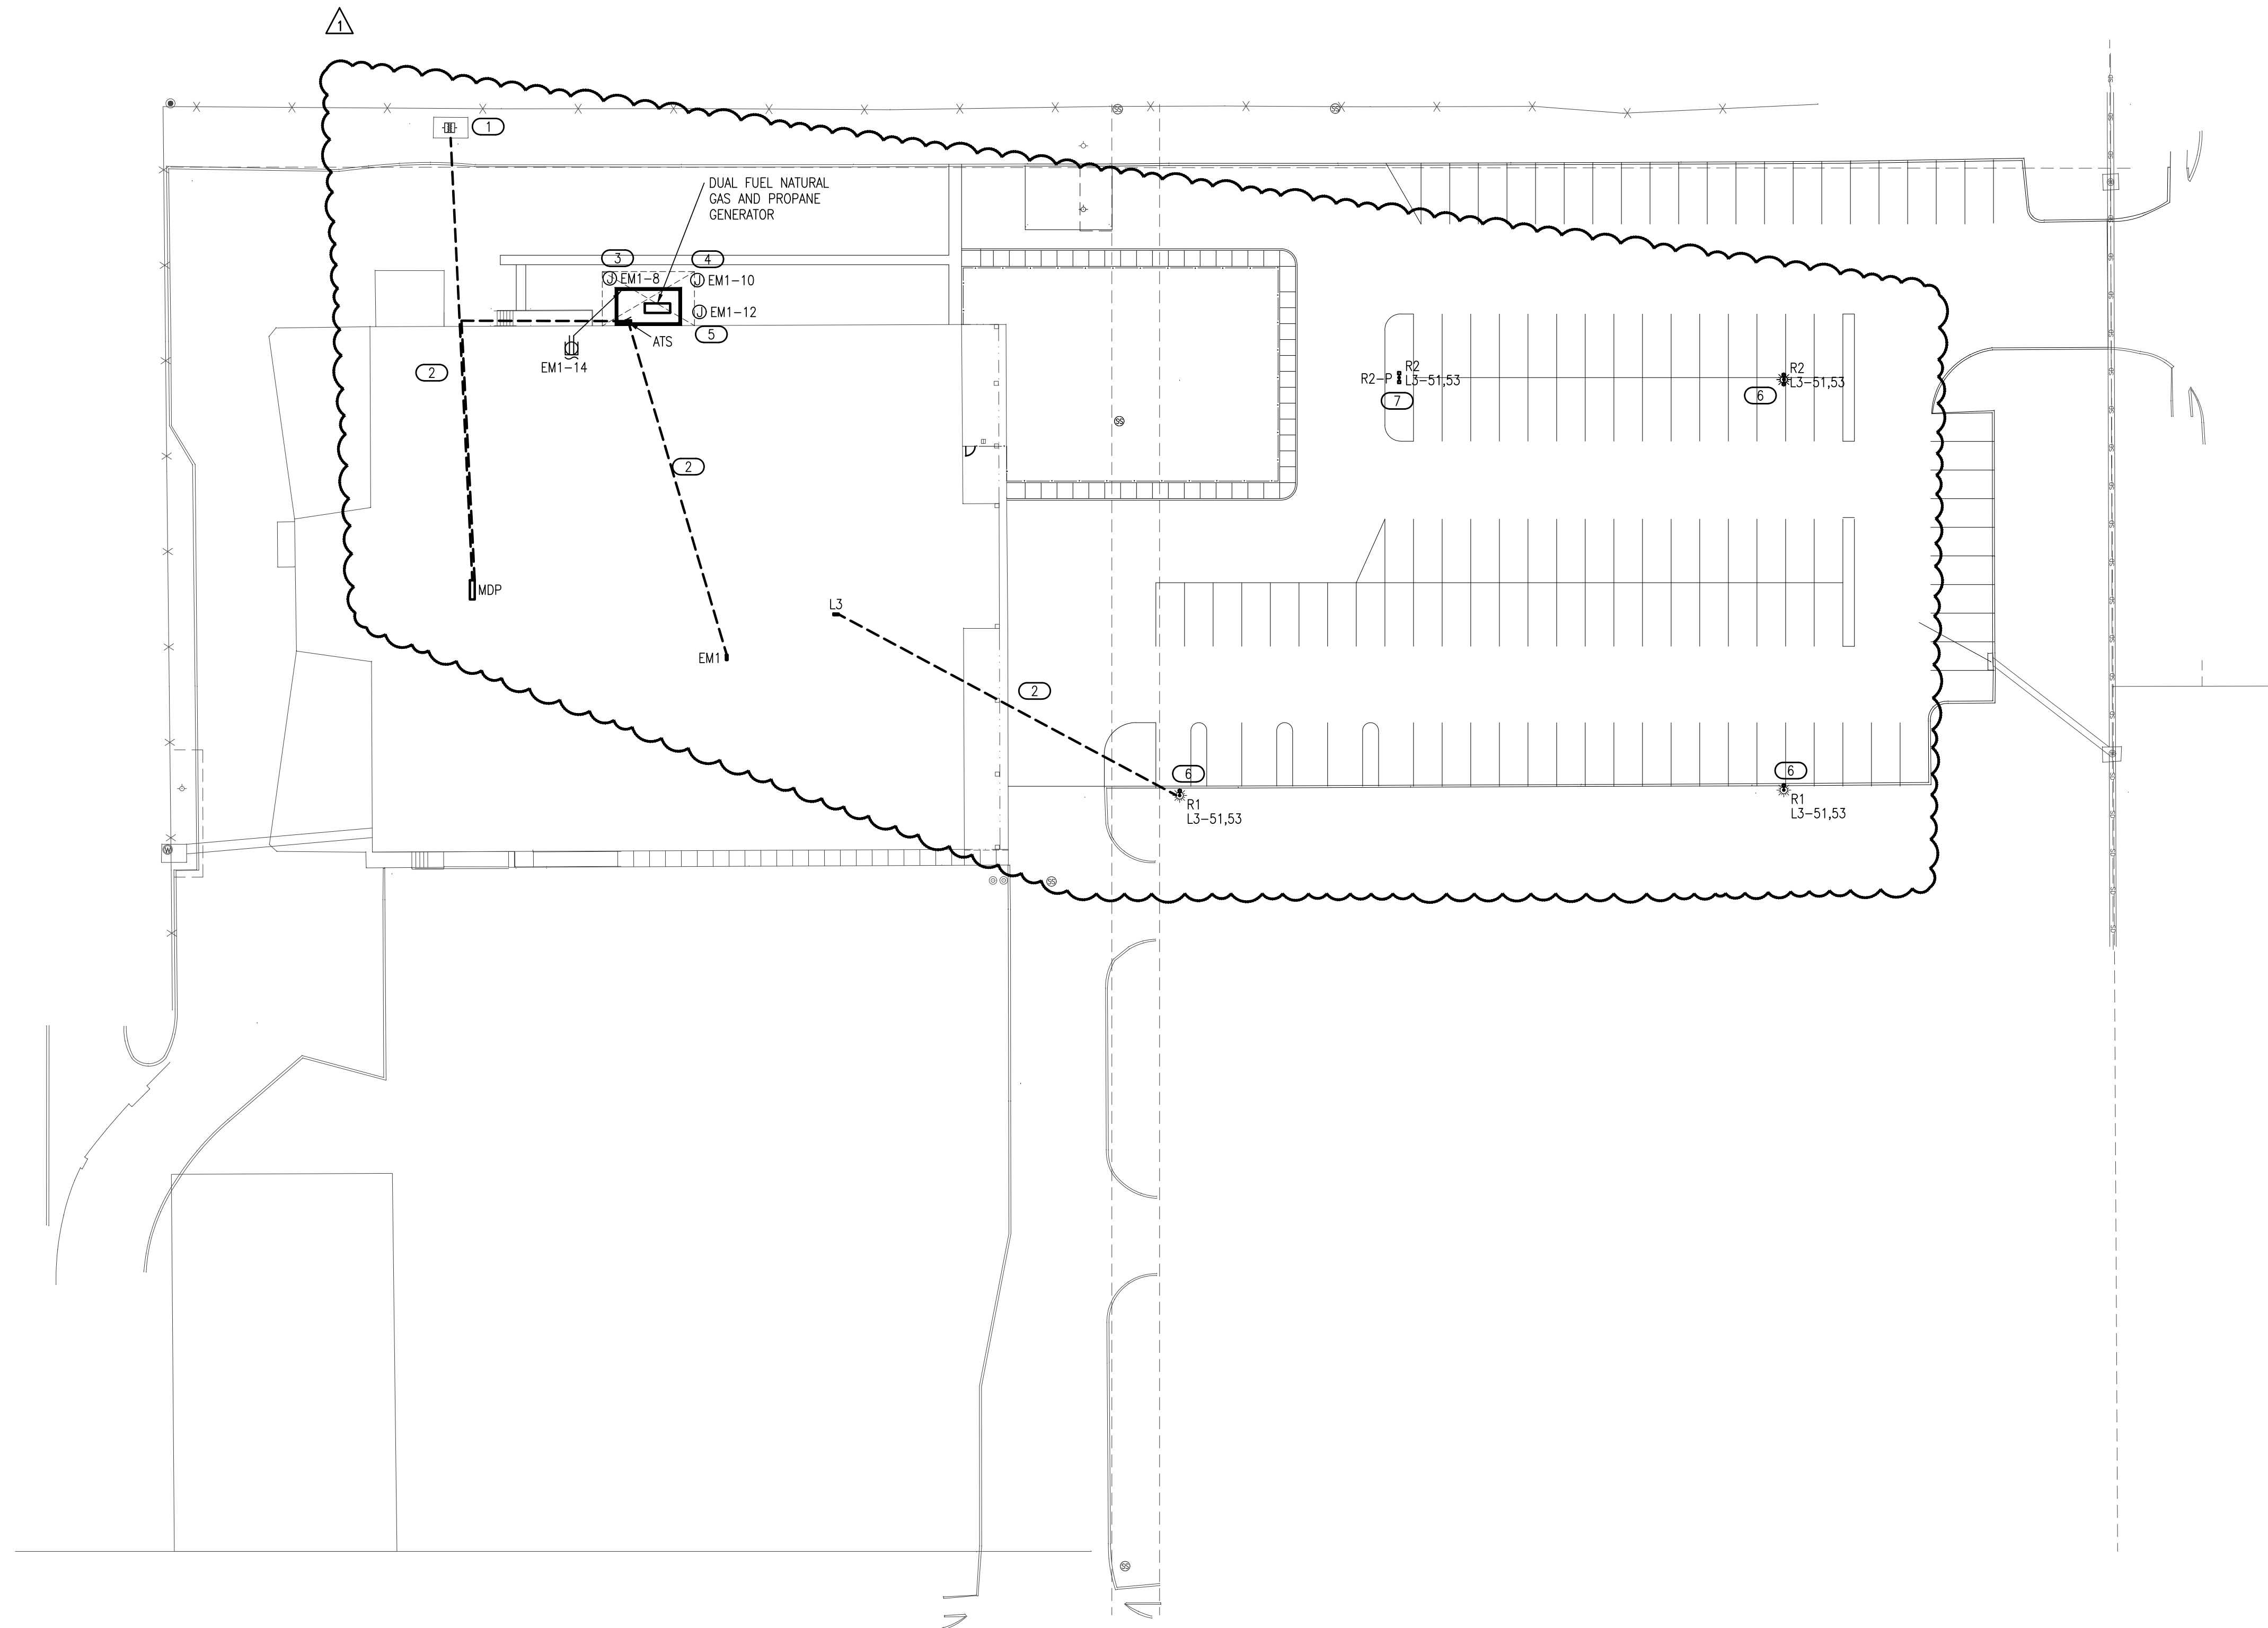


1 ELECTRICAL SITE PLAN

SCALE: 1/32" = 1'-0"



Salas O'Brien
2900 S. Telephone Road, Suite 120
Moore, OK 73160
Salas O'Brien Registration: CA# 7058
Expiration Date: 6/30/2025
Salas O'Brien Project Number: 2450-70304-00

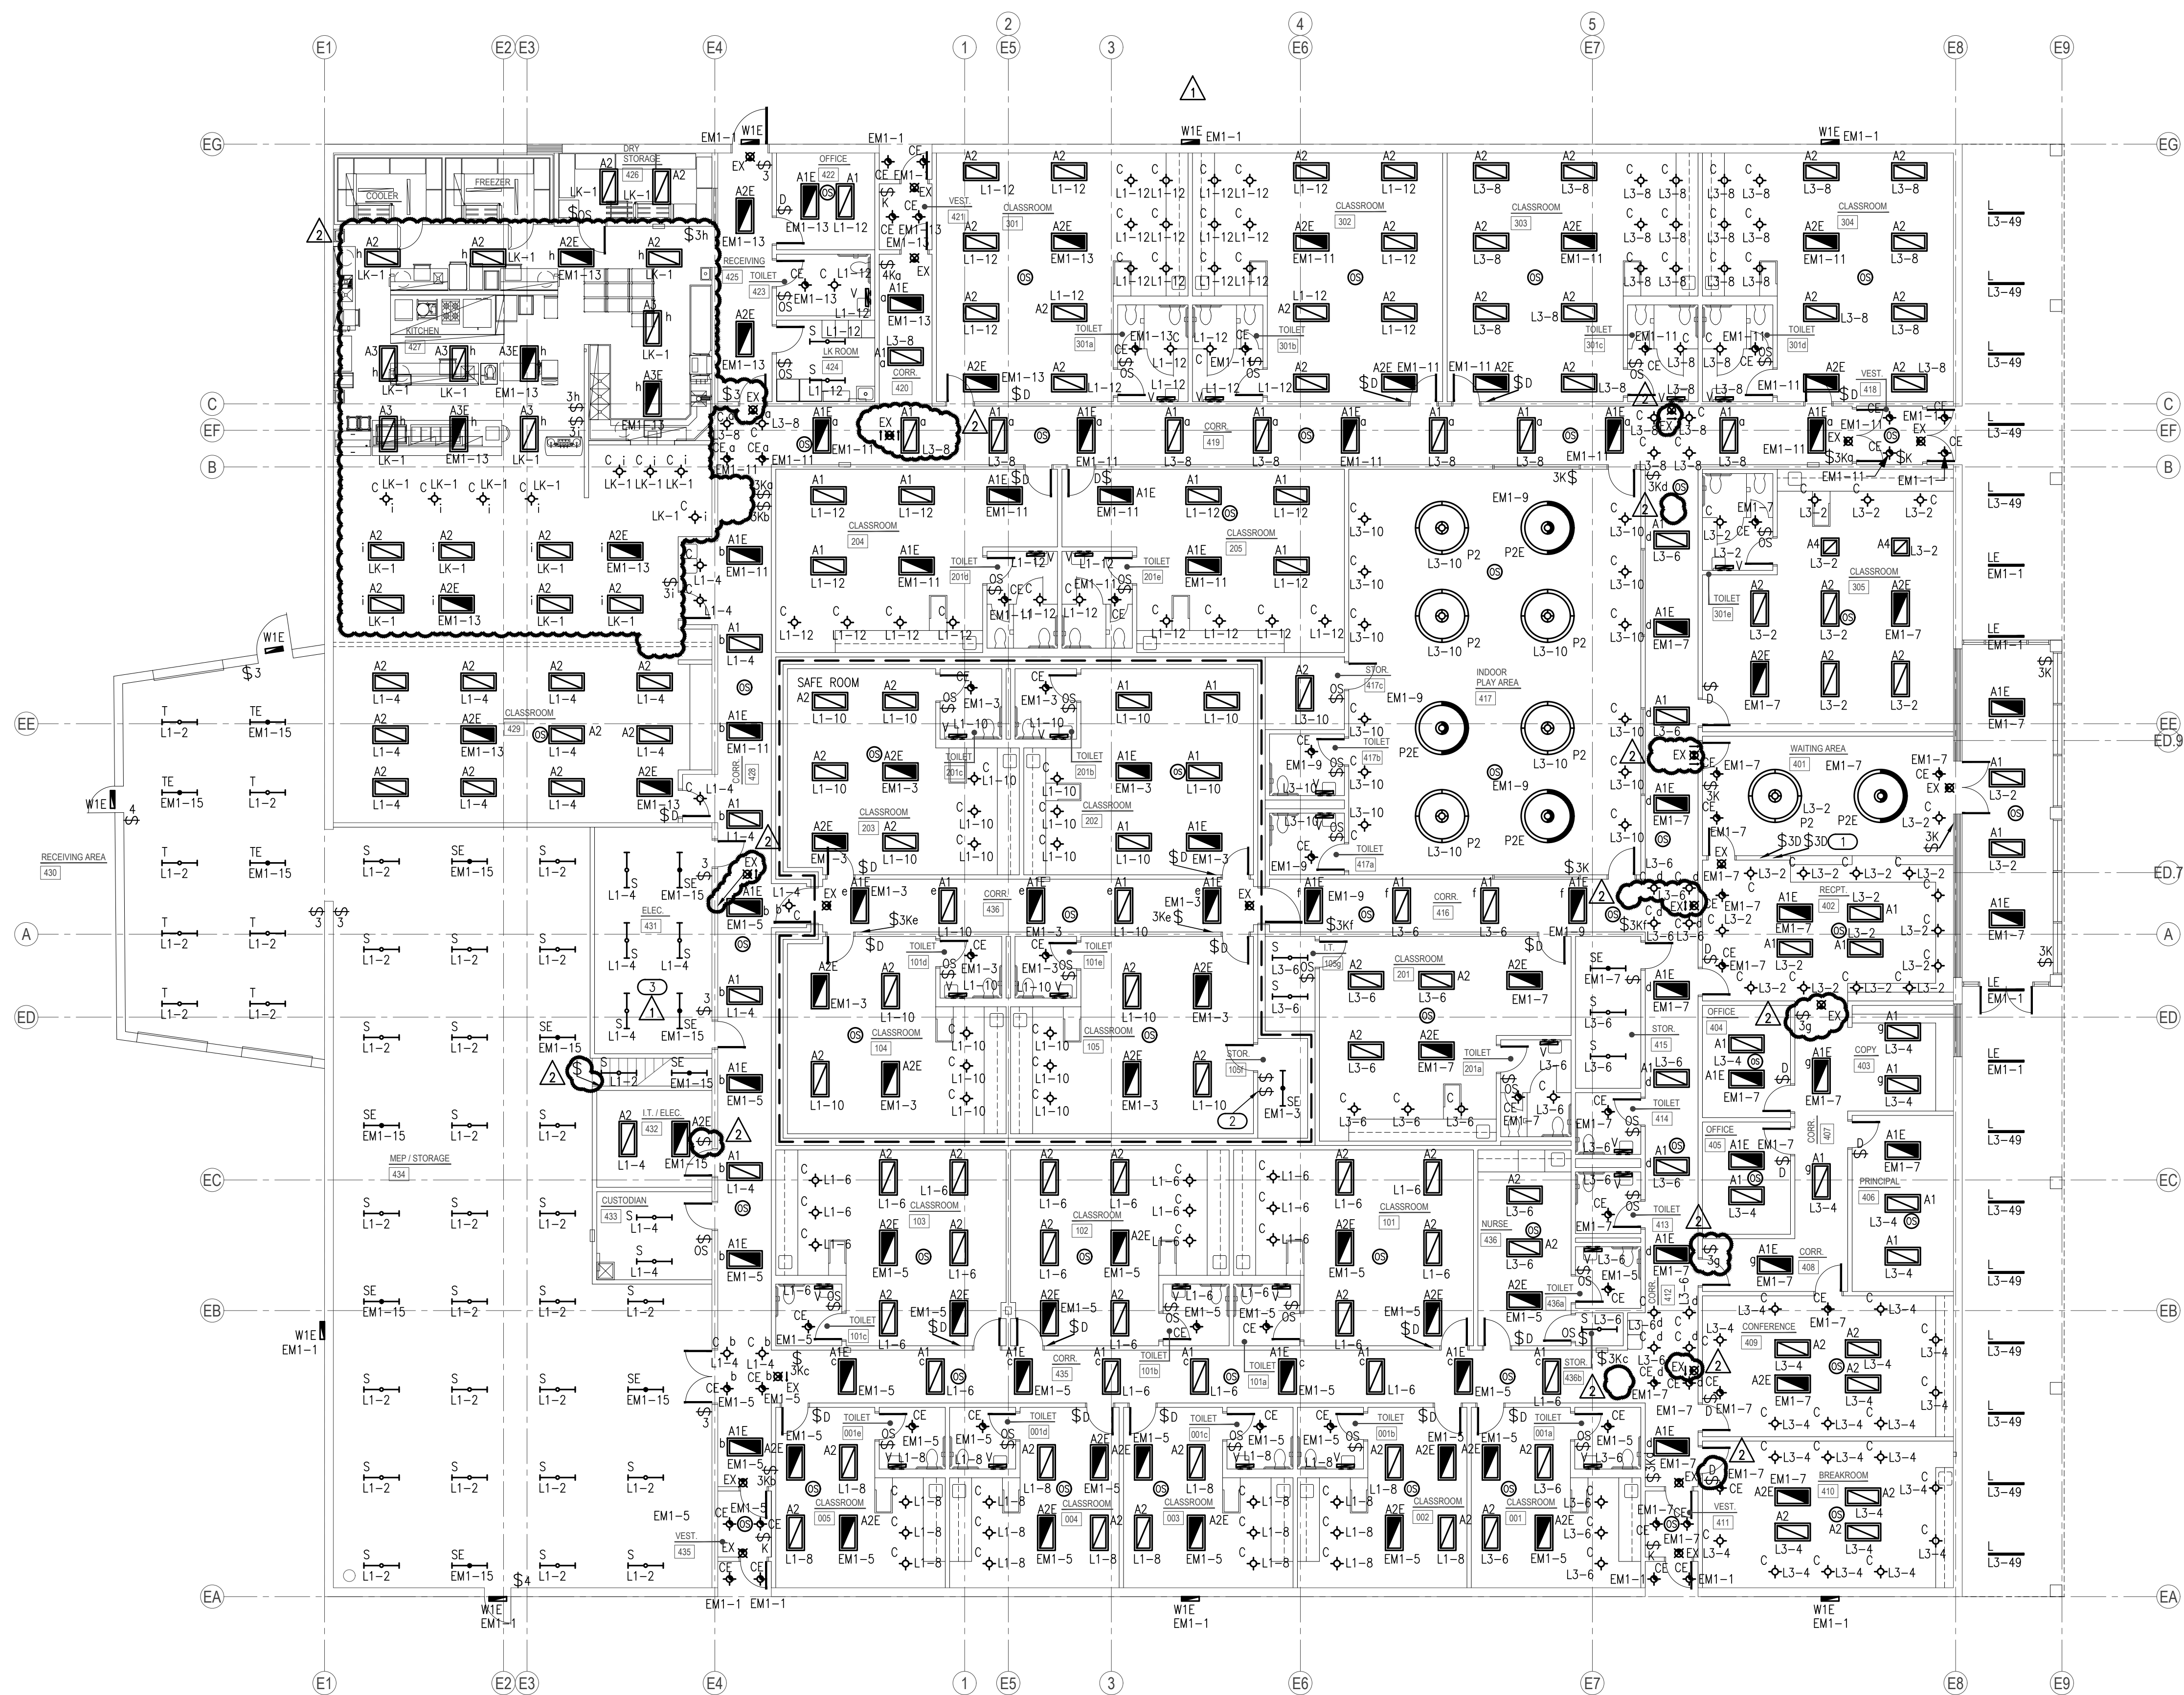

GENERAL NOTES

- OCCUPANCY SENSOR LOCATIONS SHOWN ARE FOR DESIGN INTENT ONLY. LOCATE OCCUPANCY SENSORS PER MANUFACTURER'S WRITTEN INSTALLATION INSTRUCTIONS.
- CONNECT BATTERY PACKS TO UNSWITCHED HOT OF LOCAL LIGHTING CIRCUIT.
- COORDINATE WITH ALL ASSOCIATED TRADES FOR THE EXACT LOCATIONS OF LIGHT FIXTURES WITH HVAC EQUIPMENT AND OTHER DEVICES/EQUIPMENT.
- COORDINATE WITH THE ARCHITECT, OWNER, AND ASSOCIATED TRADES FOR THE EXACT HEIGHT/LOCATION OF EXTERIOR MOUNTED LIGHTING FIXTURES PRIOR TO ROUGH-IN.
- LABEL SWITCH PLATES AND J-BOXES WITH CIRCUIT PER SPECS.
- COORDINATE LIGHT SWITCHES WITH THERMOSTATS AND OTHER WALL MOUNT DEVICES.

SAFEROOM GENERAL NOTES

PER ICC 500-2014, 309.1:

PENETRATIONS THROUGH THE STORM SHELTER ENVELOPE THAT ARE LARGER THAN:


- 3.5" SQUARE INCHES IN AREA FOR RECTANGULAR OPENINGS, OR
- 2 1/16" IN DIAMETER

SHALL BE CONSIDERED AN OPENING AND SHALL BE PROVIDED WITH AN OPENING PROTECTIVE DEVICE (SHROUD). REFERENCE STRUCTURAL DRAWINGS FOR A SAMPLE SHROUD DETAIL. THIS INCLUDES PENETRATIONS FOR BUNDLES OF CONDUIT.

KEYED NOTES

- LIGHT SWITCH FOR 'WAITING AREA 401' LIGHT FIXTURES.
- SUPPLY VENTILATION FAN SWITCH. COORDINATE WITH MECHANICAL CONTRACTOR.
- DUPLICATE LIGHT FIXTURE PLACEMENT IN MEZZANINE AREA ABOVE. INSTALL LIGHT SWITCH IN MEZZANINE NEXT TO ENTRY WAY.

1 ELECTRICAL LIGHTING PLAN
SCALE: 3/32" = 1'-0"

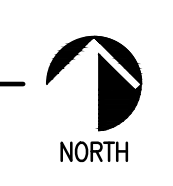

201 N. BROADWAY
SUITE 210
MOORE, OK. 73160
405.735.3477
AGP@theAGP.net
www.theAGP.net

KFC ENGINEERING
STRUCTURAL

SALAS O'BRIEN
MECHANICAL / ELECTRICAL



DWG
drawn by
TVO
checked by
OCTOBER 2024
date

revisions
11/22/2024 AD 02
12/12/2024 AD 03



CHILD CARE FACILITY
201 N. EASTERN AVE.

sheet no:

E101

Salas O'Brien
2900 S. Telephone Road, Suite 120
Moore, OK 73160
Salas O'Brien Registration: CA# 7058
Expiration Date: 6/30/2025
Salas O'Brien Project Number: 2450-70304-00

OWNERSHIP USE OF DOCUMENTS:
AGP EXPRESSLY RESERVES ITS COPYRIGHT AND OTHER PROPERTY RIGHTS OF ALL PLANS AND DRAWINGS DESIGNED AND/OR PRODUCED. PLANS AND DRAWINGS ARE NOT TO BE REPRODUCED IN ANY FORM OR MANNER WITHOUT THE EXPRESSED WRITTEN CONSENT OF AGP.



GENERAL NOTES


- COORDINATE EXACT LOCATIONS OF DEVICES SHOWN WITH OTHER EQUIPMENT. COORDINATE EXACT LOCATION OF CEILING MOUNTED DEVICES WITH LIGHTS, HVAC EQUIPMENT, AND OTHER DEVICES.
- COORDINATE WITH MECHANICAL CONTRACTOR AND PROVIDE ALL RELAYS, CONNECTIONS, AND ALL DEVICES NECESSARY TO INTERLOCK EXHAUST FANS, DAMPERS, ETC WITH PROPER CONTROL DEVICES.
- COORDINATE EXACT LOCATION OF MECHANICAL EQUIPMENT WITH MECHANICAL CONTRACTOR. REFER TO MECHANICAL PLANS AND MANUFACTURER FOR ADDITIONAL INFORMATION.
- COORDINATE EXACT LOCATION OF PLUMBING EQUIPMENT WITH PLUMBING CONTRACTOR. REFER TO PLUMBING PLANS AND MANUFACTURER FOR ADDITIONAL INFORMATION.
- ALL RECEPTACLES LOCATED AT COUNTERTOP HEIGHT SHALL BE ORIENTED HORIZONTALLY.
- FIRE STOP ALL PENETRATIONS IN FIRE AND SMOKE RATED WALLS. REFER TO ARCHITECTURAL PLANS FOR LOCATIONS AND ADDITIONAL INFORMATION

SAFEROOM GENERAL NOTES


- PER ICC 500-2014, 309.1:
PENETRATIONS THROUGH THE STORM SHELTER ENVELOPE THAT ARE LARGER THAN:
1. 3.5" SQUARE INCHES IN AREA FOR RECTANGULAR OPENINGS, OR
2. 2 1/16" IN DIAMETER
SHALL BE CONSIDERED AN OPENING AND SHALL BE PROVIDED WITH AN OPENING PROTECTIVE DEVICE (SHROUD). REFERENCE STRUCTURAL DRAWINGS FOR A SAMPLE SHROUD DETAIL. THIS INCLUDES PENETRATIONS FOR BUNDLES OF CONDUIT.

KEYED NOTES

- PROVIDE 120V CONNECTION FOR SMARTBOARD. COORDINATE FINAL LOCATION AND REQUIREMENTS WITH OWNER/ARCHITECT PRIOR TO ROUGH-IN. REFER TO DETAIL '1/ES02' FOR ADDITIONAL INFORMATION.
- PROVIDE 120V WATER COOLER DEDICATED CONNECTION. COORDINATE WITH THE ARCHITECT, PLUMBING CONTRACTOR, AND MANUFACTURER FOR THE EXACT LOCATION AND CONNECTION REQUIREMENTS PRIOR TO ROUGH-IN.
- PROVIDE 120V COPY MACHINE DEDICATED CONNECTION. COORDINATE WITH THE ARCHITECT, OWNER, AND MANUFACTURER FOR THE EXACT LOCATION AND CONNECTION REQUIREMENTS PRIOR TO ROUGH-IN.
- PROVIDE 120V GAS DRYER DEDICATED CONNECTION. COORDINATE WITH THE ARCHITECT, OWNER AND MANUFACTURER FOR THE EXACT LOCATION AND CONNECTION REQUIREMENTS PRIOR TO ROUGH IN.
- PROVIDE 120V WASHER DEDICATED CONNECTION. COORDINATE WITH THE ARCHITECT, OWNER AND MANUFACTURER FOR THE EXACT LOCATION AND CONNECTION REQUIREMENTS PRIOR TO ROUGH IN.
- PROVIDE 120V FIRE ALARM CONTROL PANEL. DEDICATED CONNECTION. COORDINATE RECEPTACLE TYPE AND LOCATION WITH FIRE ALARM CONTRACTOR.
- PROVIDE 120V TELECOM EQUIPMENT CONNECTION. COORDINATE EXACT LOCATION WITH ARCHITECT/OWNER.
- PROVIDE 120V CONNECTION FOR TRAP PRIMER. COORDINATE FINAL LOCATION AND REQUIREMENTS WITH PLUMBING CONTRACTOR PRIOR TO ROUGH-IN.
- PROVIDE 120V CONNECTION FOR DRYER BOOSTER FAN. COORDINATE EXACT LOCATION WITH MECHANICAL CONTRACTOR ON SITE.

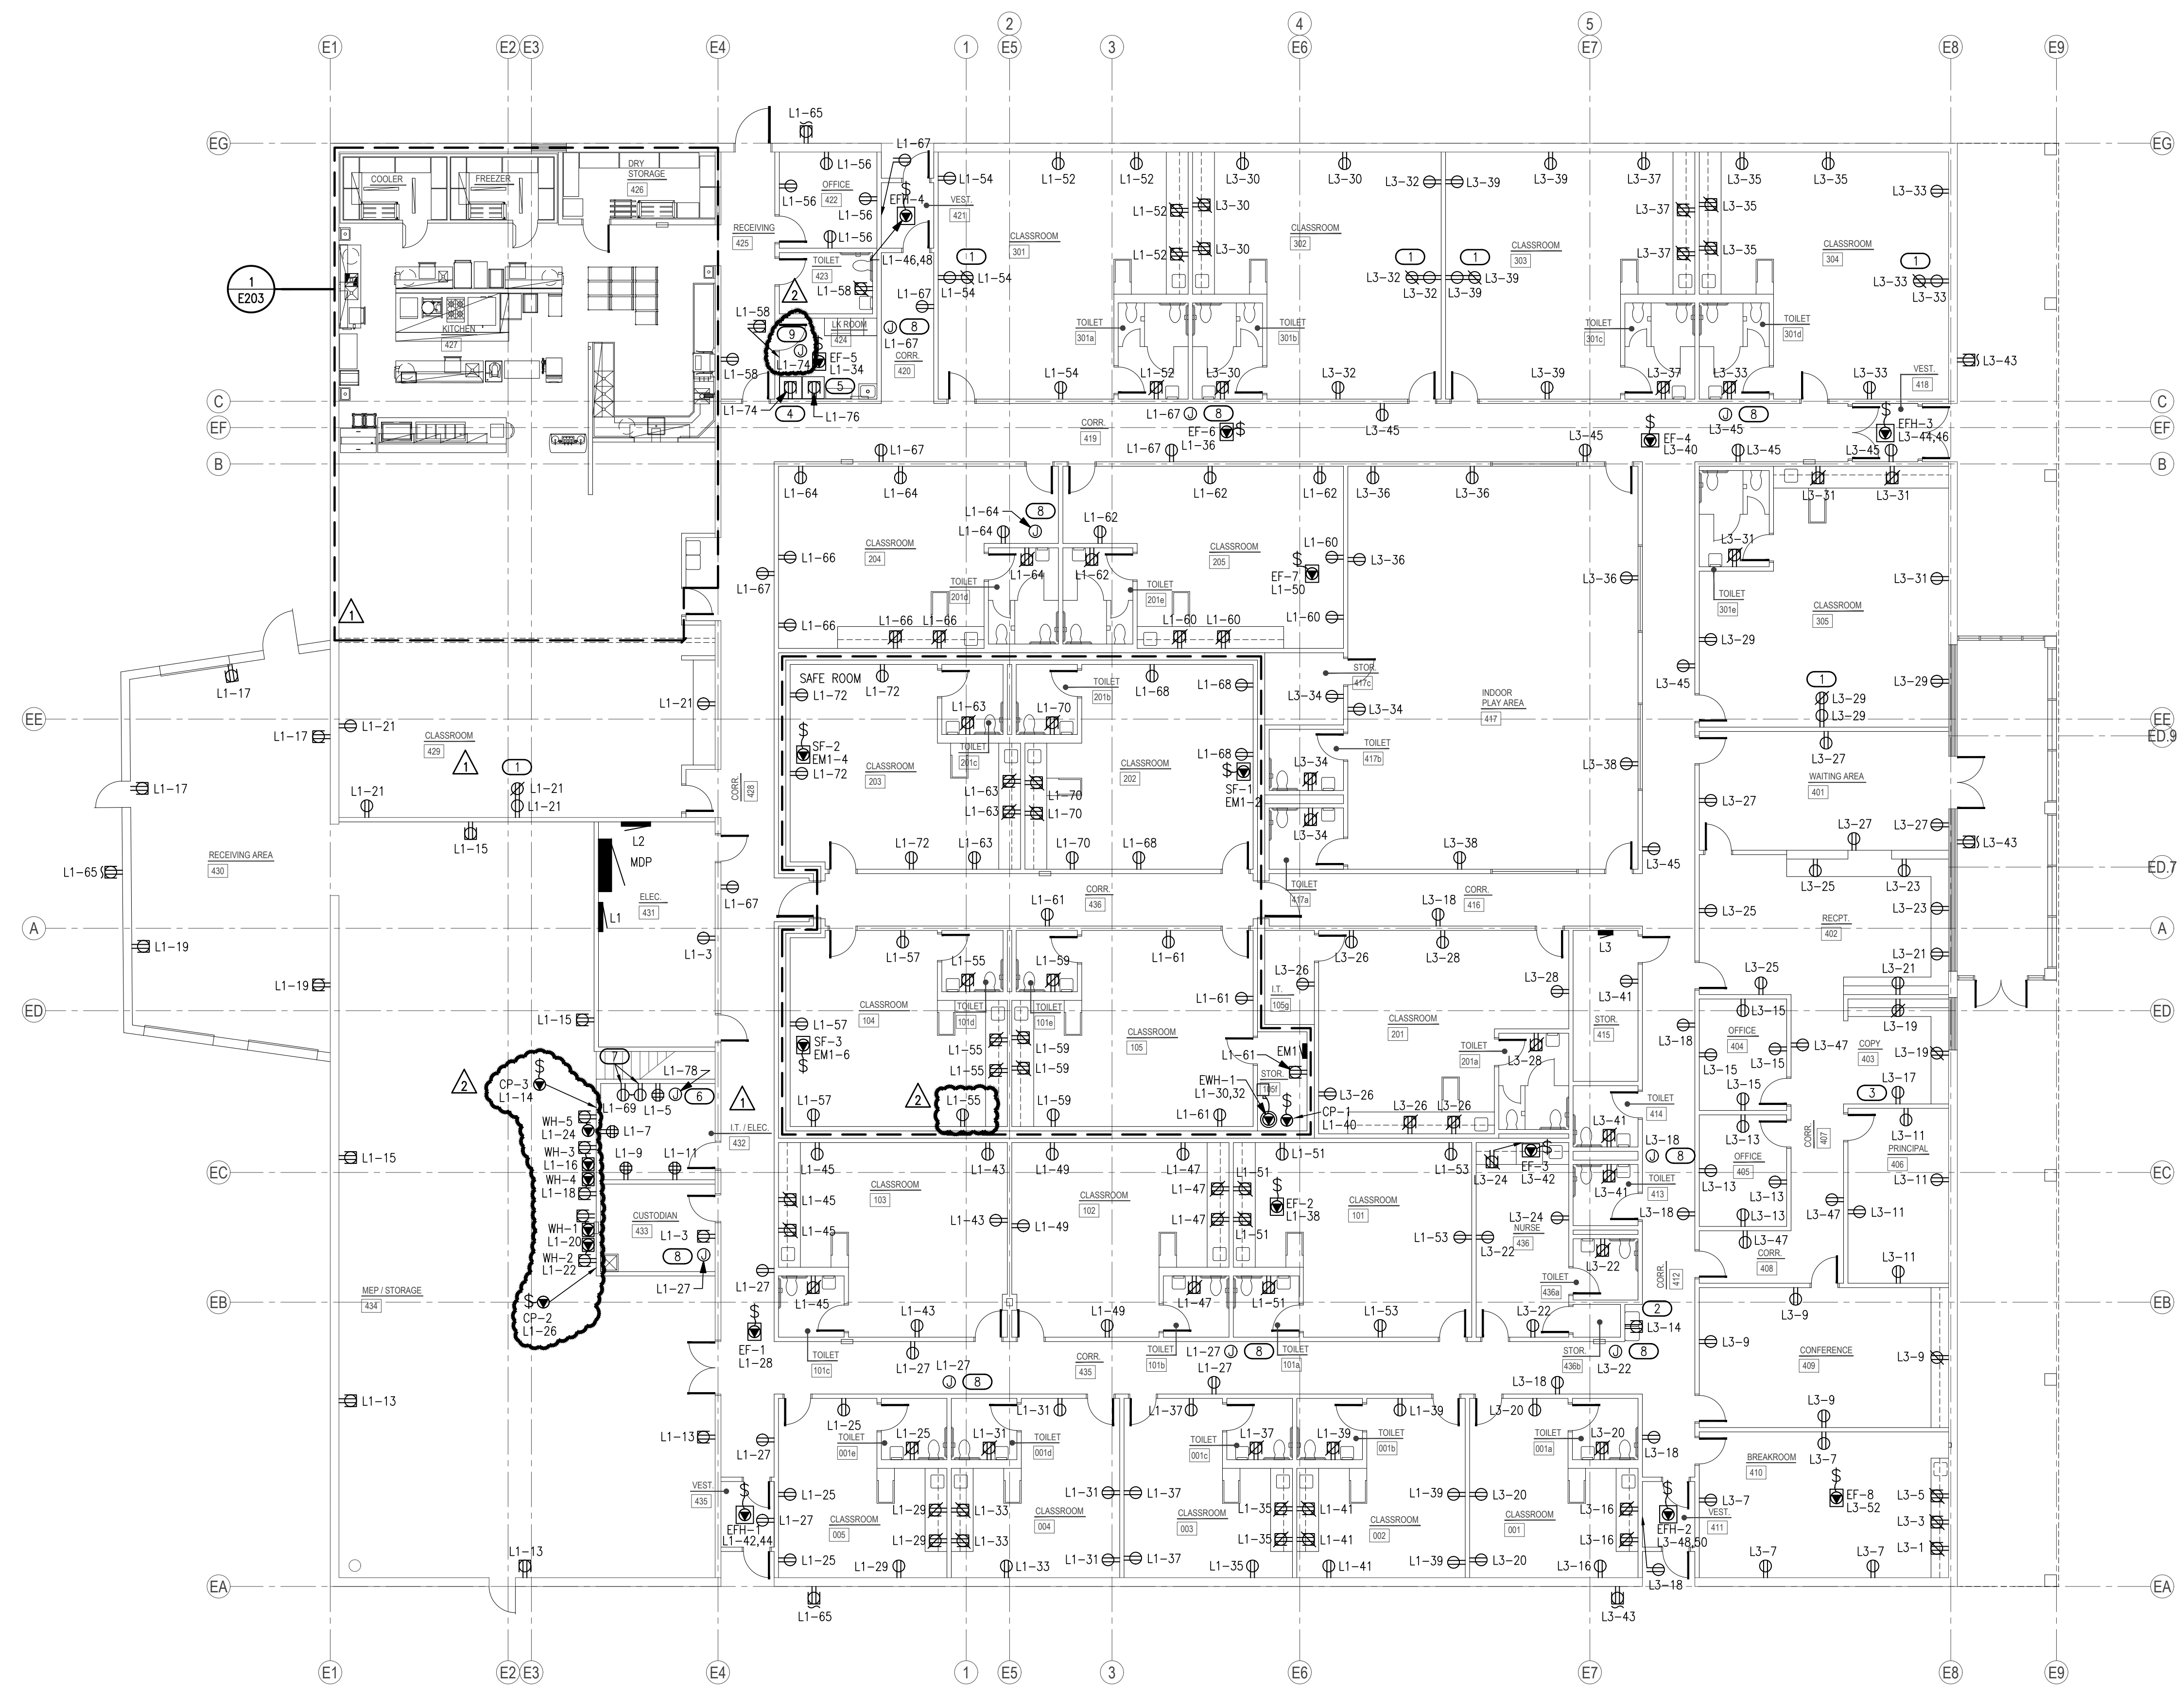

1 ELECTRICAL POWER PLAN
SCALE: 3/32" = 1'-0"

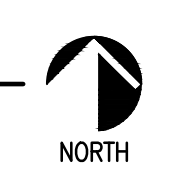

Salas O'Brien
2900 S. Telephone Road, Suite 120
Moore, OK 73160
Salas O'Brien Registration: CA# 7058
Expiration Date: 6/30/2025
Salas O'Brien Project Number: 2450-70304-00

GENERAL NOTES

1. COORDINATE EXACT LOCATIONS OF DEVICES SHOWN WITH OTHER EQUIPMENT.
2. COORDINATE WITH MECHANICAL CONTRACTOR AND PROVIDE ALL RELAYS, CONNECTIONS, AND ALL DEVICES NECESSARY TO INTERLOCK EXHAUST FANS, DAMPERS, ETC WITH PROPER DEVICES.
3. COORDINATE EXACT LOCATIONS OF MECHANICAL EQUIPMENT WITH MECHANICAL CONTRACTOR.
4. FIRMLY MOUNT WEATHERPROOF 120V CONVENIENCE OUTLET ON UNISTRUT/KINDORF. COORDINATE WITH OTHER TRADES PRIOR TO ROUGH-IN. REDUNDANT RECEPTACLES WHETHER STAND-ALONE OR INTEGRAL TO A UNIT, MAY BE OMITTED SO LONG AS ALL OF THE REQUIREMENTS OF NEC 210.63 ARE SATISFIED.

AGP

the Abila Griffin Partnership L.L.C.

201 N. BROADWAY
SUITE 210
MOORE, OK. 73160
405.735.3477
AGP@theAGP.net
www.theAGP.net

KFC ENGINEERING
STRUCTURAL

SALAS O'BRIEN
MECHANICAL / ELECTRICAL



DWG
drawn by
TVO
checked by
OCTOBER 2024
date

revisions
 11/22/2024 AD 02
 12/12/2024 AD 03




CHILD CARE FACILITY
201 N. EASTERN AVE.

sheet no:

E202


OWNERSHIP USE OF DOCUMENTS:
AGP EXPRESSLY RESERVES ITS COPYRIGHT AND OTHER PROPERTY RIGHTS OF ALL PLANS AND DRAWINGS DESIGNED AND/OR PRODUCED. PLANS AND DRAWINGS ARE NOT TO BE REPRODUCED IN ANY FORM OR MANNER WITHOUT THE EXPRESSED WRITTEN CONSENT OF AGP.

Salas O'Brien
2900 S. Telephone Road, Suite 120
Moore, OK 73160
Salas O'Brien Registration: CA# 7058
Expiration Date: 6/30/2025
Salas O'Brien Project Number: 2450-70304-00

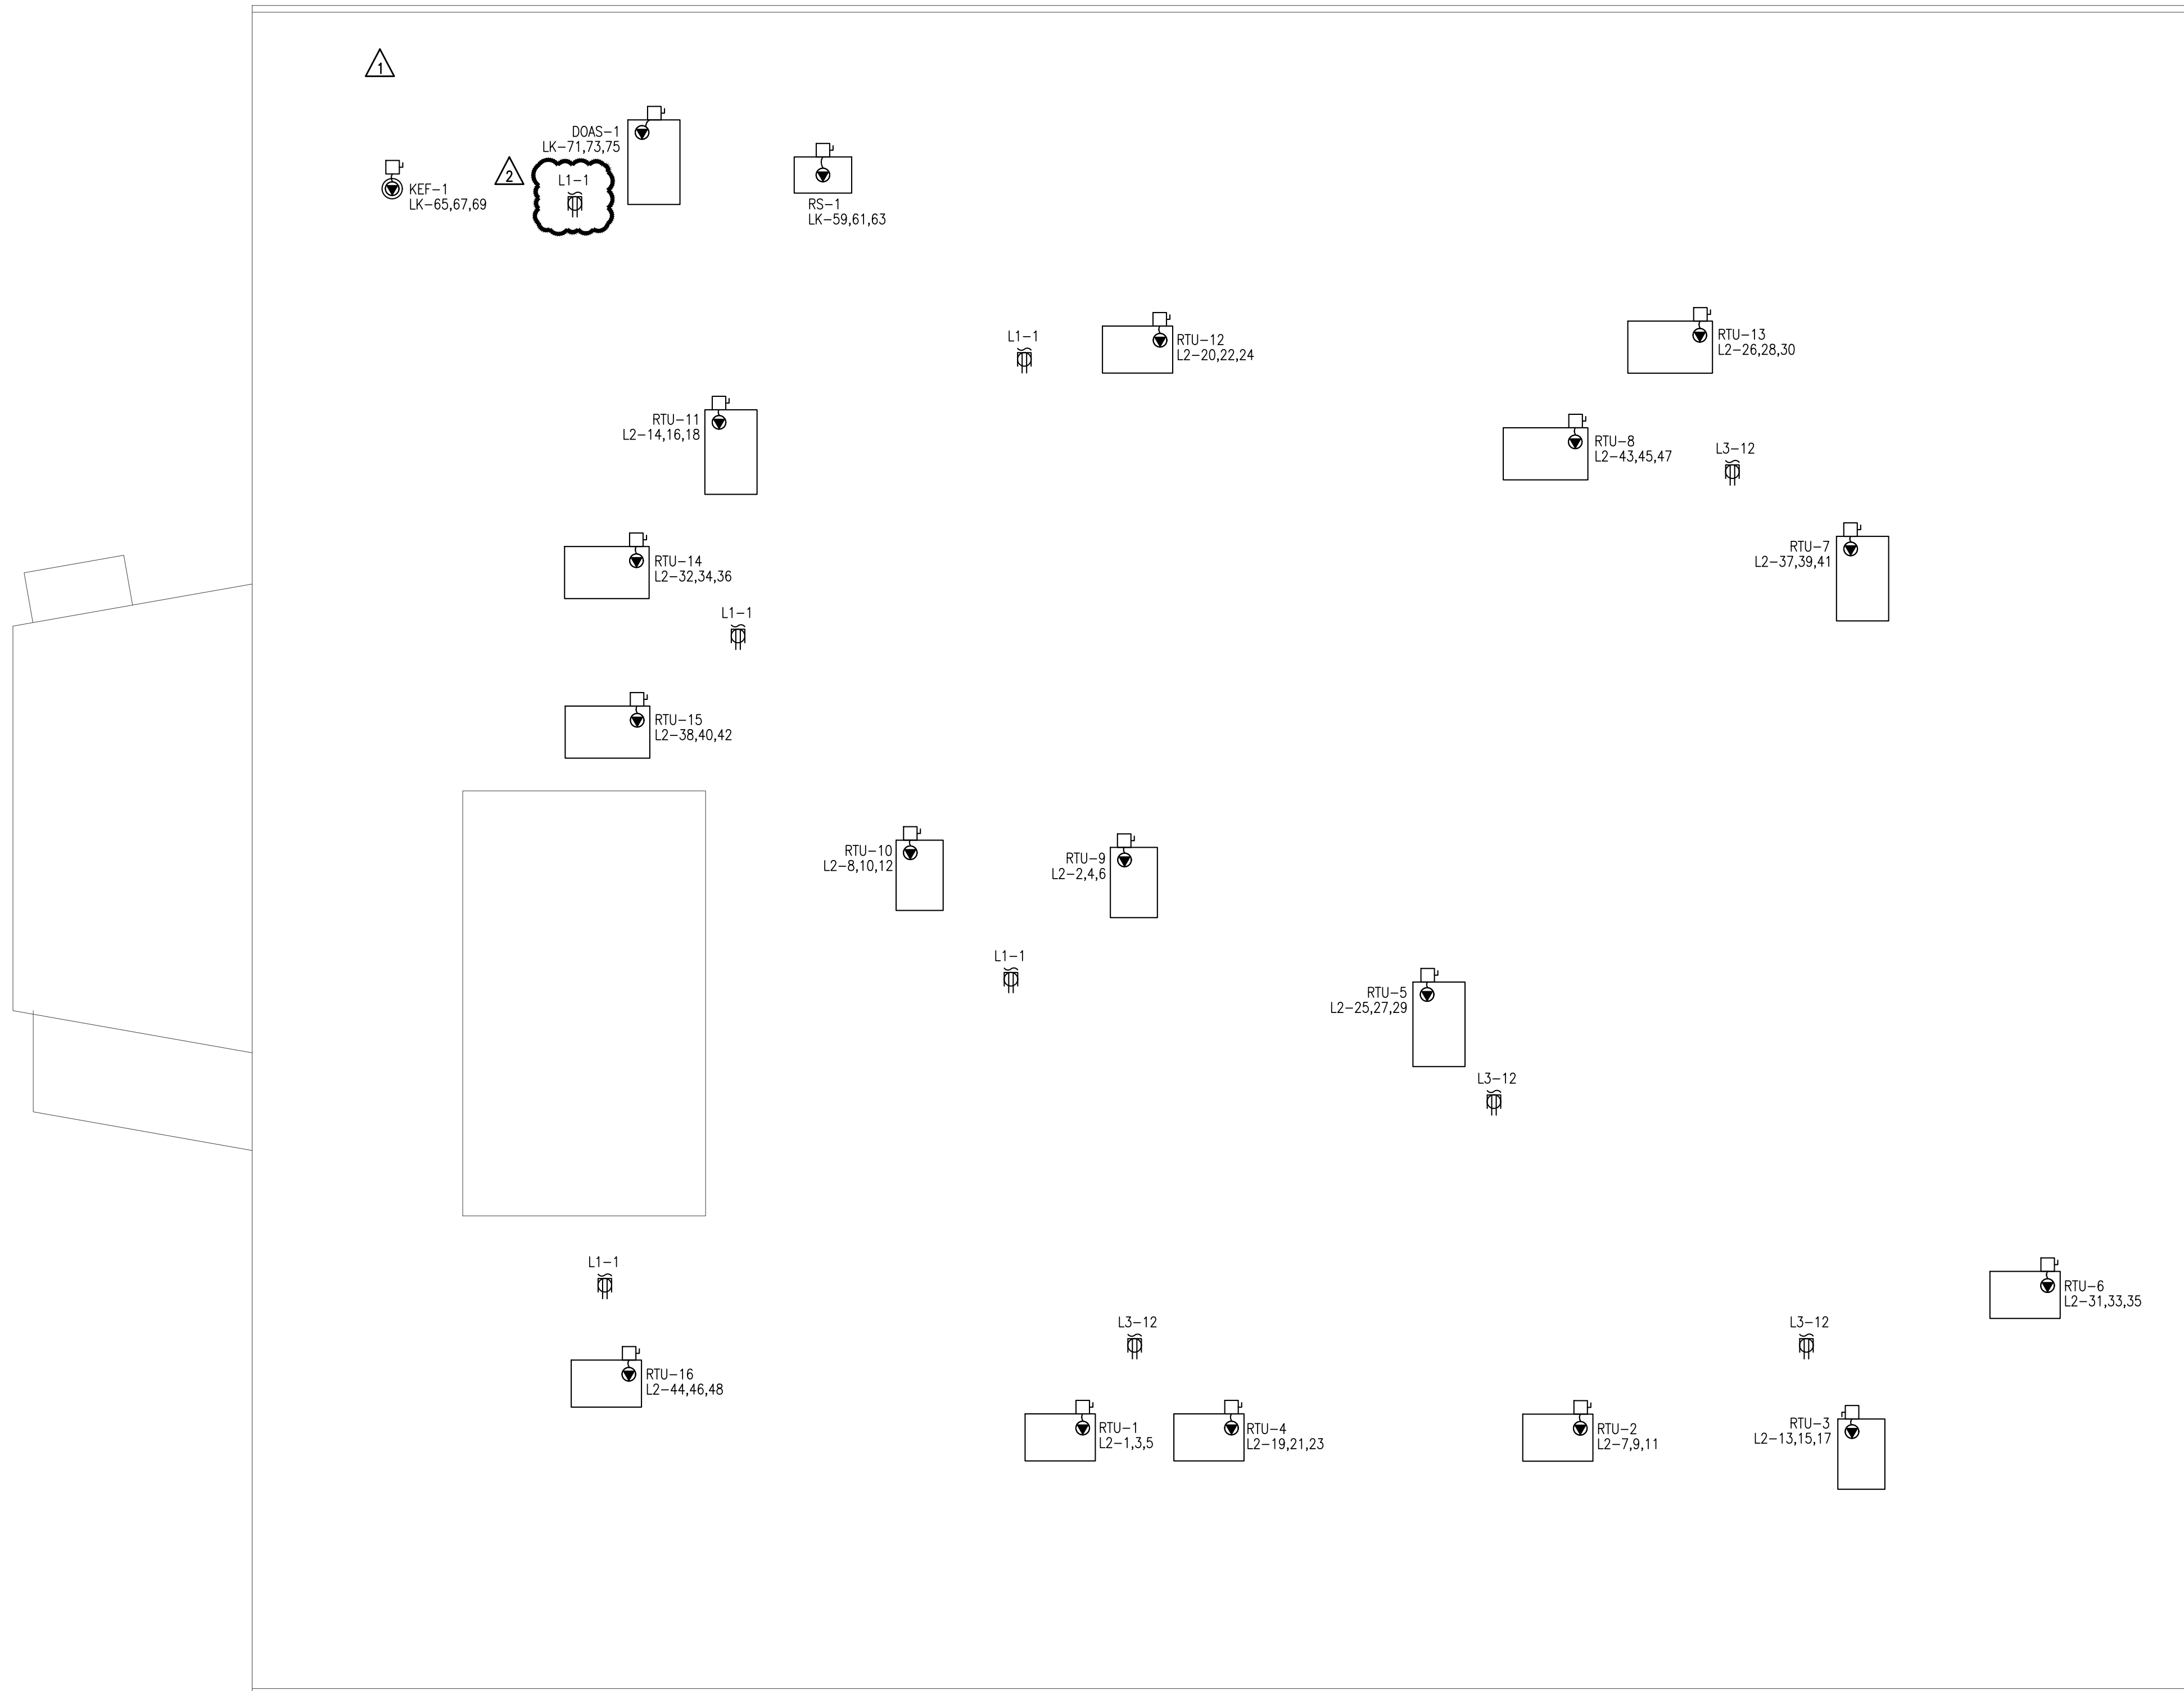

1 ELECTRICAL ROOF PLAN
SCALE: 3/32" = 1'-0"



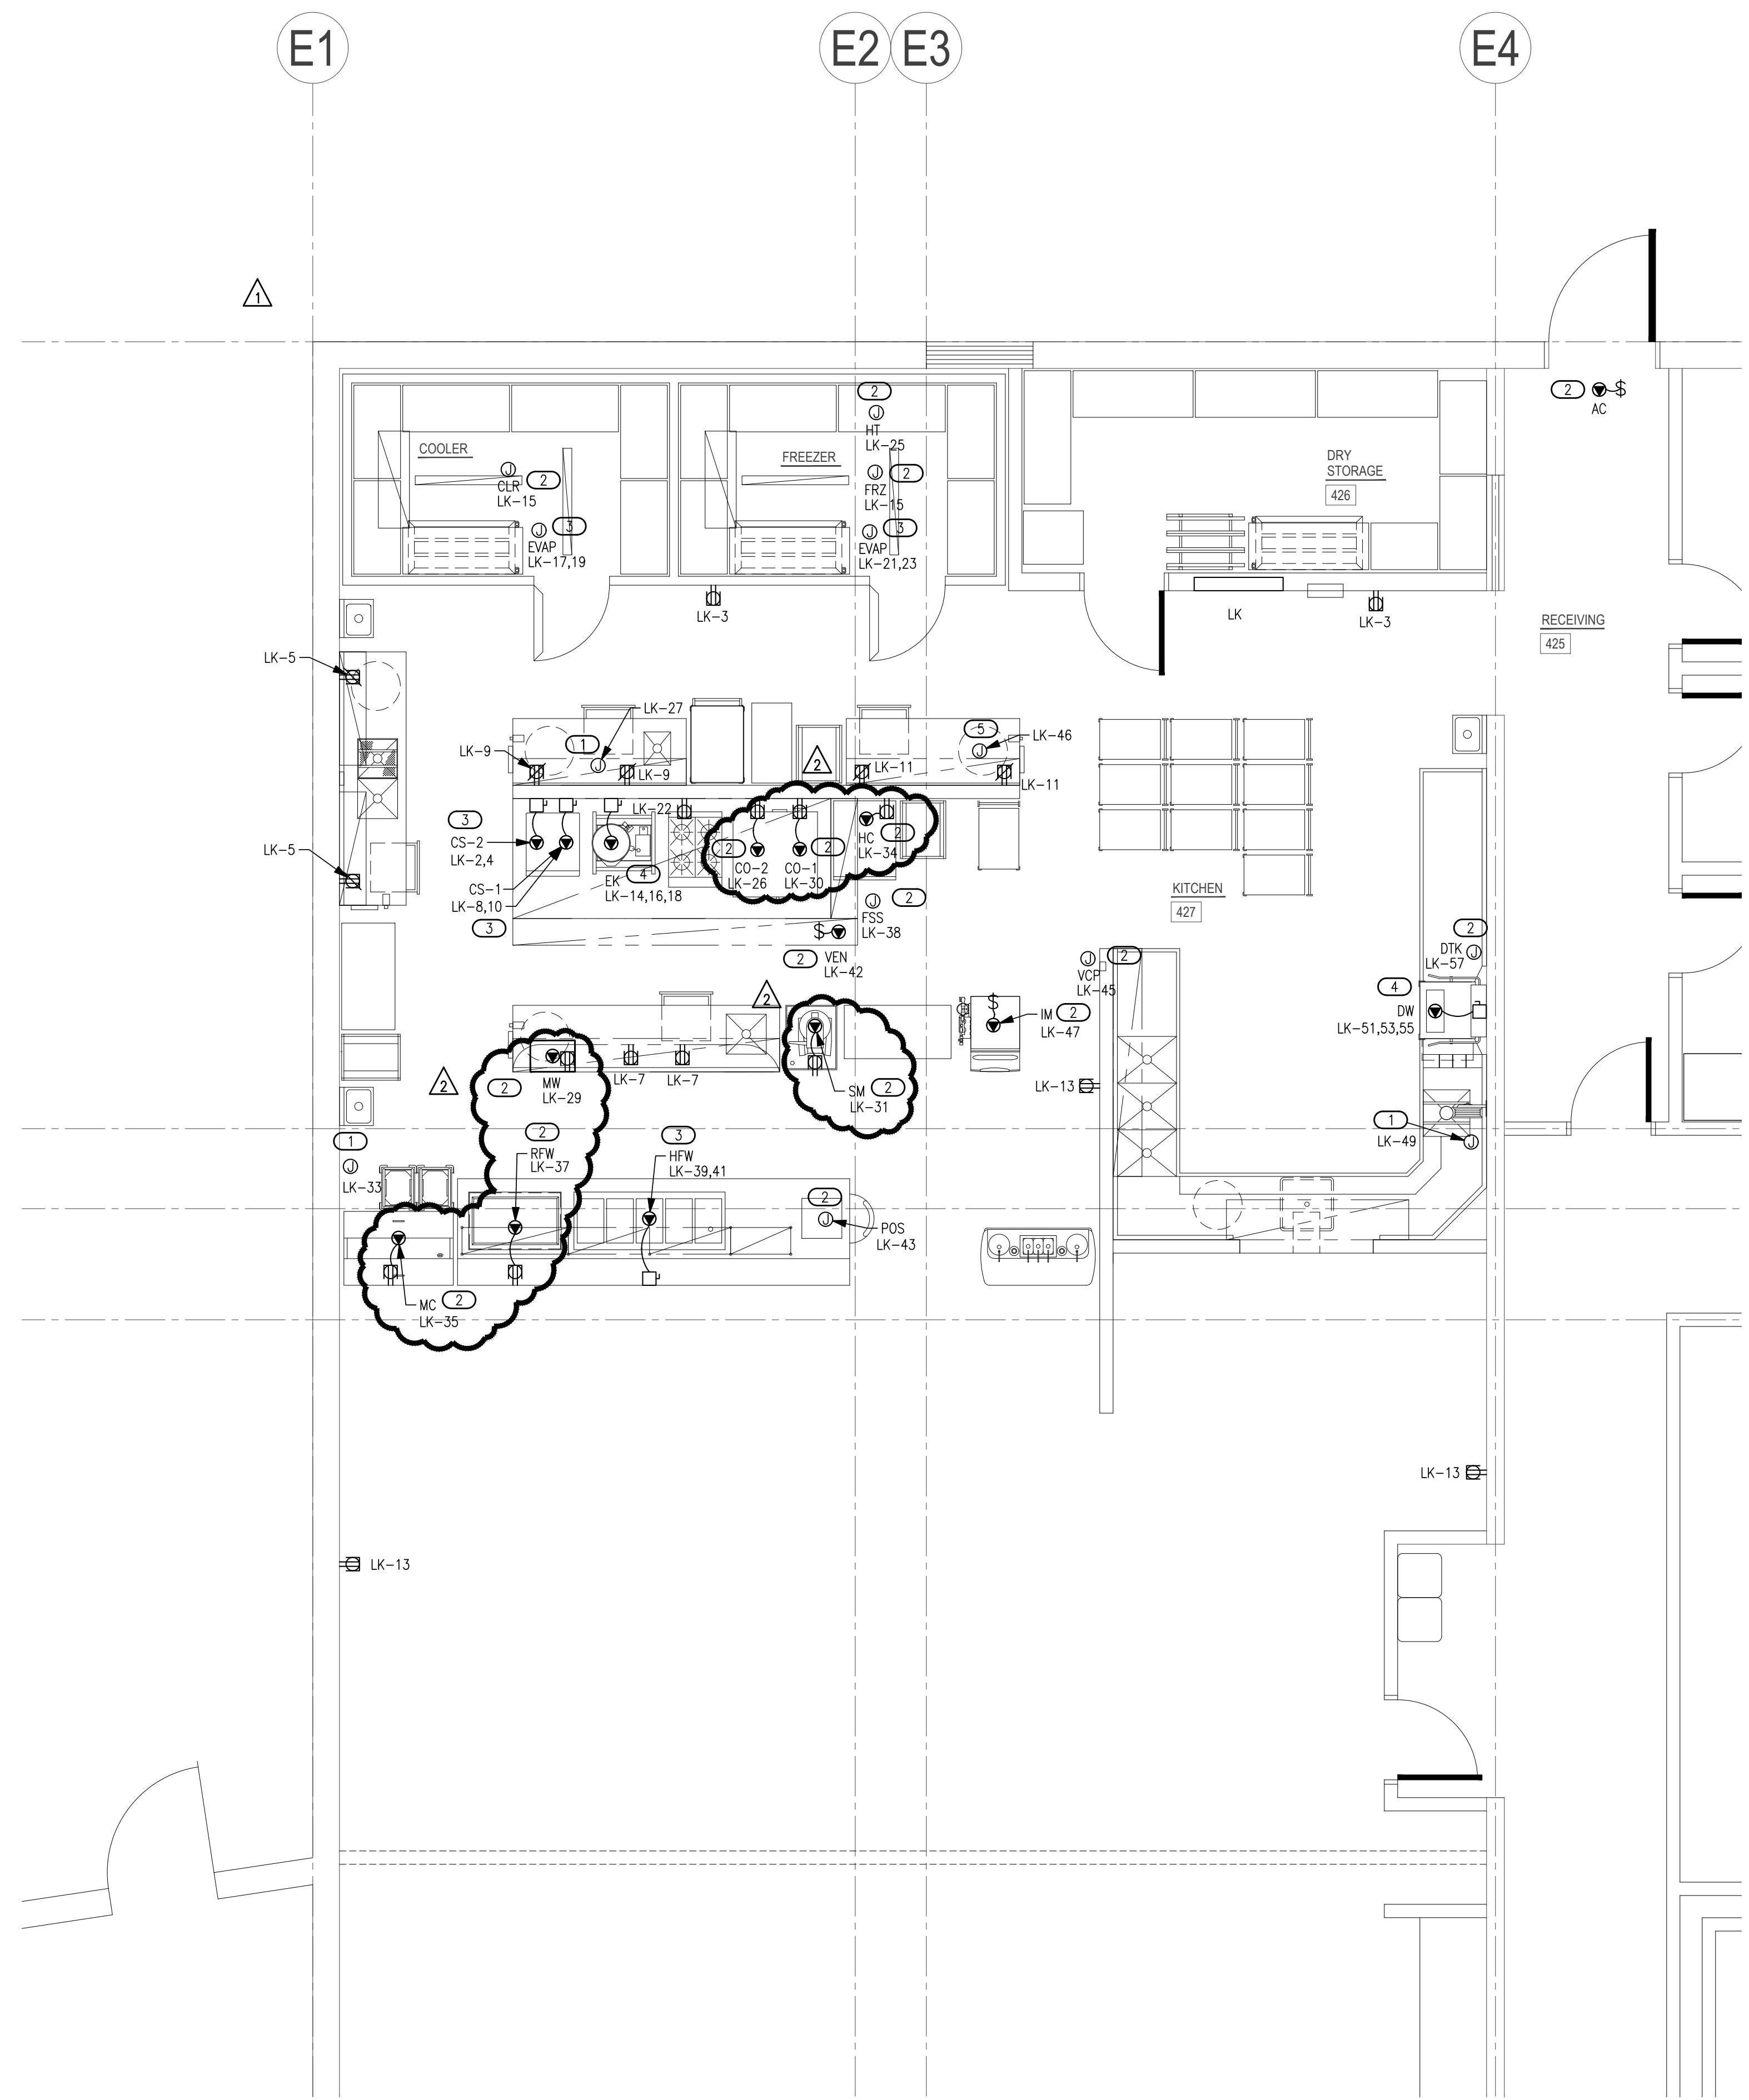

KITCHEN GENERAL NOTES

- COORDINATE KITCHEN/FOODSERVICE EQUIPMENT EXACT INSTALLATION LOCATIONS AND REQUIREMENTS WITH THE ARCHITECT, MANUFACTURER, AND FOOD SERVICE CONTRACTOR PRIOR TO BEGINNING WORK. REFER TO FOOD SERVICE PLANS FOR ADDITIONAL INFORMATION.
- COORDINATE KITCHEN HVAC EQUIPMENT EXACT INSTALLATION LOCATIONS AND REQUIREMENTS WITH THE ARCHITECT, MECHANICAL CONTRACTOR, AND ALL OTHER ASSOCIATED TRADES PRIOR TO ROUGH-IN. REFER TO MECHANICAL PLANS FOR ADDITIONAL INFORMATION.
- COORDINATE KITCHEN PLUMBING EQUIPMENT EXACT INSTALLATION LOCATIONS AND REQUIREMENTS WITH THE ARCHITECT, PLUMBING CONTRACTOR, AND ALL OTHER ASSOCIATED TRADES PRIOR TO ROUGH-IN. REFER TO PLUMBING PLANS FOR ADDITIONAL INFORMATION.
- E.C. SHALL COORDINATE WITH OWNER, KITCHEN EQUIPMENT PROVIDER, AND OTHER TRADES PRIOR TO ROUGH IN TO ENSURE ALL ROUGH IN LOCATIONS ARE CONCEALED IN THE WALL AND STUBBED OUT IN THE PROPER LOCATIONS.
- GFCI PROTECTION REQUIRED FOR ALL 120V 15 AND 20A RECEPTACLES, BY GFCI FUNCTION ON BREAKER OR RECEPTACLE, PER NEC 210.8 (B) (2).
- HOOD STAND ALONE FIRE SUPPRESSION SYSTEM SHALL HAVE INPUT TO BUILDING FIRE ALARM SYSTEM.
- PROVIDE A 20 A MP, 1 HP, 120V POWER SUPPLY FOR KITCHEN EXHAUST FAN ANSUL SYSTEM. THE ACTIVATION OF THE FIRE SUPPRESSION SYSTEM SHALL AUTOMATICALLY SHUT DOWN THE FUEL AND ELECTRICAL POWER SUPPLY TO THE COOKING EQUIPMENT UNDER THE KITCHEN HOOD. THE FUEL AND ELECTRICAL POWER SUPPLY RESET SHALL BE MANUAL. SHUNT TRIP CIRCUIT BREAKERS SHALL BE USED FOR ELECTRICALLY SUPPLIED APPLIANCES LOCATED UNDER THE HOOD.

KEYED NOTES

- PROVIDE 120V CONNECTION FOR TRAP PRIMER. COORDINATE FINAL LOCATION AND REQUIREMENTS WITH PLUMBING CONTRACTOR PRIOR TO ROUGH-IN.
- PROVIDE 120V CONNECTION FOR EQUIPMENT. COORDINATE RECEPTACLE TYPE WITH EQUIPMENT MANUFACTURER PRIOR TO ROUGH-IN.
- PROVIDE 208V SINGLE PHASE CONNECTION FOR EQUIPMENT. COORDINATE RECEPTACLE TYPE WITH EQUIPMENT MANUFACTURER PRIOR TO ROUGH-IN.
- PROVIDE 208V THREE PHASE CONNECTION FOR EQUIPMENT. COORDINATE RECEPTACLE TYPE WITH EQUIPMENT MANUFACTURER PRIOR TO ROUGH-IN.
- PROVIDE 120V CONNECTION FOR GAS SOLENOID VALVE ON SHUNT TRIP BREAKER. INTERLOCK WITH EXHAUST HOOD FIRE SUPPRESSION.



DWG
drawn by
TVO
checked by
OCTOBER 2024
date

revisions
11/22/2024 AD 02
12/12/2024 AD 03




CHILD CARE FACILITY
201 N. EASTERN AVE.

sheet no:


E203

1 ENLARGED ELECTRICAL KITCHEN PLAN
SCALE: 1/4" = 1'-0"

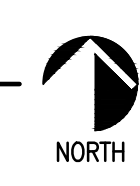

Salas O'Brien
2900 S. Telephone Road, Suite 120
Moore, OK 73160
Salas O'Brien Registration: CA# 7058
Expiration Date: 6/30/2025
Salas O'Brien Project Number: 2450-70304-00

OWNERSHIP USE OF DOCUMENTS:
AGP EXPRESSLY RESERVES ITS COPYRIGHT AND OTHER PROPERTY RIGHTS OF ALL PLANS AND DRAWINGS DESIGNED AND/OR PRODUCED. PLANS AND DRAWINGS ARE NOT TO BE REPRODUCED IN ANY FORM OR MANNER WITHOUT THE EXPRESSED WRITTEN CONSENT OF AGP.

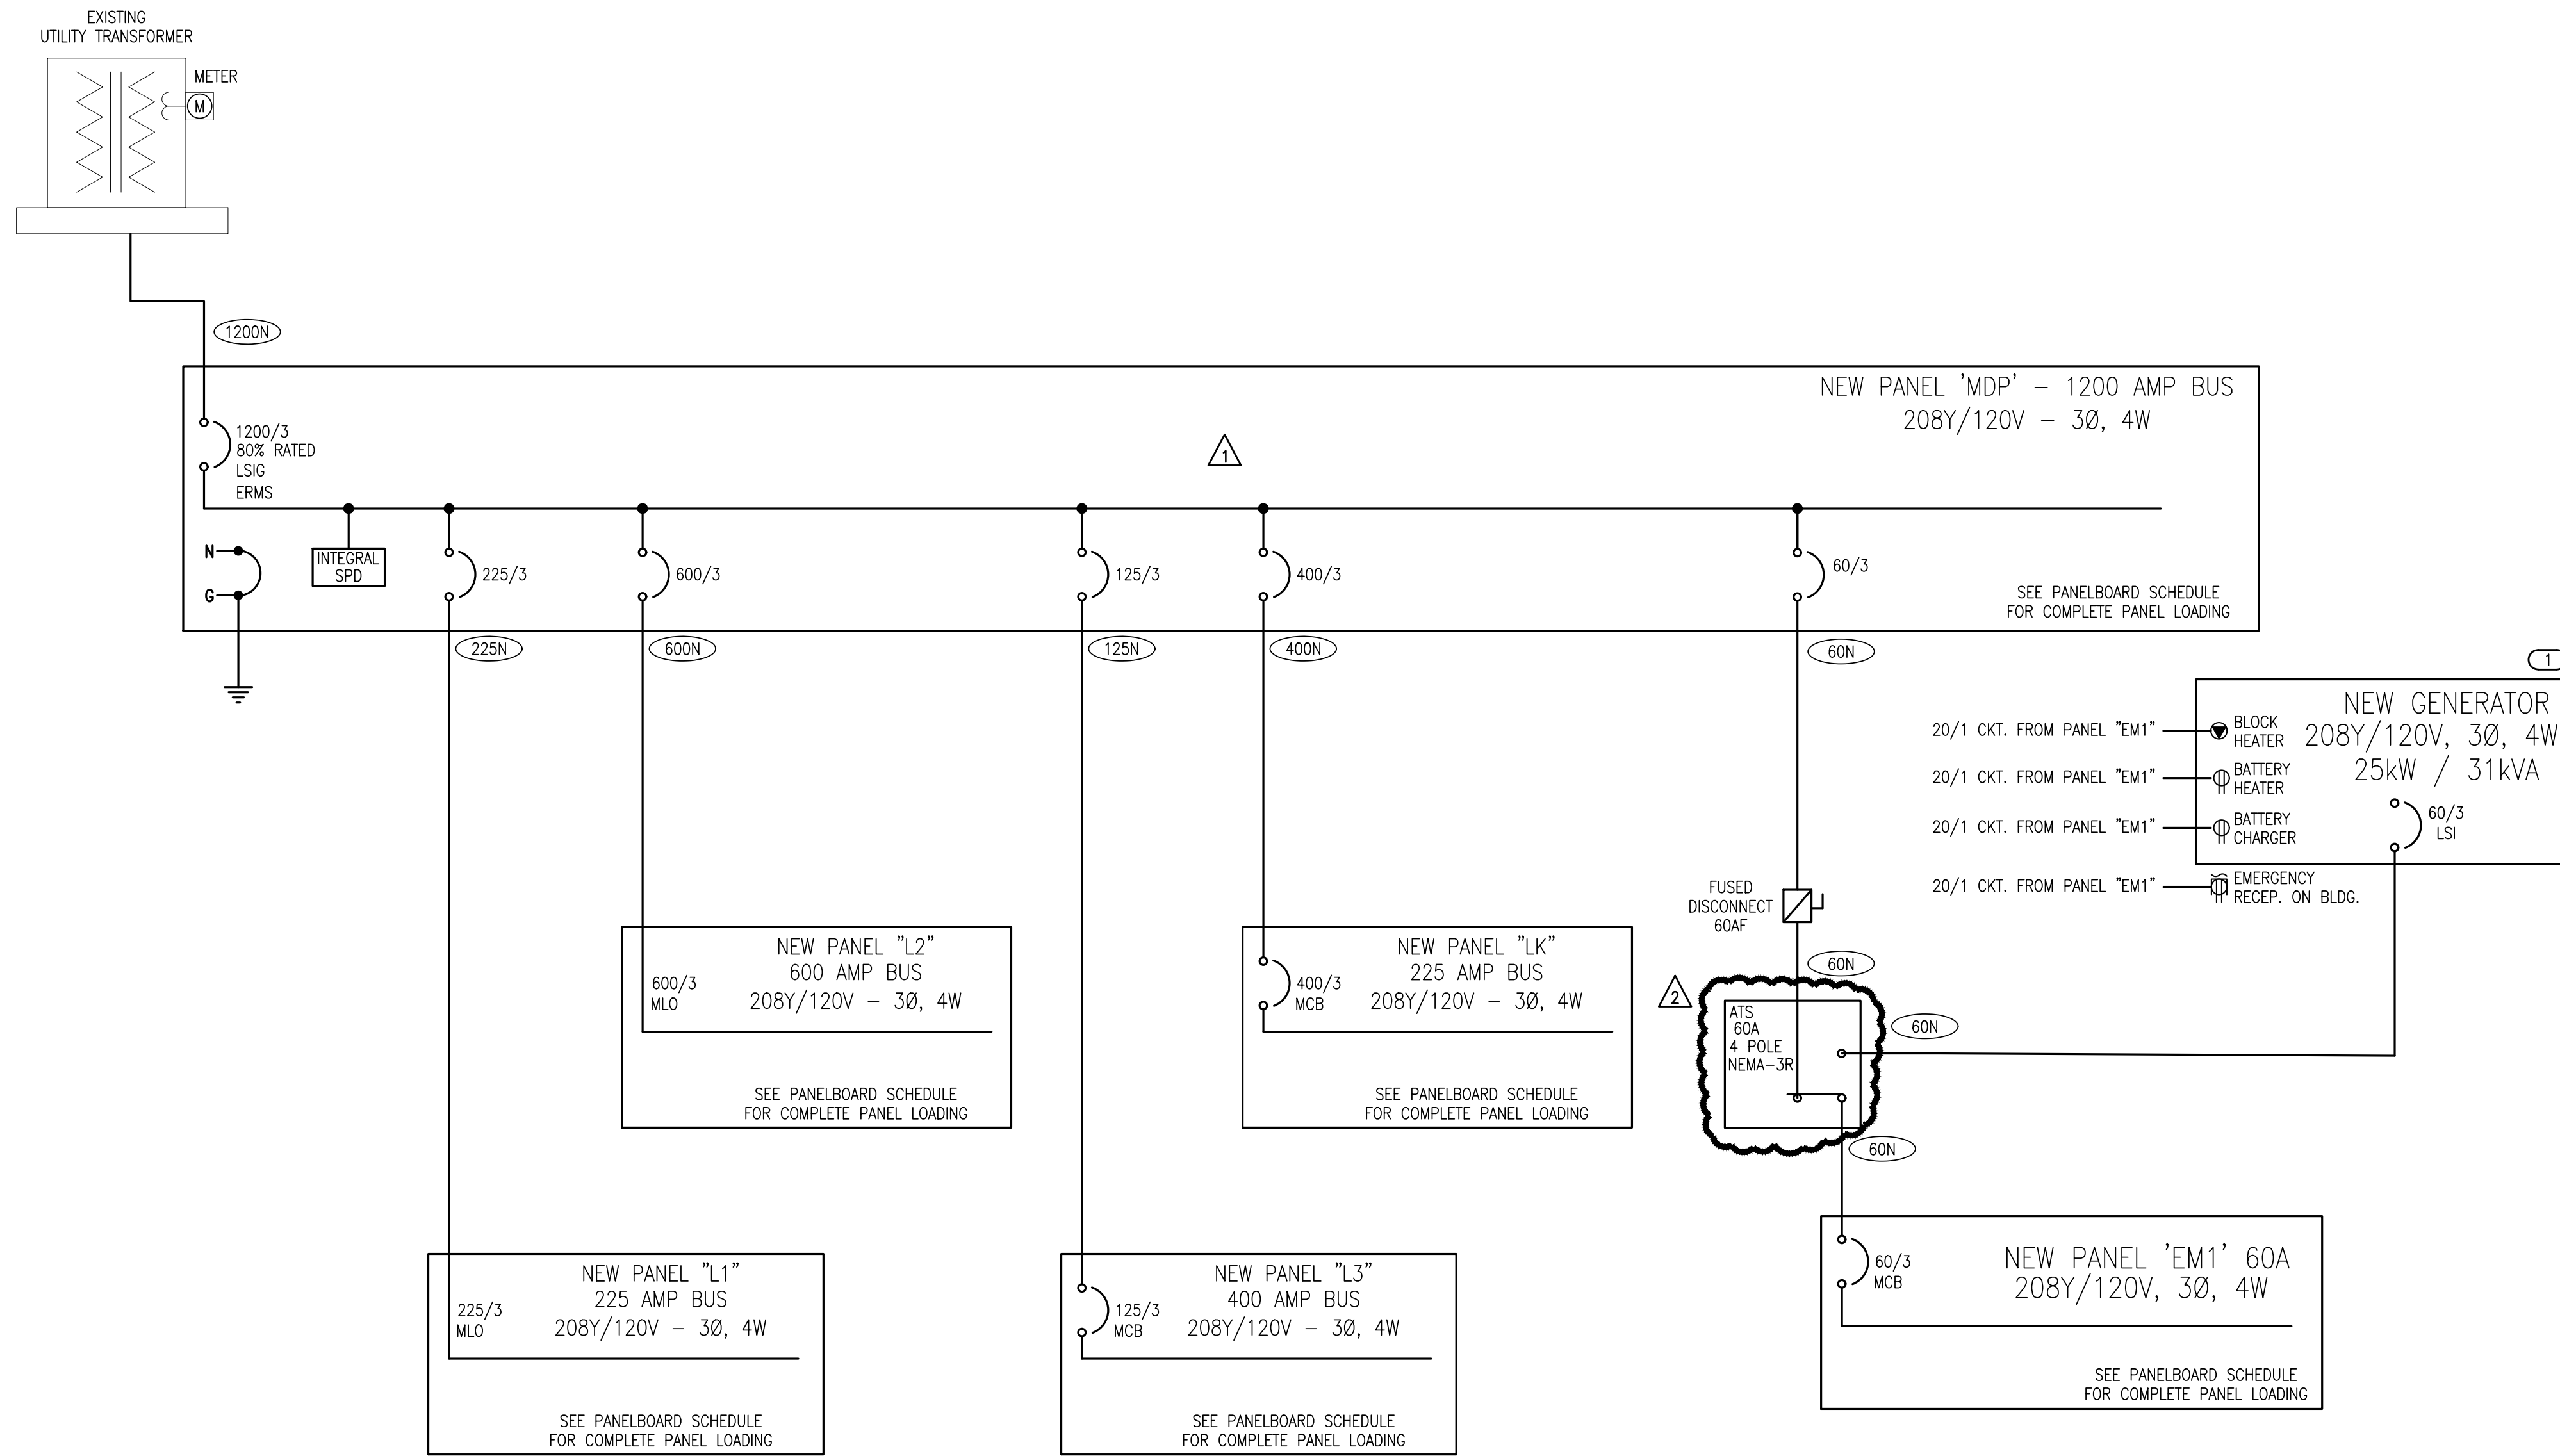

1 ONE-LINE DIAGRAM
NO SCALE

FEEDER SCHEDULE				
AMPS	CONDUIT SIZE 4W	CONDUIT SIZE 3W	PHASE CONDUCTORS	EQUIPMENT GROUND CONDUCTOR
20	3/4"	3/4"	#12	#12
25	3/4"	3/4"	#10	#10
30	3/4"	3/4"	#10	#10
35	1"	3/4"	#8	#10
40	1"	3/4"	#8	#10
45	1"	1"	#6	#10
50	1"	1"	#6	#10
60	1 1/4"	1 1/4"	#4	#10
70	1 1/4"	1 1/4"	#4	#8
80	1 1/4"	1 1/4"	#3	#8
90	1 1/2"	1 1/4"	#2	#8
100	1 1/2"	1 1/4"	#2	#8
110	2"	1 1/2"	#1	#6
125	2"	1 1/2"	#1	#6
150	2"	1 1/2"	#1/0	#6
175	2"	2"	#2/0	#6
200	2"	2"	#3/0	#6
225	2 1/2"	2"	#4/0	#4
250	3"	2 1/2"	250 kcmil	#4
300	3"	3"	350 kcmil	#4
350	3 1/2"	3"	500 kcmil	#3
400	(2) 2"	(2) 2"	2 SETS OF #3/0	#3
450	(2) 2 1/2"	(2) 2"	2 SETS OF #4/0	#2
500	(2) 2 1/2"	(2) 2 1/2"	2 SETS OF 250 kcmil	#2
600	(2) 3"	(2) 3"	2 SETS OF 350 kcmil	#1
700	(2) 3 1/2"	(2) 3"	2 SETS OF 500 kcmil	#1/0
800	(3) 3"	(3) 2 1/2"	3 SETS OF 300 kcmil	#1/0
900	(3) 3 1/2"	(3) 3"	3 SETS OF 400 kcmil	#2/0
1000	(3) 3 1/2"	(3) 3"	3 SETS OF 500 kcmil	#2/0
1200	(4) 3"	(4) 3"	4 SETS OF 350 kcmil	#3/0
1600	(5) 3 1/2"	(5) 3"	5 SETS OF 500 kcmil	#4/0
1800	(6) 3 1/2"	(6) 3"	6 SETS OF 400 kcmil	250 kcmil
2000	(6) 3 1/2"	(6) 3"	6 SETS OF 500 kcmil	250 kcmil
2500	(7) 3 1/2"	(7) 3"	7 SETS OF 500 kcmil	350 kcmil

NOTES:
 1. FEEDER SIZES ARE ON THE PLAN WHERE 60 REFERS TO A 60A FEEDER WITHOUT NEUTRAL AND 60N REFERS TO A 60A FEEDER WITH NEUTRAL.
 2. SOME FEEDER SIZES DO NOT MATCH BREAKER SIZE DUE TO UP-SIZING OF THE FEEDER FOR VOLTAGE DROP.
 3. CONDUITS ARE SIZED PER NEC TABLES FOR THHN/THWN AND MAY BE UPSIZED FOR EASE OF PULLING OR DOWNSIZED AS ALLOWED PER NEC FOR CONDUIT TYPE(S) BEING INSTALLED.
 4. ALL CONDUCTORS 100A AND LESS ARE SIZED PER 60 DEGREE LUGS, EC MAY SIZE CONDUCTORS FOR ACTUAL RATING OF LUGS PER NEC.

GENERAL NOTES

1. AIC RATINGS ARE ESTIMATED BASED ON AVAILABLE DATA DURING DESIGN. CONTRACTOR TO VERIFY AVAILABLE FAULT CURRENT WITH UTILITY.

KEYED NOTES

(1) GENERATOR SHALL BE DUAL FUEL - NATURAL GAS AND PROPANE. GENERATOR SHALL HAVE FUEL TYPE AUTOMATIC SWITCHOVER CAPABILITY. BASIS OF DESIGN - KOHLER MODEL 250CL 25/31 KW/KVA.

AGP
 the Abila Griffin Partnership L.L.C.
 201 N. BROADWAY SUITE 210
 MOORE, OK. 73160
 405.735.3477
 AGP@theAGP.net
 www.theAGP.net

KFC ENGINEERING
 STRUCTURAL
 SALAS O'BRIEN
 MECHANICAL / ELECTRICAL



DWG
 drawn by
 TVO
 checked by
 OCTOBER 2024
 date

revisions
 11/22/2024 AD 02
 12/12/2024 AD 03



CHILD CARE FACILITY
 201 N. EASTERN AVE.

sheet no:
E401

Salas O'Brien
 2900 S. Telephone Road, Suite 120
 Moore, OK 73160
 Salas O'Brien Registration: CA# 7058
 Expiration Date: 6/30/2025
 Salas O'Brien Project Number: 2450-70304-00

OWNERSHIP USE OF DOCUMENTS:
 AGP EXPRESSLY RESERVES ITS COPYRIGHT AND OTHER PROPERTY RIGHTS OF ALL PLANS AND DRAWINGS DESIGNED AND/OR PRODUCED. PLANS AND DRAWINGS ARE NOT TO BE REPRODUCED IN ANY FORM OR MANNER WITHOUT THE EXPRESSED WRITTEN CONSENT OF AGP.



DWG
drawn by
TVO
checked by
OCTOBER 2024
date

revisions
12/12/2024 AD 03



CHILD CARE FACILITY
201 N. EASTERN AVE.


sheet no:

E502


Salas O'Brien
2900 S. Telephone Road, Suite 120
Moore, OK 73160
Salas O'Brien Registration: CA# 7058
Expiration Date: 6/30/2025
Salas O'Brien Project Number: 2450-70304-00

OWNERSHIP USE OF DOCUMENTS:
AGP EXPRESSLY RESERVES ITS COPYRIGHT AND OTHER PROPERTY RIGHTS OF ALL PLANS AND DRAWINGS DESIGNED AND/OR PRODUCED. PLANS AND DRAWINGS ARE NOT TO BE REPRODUCED IN ANY FORM OR MANNER WITHOUT THE EXPRESSED WRITTEN CONSENT OF AGP.

DATA & POWER OUTLET NEAR TEACHERS DESK

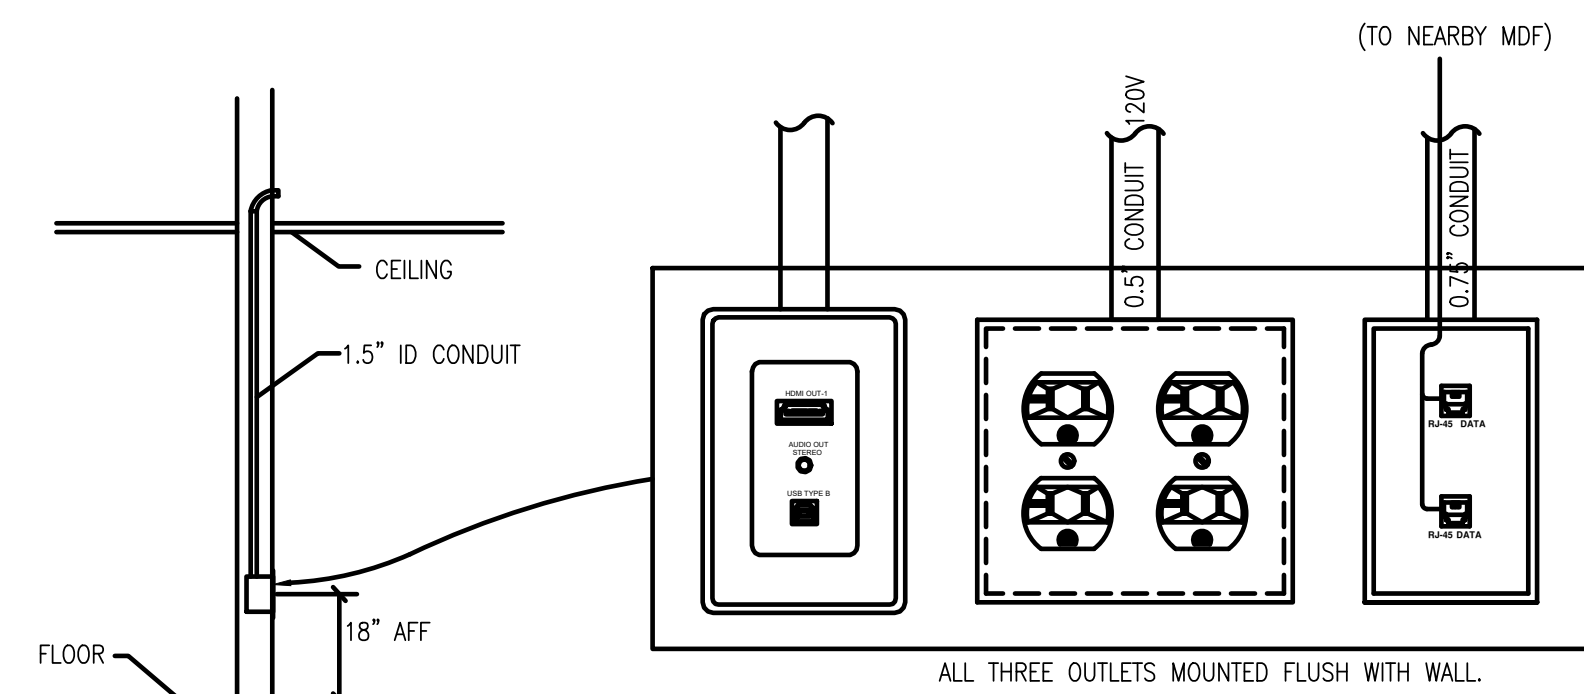


POWER OUTLET BEHIND SMARTBOARD

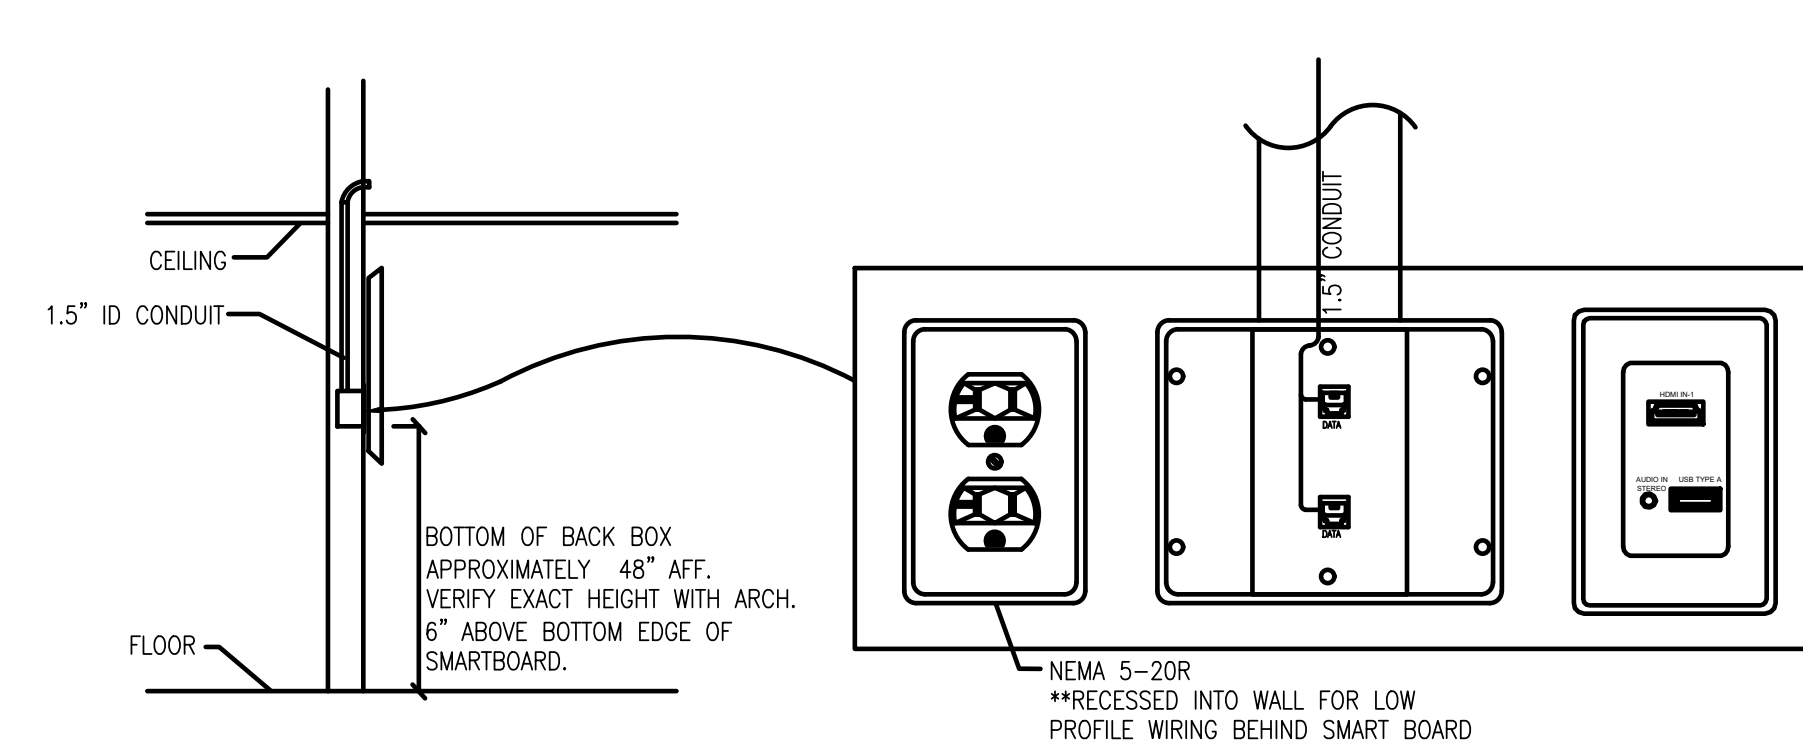


1 TEACHERS DESK & SMART BOARD WIRING DETAIL

NO SCALE

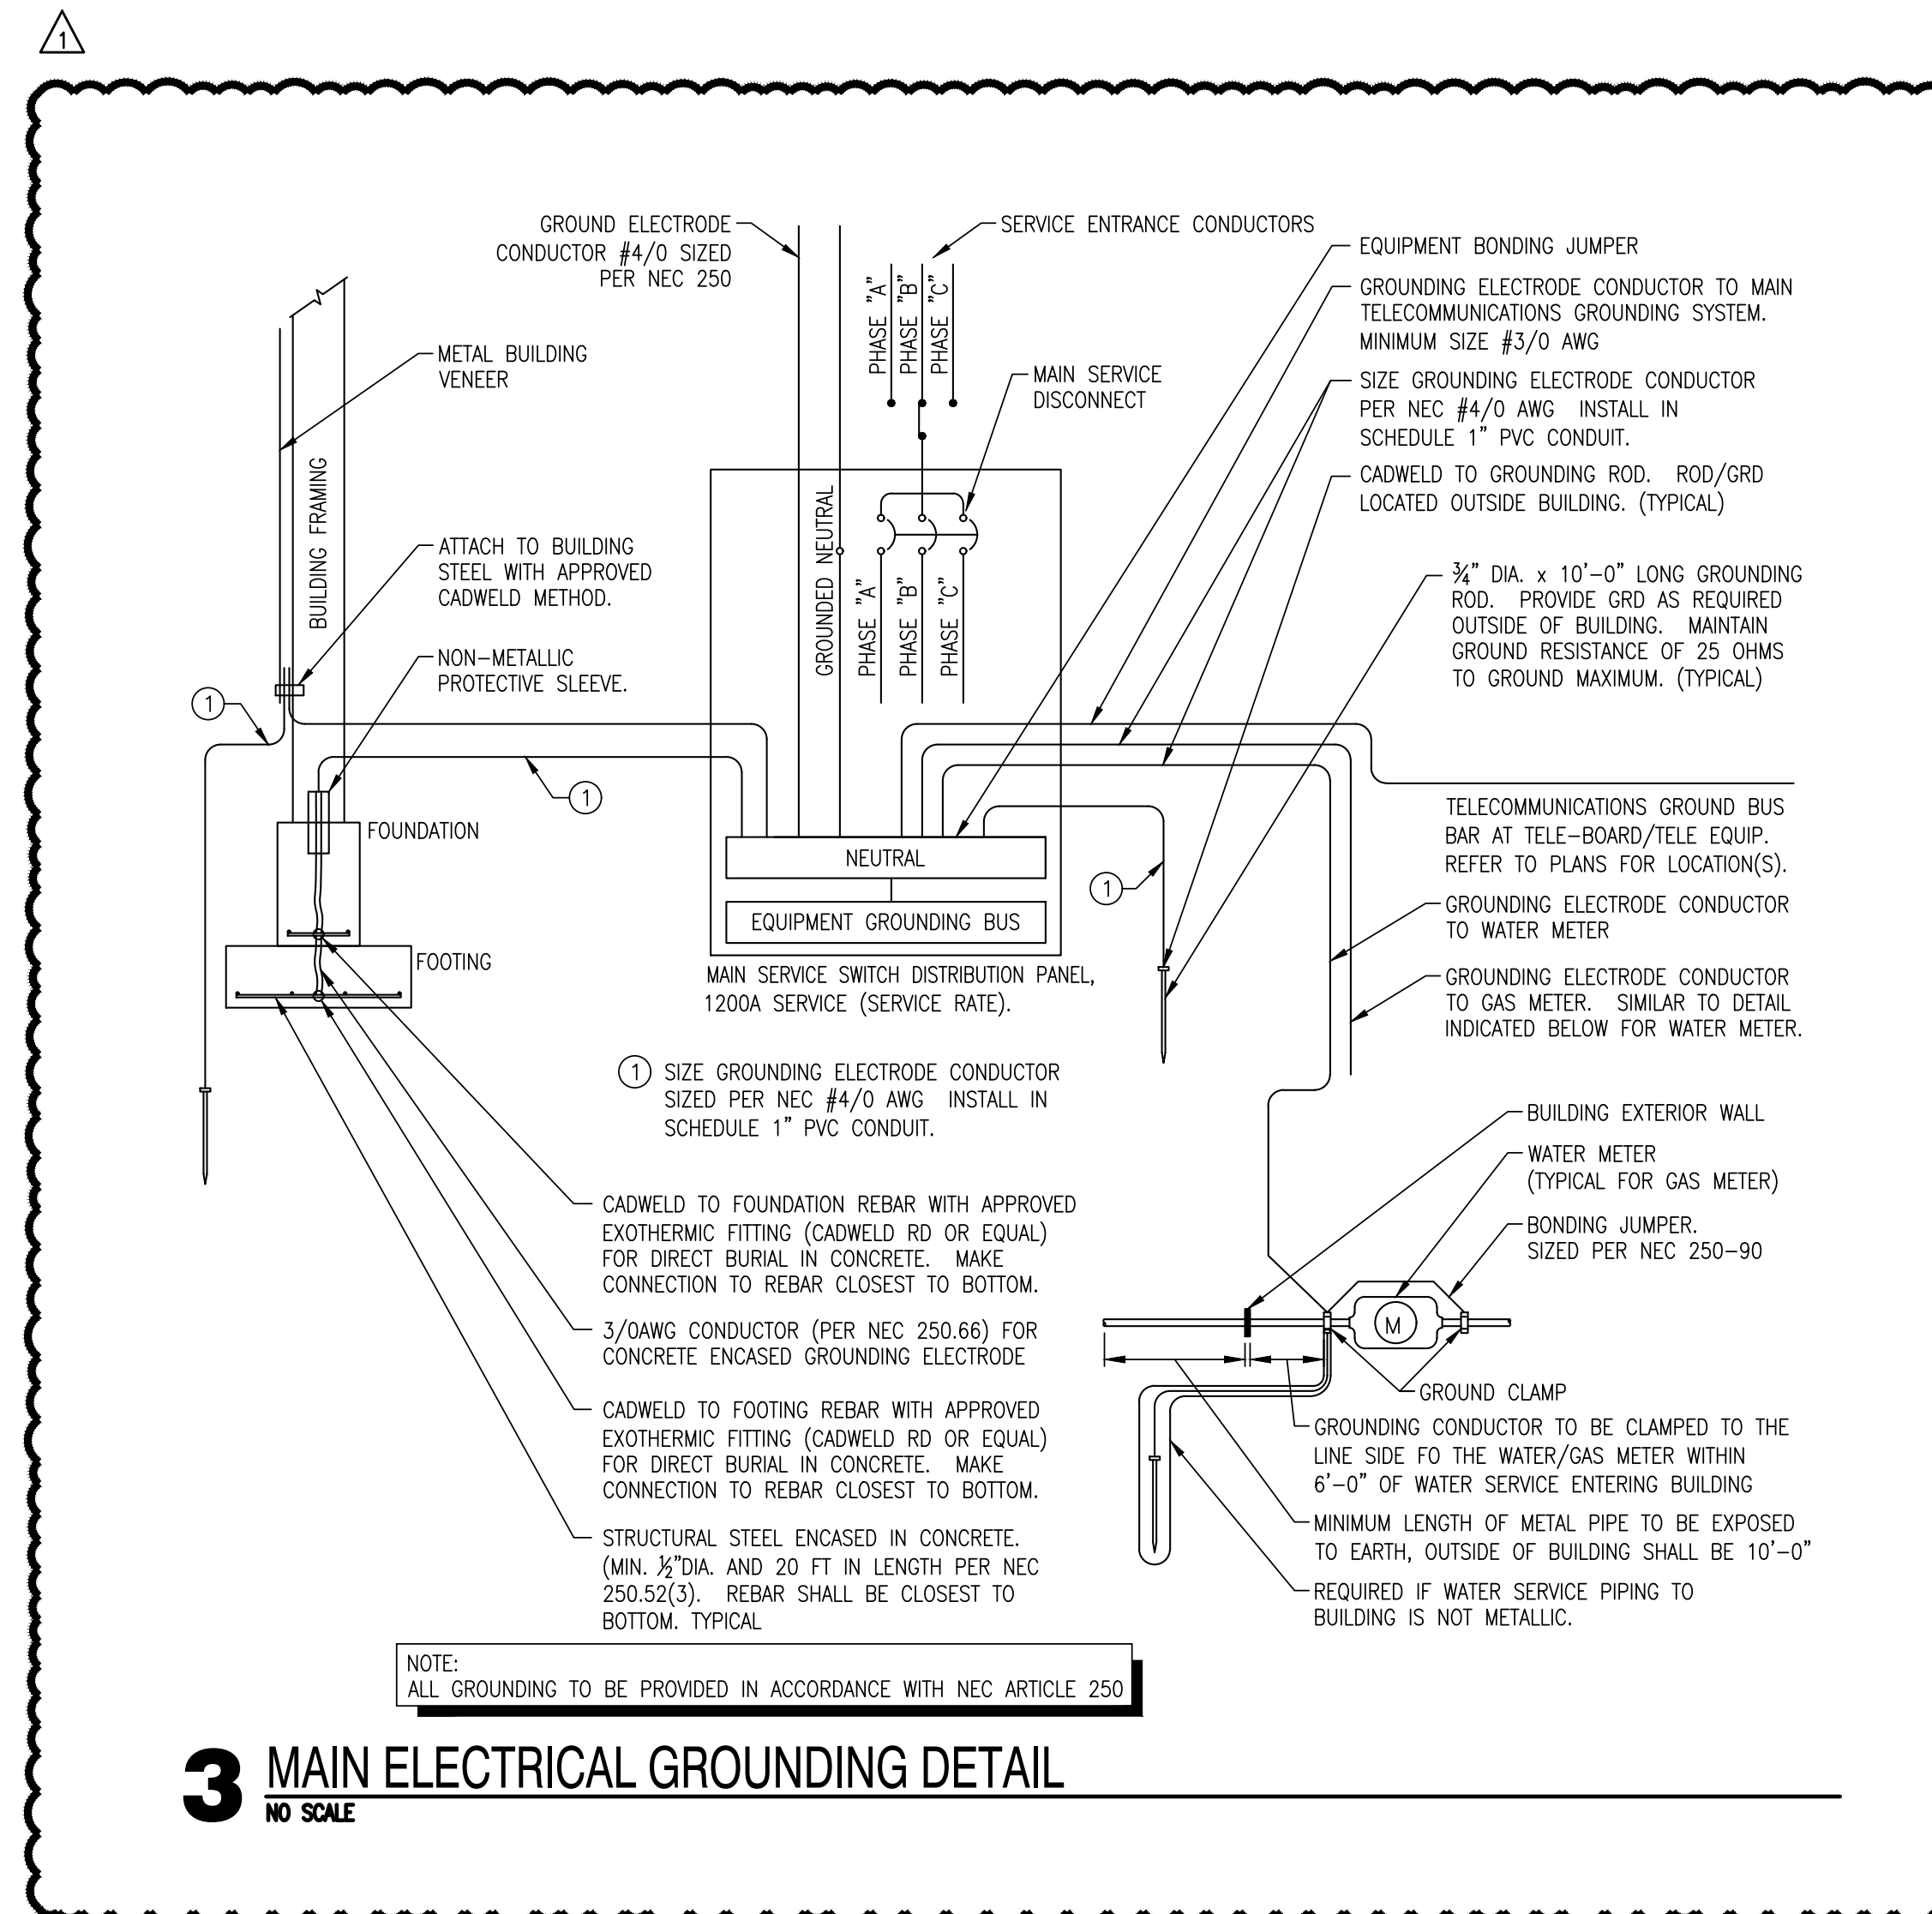

3 MAIN ELECTRICAL GROUNDING DETAIL

NO SCALE

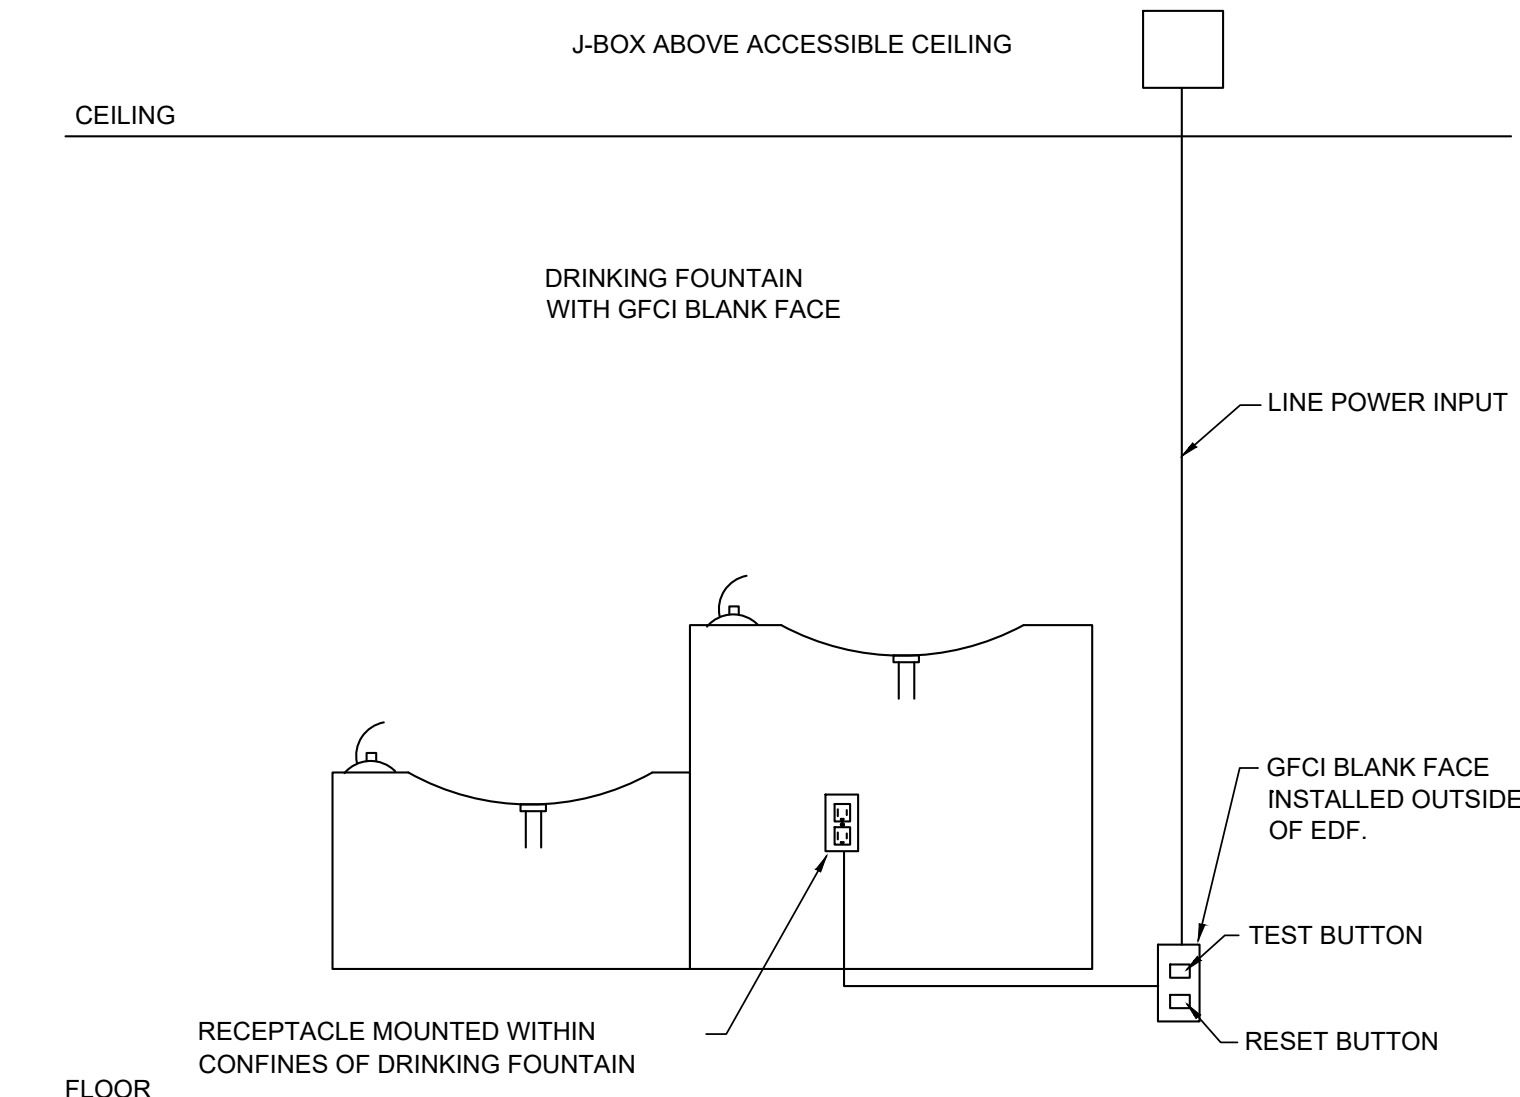


2 TYP. ELECTRICAL DRINKING FOUNTAIN DETAIL

NO SCALE



DWG
drawn by
TVO
checked by
OCTOBER 2024
date

revisions
 11/22/2024 AD 02
 12/12/2024 AD 03

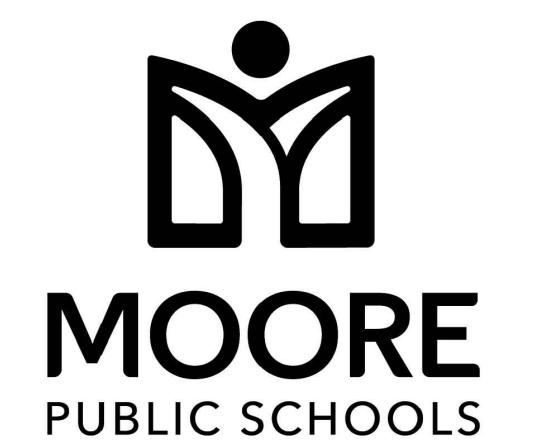

CHILD CARE FACILITY
201 N. EASTERN AVE.

sheet no:

E601

Panel L2		ROOM MOUNTING SURFACE	VOLTS 208Y/120V 3P 4W	AIC 65,000	ROOM MOUNTING SURFACE		VOLTS 208Y/120V 3P 4W	AIC 65,000					
CKT #	CKT BKR	LOAD KVA	CIRCUIT DESCRIPTION	CKT #	CKT BKR	LOAD KVA	CIRCUIT DESCRIPTION	CKT #	CKT BKR	LOAD KVA	CIRCUIT DESCRIPTION		
1	25/3	5.48	RTU-1	a	2	35/3	7.21	RTU-9	a	2	20/1	0.9	ROOFTOP RECEPTACLE
3				b	4				b	4	20/1	0.36	RM 431 RECEPTACLE, RM 433 RECEPTACLE
5				c	6				c	6	20/1	0.36	I.T. RECEPTACLE
7	40/3	7.49	RTU-2	a	8	40/3	7.49	RTU-10	a	8	20/1	0.36	I.T. RECEPTACLE
9				b	10				b	10	20/1	0.36	I.T. RECEPTACLE
11				c	12				c	12	20/1	0.36	I.T. RECEPTACLE
13	25/3	5.48	RTU-3	a	14	50/3	13.3	RTU-11	a	14	20/1	0.54	RM 434 RECEPTACLE
15				b	16				b	16	20/1	0.54	RM 434 RECEPTACLE
17				c	18				c	18	20/1	0.54	RM 430 RECEPTACLE
19	40/3	7.49	RTU-4	a	20	35/3	7.21	RTU-12	a	20	20/1	0.36	RM 429 RECEPTACLE, SMARTBOARD
21				b	22				b	22	20/1	0.9	SPACE
23				c	24				c	24	20/1	0.72	RM 1E RECEPTACLE, RM 5 RECEPTACLE
25	50/3	13.3	RTU-5	a	26	50/3	13.3	RTU-13	a	26	20/1	0.93	CORRIDOR 428 RECEPTACLE, CORRIDOR 435 RECEPTACLE, RM 435 RECEPTACLE, TRAP PRIMER
27				b	28				b	28	15/1	0.696	EF-1
29				c	30				c	30	30/2	4.5	EFH-1
31	25/3	5.48	RTU-6	a	32	25/3	7.21	RTU-14	a	32			
33				b	34				b	34	15/1	0.696	EF-5
35				c	36				c	36	15/1	0.696	EF-6
37	50/3	13.3	RTU-7	a	38	25/3	5.48	RTU-15	a	38	15/1	0.696	EF-2
39				b	40				b	40	20/1	0.528	CP-1
41				c	42				c	42	20/2	2	EFH-1
43	50/3	13.8	RTU-8	a	44	25/3	5.48	RTU-16	a	44			
45				b	46				b	46	20/2	2	EFH-4
47				c	48				c	48			
49	20/1	0	SPACE	a	50	20/1	0	SPACE	a	50	15/1	0.696	EF-7
51	20/1	0	SPACE	b	52	20/1	0	SPACE	b	52	20/1	0.9	RM 301A RECEPTACLE, RM 301 RECEPTACLE, RM 303 RECEPTACLE
53	20/1	0	SPACE	c	54	20/1	0	SPACE	c	54	20/1	0.72	RM 301 RECEPTACLE, SMARTBOARD
55	20/1	0	SPACE	a	56	20/1	0	SPACE	a	56	20/1	0.72	RM 422 RECEPTACLE
57	20/1	0	SPACE	b	58	20/1	0	SPACE	b	58	20/1	0.54	RM 423 RECEPTACLE, RM 424 RECEPTACLE, RM 425 RECEPTACLE
59	20/1	0	SPACE	c	60	20/1	0	SPACE	c	60	20/1	0.72	RM 205 RECEPTACLE

Panel EM1		ROOM MOUNTING SURFACE	VOLTS 208Y/120V 3P 4W	AIC 65,000	ROOM MOUNTING SURFACE		VOLTS 208Y/120V 3P 4W	AIC 65,000					
CKT #	CKT BKR	LOAD KVA	CIRCUIT DESCRIPTION	CKT #	CKT BKR	LOAD KVA	CIRCUIT DESCRIPTION	CKT #	CKT BKR	LOAD KVA	CIRCUIT DESCRIPTION		
1	20/1	0.432	LIGHTING	a	2	15/1	1.18	SF-1	a	2	20/1	0.432	LIGHTING
3	20/1	0.441	LIGHTING	b	4	15/1	0.696	SF-2	b	4	20/1	0.441	LIGHTING
5	20/1	1	LIGHTING	c	6	15/1	0.696	SF-3	c	6	20/1	1	LIGHTING
7	20/1	0.981	LIGHTING	a	8	20/1	0.5	BLOCK HEATER	a	8	20/1	0.981	LIGHTING
9	20/1	0.55	LIGHTING	b	10	20/1	0.5	BATTERY HEATER	b	10	20/1	0.55	LIGHTING
11	20/1	0.643	LIGHTING	c	12	20/1	0.5	BATTERY CHARGER	c	12	20/1	0.643	LIGHTING
13	20/1	0.568	LIGHTING	a	14	20/1	0.18	RECEPTACLE	a	14	20/1	0.568	LIGHTING
15	20/1	0.477	LIGHTING	b	16	20/1	0	SPACE	b	16	20/1	0.477	LIGHTING
17	20/1	0	SPACE	c	18	20/1	0	SPACE	c	18	20/1	0	SPACE
19	20/1	0	SPACE	a	20	20/1	0	SPACE	a	20	20/1	0	SPACE
21	20/1	0	SPACE	b	22	20/1	0	SPACE	b	22	20/1	0	SPACE
23	20/1	0	SPACE	c	24	20/1	0	SPACE	c	24	20/1	0	SPACE
25	20/1	0	SPACE	a	26	20/1	0	SPACE	a	26	20/1	0	SPACE
27	20/1	0	SPACE	b	28	20/1	0	SPACE	b	28	20/1	0	SPACE
29	20/1	0	SPACE	c	30	20/1	0	SPACE	c	30	20/1	0	SPACE

Panel L1		ROOM MOUNTING SURFACE	VOLTS 208Y/120V 3P 4W	AIC 65,000	ROOM MOUNTING SURFACE		VOLTS 208Y/120V 3P 4W	AIC 65,000					
CKT #	CKT BKR	LOAD KVA	CIRCUIT DESCRIPTION	CKT #	CKT BKR	LOAD KVA	CIRCUIT DESCRIPTION	CKT #	CKT BKR	LOAD KVA	CIRCUIT DESCRIPTION		
1	20/1	0.9	ROOFTOP RECEPTACLE	a	2	20/1	1.28	LIGHTING	a	2	20/1	1.28	LIGHTING
3	20/1	0.36	RM 431 RECEPTACLE, RM 433 RECEPTACLE	b	4	20/1	0.806	LIGHTING	b	4	20/1	0.806	LIGHTING
5	20/1	0.36	I.T. RECEPTACLE	c	6	20/1	0.706	LIGHTING	c	6	20/1	0.706	LIGHTING
7	20/1	0.36	I.T. RECEPTACLE	a	8	20/1	0.48	LIGHTING	a	8	20/1	0.48	LIGHTING
9	20/1	0.36	I.T. RECEPTACLE	b	10	20/1	0.636	LIGHTING	b	10	20/1	0.636	LIGHTING
11	20/1	0.36	I.T. RECEPTACLE	c	12	20/1	1.06	LIGHTING	c	12	20/1	1.06	LIGHTING
13	20/1	0.54	RM 434 RECEPTACLE	a	14	20/1	0.528	CP-3	a	14	20/1	0.528	CP-3
15	20/1	0.54	RM 434 RECEPTACLE	b	16	20/1	0.1	WH-3	b	16	20/1	0.1	WH-3
17	20/1	0.54	RM 430 RECEPTACLE	c	18	20/1	0.1	WH-4	c	18	20/1	0.1	WH-4
19	20/1	0.36	RM 429 RECEPTACLE, SMARTBOARD	a	20	20/1	0.1	WH-1	a	20	20/1	0.1	WH-1
21	20/1	0.9	RM 429 RECEPTACLE, SMARTBOARD	b	22	20/1	0.1	WH-2	b	22	20/1	0.1	WH-2
23	20/1	0	SPACE	c	24	20/1	0.1	WH-5	c	24	20/1	0.1	WH-5
25	20/1	0.72	RM 1E RECEPTACLE, RM 5 RECEPTACLE	a	26	20/1	0.528	CP-2	a	26	20/1	0.528	CP-2
27	20/1	0.93	CORRIDOR 428 RECEPTACLE, CORRIDOR 435 RECEPTACLE, RM 435 RECEPTACLE, TRAP PRIMER	b	28	15/1	0.696	EF-1	b	28	15/1	0.696	EF-1
29	20/1	0.54	RM 5 RECEPTACLE	c	30	30/2	4.5	EFH-1	c	30	30/2	4.5	EFH-1
31	20/1	0.72	RM 1D RECEPTACLE, RM 4 RECEPTACLE	a	32				a	32			
33	20/1	0.54	RM 4 RECEPTACLE	b	34	15/1	0.696	EF-5	b	34	15/1	0.696	EF-5
35	20/1	0.54	RM 3 RECEPTACLE	c	36	15/1	0.696	EF-6	c	36	15/1	0.696	EF-6
37	20/1	0.72	RM 1C RECEPTACLE, RM 3 RECEPTACLE	a	38	15/1	0.696	EF-2	a	38	15/1	0.696	EF-2
39	20/1	0.72	RM 1B RECEPTACLE, RM 2 RECEPTACLE	b	40	20/1	0.528	CP-1	b	40	20/1	0.528	CP-1
41	20/1	0.54	RM 2 RECEPTACLE	c	42	20/2	2	EFH-1	c	42	20/2	2	EFH-1
43	20/1	0.54	RM 103 RECEPTACLE	a	44				a	44			
45	20/1	0.72	RM 101C RECEPTACLE, RM 103 RECEPTACLE	b	46	20/2	2	EFH-4	b	46	20/2	2	EFH-4
47	20/1	0.72	RM 101B RECEPTACLE, RM 102 RECEPTACLE	c	48				c	48			
49	20/1	0.54	RM 102 RECEPTACLE	a	50	15/1	0.696	EF-7	a	50	15/1	0.696	EF-7
51	20/1	0.72	RM 101A RECEPTACLE, RM 101 RECEPTACLE	b	52	20/1	0.9	RM 301A RECEPTACLE, RM 301 RECEPTACLE, RM 303 RECEPTACLE	b	52	20/1	0.9	RM 301A RECEPTACLE, RM 301 RECEPTACLE, RM 303 RECEPTACLE
53	20/1	0.54	RM 101 RECEPTACLE	c	54	20/1	0.72	RM 301 RECEPTACLE, SMARTBOARD	c	54	20/1	0.72	RM 301 RECEPTACLE, SMARTBOARD
55	20/1	0.72	RM 101D RECEPTACLE, RM 104 RECEPTACLE	a	56	20/1	0.72	RM 422 RECEPTACLE	a	56	20/1	0.72	RM 422 RECEPTACLE
57	20/1	0.54	RM 104 RECEPTACLE	b	58	20/1	0.54	RM 423 RECEPTACLE, RM 424 RECEPTACLE, RM 425 RECEPTACLE	b	58	20/1	0.54	RM 423 RECEPTACLE, RM 424 RECEPTACLE, RM 425 RECEPTACLE
59	20/1	0.72	RM 101E RECEPTACLE, RM 105 RECEPTACLE	c	60	20/1	0.72	RM 205 RECEPTACLE	c	60	20/1	0.72	RM 205 RECEPTACLE
61	20/1	0.9	CORRIDOR 436 RECEPTACLE, RM 105F RECEPTACLE, RM 105 RECEPTACLE	a	62	20/1	0.72	RM 201E RECEPTACLE, RM 205 RECEPTACLE	a	62	20/1	0.72	RM 201E RECEPTACLE, RM 205 RECEPTACLE
63	20/1	0.72	RM 201C RECEPTACLE, RM 203 RECEPTACLE	b	64	20/1	0.73	RM 201D RECEPTACLE, RM 204 RECEPTACLE, TRAP PRIMER	b	64	20/1	0.73	RM 201D RECEPTACLE, RM 204 RECEPTACLE, TRAP PRIMER
65	20/1	0.54	EXTERIOR RECEPTACLE	c	66	20/1	0.72	RM 204 RECEPTACLE	c	66	20/1	0.72	RM 204 RECEPTACLE
67	20/1	1.1	CORRIDOR 419 RECEPTACLE, CORRIDOR 420 RECEPTACLE, CORRIDOR 428 RECEPTACLE, RM 421 RECEPTACLE, TRAP PRIMER	a	68	20/1	0.72	RM 202 RECEPTACLE	a	68	20/1	0.72	RM 202 RECEPTACLE
69	20/1	0.36	TELECOM EQ	b	70	20/1	0.72	RM 201B RECEPTACLE, RM 202 RECEPTACLE	b	70	20/1	0.72	RM 201B RECEPTACLE, RM 202 RECEPTACLE
71	20/1	0	SPACE	c	72	20/1	0.72	RM 203 RECEPTACLE	c	72	20/1	0.72	RM 203 RECEPTACLE
73	20/1	0	SPACE	a	74	20/1	0.415	DRYER, DRYER BOOSTER FAN	a	74	20/1	0.415	DRYER, DRYER BOOSTER FAN
75	20/1	0	SPACE	b	76								

MECHANICAL EQUIPMENT SCHEDULE											
CALLOUT	DESCRIPTION	VOLTS	HP	KVA	MCA	MOCP	CIRCUIT	WIRE CALLOUT	DISCONNECT	DISC PROV BY	DISC INST BY
CP-1	CIRCULATION PUMP	120V 1P 2W	1/6 HP	0.53			L1-40	3/4"C,1#10,1#10G	TOGGLE SWITCH	EC	EC
CP-2	CIRCULATION PUMP	120V 1P 2W	1/6 HP	0.53			L1-26	3/4"C,1#12,1#12N,1#12G	TOGGLE SWITCH	EC	EC
CP-3	CIRCULATION PUMP	120V 1P 2W	1/6 HP	0.53			L1-14	3/4"C,1#10,1#10G	TOGGLE SWITCH	EC	EC
EF-1	EXHAUST FAN	120V 1P 2W	1/4 HP	0.7	4	15	L1-28	3/4"C,1#10,1#10G	TOGGLE SWITCH	EC	EC
EF-2	EXHAUST FAN	120V 1P 2W	1/4 HP	0.7	4	15	L1-38	3/4"C,1#10,1#10G	TOGGLE SWITCH	EC	EC
EF-3	EXHAUST FAN	120V 1P 2W	1/4 HP	0.7	4	15	L3-42	3/4"C,1#12,1#12N,1#12G	TOGGLE SWITCH	EC	EC
EF-4	EXHAUST FAN	120V 1P 2W	1/4 HP	0.7	4	15	L3-40	3/4"C,1#12,1#12N,1#12G	TOGGLE SWITCH	EC	EC
EF-5	EXHAUST FAN	120V 1P 2W	1/4 HP	0.7	4	15	L1-34	3/4"C,1#10,1#10G	TOGGLE SWITCH	EC	EC
EF-6	EXHAUST FAN	120V 1P 2W	1/4 HP	0.7	4	15	L1-36	3/4"C,1#10,1#10G	TOGGLE SWITCH	EC	EC
EF-7	EXHAUST FAN	120V 1P 2W	1/4 HP	0.7	4	15	L1-50	3/4"C,1#10,1#10G	TOGGLE SWITCH	EC	EC
EF-8	EXHAUST FAN	120V 1P 2W	1/4 HP	0.7	4	15	L3-52	3/4"C,1#10,1#10G	TOGGLE SWITCH	EC	EC
EFH-1	ELECTRIC FAN FORCED HEATER	208V 2P 2W		2			L1-42,44	3/4"C,2#10,1#10G	TOGGLE SWITCH	MFR	EC
EFH-2	ELECTRIC FAN FORCED HEATER	208V 2P 2W		2			L3-48,50	3/4"C,2#10,1#10G	TOGGLE SWITCH	MFR	EC
EFH-3	ELECTRIC FAN FORCED HEATER	208V 2P 2W		2			L3-44,46	3/4"C,2#10,1#10G	TOGGLE SWITCH	MFR	EC
EFH-4	ELECTRIC FAN FORCED HEATER	208V 2P 2W		2			L1-46,48	3/4"C,2#10,1#10G	TOGGLE SWITCH	MFR	EC
EWH-1	ELECTRIC WATER HEATER	208V 2P 2W		4.5			L1-30,32	3/4"C,2#10,1#10G	NON-FUSED	EC	EC
RTU-1	ROOF TOP UNIT	208V 3P 3W		5.48	19	25	L2-1,3,5	3/4"C,3#10,1#10G	NON-FUSED	MFR	EC
RTU-2	ROOF TOP UNIT	208V 3P 3W		7.49	26	40	L2-7,9,11	3/4"C,3#10,1#10G	NON-FUSED	MFR	EC
RTU-3	ROOF TOP UNIT	208V 3P 3W		5.48	19	25	L2-13,15,17	3/4"C,3#8,1#10G	NON-FUSED	MFR	EC
RTU-4	ROOF TOP UNIT	208V 3P 3W		7.49	26	40	L2-19,21,23	3/4"C,3#10,1#10G	NON-FUSED	MFR	EC
RTU-5	ROOF TOP UNIT	208V 3P 3W		13.26	46	50	L2-25,27,29	3/4"C,3#6,1#10G	NON-FUSED	MFR	EC
RTU-6	ROOF TOP UNIT	208V 3P 3W		5.48	19	25	L2-31,33,35	3/4"C,3#8,1#10G	NON-FUSED	MFR	EC
RTU-7	ROOF TOP UNIT	208V 3P 3W		13.26	46	50	L2-37,39,41	1"C,3#4,1#10G	NON-FUSED	MFR	EC
RTU-8	ROOF TOP UNIT	208V 3P 3W		13.83	48	50	L2-43,45,47	1"C,3#4,1#10G	NON-FUSED	MFR	EC
RTU-9	ROOF TOP UNIT	208V 3P 3W		7.21	25	35	L2-2,4,6	3/4"C,3#10,1#10G	NON-FUSED	MFR	EC
RTU-10	ROOF TOP UNIT	208V 3P 3W		7.49	26	40	L2-8,10,12	3/4"C,3#10,1#10G	NON-FUSED	MFR	EC
RTU-11	ROOF TOP UNIT	208V 3P 3W		13.26	46	50	L2-14,16,18	3/4"C,3#6,1#10G	NON-FUSED	MFR	EC
RTU-12	ROOF TOP UNIT	208V 3P 3W		7.21	25	35	L2-20,22,24	3/4"C,3#10,1#10G	NON-FUSED	MFR	EC
RTU-13	ROOF TOP UNIT	208V 3P 3W		13.26	46	50	L2-26,28,30	1"C,3#4,1#10G	NON-FUSED	MFR	EC
RTU-14	ROOF TOP UNIT	208V 3P 3W		5.48	19	25	L2-32,34,36	3/4"C,3#10,1#10G	NON-FUSED	MFR	EC
RTU-15	ROOF TOP UNIT	208V 3P 3W		5.48	19	25	L2-38,40,42	3/4"C,3#10,1#10G	NON-FUSED	MFR	EC
RTU-16	ROOF TOP UNIT	208V 3P 3W		5.48	19	25	L2-44,46,48	3/4"C,3#10,1#10G	NON-FUSED	MFR	EC
SF-1	EXHAUST FAN	120V 1P 2W	1/2 HP	1.18	2	15	EM1-2	3/4"C,1#12,1#12N,1#12G	TOGGLE SWITCH	EC	EC
SF-2	EXHAUST FAN	120V 1P 2W	1/4 HP	0.7	2	15	EM1-4	3/4"C,1#10,1#10G	TOGGLE SWITCH	EC	EC
SF-3	EXHAUST FAN	120V 1P 2W	1/4 HP	0.7	2	15	EM1-6	3/4"C,1#12,1#12N,1#12G	TOGGLE SWITCH	EC	EC
WH-1	WATER HEATER	120V 1P 2W	F HP	0.1			L1-20	3/4"C,1#12,1#12N,1#12G	DUPLEX RECEPTACLE GFI	EC	EC
WH-2	WATER HEATER	120V 1P 2W	F HP	0.1			L1-22	3/4"C,1#12,1#12N,1#12G	DUPLEX RECEPTACLE GFI	EC	EC
WH-3	WATER HEATER	120V 1P 2W	F HP	0.1			L1-16	3/4"C,1#12,1#12N,1#12G	DUPLEX RECEPTACLE GFI	EC	EC
WH-4	WATER HEATER	120V 1P 2W	F HP	0.1			L1-18	3/4"C,1#12,1#12N,1#12G	DUPLEX RECEPTACLE GFI	EC	EC
WH-5	WATER HEATER	120V 1P 2W	F HP	0.1			L1-24	3/4"C,1#12,1#12N,1#12G	DUPLEX RECEPTACLE GFI	EC	EC

KITCHEN EQUIPMENT SCHEDULE											
CALLOUT	DESCRIPTION	VOLTS	HP	KVA	MCA	MOCP	CIRCUIT	WIRE CALLOUT	DISCONNECT	DISC PROV BY	DISC INST BY
AC	AIR CURTAIN	120V 1P 2W	1 HP	1.92					TOGGLE SWITCH	EC	EC
CLR	COOLER LIGHTING	120V 1P 2W		0.3			LK-15	3/4"C,1#12,1#12N,1#12G	JUNCTION BOX	EC	EC
CO-1	CONVECTION OVEN	120V 1P 2W	1/2 HP	1.18			LK-30	3/4"C,1#12,1#12N,1#12G	DUPLEX RECEPTACLE GFI	EC	EC
CO-2	CONVECTION OVEN	120V 1P 2W	1/2 HP	1.18			LK-26	3/4"C,1#12,1#12N,1#12G	DUPLEX RECEPTACLE GFI	EC	EC
CS-1	CONVECTION STEAMER	208V 2P 2W		6			LK-8,10	3/4"C,2#8,1#10G	NON-FUSED	EC	EC
CS-2	CONVECTION STEAMER	208V 2P 2W		8			LK-2,4	3/4"C,2#6,1#10G	NON-FUSED	EC	EC
DOAS-1	ROOF TOP UNIT	208V 3P 3W		16.43	57.1	60	LK-71,73,75	1"C,3#4,1#10G	NON-FUSED	MFR	EC
DTK	DRAIN WATER TEMPERING KIT	120V 1P 2W		0.6			LK-57	3/4"C,1#12,1#12N,1#12G	JUNCTION BOX	EC	EC
DW	DISHWASHER	208V 3P 3W		18			LK-51,53,55	1"C,3#4,1#8G	NON-FUSED	EC	EC
EK	ELECTRIC KETTLE	208V 3P 3W		10.8			LK-14,16,18	3/4"C,3#8,1#10G	NON-FUSED	EC	EC
EVAP	EVAPORATOR	208V 2P 2W		0.21			LK-17,19	3/4"C,2#12,1#12G	JUNCTION BOX	EC	EC
EVAP	EVAPORATOR	208V 2P 2W		0.21			LK-21,23	3/4"C,2#12,1#12G	JUNCTION BOX	EC	EC
FRZ	FREEZER LIGHTING	120V 1P 2W		0.3			LK-15	3/4"C,1#12,1#12N,1#12G	JUNCTION BOX	EC	EC
FSS	FIRE SUPPRESSION SYSTEM	120V 1P 2W		0.12			LK-38	3/4"C,1#12,1#12N,1#12G	JUNCTION BOX	EC	EC
HC	HOT CABINET	120V 1P 2W		1.92			LK-34	3/4"C,1#12,1#12N,1#12G	DUPLEX RECEPTACLE GFI	EC	EC
HFV	HOT FOOD WELL	208V 2P 2W		2.81			LK-39,41	3/4"C,2#12,1#12G	NON-FUSED	EC	EC
HT	HEAT TAPE	120V 1P 2W		1.92			LK-25	3/4"C,1#12,1#12N,1#12G	JUNCTION BOX	EC	EC
IM	ICE MAKER	120V 1P 2W		1.62			LK-47	3/4"C,1#12,1#12N,1#12G	TOGGLE SWITCH	EC	EC
KEF-1	KITCHEN EXHAUST FAN	208V 3P 3W		2.63			LK-65,67,69	3/4"C,3#10,1#10G	NON-FUSED	EC	EC
MC	MILK COOLER	120V 1P 2W		0.33			LK-35	3/4"C,1#12,1#12N,1#12G	DUPLEX RECEPTACLE GFI	EC	EC
MW	MICROWAVE	120V 1P 2W		1.5			LK-29	3/4"C,1#12,1#12N,1#12G	DUPLEX RECEPTACLE GFI	EC	EC
POS	POINT OF SALE SYSTEM	120V 1P 2W		0.12			LK-43	3/4"C,1#12,1#12N,1#12G	JUNCTION BOX	EC	EC
RFW	REFRIGERATED FOOD WELL	120V 1P 2W		0.84			LK-37	3/4"C,1#12,1#12N,1#12G	DUPLEX RECEPTACLE GFI	EC	EC
RS-1	REFRIGERATION SYSTEM	208V 3P 3W		9.73	29	40	LK-59,61,63	3/4"C,3#10,1#10G	NON-FUSED	EC	EC
SM	STAND MIXER	120V 1P 2W	1/2 HP	1.18			LK-31	3/4"C,1#12,1#12N,1#12G	DUPLEX RECEPTACLE GFI	EC	EC
VCP	VENTILATOR CONTROL PANEL	120V 1P 2W		0.12			LK-45	3/4"C,1#12,1#12N,1#12G	JUNCTION BOX	EC	EC
VEN	VENTILATOR	120V 1P 2W		1.8			LK-42	3/4"C,1#12,1#12N,1#12G	TOGGLE SWITCH	EC	EC

Panel	ROOM	MOUNTING	RECESSED	FED FROM	MDP	VOLTS	208Y/120V 3P 4W	BUS AMPS	400	AIC	65,000	MAIN BKR	400	LUGS	STANDARD
Panel	ROOM	MOUNTING	RECESSED	FED FROM	MDP	VOLTS	208Y/120V 3P 4W	BUS AMPS	400	AIC	65,000	MAIN BKR	400	LUGS	STANDARD
LK						NEUTRAL	100%								
CKT #	CKT BKR	LOAD KVA	CIRCUIT DESCRIPTION	CKT #	CKT BKR	LOAD KVA	CIRCUIT DESCRIPTION	CONN KVA	CALC KVA	DISCONNECT	DISC PROV BY	DISC INST BY			
1	20/1	0.726	LIGHTING	2	50/2	8	CS-2								
3	20/1	0.36	RECEPTACLE	4		0									
5	20/1	0.36	RECEPTACLE	6	-/1	0	SHUNT TRIP								
7	20/1	0.36	RECEPTACLE	8	40/2	6	CS-1								
9	20/1	0.36	RECEPTACLE	10		0									
11	20/1	0.36	RECEPTACLE	12	-/1	0	SHUNT TRIP								
13	20/1	0.54	RECEPTACLE	14	40/3	10.8	EK								
15	20/1	0.6	CLR, FRZ	16		0									
17	20/2	0.208	EVAP	18		0									
19				20	-/1	0	SHUNT TRIP								
21	20/2	0.208	EVAP	22	20/1	0.18	RECEPTACLE								
23				24	-/1	0	SHUNT TRIP								
25	20/1	1.92	HT	26	20/1	1.18	CO-2								
27	20/1	0.01	TRAP PRIMER	28	-/1	0	SHUNT TRIP								
29	20/1	1.5	MW	30	20/1	1.18	CO-1								
31	20/1	1.18	SM	32	-/1	0	SHUNT TRIP								
33	20/1	0.01	TRAP PRIMER	34	20/1	1.92	HC								
35	20/1	0.325	MC	36	-/1	0	SHUNT TRIP								
37	20/1	0.84	RFW	38	20/1	0.12	FSS								
39	20/2	2.81	HFV	40	-/1	0	SHUNT TRIP								
41				42	20/1	1.8	VEN								
43	20/1	0.12	POS	44	-/1	0	SHUNT TRIP								
45	20/1	0.12	VCP	46	20/1	0.18	GAS VALVE								
47	20/1	1.62	IM	48	-/1	0	SHUNT TRIP								
49	20/1	0.01	TRAP PRIMER	50	20/1	0	SPACE								
51	70/3	18	DW	52	20/1	0	SPACE								
53				54	20/1	0	SPACE								
55				56	20/1	0	SPACE								
57	20/1	0.6	DTK	58	20/1	0	SPACE								
59	40/3	9.73	RS-1	60	20/1	0	SPACE								
61				62	20/1	0	SPACE								
63				64	20/1	0	SPACE								
65	20/3	2.63	KEF-1	66	20/1	0	SPACE								
67				68	20/1	0	SPACE								
69				70	20/1	0	SPACE								
71	60/3	16.4	DOAS-1	72	20/1	0	SPACE								
73				74	20/1	0	SPACE								
75				76	20/1	0	SPACE								
77	20														