

Construction Bulletin # 01

Client: Abla Griffin Partnership Project Name: MPS Daycare Project Number: 2450-70304-00

January 14, 2025

Requested by:___ Owner

___ Contractor:

___ Salas O'Brien:

To: Mike Abla, Clay Griffin




This Construction Bulletin is issued to:

| THIS C | oristruction bulletin is issued to. |
|----------|---|
| <u>X</u> | Offer additional information for clarification or supplemental drawings for layout |
| | assistance. |
| | Request cost and time impact to initiate a change to the Contract Documents. Owner approval is required, do not commence with revisions unless directed in writing. Avoid Work in areas that may be affected by proposed change until approved or rejected. Once approved, forward Change Order documentation as required by the Contract |
| | Documents. Direct a required change in the Contract Documents. Proceed with change(s) as |
| | indicated. Forward Change Order documentation as required by the Contract Documents. |
| | Response to RFI |
| | |

| Item No. | Description | Attachment |
|----------|----------------------------|------------|
| 1 | Refer to clouds and deltas | P001 |
| 2 | Refer to clouds and deltas | P101 |
| 3 | Refer to clouds and deltas | P110 |
| 4 | Refer to clouds and deltas | P301 |
| 5 | Refer to clouds and deltas | P601 |
| | | |

END OF CB-01

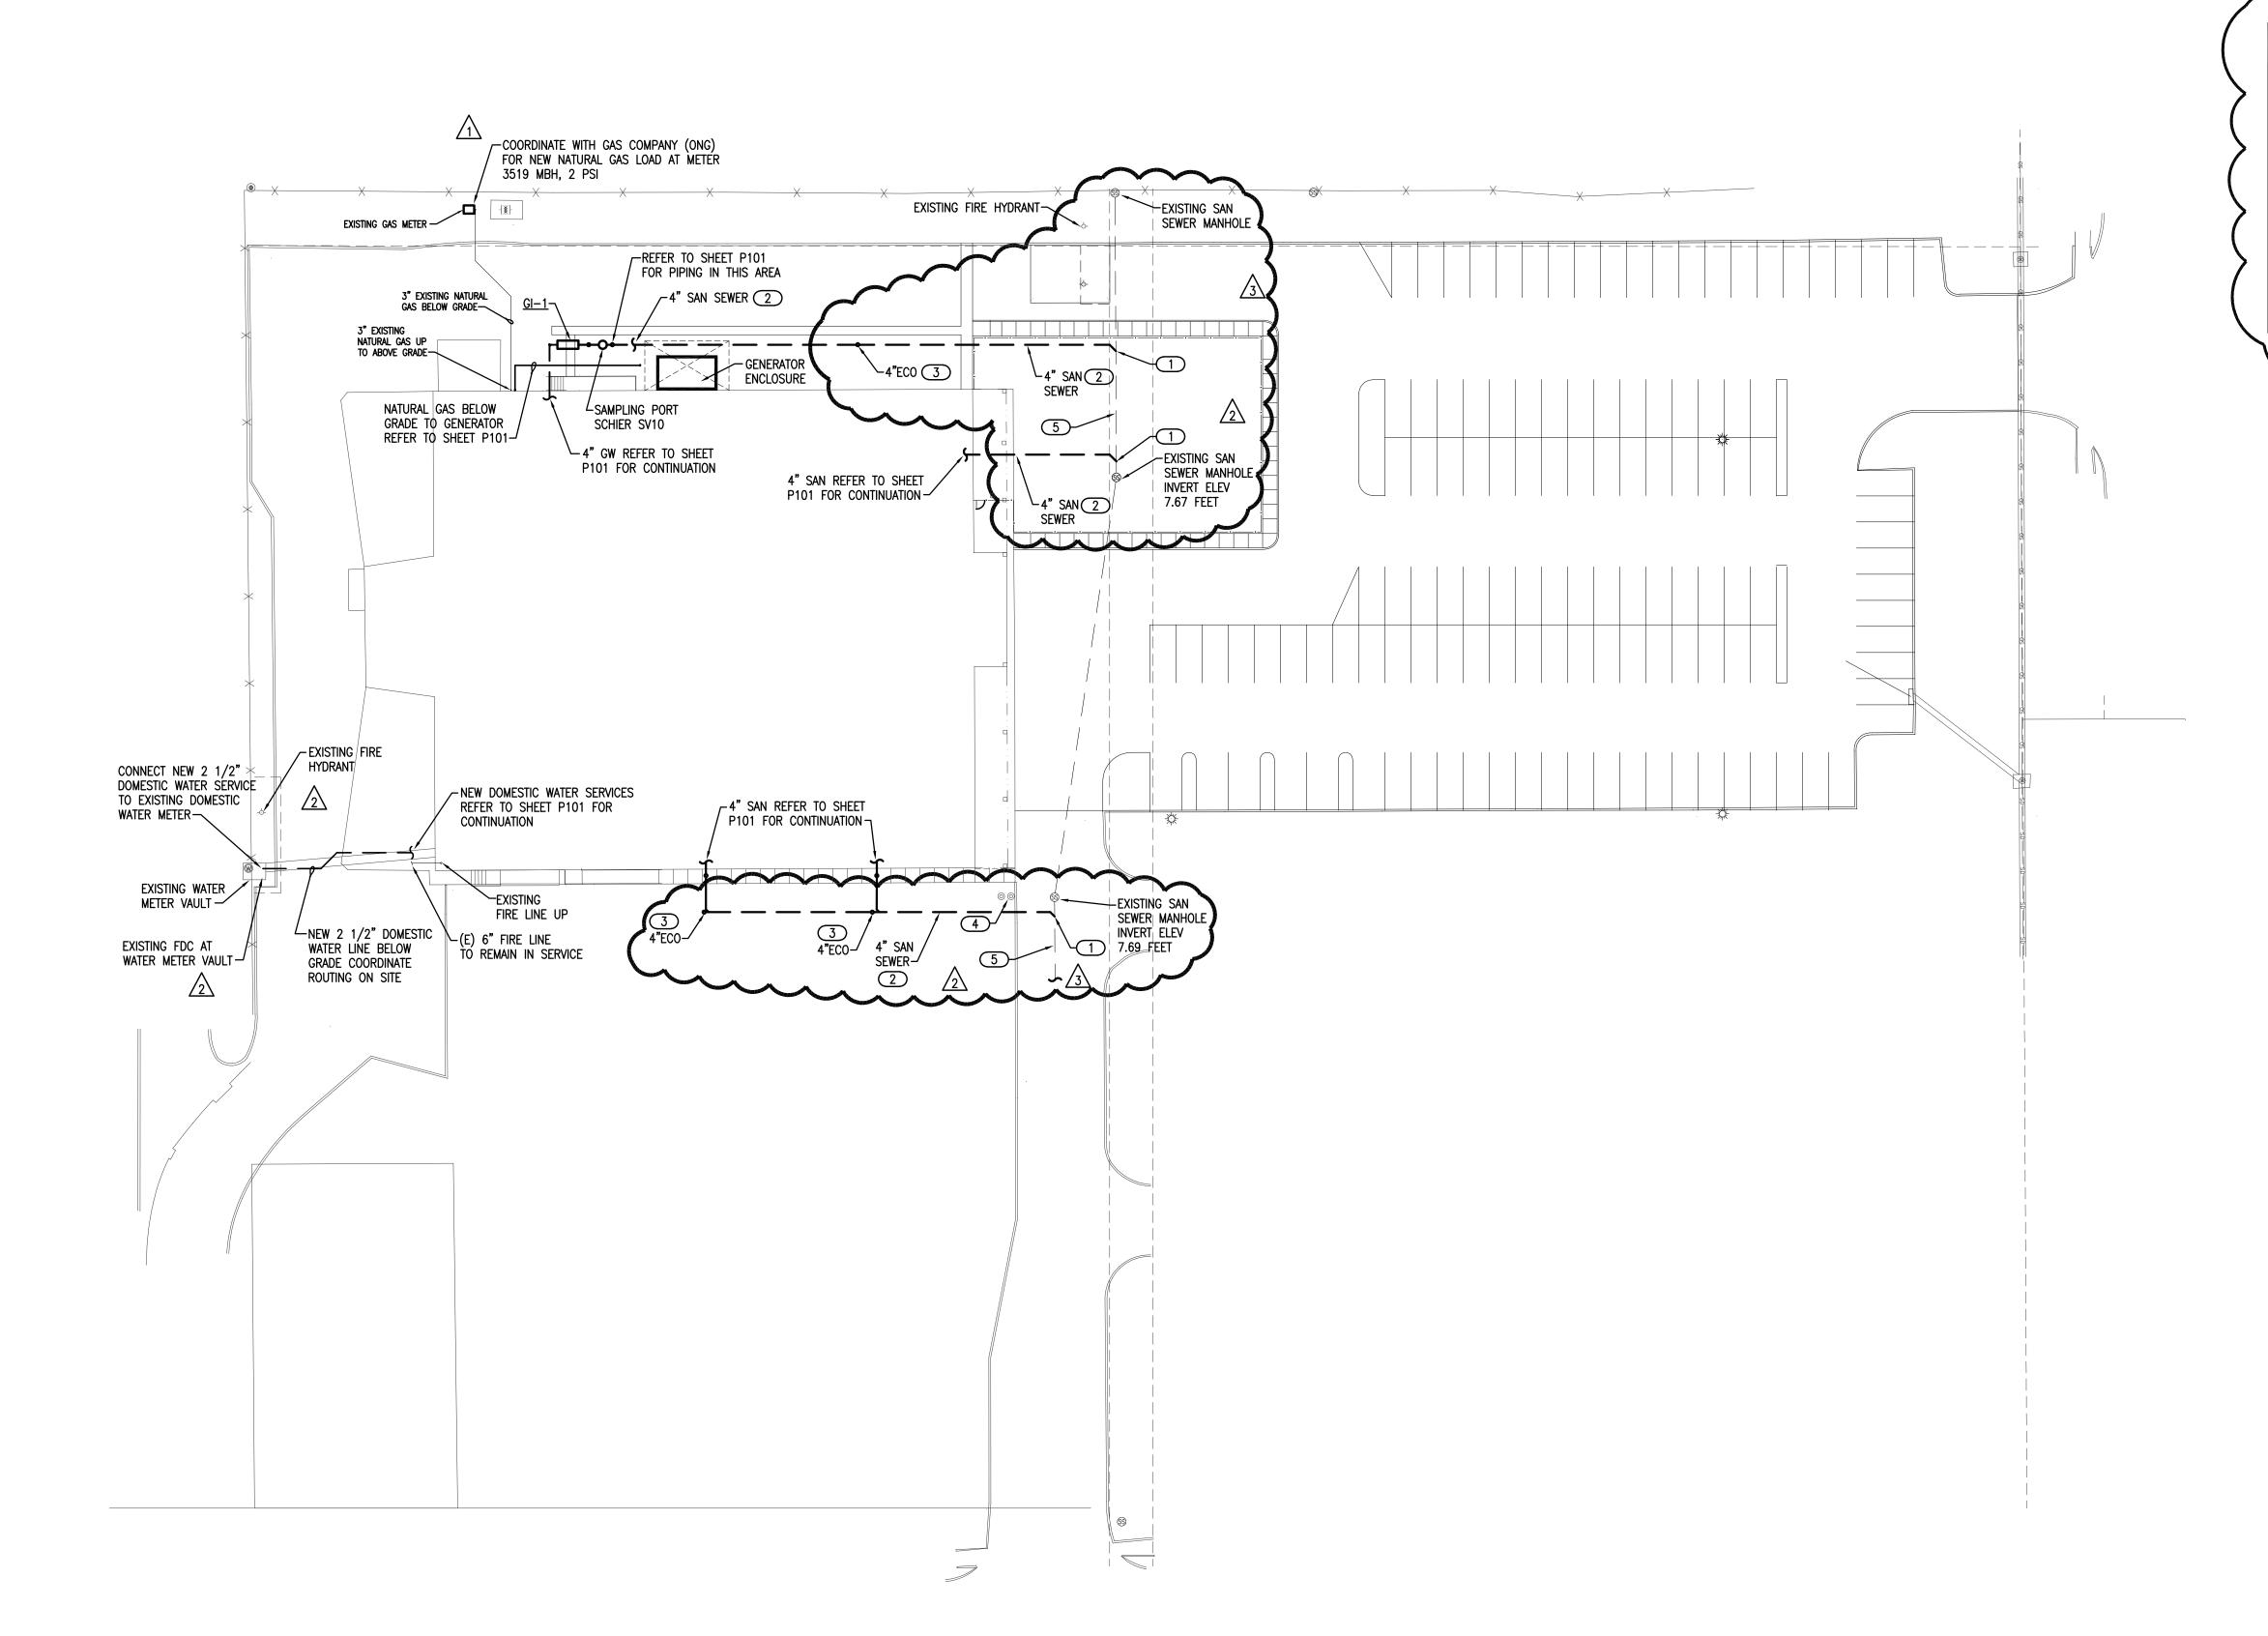

GENERAL NOTES

- COORDINATE WORK WITH ALL OTHER TRADES ON SITE.
- P. FIELD VERIFY EXISTING CONDITIONS PRIOR TO COMMENCING WORK.
- PRIOR TO COMMENCING WORK, COORDINATE WITH SITE CONTRACTOR FOR SANITARY SEWER AND WATER INVERT ELEVATIONS.
- COORDINATE ALL BELOW GRADE NATURAL GAS PIPE ROUTING WITH EXISTING SITE CONDITIONS.

KEYED NOTES

- 1 SITE CONTRACTOR TO FIELD VERIFY AND CONNECT NEW 4" SANITARY SEWER TO EXISTING SANITARY SEWER PER CITY REQUIREMENTS.
- 2 PLUMBING CONTRACTOR TO COORDINATE WITH SITE CONTRACTOR FOR INSTALLING NEW BELOW GRADE SANITARY SEWER PIPING.
- 3 PLUMBING CONTRACTOR TO COORDINATE WITH SITE CONTRACTOR FOR INSTALLING NEW EXTERIOR SEWER CLEANOUT.
- 4 COORDINATE WITH SITE CONTRACTOR FOR REMOVAL OF EXISTING GREASE WASTE PIPING, GREASE INTERCEPTOR, CLEANOUTS AND SEWER PIPING TO
- 5 SITE CONTRACTOR TO FIELD VERIFY LOCATION OF EXISTING SANITARY SEWER PIPE.

the Abla Griffin Partnership L.L.C.

> 201 N. BROADWAY SUITE 210 MOORE, OK. 73160 405.735.3477 AGP@theAGP.net www.theAGP.net

KFC ENGINEERING

STRUCTURAL

SALAS O'BRIEN MECHANICAL / ELECTRICAL



drawn by

checked by

OCTOBER 2024

11/22/2024 AD 02

12/12/2024 AD 03 3 01/14/2025 CB01


MOORE PUBLIC SCHOOLS

CHILD CARE FACILITY 201 N. EASTERN AVE.

sheet no:

P001



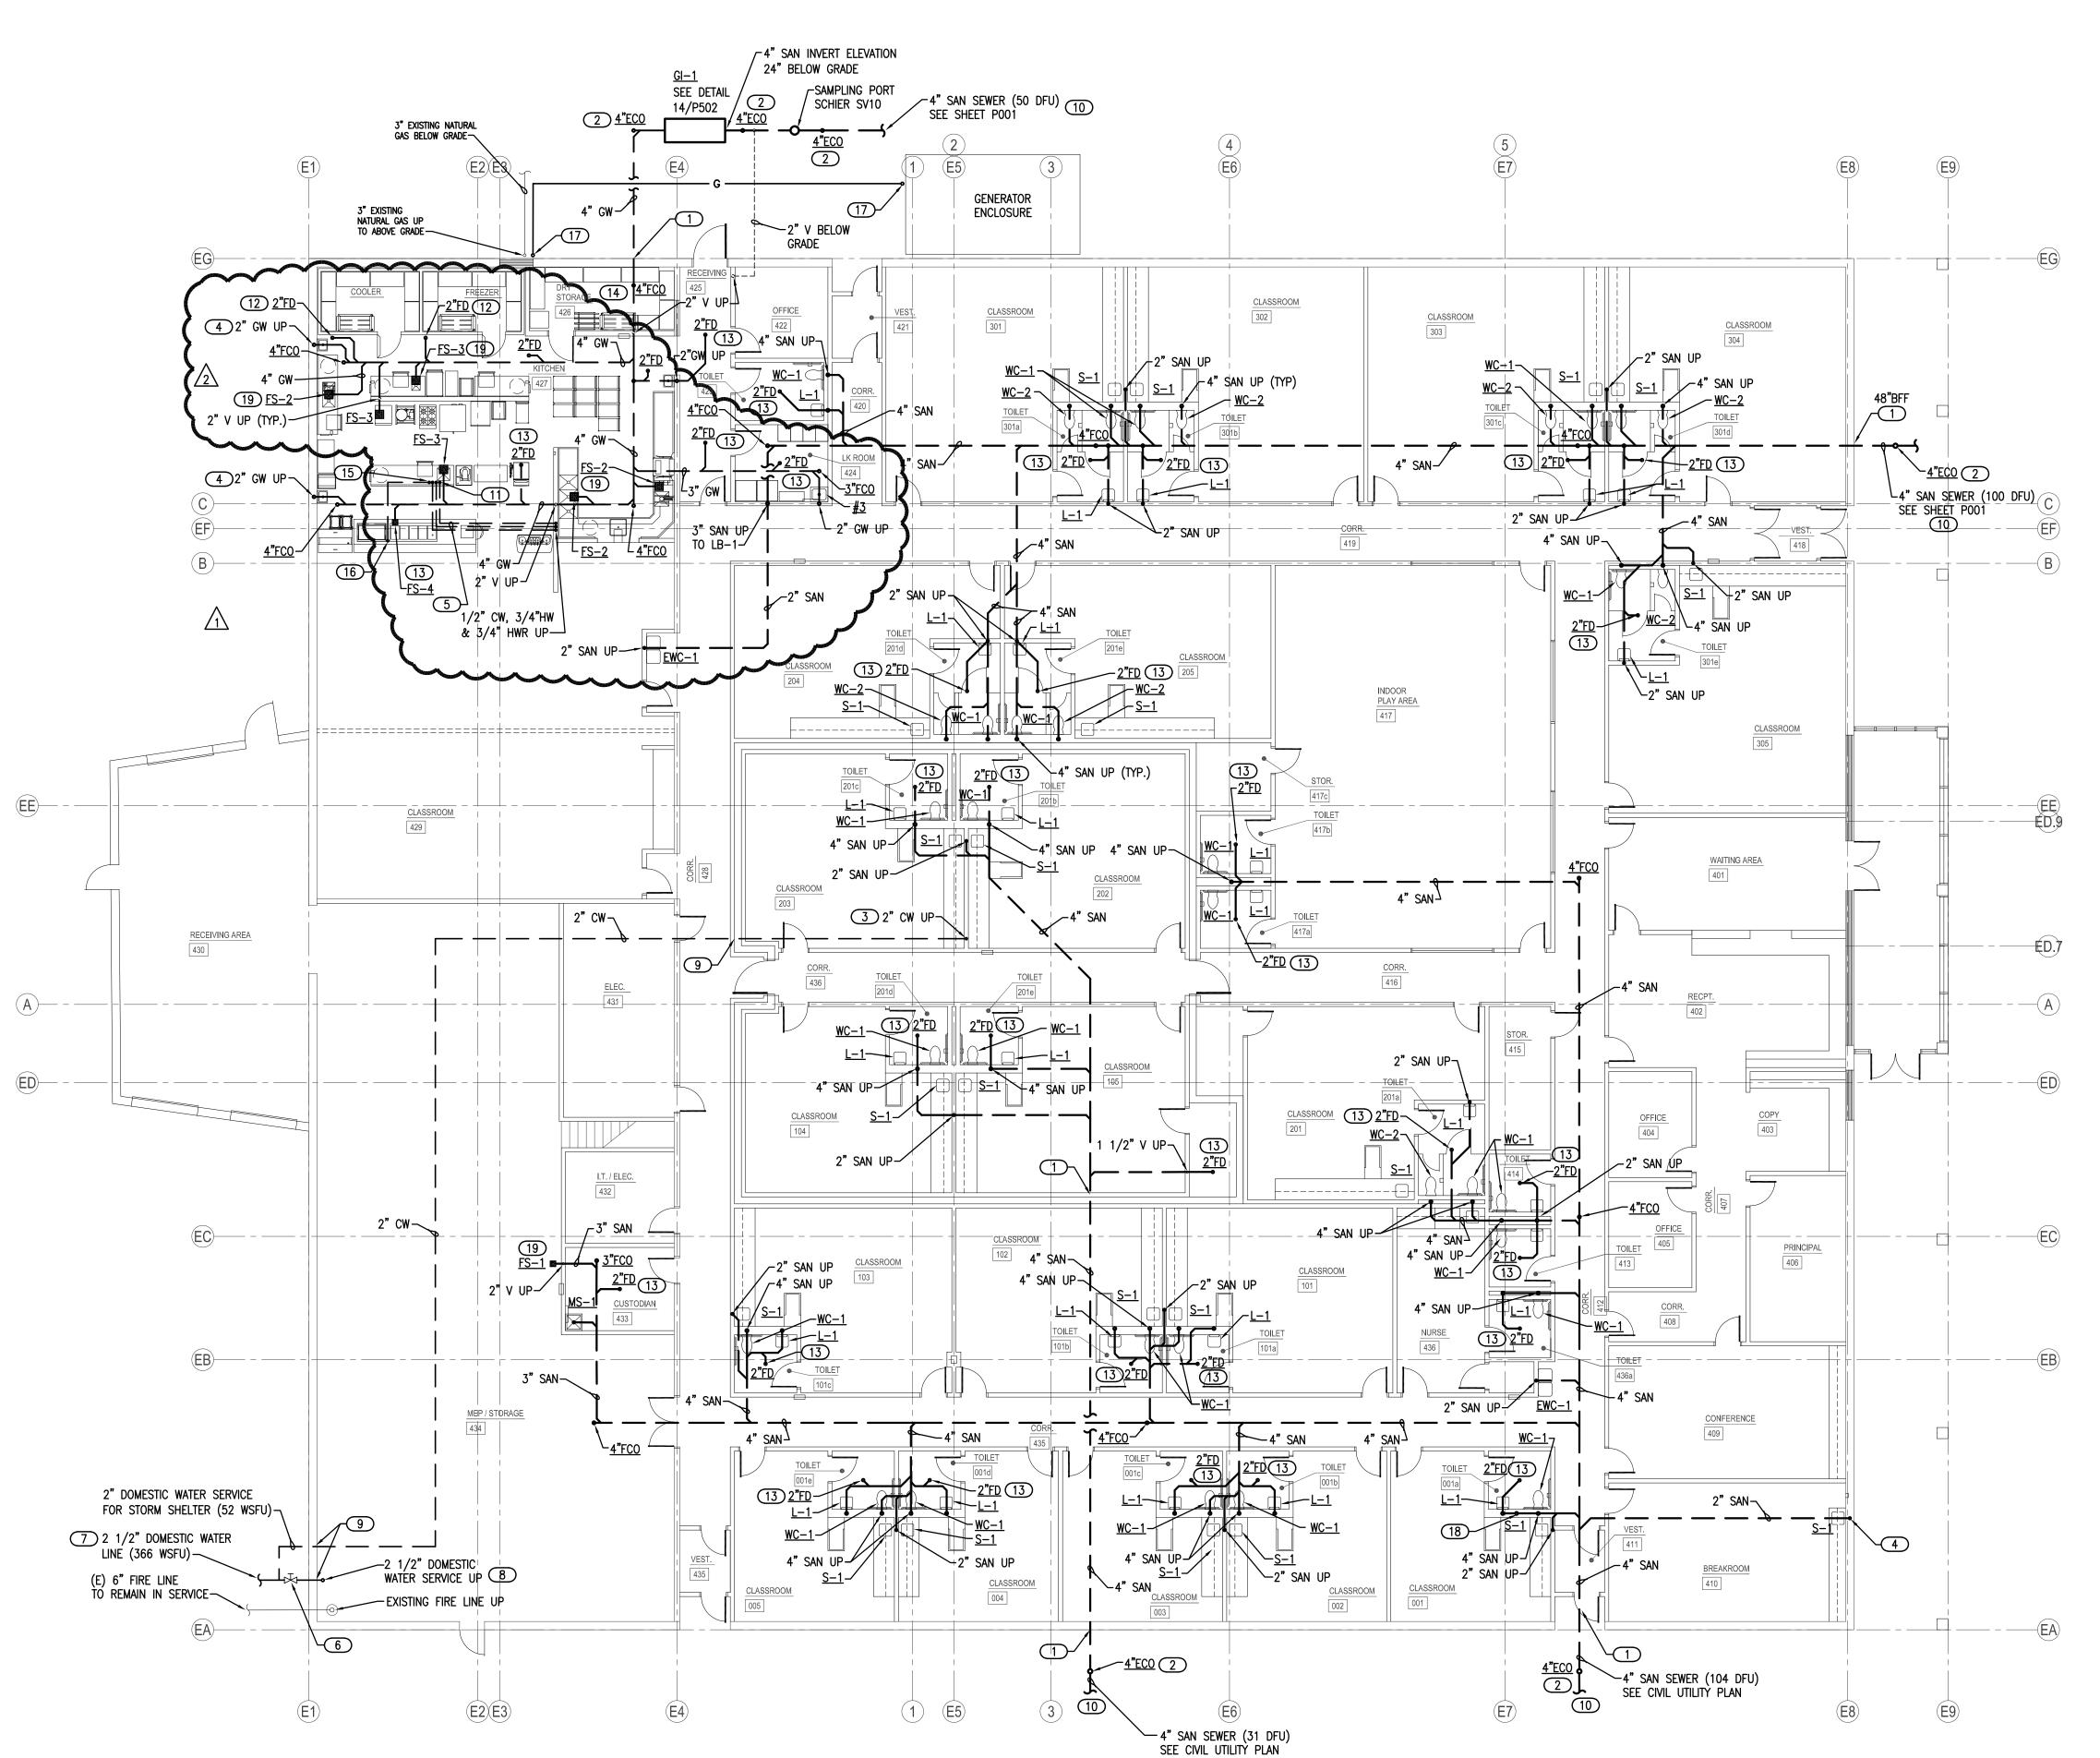

GENERAL NOTES

- . COORDINATE WORK WITH ALL OTHER TRADES ON SITE.
- 2. COORDINATE ALL BELOW GRADE PIPE ROUTING WITH STRUCTURAL FOUNDATIONS AND REQUIRED PIPE SLEEVES THRU FOUNDATION PENETRATIONS.
- . FIELD VERIFY EXISTING CONDITIONS PRIOR TO COMMENCING WORK.
- PRIOR TO COMMENCING WORK, COORDINATE WITH SITE CONTRACTOR FOR SANITARY SEWER AND WATER INVERT ELEVATIONS.
- 5. REFER TO PLUMBING FIXTURE SCHEDULE ON SHEET P601 FOR FIXTURE ROUGH—IN PIPE SIZES. REFER TO ISOMETRIC SHEETS P301 AND P302 FOR ADDITIONAL PIPE SIZES.
- . PIPE TRENCHES SHALL HAVE SAND BEDDING TO A MINIMUM POINT 6" ABOVE THE TOP OF PIPE. REFER TO SPECIFICATIONS.
- 6. TRAP PRIMER LINES SHALL BE COPPER TYPE "K" OR PEX—a TUBING WITH CONTINUOUS SLOPE TOWARDS DRAIN CONNECTION.
- COORDINATE WITH GENERAL CONTRACTOR FOR ALL REQUIRED FLOOR CUTTING AND PATCHING TO INSTALL NEW BELOW GRADE/FLOOR PIPING.
- 8. INSTALL TRAP PRIMER LINES TO ALL FLOOR DRAINS AND FLOOR SINKS. SEE DETAIL 1/P501.

KEYED NOTES

- 1 PROVIDE CAST IRON PIPE SLEEVE FOR SANITARY OR GREASE WASTE PIPE BELOW OR THRU FOUNDATION WALL OR GRADE BEAM. INSTALL FOAM SPACER BLOCKS TO MAINTAIN PIPE IN CENTER OF SLEEVE. COORDINATE PIPE SLEEVE INSTALLATION WITH STRUCTURAL.
- 2 INSTALL 4" EXTERIOR CLEANOUT IN CONCRETE PAD AT GRADE. COORDINATE INVERT ELEVATION WITH CIVIL. SEE DETAIL 4/P501.
- 3 INSTALL PVC PIPE SLEEVE THRU CONCRETE FLOOR AND STUB UP 2" AFF FOR WATER LINE. INSTALL FOAM PIPE INSULATION ON WATER LINE IN SLEEVE. SEAL SLEEVE OPENINGS WATERTIGHT.
- ROUTE 2" SANITARY OR GREASE WASTE UP INTO FUR OUT OF EXISTING CMU WALL. COORDINATE PIPE ROUTING WITH EXISTING WALL FOOTING.
- 5 ROUTE 1/2" CW, 3/4" HW AND 3/4" HWR (PEX-a TUBING) BELOW FLOOR TO COOK'S TABLE PREP SINK.
- 6 INSTALL DOMESTIC WATER CURB STOP IN NEW WATER SERVICE WITH ACCESS COVER AT GRADE.
- 7 REMOVE EXISTING BELOW GRADE 1 1/2" DOMESTIC WATER SERVICE PIPE FROM BUILDING OUT TO WATER METER CONNECTION. REPLACE WITH 2 1/2" PIPE. COORDINATE WORK WITH SITE CONTRACTOR AND CITY WATER UTILITY DEPARTMENT. SEE SHEET POO1 FOR CONTINUATION.
- 8 REMOVE EXISTING 1 1/2" DOMESTIC WATER SERVICE PIPE AND REPLACE WITH 2 1/2" PIPE. INSTALL PIPE IN PVC PIPE SLEEVE THRU CONCRETE FLOOR. INSULATE PIPE IN SLEEVE WITH CELLULAR FOAM INSULATION.
- 9 COORDINATE WITH STRUCTURAL FOR ROUTING WATER LINE IN PIPE SLEEVE THRU FOOTING OR FOUNDATION WALL IN THIS AREA.
- COORDINATE 4" SANITARY SEWER CONNECTION TO EXISTING SEWER MANHOLE WITH SITE CONTRACTOR.
- 11) ROUTE 1/2" CW, 3/4" HW AND 3/4" HWR (PEX-a TUBING) FROM BELOW FLOOR UP TO SERVE COOK'S TABLE PREP SINK. INSTALL PIPE SLEEVE AT FLOOR PENETRATION FOR WATER LINES. INSULATE WATER LINES WITH FOAM INSULATION IN SLEEVE. SEE SHEET P110 FOR CONTINUATION.
- 12 INSTALL FUNNEL FASTENED TO STRAINER FOR CONDENSATE DRAIN LINES FROM FREEZER AND COOLER. MINIMUM FUNNEL HEIGHT 3" AND TOP DIAMETER 4". PROVIDE TRAP PRIMER LINE TO FLOOR DRAIN.
- (13) INSTALL TRAP PRIMER LINE TO FLOOR DRAIN. SEE DETAIL 1/P501.
- 14 INSTALL 4" FLOOR CLEANOUT AND ROUTE 4" GREASE WASTE DOWN AND THRU EXISTING WALL FOOTING. COORDINATE ROUTING WITH STRUCTURAL.
- ROUTE 1/2" HW (PEX-a TUBING) FROM BELOW FLOOR UP TO HW LINE SERVING SINK. INSTALL PIPE SLEEVE AT FLOOR PENETRATION FOR WATER LINES. INSULATE WATER LINE WITH FOAM INSULATION IN SLEEVE
- ROUTE 1/2" HW (PEX-a TUBING) FROM BELOW FLOOR UP SERVING FOOD WELL FAUCET. INSTALL PIPE SLEEVE AT FLOOR PENETRATION FOR WATER LINES. INSULATE WATER LINE WITH FOAM INSULATION IN SLEEVE. SEE SHEET P110 FOR CONTINUATION.
- 17 INSTALL 1" NATURAL GAS (2 PSI) ANODELESS GAS RISER FOR TRANSITION FROM BELOW GRADE MDPE TUBING TO ABOVE GRADE BLACK IRON PIPE. COORDINATE LOCATION ON SITE.
- ROUTE 3" SANITARY UP TO OPEN SITE DRAIN IN CHASE FOR CONDENSATE DRAIN LINES.
- 19 ROUTE TRAP PRIMER LINE ABOVE FLOOR AND OVER FLOOR SINK WITH AIR GAP. SEE DETAIL.



201 N. BROADWAY SUITE 210 MOORE, OK. 73160 405.735.3477 AGP@theAGP.net www.theAGP.net

KFC ENGINEERING
STRUCTURAL

SALAS O'BRIEN

MECHANICAL / ELECTRICAL



KS drawn by

checked by
OCTOBER 2024

01/14/2025 CB01

MOORE PUBLIC SCHOOLS

CHILD CARE FACILITY 201 N. EASTERN AVE.

sheet no:

P101



Salas O'Brien Project Number: 2450-70304-00

Expiration Date: 6/30/2025

KEYED NOTES

(36) INSTALL 120 GALLON VERTICAL PROPANE TANK WITH SUPPORT STRAP FASTENED TO WALL. INSTALL 2-STAGE PRESSURE REGULATOR WITH VENT $\angle 2$ PIPED TO ROOF WITH GOOSENECK. ROUTE 1" PROPANE GAS LINE WITH FLEXIBLE CONNECTION TO GENERATOR. (355 MBH, 10" W.C. PRESSURE). COORDINATE CONNECTION WITH GENERATOR SUPPLIER ON SITE. PRESSURE REGULATOR LOCATED 10'-0" FROM GENERATOR CONNECTION.

(37) DUAL FUEL GENERATOR WITH AUTOMATIC SW WHEN UNIT SENSES LOSS OF NATURAL GAS PRESSURE IN FUEL INLET 1

(38) INSTALL 2" OPEN SITE DRAIN IN CHASE FOR CONDENSATE DRAIN LINES FROM RTU'S. CONNECT TO SANITARY SERVING LAVATORY. COORDINATE ROUTING WITH MC. COORDINATE WALL ACCESS PANEL WITH GC.

 $\overline{(39)}$ install 1 1/2" open site drain in sink cabinet for condensate DRAIN LINES FROM RTU'S. CONNECT TO SANITARY SERVING SINK. COORDINATE ROUTING WITH MC.

(1,303.5 MBH, 2 PSI)—

1 1/4" NG

13/P502

__2 1/2" CW

EXISTING FIRE

SPRINKLER RISER

(999.5 MBH, 2 |PSI)⊢

KEYED NOTES

32 ROUTE 1/2" CW AND 1/2" HW DOWN IN FUR OUT OF EXISTING CMU

WALL TO SERVE PREP SINK #24 PROVIDED BY FSC. COORDINATE PIPE ROUTING WITH GC. ROUGH-IN AND PROVIDE FINAL UNIT CONNECTION. 33 3/4" CW AND 3/4" HW DROPS IN WALL TO SERVE FAUCET AND HOSE REEL #13 PROVIDED BY FSC. ROUTE DRAIN LINE TO FLOOR SINK WITH

AIR GAP. ROUGH-IN AND PROVIDE FINAL UNIT CONNECTION.

- 34 CONNECT NEW 1" NATURAL GAS LINE (2 PSI) WITH LOCKABLE SHUT-OFF VALVE TO EXISTING 3" NATURAL GAS RISER AND ROUTE DOWN TO BELOW GRADE TO SERVE GENERATOR.
- 35 INSTALL 1" NATURAL GAS (2 PSI) BALL VALVE, DRIP LEG, PRESSURE REGULATOR, UNION AND FINAL 1" CONNECTION (10" W.C. PRESSURE) WITH FLEXIBLE CONNECTION TO GENERATOR. COORDINATE CONNECTION 2Δ with generator supplier on site. Pressure regulator located 10'-0" FROM GENERATOR CONNECTION.

1" NG (377 MBH, 2 PSI)

120 GAL PROPANE TANK

TIME FOR GENERATOR —

PROVIDES 2-HR RUN

-2 1/2" CW

<u>WC−2</u>

2" CW DN-

FROM BG & THRU

WALL TO SINKS—

<u>√S−1</u> 8

CHECK

6

- EXISTING 3" NG

UP WITH 2" NG

1/2" CW - LEWC-

2 1/2" CW \rightarrow \rightar

2 <u>IP-1</u>

BALL VALVE (TYP)-/___

UP TO ROOF

KEYED NOTES

- 28) 3/4" CW AND 3/4" HW DROPS IN WALL TO SERVE 2 FAUCETS AT #12 3-COMPARTMENT SINK PROVIDED BY FSC. ROUTE DRAIN LINES TO FLOOR SINK WITH AIR GAP. ROUGH-IN AND PROVIDE FINAL UNIT CONNECTION. SEE DETAIL 15/P502.
- (29) ROUTE 3/4" CW AND 3/4" HW DOWN IN WALL TO BELOW COUNTERTOP, STUB OUT, INSTALL BALL VALVES AND CONNECT TO WATER TROUGH MIXING VALVE FURNISHED BY FSC. SEE FSC SHEET FS301.
- (30) 1/2" CW AND 1/2" DOWN IN WALL TO SERVE KETTLE #35 FAUCET PROVIDED BY FSC. ROUGH-IN AND PROVIDE FINAL UNIT CONNECTION.

_2" CW

PLAY AREA

_1 1/2" HW

-1 1/2" HW

38

- GENERATOR

ENCLOSURE

<u>37</u>

1 1/4" HW

<u>₩C−1</u>

∕2" CW

1 1/2" V¬

<u>8 S−1</u>¬

<u>__1(12)</u>

<u>-L-1(7)(10)</u>

CHECK

~1/2" HWR

_3/4" CW

″_3/4" HW

(1)

-<u>₩C+2</u> 2" V¬

31) CONNECT 1/2" HW TO FAUCET AT SERVING COUNTER FOOD WELL. ROUTE 1/2" HW LINE DOWN WITH TRANSITION TO PEX TUBING TO BELOW FLOOR. ROUGH-IN AND PROVIDE FINAL UNIT CONNECTIONS.

KEYED NOTES

- 24) ROUTE 1/2" CW DOWN TO WATER FILTER AND CONNECT TO ICE MAKER #45. ROUGH-IN AND PROVIDE FINAL UNIT CONNECTION. ICE MAKER PROVIDED BY KEC. ROUTE DRAIN LINE TO FLOOR DRAIN.
- 25 INSTALL 3/4" CW DROP IN WALL TO SERVE CONVENTION STEAMER PROVIDED BY KEC. ROUTE DRAIN LINE TO FLOOR SINK WITH AIR GAP. ROUGH-IN AND PROVIDE FINAL UNIT CONNECTION.
- (26) ROUTE 1/2" CW, 1/2" HW AND 2" VENT DOWN IN WALL TO SERVE HAND SINK PROVIDED BY KEC. PROVIDE THERMOSTATIC MIXING VALVE TMV-1 AND PIPE WRAP UNDER FIXTURE. ROUGH-IN AND PROVIDE FINAL UNIT
- 27 1/2" CW AND 3/4" HW DROPS IN WALL TO SERVE DISHWASHER #11 PROVIDED BY KEC. ROUGH-IN AND PROVIDE FINAL UNIT CONNECTION. PROVIDE WATER ARRESTORS, PRV'S AND BALL VALVES ON WATER LINES IN ACCESSIBLE LOCATION. ROUTE DRAIN LINE TO FLOOR SINK.

- - - 1-1/2" CW-

<u>₩C−1</u>

L<u>L-1</u> (12)

3/4" CW-

₩+(E) FWH

 $\overline{4}$

GENERAL NOTES

PROVIDE WATER HAMMER ARRESTORS (HA) ON WATER LINES TO FLUSH VALVES, AND QUICK CLOSING VALVES. LOCATE UNITS IN ACCESSIBLE

COORDINATE WORK WITH ALL OTHER TRADES ON SITE.

- SINK AND LAVATORY WATER SUPPLY STUB OUTS SHALL BE COPPER PIPE WITH SUPPORT BRACKET FASTENED IN WALL CAVITY.
- FIRE SEAL ALL PENETRATIONS THRU RATED STRUCTURES TO MAINTAIN FIRE
- REFER TO PLUMBING FIXTURE SCHEDULE ON SHEET P601 FOR FIXTURE ROUGH-IN PIPE SIZES. REFER TO ISOMETRIC SHEETS P301 AND P302 FOR ADDITIONAL PIPE SIZES.
- PROVIDE ACCESS PANELS FOR ALL VALVES/DEVICES ABOVE HARD CEILINGS AND BEHIND WALLS.
- ALL GAS PIPE SHALL COMPLY WITH IFGC. BRANCH LINES SHALL TAP OFF TOP OF GAS MAINS AND INSTALL SHUT-OFF VALVE ON BRANCH LINE.
- TRAP PRIMER LINES SHALL BE COPPER TYPE "K" OR PEX—a TUBING WITH CONTINUOUS SLOPE TOWARDS DRAIN CONNECTION.
- FIELD VERIFY EXISTING CONDITIONS PRIOR TO COMMENCING WORK.

—EG

-£D.9

KEYED NOTES

- 1) INSTALL ELECTRIC TRAP PRIMER ASSEMBLY (TP-1) ABOVE LAY-IN CEILING IN ACCESSIBLE LOCATION. ROUTE (4) 1/2" DISCHARGE LINES TO FLOOR DRAINS IN THIS AREA. COORDINATE POWER WITH EC. SEE DETAIL 1/P501.
- 2) INSTALL ELECTRIC TRAP PRIMER ASSEMBLY (TP-1) ABOVE LAY-IN CEILING IN ACCESSIBLE LOCATION. ROUTE (3) 1/2" DISCHARGE LINES TO FLOOR DRAINS OR FLOOR SINKS IN THIS AREA. COORDINATE POWER WITH EC. SEE DETAIL 1/P501.
- 3 INSTALL ELECTRIC TRAP PRIMER ASSEMBLY (TP-1) ABOVE LAY-IN CEILING IN ACCESSIBLE LOCATION. ROUTE (2) 1/2" DISCHARGE LINES TO FLOOR DRAINS IN THIS AREA. COORDINATE POWER WITH EC. SEE DETAIL 1/P501.
- 4) FIELD VERIFY LOCATION OF EXISTING WALL HYDRANT AND CONNECT NEW 3/4" CW TO EXISTING PIPE SERVING WALL HYDRANT.
- 5 ROUTE INSULATED 2 1/2" CW PIPE DOWN WITH BALL VALVE AT 24" AFF. AND CONNECT TO NEW WATER SERVICE.
- (6) ROUTE 2" CW PIPE DOWN TO BELOW FLOOR. INSTALL ACCESS PANEL IN BACK OF CABINET FOR BALL VALVE. SEE SHEET P101 FOR CONTINUATION.
- 7 ROUTE 1/2" CW, 1/2" HW AND 1 1/2" VENT IN CHASE TO SERVE LAVATORY. INSTALL THERMOSTATIC MIXING VALVE (TMV-1) BELOW FIXTURE. SEE DETAIL 5/P501.
- (8) 1/2" CW, 1/2" HW AND 1 1/2" VENT DOWN IN WALL TO SERVE SINK. INSTALL THERMOSTATIC MIXING VALVE (TMV-1) BELOW FIXTURE. SEE DETAIL 5/P501.
- 9 1/2" CW, 1/2" HW AND 1 1/2" VENT DOWN INTO FUR OUT OF EXISTING CMU WALL TO SERVE SINK. INSTALL THERMOSTATIC MIXING VALVE (TMV-1) BELOW FIXTURE. SEE DETAIL 5/P501. COORDINATE PIPE ROUTING WITH ARCHITECT AND GC.
- 10 INSTALL TRAP PRIMER (TP-2) UNDER LAVATORY. INSTALL PER MANUFACTURER'S RECOMMENDATIONS. SEE DETAIL 11/P501.
- (11) COORDINATE WITH STRUCTURAL FOR DEBRIS GUARD BELOW SHELTER ROOF FOR PLUMBING VENT ROOF PENETRATION.
- 12 1/2" CW, 1/2" HW AND 1 1/2" VENT DOWN IN WALL TO SERVE LAVATORY. INSTALL THERMOSTATIC MIXING VALVE (TMV-1) BELOW FIXTURE. SEE DETAIL 5/P501.
- 13) 3/4" CW UP TO ROOF HYDRANT. SEE SHEET P201 FOR CONTINUATION.
- 14) ROUTE 1/2" CW, 3/4" HW AND 3/4" HWR DOWN IN WALL WITH PEX TUBING TO BELOW FLOOR TO SERVE ISLAND PREP SINK.
- 15) ROUTE 1" NG (LOW PRESS) BEHIND EQUIPMENT AND PROVIDE 3/4" GAS TO KITCHEN EQUIPMENT (33 & 34) PROVIDED BY KEC. PROVIDE SHUT-OFF VALVE AND FINAL UNIT CONNECTION. SEE DETAIL 9/P501.
- 16) ROUTE 1/2" CW, 1/2" HW AND 2" VENT IN FUR OUT OF EXISTING CMU WALL TO SERVE HAND SINK (#8) PROVIDED BY KEC. PROVIDE THERMOSTATIC MIXING VALVE TMV-1 AND PIPE WRAP UNDER FIXTURE.
- 17 CONNECT NEW 1 1/4" NATURAL GAS LINE (2 PSI) TO EXISTING 3" NATURAL GAS RISER AND ROUTE NEW LINE INTO BUILDING.

COORDINATE PIPE ROUTING WITH GC.

- 18) ROUTE 3/4" CW DOWN IN WALL WITH TRANSITION TO PEX TUBING TO BELOW FLOOR TO SERVE ICE MAKER PROVIDED BY KEC. ROUGH-IN AND PROVIDE FINAL UNIT CONNECTION.
- 19 INSTALL 3/4" NATURAL GAS (2 PSI) BALL VALVE AND PRESSURE REGULATOR (KITCHEN EQUIP). INSTALL GAS SOLENOID VALVE FURNISHED BY KITCHEN EQUIPMENT SUPPLIER AND COORDINATE POWER WITH EC TO INTERLOCK WITH EXHAUST HOOD FIRE SUPPRESSION SYSTEM. ROUTE 1" NG (LOW PRESS) TO KITCHEN EQUIPMENT.
- 20 ROUTE 1/2" CW, 3/4" HW AND 3/4" HWR UP FROM BELOW FLOOR, TRANSITION TO COPPER PIPE AND CONNECT TO COOK'S TABLE SINK PROVIDED BY KEC. ROUGH-IN AND PROVIDE FINAL UNIT CONNECTION.
- (21) INSTALL 1/2" BALL VALVE AND PRESSURE REGULATOR IN NATURAL GAS LINE SUPPLYING DRYER #6. PROVIDE 1/2" LOW PRESSURE GAS DOWN IN WALL TO GAS VALVE BOX (GVB-1) AND FLEXIBLE CONNECTION TO UNIT.
- 22 CLOTHES WASHER FURNISHED BY OTHERS. ROUGH—IN AND MAKE FINAL CONNECTION. PROVIDE 1/2" CW AND 1/2" HW LINES DOWN IN WALL TO LAUNDRY BOX. CONNECT FLEXIBLE SUPPLY LINES TO WASHER. ROUTE WASHER DRAIN LINE INTO WALL BOX DRAIN FITTING AND SECURE. COORDINATE WITH EQUIPMENT SUPPLIER.
- 23) COORDINATE WITH FOOD SERVICE CONTRACTOR FOR ROUTING CONDENSATE DRAIN LINES TO FLOOR DRAIN FROM FREEZER OR COOLER. SEE SHEET

AGP@theAGP.net www.theAGP.net

the Abla Griffin

Partnership L.L.C.

201 N. BROADWAY

SUITE 210

MOORE, OK. 73160

405.735.3477

KFC ENGINEERING STRUCTURAL

> SALAS O'BRIEN MECHANICAL / ELECTRICAL



drawn by


checked by

OCTOBER 2024

 $1 \ 11/22/2024 \text{ AD } 02$

12/12/2024 AD 03

3 01/14/2025 CB01

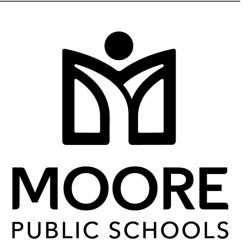

CHILD CARE FACILITY 201 N. EASTERN AVE.

sheet no:



OWNERSHIP USE OF DOCUMENTS: Salas O'Brien AGP EXPRESSLY RESERVES ITS


Moore, OK 73160 Salas O'Brien Registration: CA# 7058 Expiration Date: 6/30/2025

5

RECEIVING AREA

(EC)—

(EA)-

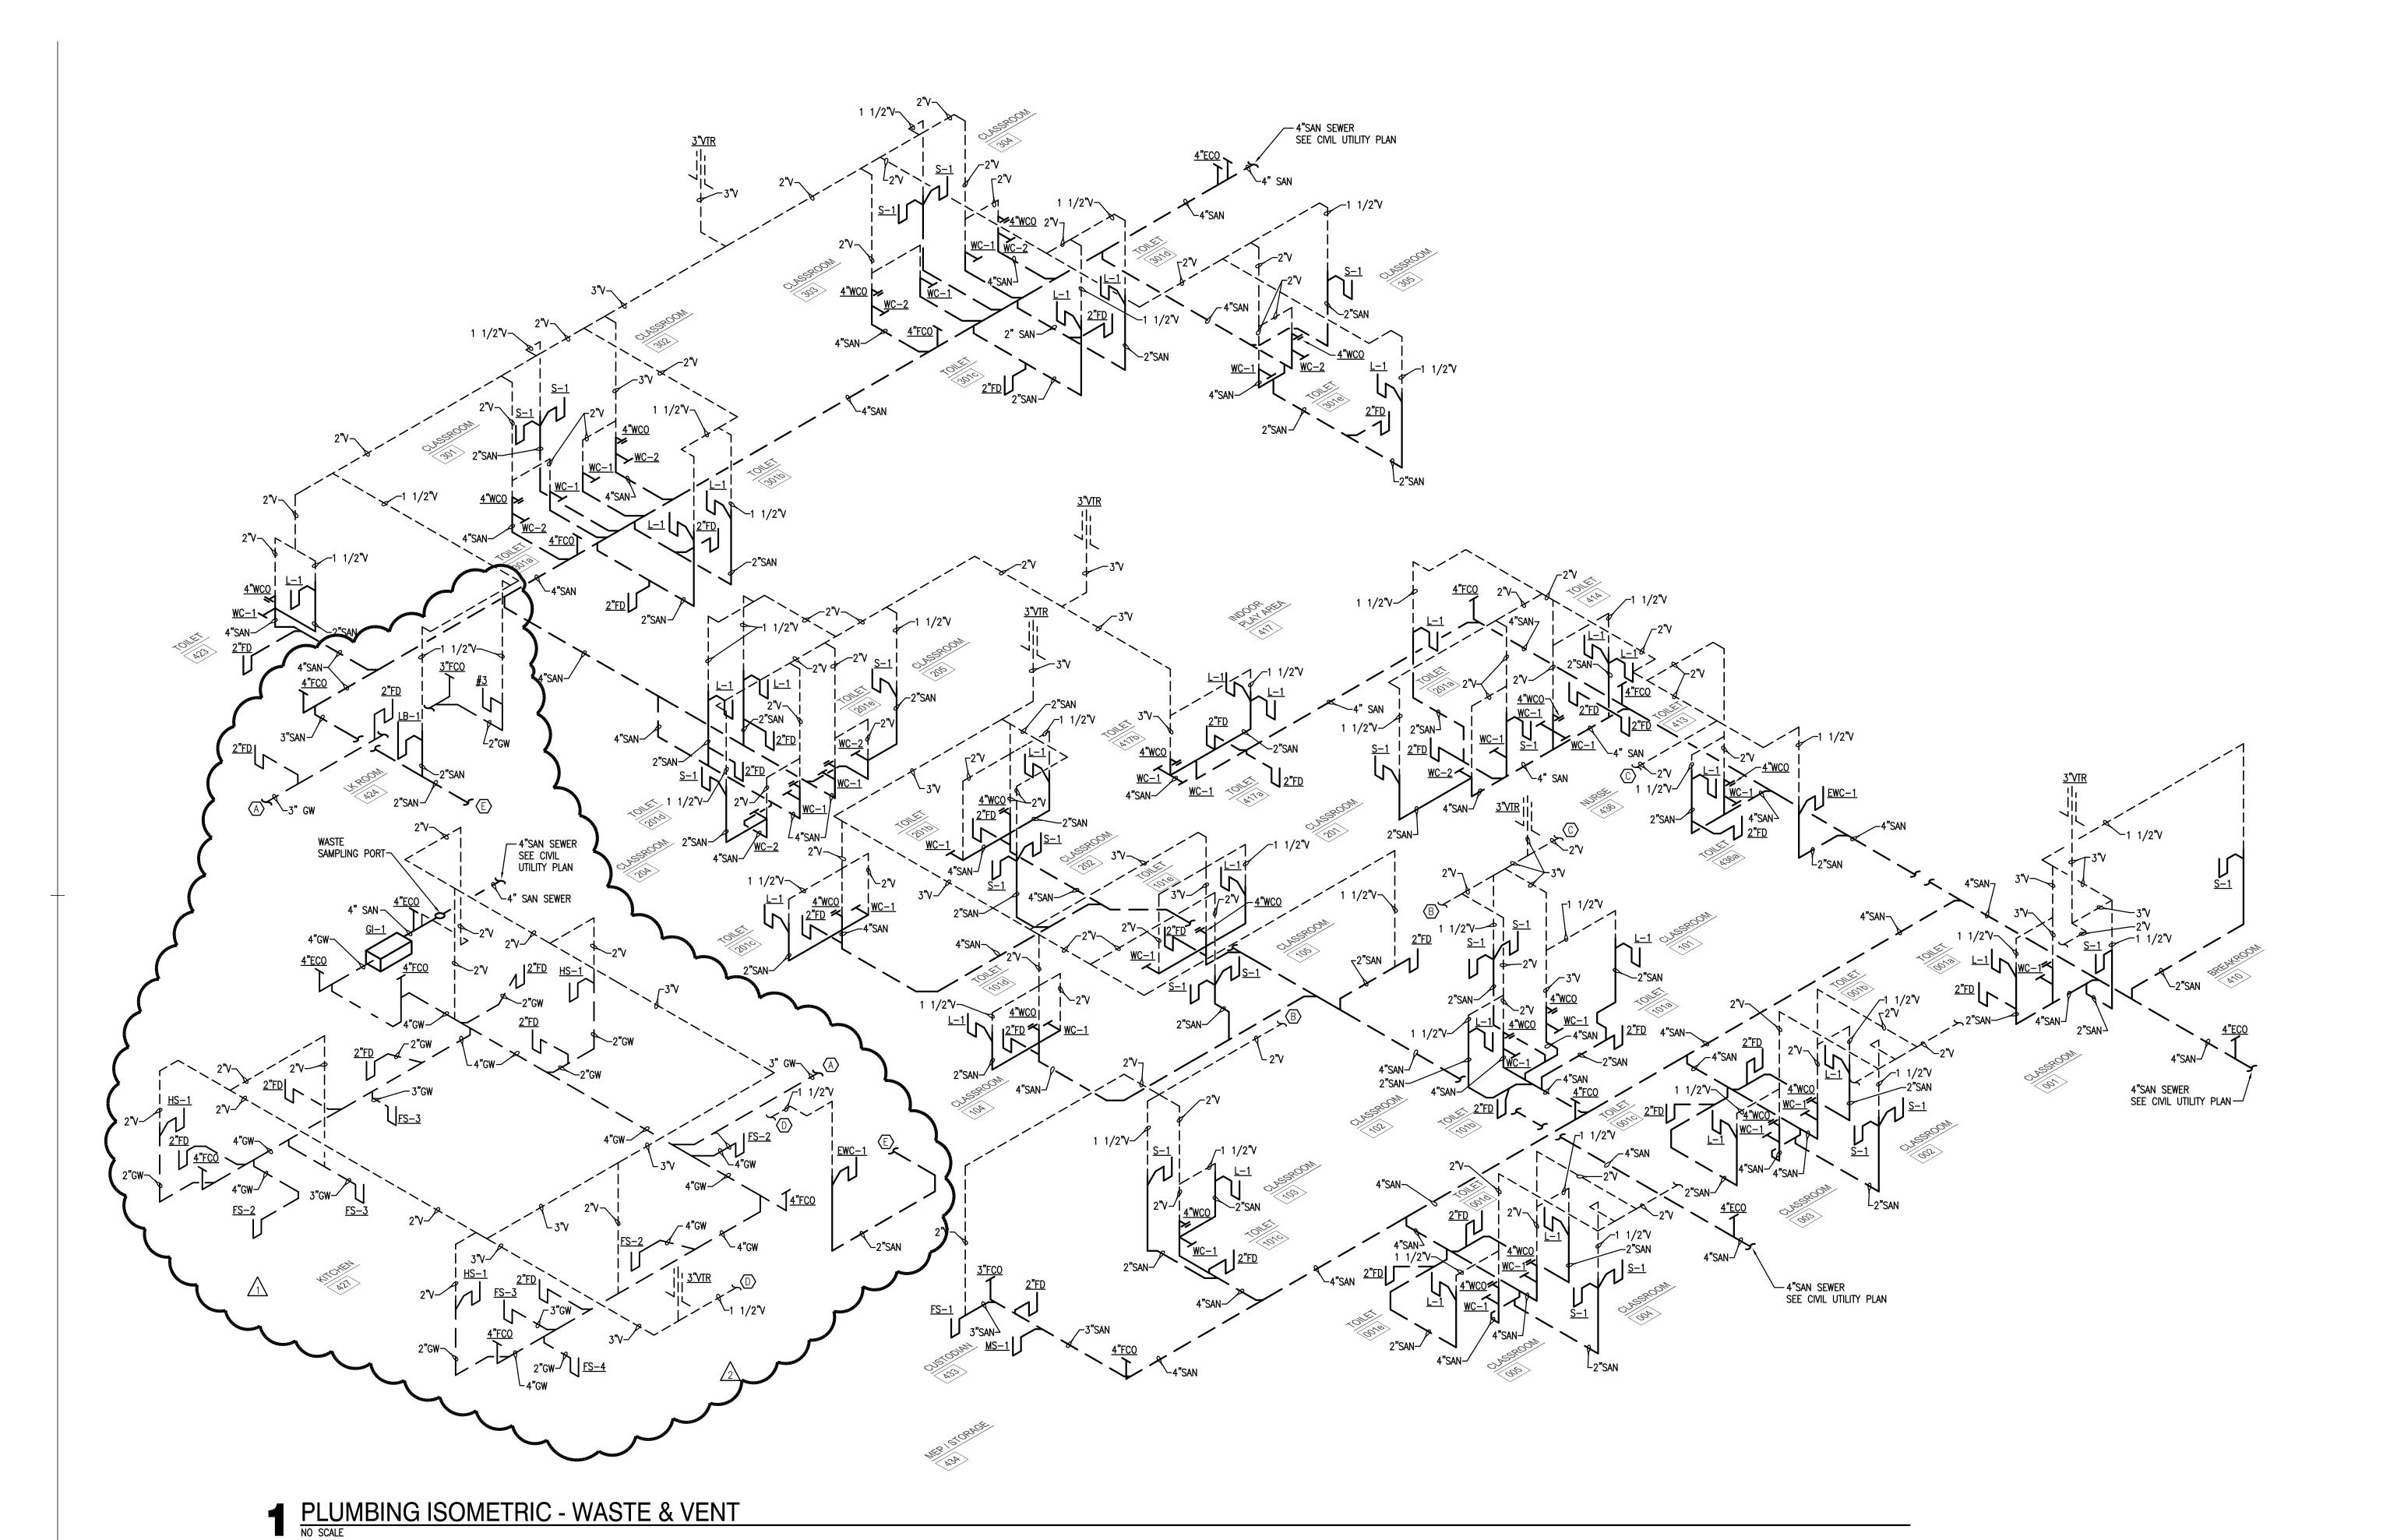

AGP
the Abla Griffin
Partnership L.L.C.

201 N. BROADWAY SUITE 210 MOORE, OK. 73160 405.735.3477 AGP@theAGP.net www.theAGP.net

KFC ENGINEERING

STRUCTURAL

SALAS O'BRIEN

MECHANICAL / ELECTRICAL



KS
drawn by
KP
checked by

revisions

11/22/2024 AD 02

01/14/2025 CB01

OCTOBER 2024 date

MOORE PUBLIC SCHOOLS

CHILD CARE FACILITY 201 N. EASTERN AVE.

she

P301



OWNERSHIP USE OF DOCUMENTS:

AGP EXPRESSLY RESERVES ITS
COPYRIGHT AND OTHER PROPERTY
RIGHTS OF ALL PLANS AND DRAWINGS
DESIGNED AND/OR PRODUCED. PLANS
AND DRAWINGS ARE NOT TO BE
REPRODUCED IN ANY FORM OR MANNER

WITHOUT THE EXPRESSED WRITTEN CONSENT OF AGP.

| | | GAS L | OAD TABLE | : | |
|---------------|----------------|----------------------|-----------------------|--------------------|---------|
| <u>-</u> | INPUT (MBH) | REQUIRED PRESSURE | REQUIRED REGULATOR | SYSTEM PRESSURE | NOTES |
| RTU-1 | 65 | 7" | MAXITROL 325-3LB | 2 PSI | 1,3,4,5 |
| RTU-2 | 108 | 7" | MAXITROL 325-3LB | 2 PSI | 1,3,4,5 |
| RTU-3 | 65 | 7" | MAXITROL 325-3LB | 2 PSI | 1,3,4,5 |
| RTU-4 | 108 | 7" | MAXITROL 325-3LB | 2 PSI | 1,3,4,5 |
| RTU-5 | 180 | 7" | MAXITROL 325-5LB | 2 PSI | 1,3,4,5 |
| RTU-6 | 65 | 7" | MAXITROL 325-3LB | 2 PSI | 1,3,4,5 |
| RTU-7 | 180 | 7" | MAXITROL 325-5LB | 2 PSI | 1,3,4,5 |
| RTU-8 | 180 | 7" | MAXITROL 325-5LB | 2 PSI | 1,3,4,5 |
| RTU-9 | 108 | 7" | MAXITROL 325-3LB | 2 PSI | 1,3,4,5 |
| RTU-10 | 108 | 7" | MAXITROL 325-3LB | 2 PSI | 1,3,4,5 |
| RTU-11 | 180 | 7" | MAXITROL 325-5LB | 2 PSI | 1,3,4,5 |
| RTU-12 | 108 | 7" | MAXITROL 325-3LB | 2 PSI | 1,3,4,5 |
| RTU-13 | 180 | 7" | MAXITROL 325-5LB | 2 PSI | 1,3,4,5 |
| RTU-14 | 65 | 7" | MAXITROL 325-5LB | 2 PSI | 1,3,4,5 |
| RTU-15 | 65 | 7" | MAXITROL 325-3LB | 2 PSI | 1,3,4,5 |
| RTU-16 | 65 | 7" | MAXITROL 325-3LB | 2 PSI | 1,3,4,5 |
| DOAS-1 | 208 | 7" | MAXITROL 325-5LB | 2 PSI | 1,3,4,5 |
| WH-1 | 199.9 | 7" | MAXITROL 325-5L | 2 PSI | 1,2,5 |
| WH-2 | 199.9 | 7" | MAXITROL 325-5L | 2 PSI | 1,2,5 |
| WH-3 | 199.9 | 7" | MAXITROL 325-5L | 2 PSI | 1,2,5 |
| WH-4 | 199.9 | 7" | MAXITROL 325-5L | 2 PSI | 1,2,5 |
| KITCHEN | 254 | 10" | MAXITROL 325-5L | 2 PSI | 1,2,5 |
| DRYER | 50 | 7" | MAXITROL 325-3L | 2 PSI | 1,2,5 |
| GEN SET | 377 | 10" | MAXITROL 325-5L | 2 PSI | 1,2,5 |
| TOTAL LOAD | 3519 MBH | | | | |

- INSTALL AND VENT REGULATOR PER MANUFACTURER'S RECOMMENDATIONS. PROVIDE VENT LIMITING DEVICE FOR INDOOR REGULATORS EQUIPPED WITH INTEGRAL VENT LIMITING ORIFICE MODEL 12A09 OR 12A39.
- COORDINATE WITH MECHANICAL CONTRACTOR FOR EQUIPMENT LOCATIONS AND REQUIRED CONNECTION. PROVIDE VENT PROTECTOR DEVICE FOR OUTDOOR REGULATORS MODEL
- 13A15 OR 13A15-5. GAS SYSTEM DESIGN FOR INITIAL METER OUTLET PRESSURE OF 2 PSIG WITH PRESSURE DROP OF 1 PSIG AND TOTAL LENGTH OF 450 FEET.

| PL | UMBING P | TICHE | N EQUI | PIVIEN | 11 50 | HEDU | /LE |
|------|---------------------------|-------------------|-----------------|--------|----------|----------|----------------|
| ITEM | DESCRIPTION | INDIRECT DRAIN | DIRECT DRAIN | VENT | CW | HW | GAS |
| 3 | MOP SINK | - | 2" | 1 1/2" | 1/2" | 1/2" | _ |
| 5 | WASHER BY OWNER | - | 2" | 1 1/2" | 1/2" | 1/2" | _ |
| 6 | DRYER BY OWNER | - | - | - | - | - | 1/2 50 M |
| 8 | HAND SINK | - | 2" | 1 1/2" | 1/2" | 1/2" | _ |
| 11 | DISHWASHER | 2" | _ | - | 1/2" | 1/2" | _ |
| 12 | SOILED DISHTABLE | (3) 2" | _ | - | (2) 3/4" | (2) 3/4" | _ |
| 13 | HOSE REEL | - | - | - | 1/2" | 1/2" | - |
| 14 | WATER TROUGH | 2" | - | - | 3/4" | 3/4" | _ |
| 24 | PREP TABLE | 2" | - | - | 1/2" | 1/2" | - |
| 25 | FOOD ALLERGY WORKTABLE | 2" | _ | - | 1/2" | 1/2" | _ |
| 33 | CONVECTION OVEN | - | - | - | - | - | (2) 3, 55 M |
| 34 | RANGE | - | _ | - | - | _ | 3/4 144 M |
| 35 | KETTLE | - | _ | _ | 1/2" | 1/2" | - |
| 36 | CONVECTION STEAMER | (2) 3/4" | - | - | 3/4" | - | _ |
| 41 | COOKS TABLE SINK | 2" | _ | - | 1/2" | 1/2" | - |
| 45 | ICEMAKER | 3/4" | _ | - | 1/2" | - | _ |
| 47 | MILK COOLER | 3/4" | _ | - | - | - | _ |
| 48 | SERVING COUNTER | - | _ | - | 1/2" | - | _ |
| 49 | COLD FOOD WELL | 3/4" | _ | - | - | - | _ |
| 51 | HOT FOOD WELL | 3/4" | - | _ | _ | 1/2" | _ |

EQUIPMENT LISTED PROVIDED BY FOOD SERVICE CONTRACTOR (FSC). COORDINATE WITH FSC FOR

REQUIRED CONNECTIONS.

| 2 | 150 PSI | 225 | 115/60/1 | 3.5 | 1/6 | VARIES | 3/4" | 5.5 | ٠. | | |
|---|--|------------------|----------|------|-------------------------|----------|-------------------|------------------|--------------|---|--|
| CP 3 | 150 PSI | 225 | 115/60/1 | 3.5 | 1/6 | VARIES | 3/4" | S.S | ò. | | |
| 2. DA 3. DA 4. DA 5. PR 6. CO | PROVIDE GRUNDFOS BRONZE 3/4" FLANGE SET. DATA: CP-1: 0.5 GPM AT 10 FEET HEAD. DATA: CP-2: 1.5 GPM AT 8 FEET HEAD. DATA: CP-3: 1 GPM AT 10 FEET HEAD. PROVIDE 24 HOUR TIMER AND AQUASTAT - SET TIMER PER OWNER'S REQUIREMENTS. COORDINATE WIRING WITH E.C. | | | | | | | | | | |
| | | GR | EASE | INTE | RCEP | TOR S | SCHI | EDU | LE | | |
| MARK | LOCATION | FLOW RA (GPM) | | | STANDARI) CONNECTIO | <i>-</i> | N) ZNOIS WIDTH | ICHES) HEIGHT | WEIG (LBS | | |
| G | FXTFRIOR | | | | | | | | | _ | |

| | GREASE INTERCEPTOR SCHEDULE | | | | | | | | | | |
|---------|-----------------------------|--------------------|----------------------|---------------------|------------------------|------------------|--------------------|------------------|--------------|-----------------------------|-------|
| MARK | LOCATION | FLOW RATE (GPM) | LIQUID CAP. (GAL) | GREASE CAP.(LBS) | STANDARD CONNECTION | DIMENS LENGTH | SIONS (II WIDTH | NCHES) HEIGHT | WEIGHT (LBS) | MANUFACTURER & MODEL NO. | NOTES |
| GI 1 | EXTERIOR BELOW GRADE | 100 | 277 | 1,865 | 4" | 87 | 33 | 44 | 376 | SCHIER GB-250 | ALL |
| NOTES: | | | | | | | | | | | |

- INSTALL EXTERIOR BELOW GRADE GREASE INTERCEPTOR SO COVERS ARE FLUSH WITH FINISHED CONCRETE. PROVIDE
- INSTALL GREASE INTERCEPTOR WITH REQUIRED CLEARANCES FOR ACCESS AND CLEANING.
- PROVIDE SAMPLING PORT SCHIER SV10 WITH EXTENSION RISER DOWNSTREAM OF INTERCEPTOR PER MANUFACTURER'S
- RECOMMENDATIONS. SEE DETAIL 14/P502 FOR ADDITIONAL INFORMATION.

GREASE INTERCEPTOR SIZING

FIXTURES DRAINING TO GREASE INTERCEPTOR:

HANDSINKS: 3 FIXTURES X 1.5 GPM = 4.5 GPM

18" x 18" x 12" = 3,888 CU INCHES / 231 x 75% = 13 GALLONS

 $12" \times 15" \times 10" = 1,800 \text{ CU INCHES } / 231 \times 75\% = 6 \text{ GALLONS}$

DISHWASHER: 36 GALLONS

PREP DOUBLE SINK: $18" \times 18" \times 14" = 4,536$ CU INCHES x 2 / 231 x 75% = 30 GALLONS

FLOOR SINKS / FLOOR DRAINS WITH 2" OUTLET: 5 FIXTURES: 2 GPM \times 5 = 10 GPM

 $18" \times 18" \times 10" = 3,240 \text{ CU INCHES } / 231 \times 75\% = 10.5 \text{ GALLONS}$

| ı | MOP | ' ` | MK: | | | | | | | | | | | | | | | | | |
|---|------|------------|-------|----|-------|------|-----------------|----|-----|------|-----|-----|------|-----------|---|---|-----|-------|-----|----------|
| ı | 16" | Х | 20" | х | 12" | = | 3.8 | 40 | CU | INCH | IES | / 2 | 31 × | < 75% | = | 1 | 2.5 | GAI | LON | 1S |
| ı | ` ` | • | | • | | | 0,0 | | • • | | | / - | · , | . , . , . | | • | | 0, 10 | | |
| ı | тот | A 1 | D D 4 | | EL 01 | ., - |) E D | ^ | | ITEO | | 477 | 0.41 | | , | _ | | | 00 | 04110410 |
| ı | 101/ | ٩L | DRA | IN | FLOV | ٧H | ² EK | 2 | MIN | JIF2 | = | 1// | GAL | LONS | / | 2 | MIN | = | 89 | GALLONS |
| | | | | | | | | | | | | | | | | | | | | |

| | | | | | | | | | | _ | | |
|---|---------------------------|------------------------|----------------------|-----------------------|-------|---------------|-----------------|-----------------------------|-------|---|------|--|
| | GAS WATER HEATER SCHEDULE | | | | | | | | | | | |
| MARK | LOCATION | TEMPERATURE RISE | FLOW RATE GAL/MIN | CAPACITY (GALLONS) | | AIR INTAKE | FLUE EXHAUST | MANUFACTURER & MODEL NO. | NOTES | | | |
| WH 1 | MEP/STORAGE RM 434 | (50°F – 120°F) 70°F | 5 | TANKLESS | 199.9 | 2" | 2" | NAVIEN NPE-240A | ALL | | MARK | |
| WH MEP/STORAGE RM 434 (50°F - 120°F) 70°F 5 TANKLESS 199.9 2" 2" NAVIEN NPE-240A ALL | | | | | | | | | | | | |
| WH 3 | MEP/STORAGE RM 434 | (50°F – 120°F) 70°F | 5 | TANKLESS | 199.9 | 2" | 2" | NAVIEN NPE-240A | ALL | | WO 4 | |
| WH 4 | MEP/STORAGE RM 434 | (50°F – 120°F) 70°F | 5 | TANKLESS | 199.9 | 2" | 2" | NAVIEN NPE-240A | ALL | | WC-1 | |
| WH 5 | MEP/STORAGE RM 434 | (50°F – 120°F) 70°F | 5 | TANKLESS | 199.9 | 2" | 2" | NAVIEN NPE-240A | ALL | | WC-2 | |
| OTES: INSTALL AND VENT PER MANUFACTURER'S RECOMMENDATIONS. COORDINATE POWER SUPPLY WITH ELECTRICAL CONTRACTOR. POWER SUPPLY TO UNIT 120V, 2 AMP (GFCI OUTLET). PROVIDE AMTROL ST—12 THERMAL EXPANSION TANK ON COLD WATER LINE. REFER TO DETAILS SHEET P501. | | | | | | | | | | | | |
| . PROVIDE CLEAR WATER ENVIRO TECHNOLOGIES SCALEBLASTER MODEL SB-250 ELECTRONIC DESCALER. COORDINATE 120 VOLT OUTLETS WITH EC PROVIDE CIRCULATION PUMP WIRING FROM WATER HEATERS. COORDINATE POWER CONNECTIONS WITH EC PROVIDE NAVIEN CONDENSATE NEUTRALIZER KIT AND OVERFLOW BY-PASS PIPING TO FLOOR SINK PER MANUFACTURER'S RECOMMENDATIONS. | | | | | | | | | | | | |
| MANUFACTURER'S RECOMMENDATIONS. PROVIDE ONE COMMUNICATION CABLE FOR WH-1 / WH-2 AND TWO CABLES FOR WH-3, WH-4 & WH-5. PROVIDE NAVIEN READY-LINK WALL MOUNT PIRING MANIFOLD SYSTEM FOR WATER HEATERS | | | | | | | | | | | | |

| | ELI | ECTRIC \ | NATER | R HE | ATER | R SCH | HEDU | LE | |
|----------|------------------------|---------------------|---------------------|------|---------------|---------|-------|-----------------------------|-------|
| MARK | LOCATION | TEMPERATURE RISE | CAPACITY GALLONS | AMPS | ELEMENT KW | VOLTAGE | PHASE | MANUFACTURER & MODEL NO. | NOTES |
| EWH 1 | ELEC RM IN SAFEROOM | 70 DEG @ 25 GPH | 20 | 22 | 4.5 | 208 | 1 | A.O. SMITH DEL-20 | ALL |
| NOTES: | | | _ | | | | | | |

PROVIDE NAVIEN READY-LINK WALL MOUNT PIPING MANIFOLD SYSTEM FOR WATER HEATERS.

INSTALL PER MANUFACTURER'S RECOMMENDATIONS.

0. SEE DETAIL 13/P502 FOR MORE INFORMATION.

WH 4

PROVIDE NAVIEN EXHAUST/INTAKE CONCENTRIC VENT KIT THRU ROOF.

- WATER HEATER OUTLET TEMPERATURE SET TO 120°F. VERIFY TEMPERATURE WITH OWNER.
- PROVIDE AMTROL ST-5 THERMAL EXPANSION TANK ON COLD WATER LINE TO WATER HEATER. PROVIDE HOLD RITE WALL SUPPORT PLATFORM MODEL 50-SWHP-W & RESTRAINT STRAP FOR WATER HEATER.
- COORDINATE WIRING WITH E.C. SEE DETAIL 6/P501 FOR MORE INFORMATION.

| ı | | CIRCULATION PUMP SCHEDULE | | | | | | | | | | | | | |
|---|---------|--------------------------------|-----------------------------------|--------------------|-----------------|-----------|--------|----------------------------|----------|----------------------------------|--|--|--|--|--|
| | MARK | MAXIMUM WORKING PRESSURE | MAXIMUM OPERATING TEMP (°F) | ELECTRICAL CHAR | MO F.L. AMPS | TOR HP | RPM | FLANGE SIZE (INCHES) | MATERIAL | MANUFACTURER & MODEL NO. | | | | | |
| | CP 1 | 150 PSI | 225 | 115/60/1 | 3.5 | 1/6 | VARIES | 3/4" | S.S. | BELL & GOSSETT ECOCIRC+ 20-18 | | | | | |
| | CP 2 | 150 PSI | 225 | 115/60/1 | 3.5 | 1/6 | VARIES | 3/4" | S.S. | BELL & GOSSETT ECOCIRC+ 20-18 | | | | | |
| | CP 3 | 150 PSI | 225 | 115/60/1 | 3.5 | 1/6 | VARIES | 3/4" | S.S. | BELL & GOSSETT ECOCIRC+ 20-18 | | | | | |

| | GREASE INTERCEPTOR SCHEDULE | | | | | | | | | | |
|---------|-----------------------------|--------------------|-----|---------------------|------------|------------------|-------|------------------|--------------|-----------------------------|-------|
| MARK | LOCATION | FLOW RATE (GPM) | | GREASE CAP.(LBS) | STANDARD . | DIMENS LENGTH | _ ` _ | NCHES) HEIGHT | WEIGHT (LBS) | MANUFACTURER & MODEL NO. | NOTES |
| GI 1 | EXTERIOR BELOW GRADE | 100 | 277 | 1,865 | 4" | 87 | 33 | 44 | 376 | SCHIER GB-250 | ALL |

- INSTALL AND VENT PER MANUFACTURER'S RECOMMENDATION AND LOCAL PLUMBING CODE.
- EXTENSION RISER ASSEMBLY AS REQUIRED.

GREASE INTERCEPTOR SIZED TO COMPLY WITH INTERNATIONAL PLUMBING CODE 2018 AND PDI-G101.

3-COMPARTMENT SINK:

20" x 20" x 14" x 3 = 16,800 CU INCHES / 231 = 58 GAL x 75% = 54.5 GALLONS

COOKS TABLE SINK #41:

PREP TABLE SINK #25:

USE INTERCEPTOR SIZED FOR FLOW RATE OF 100 GPM.

| | PLUMBING FIXTURE SCHEDULE | | | | | | | | | | | | | |
|-------|------------------------------|-----------------------------------|-----------------------|------------------|--------|---------|--------------|--------|---|--|--|--|--|--|
| | | | | | R | OUGH-IN | SCHEDUL | E | | | | | | |
| MARK | FIXTURE | MANUFACTURER | MODEL | MOUNT | COLD | НОТ | WASTE | VENT | FITTINGS AND REMARKS | | | | | |
| L-1 | LAVATORY ADA | AMERICAN STANDARD | 0355.012 | WALL | 1/2" | 1/2" | 1 1/2" | 1 1/2" | COLOR WHITE. PROVIDE CHICAGO FAUCET 420—ABCP, MCGUIRE HD155A GRID STRAINER, 8902C P—TRAP, LFBV2165CC 1/4 TURN SUPPLY STOPS. TRUEBRO LAV GUARD2 PIPE COVERS. ZURN WALL FIXTURE CARRIER. REFER TO ARCHITECT'S PLANS FOR HEIGHT AND WALL TYPE. INSTALL THERMOSTATIC MIXING VALVE TMV—1 UNDER FIXTURE. SEE DETAIL 5/P501. | | | | | |
| WC-1 | WATER CLOSET ADA | AMERICAN STANDARD | 2257.101 | WALL | 1 1/4" | ı | 4" | 1 | COLOR WHITE. PROVIDE SLOAN ROYAL 111-1.6 SFSM BATTERY OPERATED FLUSH VALVE. PROVIDE BEMIS 1655SSCT OPEN FRONT ELONGATED SEAT, EXTERNAL CHECK HINGE, COLOR WHITE. ZURN NARROW WALL CARRIER. REFER TO ARCHITECT'S PLANS FOR HEIGHT AND WALL TYPE. ADA INSTALLATION. | | | | | |
| WC-2 | WATER CLOSET | AMERICAN STANDARD | 2257.101 | WALL | 1 1/4" | - | 4" | - | COLOR WHITE. PROVIDE SLOAN ROYAL 111-1.6 SFSM BATTERY OPERATED FLUSH VALVE. PROVIDE BEMIS 1655SSCT OPEN FRONT ELONGATED SEAT, EXTERNAL CHECK HINGE, COLOR WHITE. ZURN NARROW WALL CARRIER. REFER TO ARCHITECT'S PLANS FOR HEIGHT AND WALL TYPE. | | | | | |
| S-1 | SINK | ELKAY | LRAD1919602 | COUNTERTOP | 1/2" | 1/2" | 1 1/2" | 1 1/2" | SINGLE BOWL 6" DEEP, 2 FAUCET HOLES, REAR CENTER DRAIN. PROVIDE ELKAY LKD35 DRAIN & ELKAY LK406GN08T4 FAUCET, MCGUIRE 8912 P-TRAP & LFBV2165 SUPPLY STOPS. INSTALL MIXING VALVE TMV-1 UNDER SINK. | | | | | |
| MS-1 | MOP SINK | FIAT | TSB-3000 24x24x12 | FLOOR | 1/2" | 1/2" | 3" | 1 1/2" | MOLDED STONE, 6" DROP FRONT, SS THRESHOLD. PROVIDE FIAT 832AA HOSE & WALL BRACKET, 889-CC MOP BRACKET, MSG2424 SS WALL GUARDS, PROVIDE T&S BRASS FAUCET B-0665-BSTR. PROVIDE ASSE 1011 APPROVED HOSE CONNECTION VACUUM BREAKER. | | | | | |
| EWC-1 | ELECTRIC WATER COOLER | ELKAY | LZSTL8WSSK | WALL | 1/2" | _ | 1 1/2" | 1 1/2" | DUAL LEVEL WITH SENSOR WATER BOTTLE FILLING STATION ON LOWER UNIT, VANDAL—RESISTANT, FILTERED, PUSH BUTTON ACTIVATION, 120 VOLT. PVC P—TRAP AND 1/4 TURN SUPPLY STOP. REFER TO ARCHITECT'S PLANS FOR MOUNTING HEIGHT. ADA INSTALLATION. | | | | | |
| FD | FLOOR DRAIN | ZURN | ZN415-BZ1-P -VP | FLOOR | - | - | SEE PLANS | - | 6" ROUND NICKEL BRONZE STRAINER, CAST IRON BODY ANCHOR FLANGE, CLAMP COLLAR, ADJUSTABLE COLLAR, ADJUSTABLE STRAINER HEIGHT, VANDAL-PROOF SECURED TOP, 1/2" TRAP PRIMER CONNECTION. SEE DETAIL 1/P501. | | | | | |
| FS-1 | FLOOR SINK | ZURN | ZN1910-K-2 -23 | FLOOR | _ | - | 3" | _ | 8"x8" TOP, 6" DEEP, CAST IRON BODY WITH WHITE A.R.E INTERIOR, ANCHOR FLANGE, 1/2 GRATE WITH NICKEL BRONZE FINISH & SEDIMENT BUCKET. | | | | | |
| FS-2 | FLOOR SINK | ZURN | ZS1901-K-2- 23 | FLOOR | - | _ | 4" | - | 12"x12" TOP, 8" DEEP, CAST IRON BODY WITH WHITE A.R.E INTERIOR, ANCHOR FLANGE, STAINLESS STEEL FRAME, 1/2 GRATE, & SEDIMENT BUCKET. | | | | | |
| FS-3 | FLOOR SINK | ZURN | ZS1900-K-2 -23 | FLOOR | _ | - | 2" | l | 12"x12" TOP, 6" DEEP, CAST IRON BODY WITH WHITE A.R.E INTERIOR, ANCHOR FLANGE, STAINLESS STEEL FRAME WITH 1/2 GRATE & SEDIMENT BUCKET. | | | | | |
| FS-4 | FLOOR SINK | ZURN | ZS1910-K-P -2-23 | FLOOR | - | _ | 2" | - | 8"x8" TOP, 6" DEEP, CAST IRON BODY WITH WHITE A.R.E INTERIOR, ANCHOR FLANGE, 1/2" TRAP PRIMER CONNECTION, STAINLESS STEEL FRAME WITH 1/2 GRATE & SEDIMENT BUCKET. | | | | | |
| FC0 | FLOOR CLEANOUT | ZURN | ZN1400-K-VP | FLOOR | - | - | SEE PLANS | - | ADJUSTABLE, CAST IRON BODY, ANCHOR FLANGE, ABS THREAD PLUG, ROUND SCORIATED TOP WITH NICKEL BRONZE FINISH, VANDAL RESISTANT COVER SCREWS. | | | | | |
| WCO | WALL CLEANOUT | ZURN | Z1446-VP | WALL | _ | _ | SEE PLANS | - | CAST IRON CLEANOUT TEE, THREAD ABS PLUG, STAINLESS STEEL ROUND ACCESS COVER WITH VANDAL RESISTANT SECURING SCREW. | | | | | |
| ECO | EXTERIOR CLEANOUT | ZURN | Z1474-N-VP | GRADE | _ | _ | SEE PLANS | _ | CAST IRON CLEANOUT ACCESS HOUSING, ANCHOR FLANGE, SECURED GASKETED COVER WITH CLEANOUT FERRULE WITH ABS PLUG. VANDAL PROOF COVER SCREWS. | | | | | |
| HA-1 | HAMMER ARRESTOR | WATTS | LF15M2 | PIPE | VARIES | 1 | - | 1 | LEAD-FREE DESIGN, PDI WH201 LISTED, MAINTENANCE FREE, INSTALL PER MANUFACTURER'S RECOMMENDATIONS. | | | | | |
| TP-1 | TRAP PRIMER (ELECTRIC) | PRECISION PLUMBING PRODUCTS | PTS-4 | PIPE | 3/4" | 1 | ı | 1 | ELECTRONIC UNIT ENCLOSED IN METAL CABINET WITH 24 HOUR TIMER, SOLENOID VALVE, VACUUM BREAKER, 3/4" CW INLET, HAMMER ARRESTOR & 1/2" OUTLETS, WATER, 120V POWER HARDWIRED. PROVIDE STRAINER PRIOR TO UNIT. COORDINATE 120 VOLT POWER OUTLET WITH EC. SEE DETAIL 1/P501. | | | | | |
| TP-2 | TRAP PRIMER | PRECISION PLUMBING PRODUCTS | PR01-ULP500 | PIPE | 1/2" | - | - | - | UNDER FIXTURE TRAP PRIMER VALVE, CHROME PLATED, 1/2" CW INLET WITH ANGLE STOP, 3/8" OUTLET TO FAUCET, AIR GAP WITH 1/2" OUTLET TO FLOOR DRAIN. WALL ESCUTCHEON. MOUNT MINIMUM 12" ABOVE FLOOR. SEE DETAIL 11/P501. | | | | | |
| TMV-1 | THERMOSTATIC MIXING VALVE | WATTS | LFMMV-M1 | BELOW FIXTURE | 1/2" | 1/2" | П | ı | LEAD FREE MIXING VALVE WITH ADJUSTABLE TEMPERATURE SET-POINT & LOCKABLE, INTEGRAL CHECK STOPS & STRAINERS, 1/2" INLETS & OUTLET. SET OUTLET TEMP AT 105 DEGREES F. ASSE 1070 LISTED. | | | | | |
| AP-1 | ACCESS PANEL | ACUDOR | UF-5000 14x14 CLSS | WALL | - | - | - | - | 14"x14" STEEL, 16 GAGE DOOR & FRAME, 18 GAGE MOUNTING FRAME. CONCEALED HINGE, CYLINDER LOCK & KEY, STAINLESS STEEL FINISH. CONCEALED FASTENING POINTS. | | | | | |
| CD-1 | CLOTHES DRYER | PROVIDED BY OTHERS | - | FLOOR | - | - | - | - | DRYER INSTALLED BY OTHERS. PC SHALL ROUGH—IN & MAKE FINAL CONNECTIONS. PROVIDE 1/2" DORMONT NATURAL GAS FLEXIBLE GAS LINE WITH BALL VALVE, SWIVEL CONNECTIONS & 36" LENGTH. LOW PRESSURE GAS. COORDINATE WITH UNIT SUPPLIER. 20 MBH GAS LOAD. | | | | | |
| WM-1 | WASHING MACHINE | PROVIDED BY OTHERS | - | FLOOR | 3/4" | 3/4" | 3" | - | MACHINE INSTALLED BY OTHERS. PC SHALL ROUGH—IN & MAKE FINAL CONNECTIONS. ROUTE DRAIN HOSE TO LAUNDRY BOX DRAIN. CONNECT FLEXIBLE WATER HOSES TO WALL BOX & MACHINE. COORDINATE WITH UNIT SUPPLIER. | | | | | |
| LB-1 | LAUNDRY BOX | SIOUX CHIEF | 696RG2313WF | WALL | 1/2" | 1/2" | 2" | 1 1/2" | FIRE RATED RECESSED WALL MOUNTED BOX WITH FLANGE, 1/4 TURN BALL VALVES WITH HAMMER ARRESTORS, 3/4" THREADED OUTLETS, DRAIN CONNECTION. COORDINATE INSTALL HEIGHT FOR CLOTHES WASHER. | | | | | |
| GVB-1 | GAS VALVE BOX | SIOUX CHIEF | 696R1020GF | WALL | - | - | - | - | FIRE RATED RECESSED WALL MOUNTED BOX WITH FLANGE, NATURAL GAS 1/4 TURN BALL VALVE, 1/2" THREADED OUTLET. PROVIDE DORMONT FLEXIBLE GAS LINE. COORDINATE INSTALL HEIGHT FOR CLOTHES DRYER GAS CONNECTION | | | | | |



201 N. BROADWAY SUITE 210 MOORE, OK. 73160 405.735.3477 AGP@theAGP.net www.theAGP.net

KFC ENGINEERING STRUCTURAL

SALAS O'BRIEN

MECHANICAL / ELECTRICAL



drawn by

checked by

OCTOBER 2024

11/22/2024 AD 02 01/14/2025 CB01



CHILD CARE FACILITY 201 N. EASTERN AVE.

sheet no:



Salas O'Brien Project Number: 2450-70304-00

Salas O'Brien Registration: CA# 7058


Moore, OK 73160

Expiration Date : 6/30/2025

AGP EXPRESSLY RESERVES ITS

COPYRIGHT AND OTHER PROPERTY RIGHTS OF ALL PLANS AND DRAWINGS DESIGNED AND/OR PRODUCED. PLANS AND DRAWINGS ARE NOT TO BE REPRODUCED IN ANY FORM OR MANNER WITHOUT THE EXPRESSED WRITTEN CONSENT OF AGP.

OWNERSHIP USE OF DOCUMENTS:

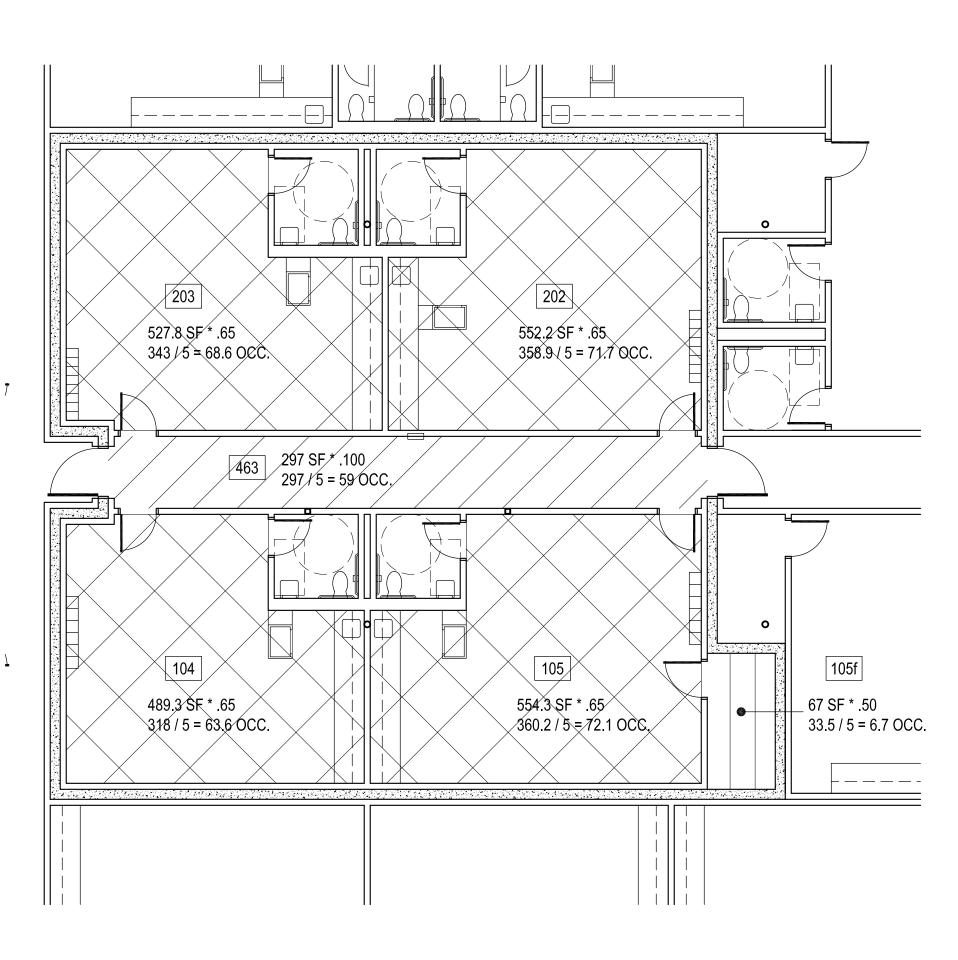



SHELTER CALCULATION PLAN

GENERAL NOTES:

INDICATES AREA USED TO CALCULATE

USABLE SHELTER FLOOR AREA - 65% X 2,122 S.F. = 1,379.3 S.F.

INDICATES AREA USED TO CALCULATE USABLE SHELTER FLOOR AREA - 100% X 297 S.F. = 297 S.F. PLUMBING FIXTURES SHELTER CALCULATIONS:


TOTAL OCCUPANT LOAD = 341

TOTAL REQUIRED: TOTAL PROVIDED: WATER CLOSETS = 2 WATER CLOSETS = 4 LAVATORIES = 2 LAVATORIES = 4

INDICATES AREA USED TO CALCULATE USABLE SHELTER FLOOR AREA - 50% X 67 S.F. = 33.5 S.F.


TOTAL CALCULATION OF USABLE FLOOR AREA (ADJUSTED TO INCL. H.C.) = 1,709.5 S.F. / 5 = 339 OCCUPANTS + 2 H.C. = 341 TOTAL OCCUPANTS

PLUMBING FIXTURE REQUIREMENTS FOR ICC 500 2014 ARE EXCEEDED BY IBC 2018 PLUMBING FIXTURE REQUIREMENTS

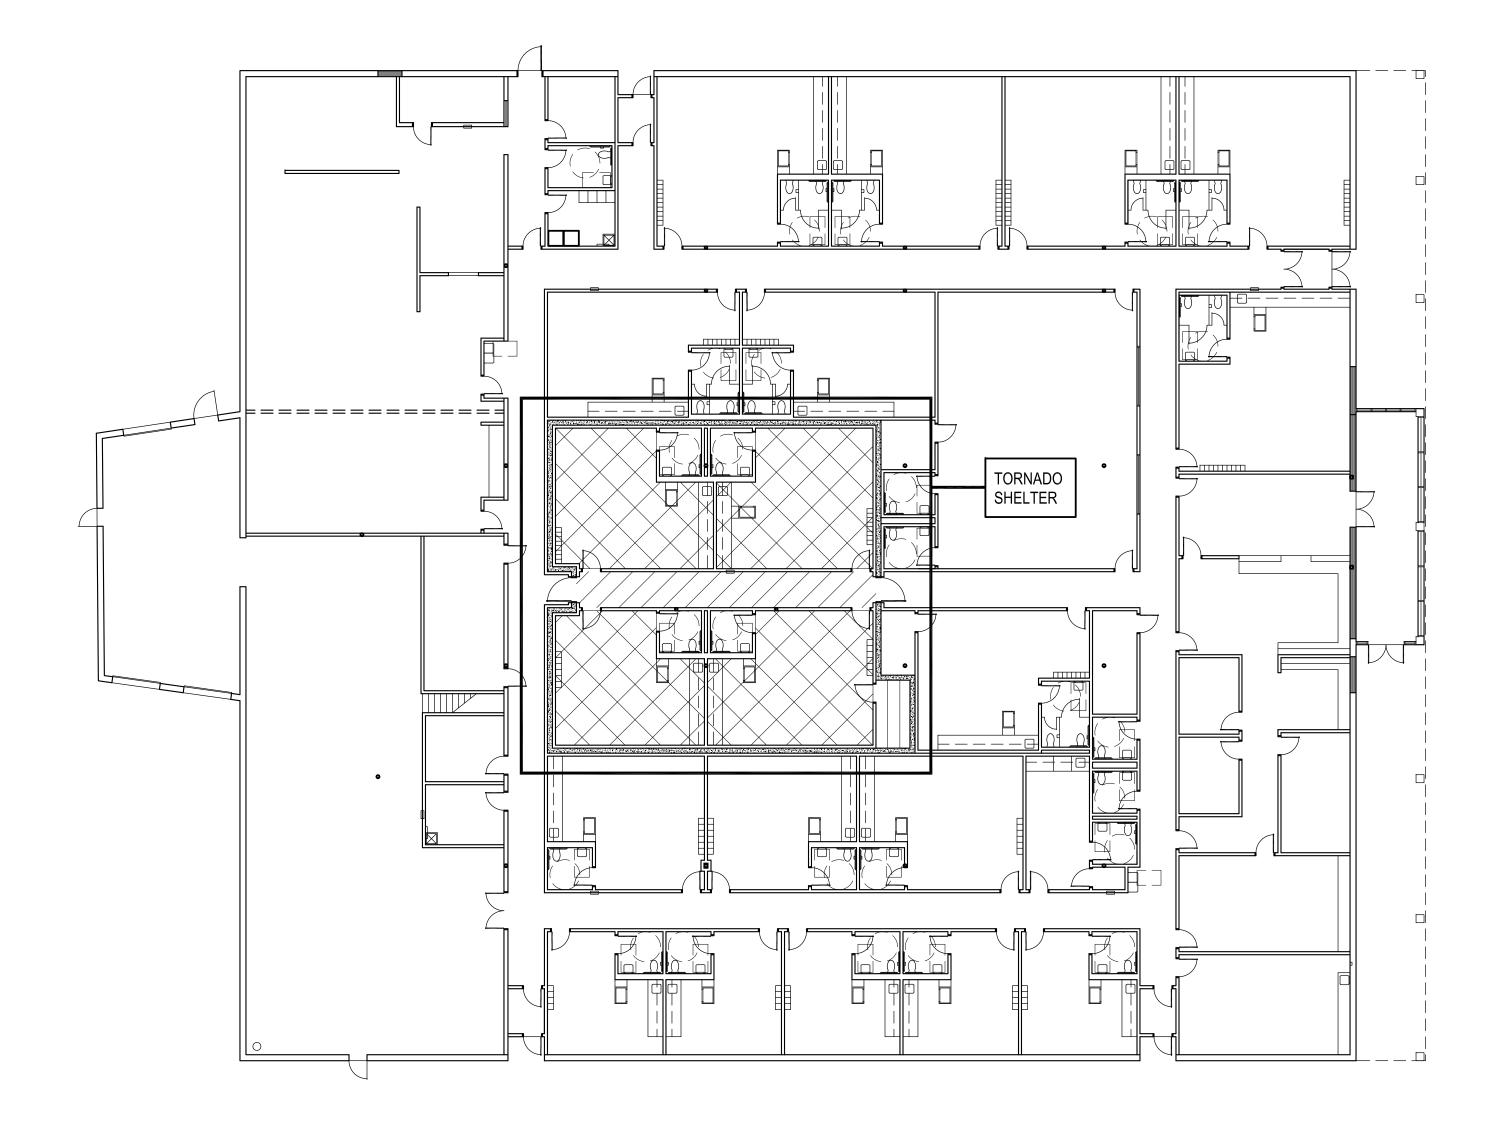



SHELTER LOCATION PLAN NO SCALE

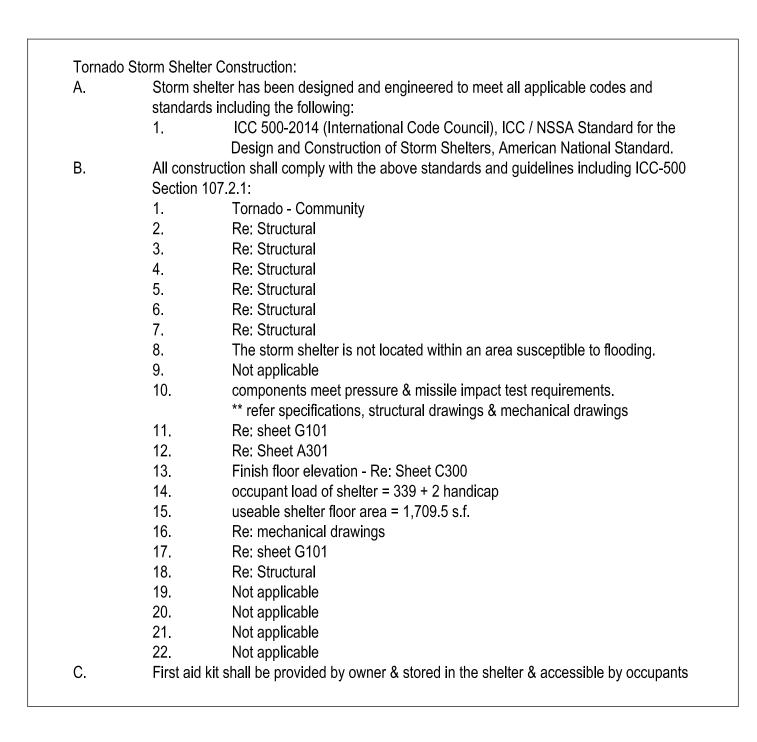






313 S. E. 5th Street MOORE, OK. 73160 405.735.3477 AGP@theAGP.net www.theAGP.net

CEDAR CREEK

KFC ENGINEERING

STRUCTURAL

SALAS O'BRIEN MECHANICAL / ELECTRICAL

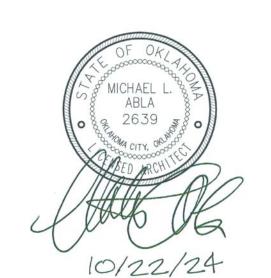

1 ADDENDUM #1

2 CB-1


MOORE PUBLIC SCHOOLS

CHILD CARE FACILITY 201 N. EASTERN AVE.

G101

OWNERSHIP USE OF DOCUMENTS:

AGP EXPRESSLY RESERVES ITS COPYRIGHT AND OTHER PROPERTY RIGHTS OF ALL PLANS AND DRAWINGS DESIGNED AND/OR PRODUCED. PLANS AND DRAWINGS ARE NOT TO BE REPRODUCED IN ANY FORM OR MANNER WITHOUT THE EXPRESSED WRITTEN CONSENT OF AGP.

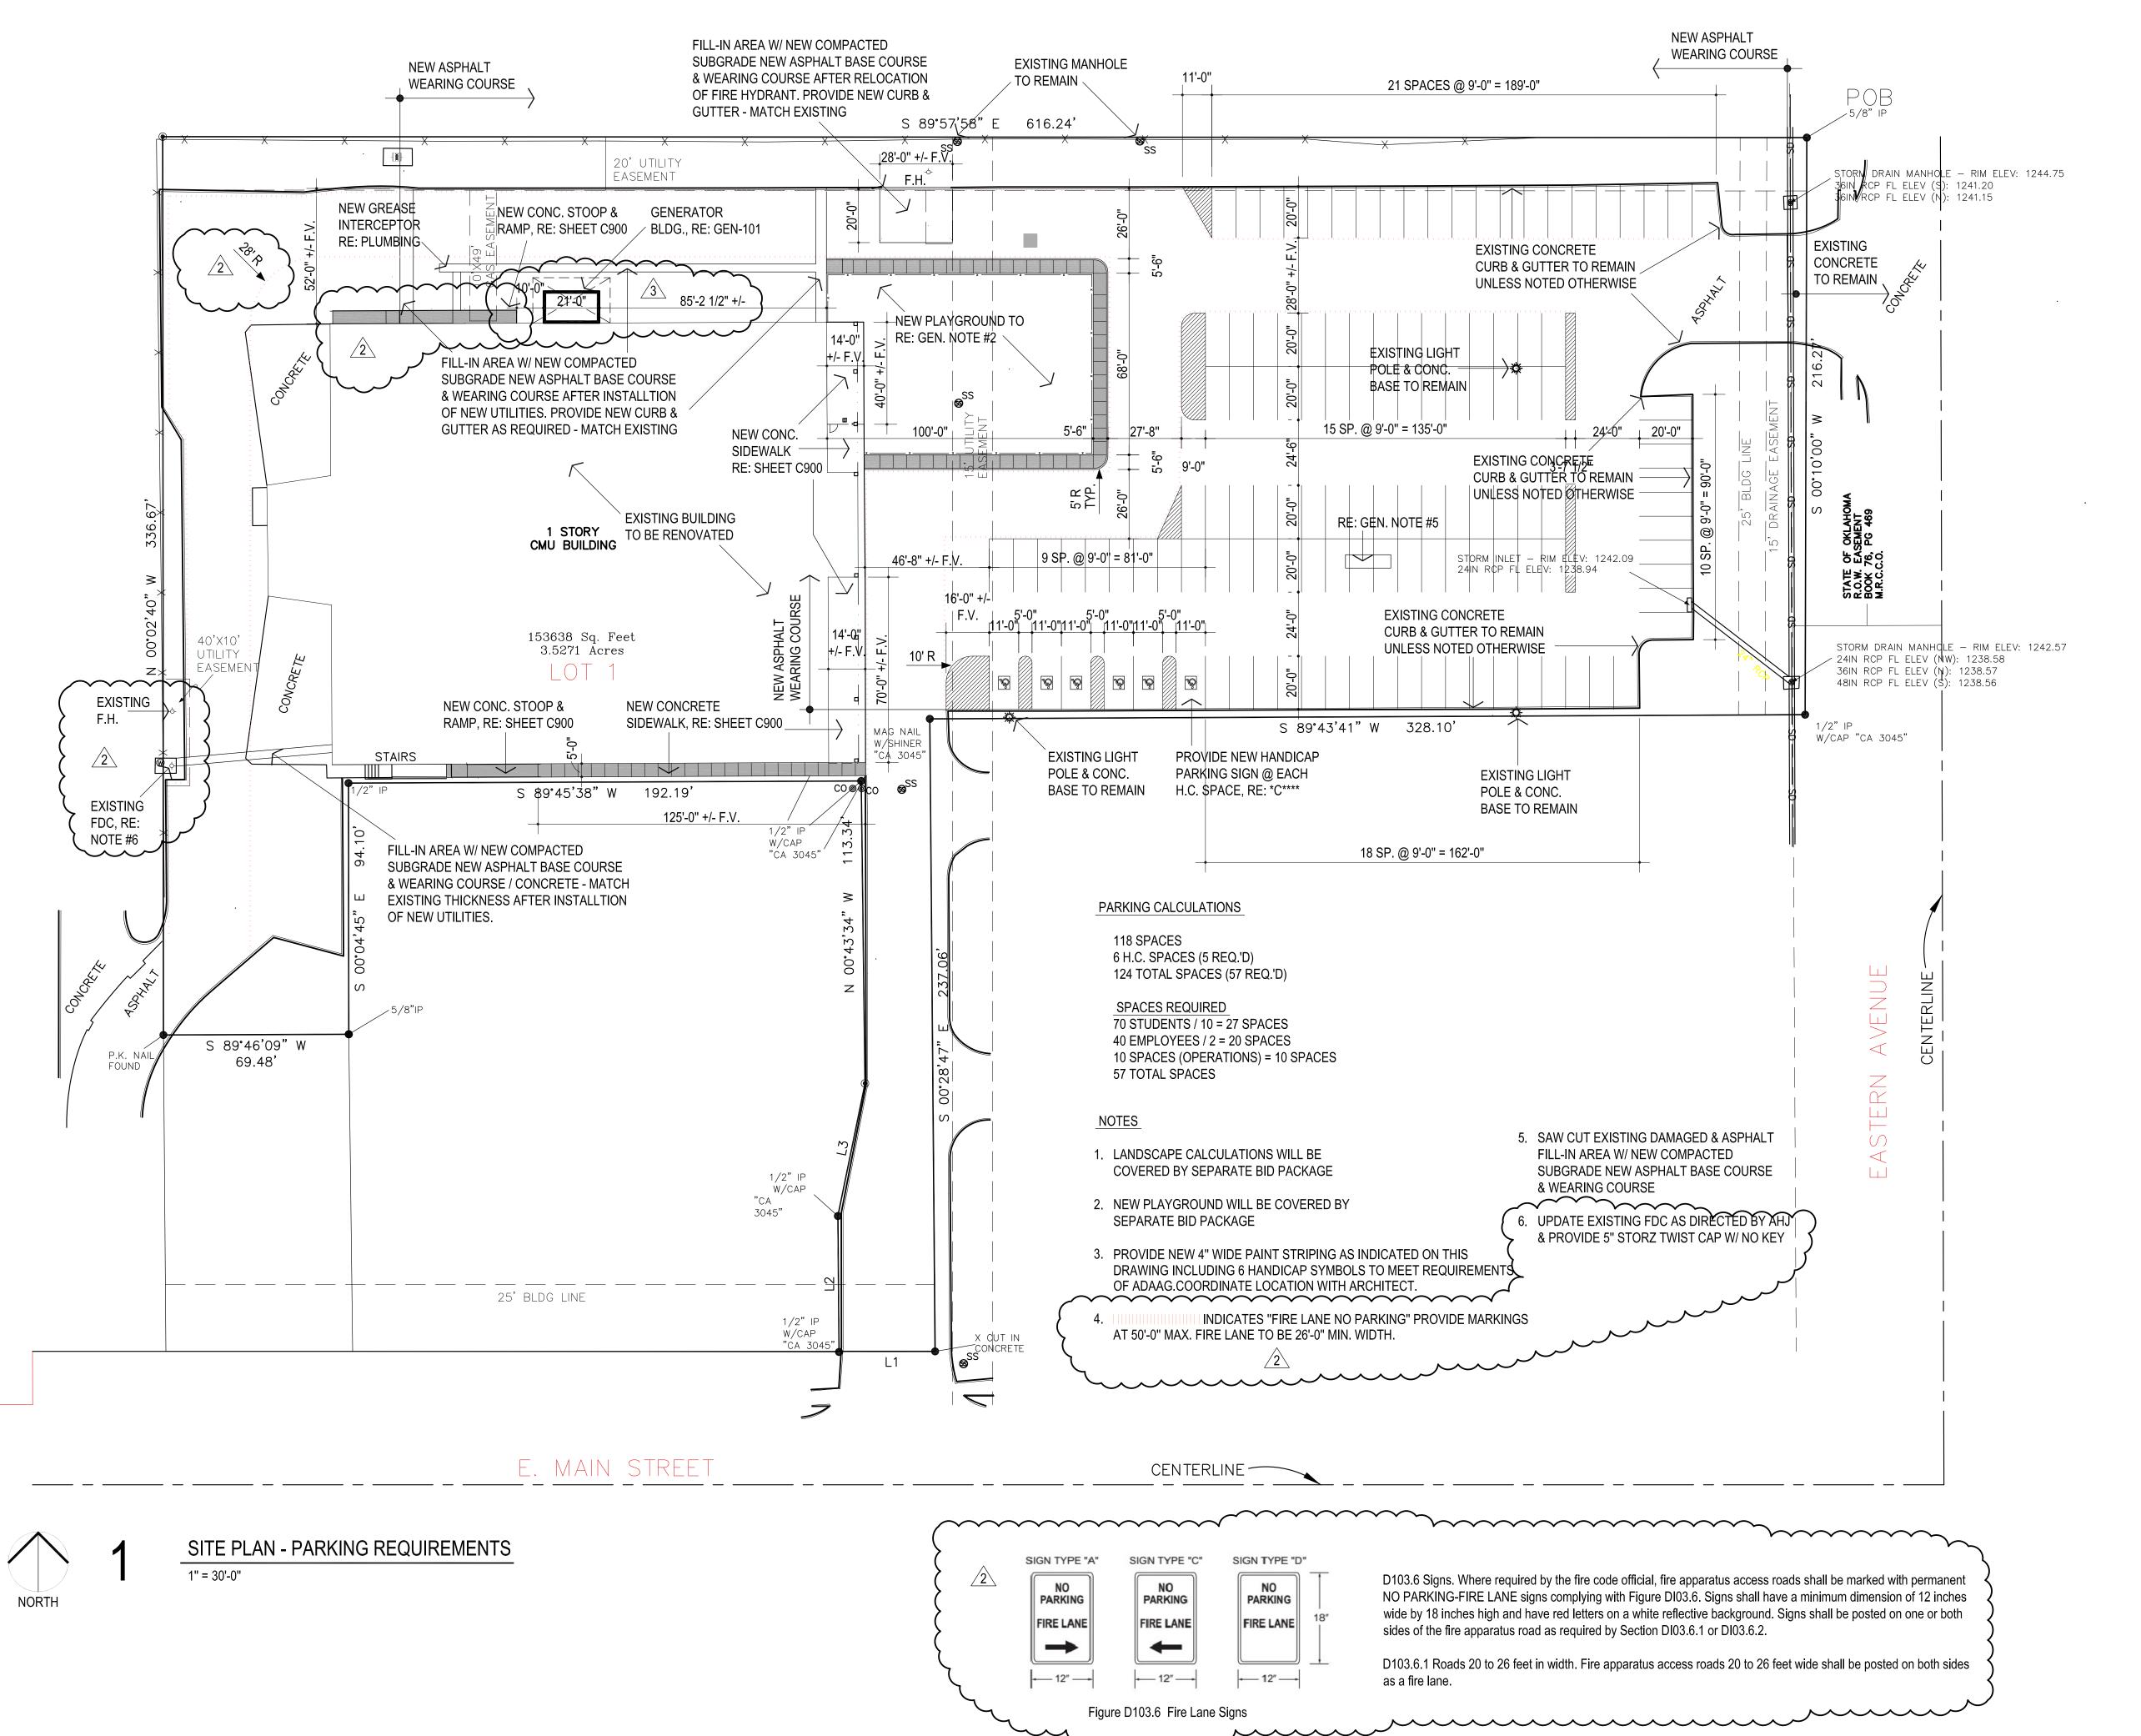

the Abla Griffin Partnership L.L.C.

> 313 S. E. 5th Street MOORE, OK. 73160 405.735.3477 AGP@theAGP.net www.theAGP.net


CEDAR CREEK

CIVIL

KFC ENGINEERING

STRUCTURAL

SALAS O'BRIEN MECHANICAL / ELECTRICAL

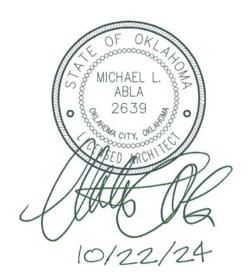

OCTOBER 2024

1 ADDENDUM #2

2 ADDENDUM #3 3 CB-1



CHILD CARE FACILITY 201 N. EASTERN AVE.

C300


WITHOUT THE EXPRESSED WRITTEN


OWNERSHIP USE OF DOCUMENTS:

CONSENT OF AGP.

AGP EXPRESSLY RESERVES ITS ~~~~ COPYRIGHT AND OTHER PROPERTY RIGHTS OF ALL PLANS AND DRAWINGS DESIGNED AND/OR PRODUCED. PLANS AND DRAWINGS ARE NOT TO BE REPRODUCED IN ANY FORM OR MANNER

1 ENTIRE SHEET

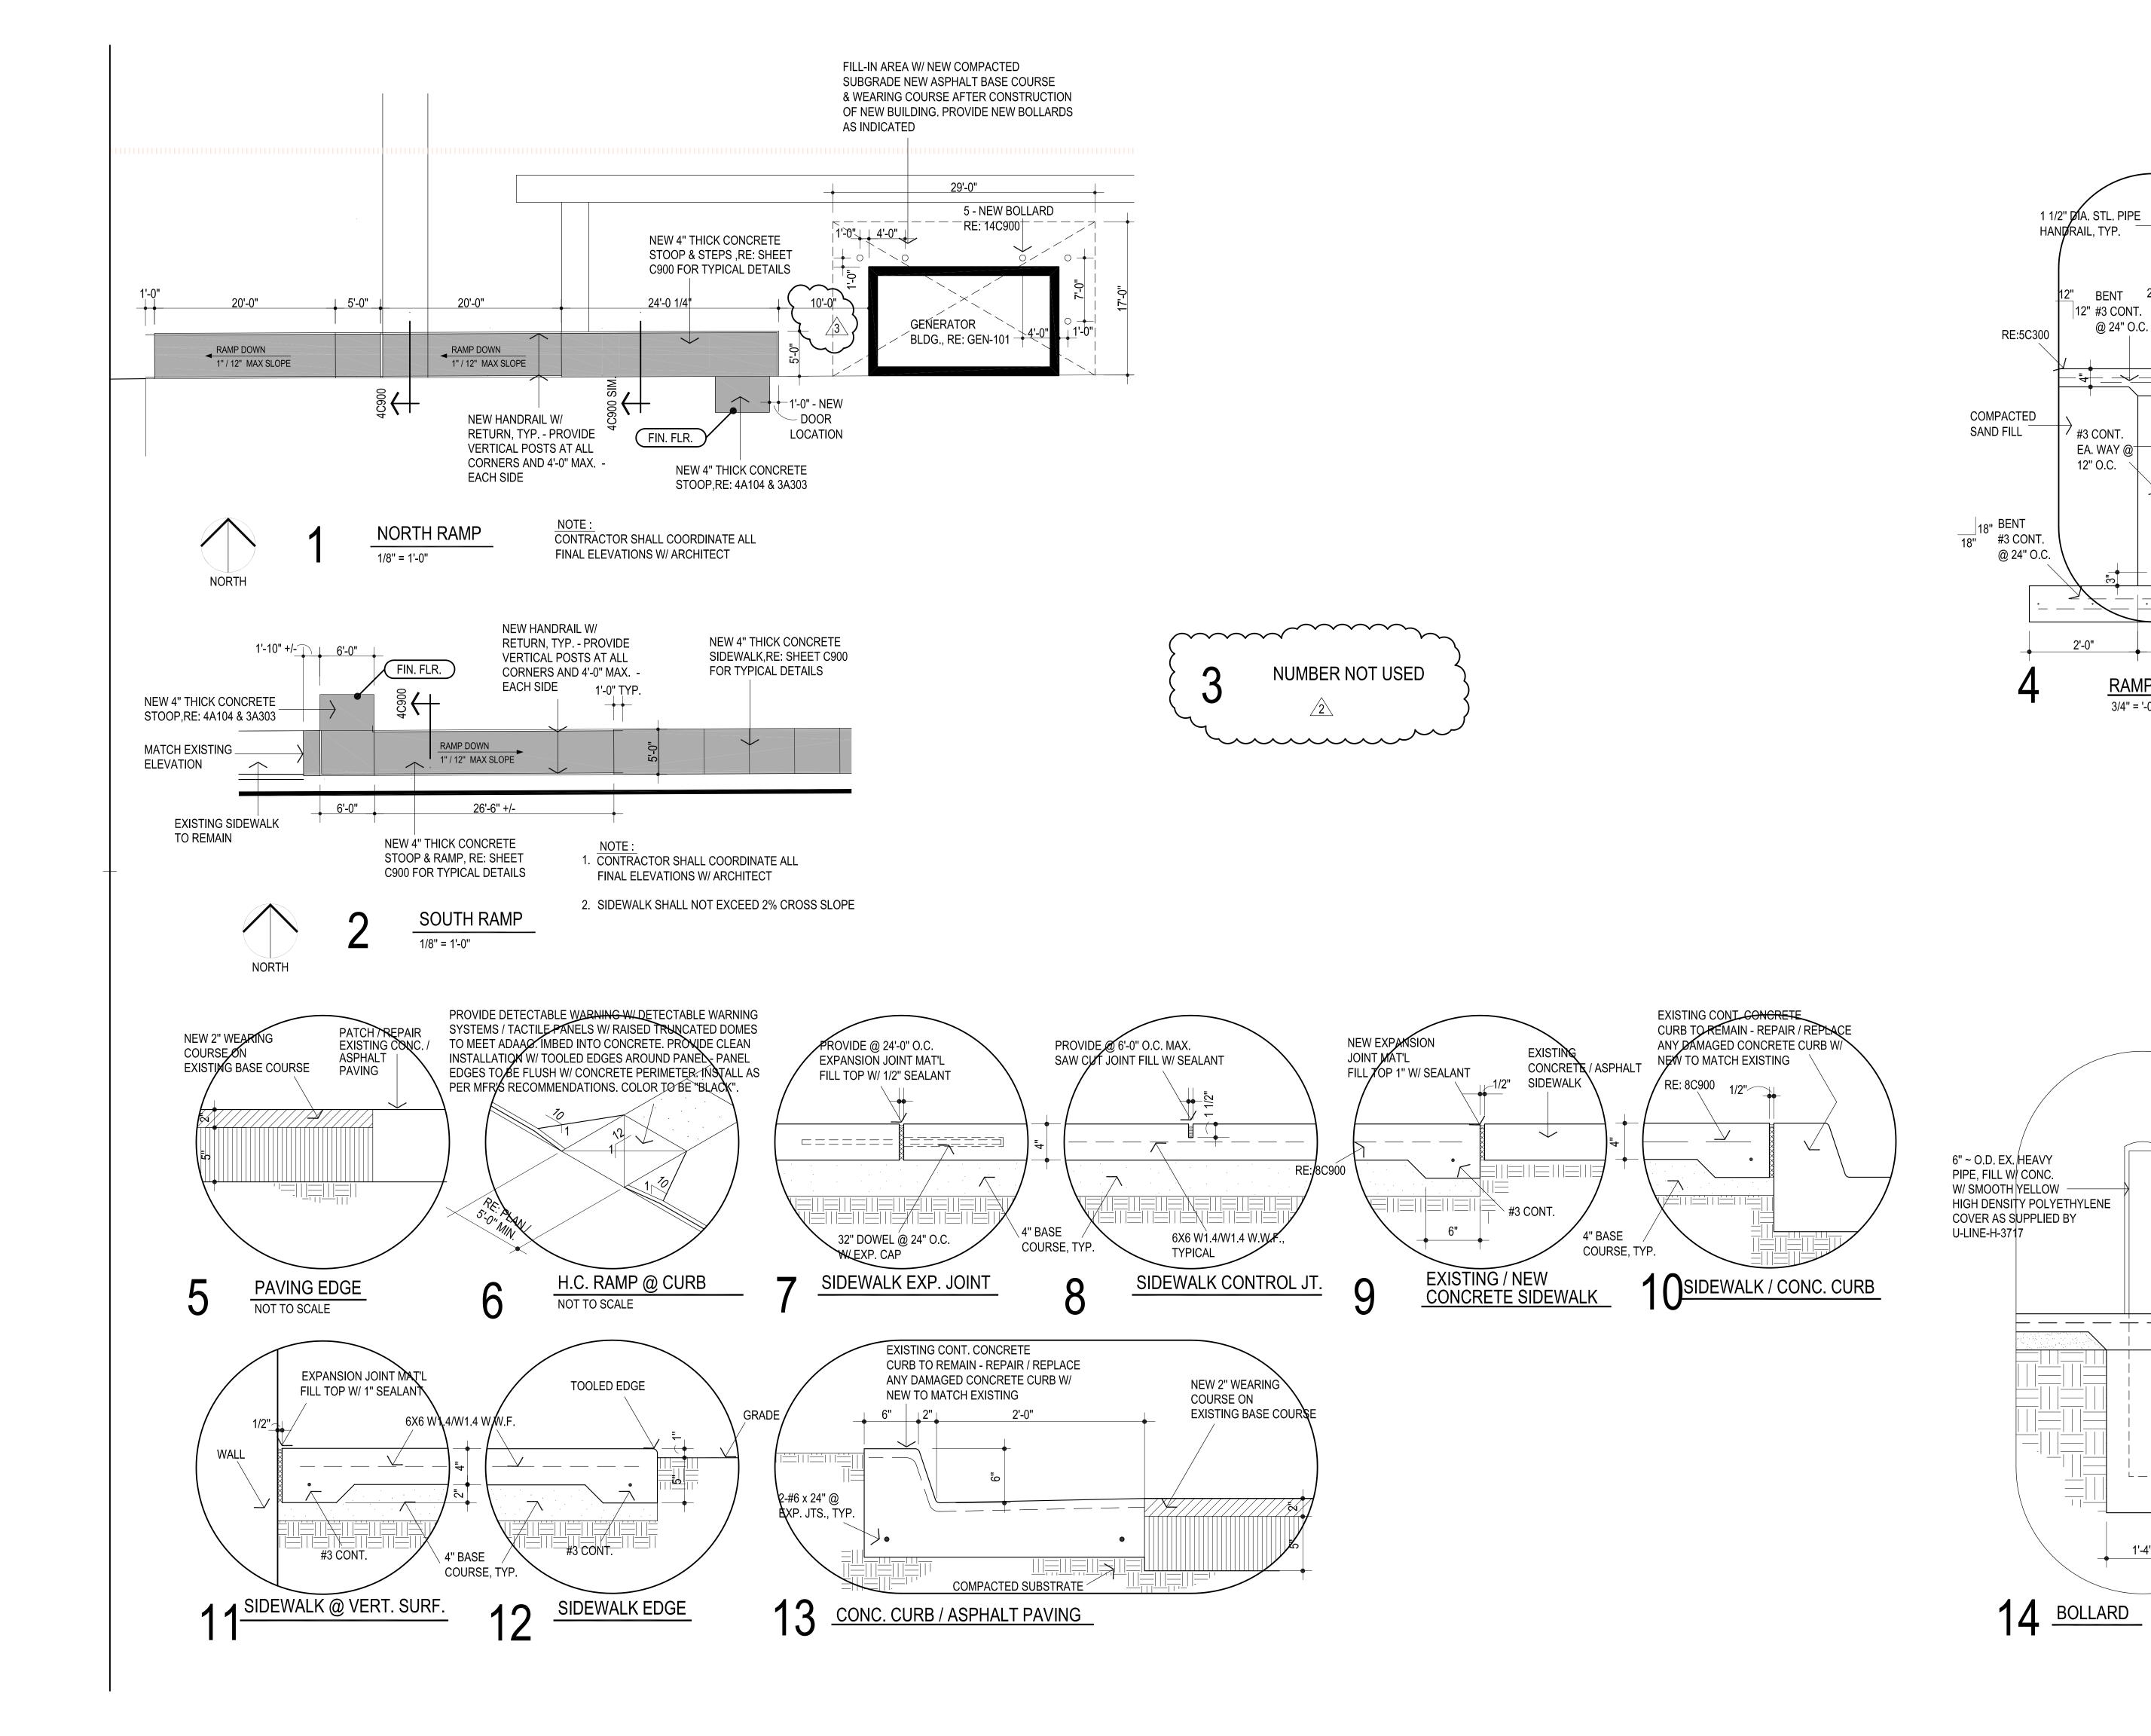

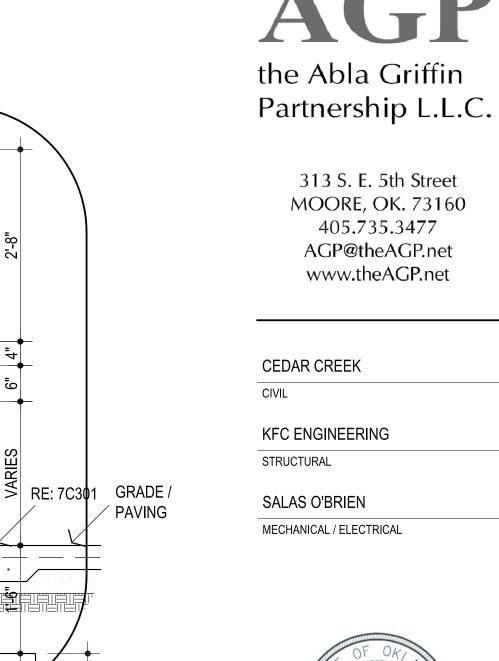

, #3 CONT.

12" O.C.

RAMP EDGE

3/4" = '-0"

1'-4"

EA. WAY @

BENT

12" #3 CONT.

@ 24" O.C.

313 S. E. 5th Street MOORE, OK. 73160 405.735.3477 AGP@theAGP.net www.theAGP.net

CEDAR CREEK CIVIL

KFC ENGINEERING

STRUCTURAL

SALAS O'BRIEN MECHANICAL / ELECTRICAL



drawn by

checked by OCTOBER 2024

✓1 ADDENDUM #2

2 ADDENDUM #3

3 CB-1



CHILD CARE FACILITY 201 N. EASTERN AVE.

1 ENTIRE SHEET

C900

OWNERSHIP USE OF DOCUMENTS:

AGP EXPRESSLY RESERVES ITS COPYRIGHT AND OTHER PROPERTY RIGHTS OF ALL PLANS AND DRAWINGS DESIGNED AND/OR PRODUCED. PLANS AND DRAWINGS ARE NOT TO BE REPRODUCED IN ANY FORM OR MANNER WITHOUT THE EXPRESSED WRITTEN CONSENT OF AGP.

| | SUMMARY OF QUA | NTIT | IES | |
|-------|---|------|----------|----------|
| ITEM# | ITEM | UNIT | QUANTITY | AS-BUILT |
| 1. | 6" WATERLINE (C-900) | L.F. | 6 | |
| 2. | 8" X 6" CUT IN TEE W/ MECHANICAL JOINTS | EA | 1 | |
| 3. | 6" GATE VALVE & BOX | EA | 1 | |
| 4. | FIRE HYDRANT | EA. | 1 | |
| 5. | FIRE HYDRANT RISER (IF NEEDED) | EA | 1 | |
| 6. | CRUSHED ROCK BEDDING | C.Y. | 1 | |
| 7. | TESTING AND DISINFECTING | L.S. | 1 | |
| | | | | |
| | | | | |
| | SHEET | | | |


| | SHEET INDE | X | |
|-----------------|------------------------------|----------|----------------|
| SHEET NUMBER | SHEET TITLE | DATE | REV/BID/CO/ADD |
| C0.00 | WATER COVER SHEET | 01.07.25 | BID/CB#1 |
| C1.00 | UTILITY PLAN | 01.07.25 | BID/CB#1 |
| C2.00 | WATERLINE 1 PLAN AND PROFILE | 01.07.25 | BID/CB#1 |
| C2.01 | WATERLINE DETAILS | 11.05.24 | |
| C3.00 | EROSION CONTROL PLAN | 01.07.25 | BID/CB#1 |
| C3.01 | EROSION CONTROL DETAILS | 11.05.24 | |
| | | | |
| | | | |
PUBLIC WATERLINE PLANS

TO SERVE

MPS DAYCARE 201 N. EASTERN

A PART OF THE NE/4 OF SEC. 14, T-10-N, R-3-W, I.M. MOORE, CLEVELAND COUNTY, OKLAHOMA

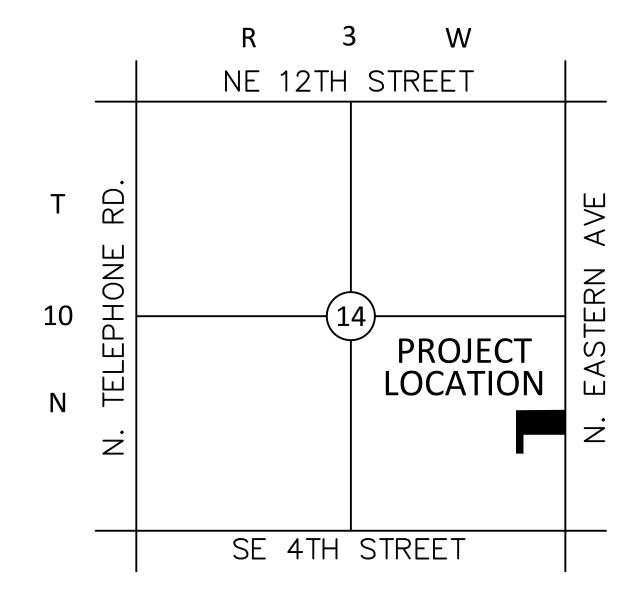



GENERAL NOTES:

- A. CONTRACTOR SHALL BE RESPONSIBLE FOR RAZING AND REMOVAL OF THE EXISTING STRUCTURES, RELATED UTILITIES, PAVING, UNDERGROUND STORAGE TANKS AND ANY OTHER EXISTING IMPROVEMENTS AS NOTED.
- B. CONTRACTOR IS TO REMOVE AND DISPOSE OF ALL DEBRIS, RUBBISH AND OTHER MATERIALS RESULTING FROM PREVIOUS AND CURRENT DEMOLITION OPERATIONS. DISPOSAL WILL BE IN ACCORDANCE WITH ALL LOCAL, STATE AND/OR FEDERAL REGULATIONS GOVERNING SUCH OPERATIONS.
- C. THE GENERAL CONTRACTOR WILL BE HELD SOLELY RESPONSIBLE FOR AND SHALL TAKE ALL PRECAUTIONS NECESSARY TO AVOID PROPERTY DAMAGE TO ADJACENT PROPERTIES DURING THE CONSTRUCTION PHASES OF THIS PROJECT.
- . WARRANTY/DISCLAIMER: THE DESIGNS REPRESENTED IN THESE PLANS ARE IN ACCORDANCE WITH ESTABLISHED PRACTICES OF CIVIL ENGINEERING FOR THE DESIGN FUNCTIONS AND USES INTENDED BY THE OWNER AT THIS TIME. HOWEVER, NEITHER THE ENGINEER NOR ITS PERSONNEL CAN OR DO WARRANT THESE DESIGNS OR PLANS AS CONSTRUCTED EXCEPT IN THE SPECIFIC CASES WHERE THE ENGINEER INSPECTS AND CONTROLS THE PHYSICAL CONSTRUCTION ON A CONTEMPORARY BASIS AT THE SITE.
- E. SAFETY NOTICE TO CONTRACTOR: IN ACCORDANCE WITH GENERALLY ACCEPTED CONSTRUCTION PRACTICES, THE CONTRACTOR SHALL BE SOLELY AND COMPLETELY RESPONSIBLE FOR CONDITIONS OF THE JOB SITE, INCLUDING SAFETY OF ALL PERSONS AND PROPERTY DURING PERFORMANCE OF THE WORK. THIS REQUIREMENT WILL APPLY CONTINUOUSLY AND NOT BE LIMITED TO NORMAL WORKING HOURS. ANY CONSTRUCTION OBSERVATION BY THE ENGINEER OF THE CONTRACTOR'S PERFORMANCE IS NOT INTENDED TO INCLUDE REVIEW OF THE ADEQUACY OF THE CONTRACTOR'S SAFETY MEASURES, IN, ON OR NEAR THE CONSTRUCTION SITE.
- F. ALL CONSTRUCTION WITHIN STATE HIGHWAY DEPARTMENT RIGHT-OF-WAY SHALL BE COORDINATED WITH THE HIGHWAY DEPARTMENT RESIDENT MAINTENANCE ENGINEER
- G. ALL CONSTRUCTION TO BE IN STRICT ACCORDANCE WITH CURRENT CITY OF MOORE STANDARD DETAILS AND CITY OF MOORE STANDARDS AND SPECIFICATIONS

NOTE: THE CONTRACTOR SHALL BE RESPONSIBLE FOR ADHEREING TO THE FOLLOWING OKLAHOMA DEQ REQUIREMENTS AND SPECIFICATIONS LISTED OUT FROM OAC 252:626


- a. 252;626-19-2(a) STANDARDS THE STANDARDS IN THIS SECTION APPLY TO THE INSTALLATION OF PIPING IN PUBLIC WATER SUPPLY DISTRIBUTION LINES.
- b. 252:626-19-2(b) BEDDING PROVIDE CONTINUOUS AND UNIFORM BEDDING IN THE TRENCH FOR ALL BURIED PIPE. TAMP BACKFILL MATERIAL IN LAYERS AROUND THE PIPE AND TO A SUFFICIENT HEIGHT ABOVE THE PIPE TO ADEQUATELY SUPPORT AND PROTECT THE PIPE. REMOVE ALL STONE FOUND IN THE TRENCH TO A DEPTH OF AT LEAST 6 INCHES BELOW THE BOTTOM OF THE PIPE
- c. 252:626-19-2(d) BLOCKING PROVIDE REACTION BLOCKING, TIE RODS, OR JOINTS DESIGNED TO PREVENT MOVEMENT AT ALL TEES, BENDS, PLUGS AND HYDRANTS TO PREVENT MOVEMENT OF THE PIPE
- d. 252:626-19-2(e) PRESSURE AND LEAKAGE TESTING TEST THE INSTALLED PIPE FOR LEAKAGE IN ACCORDANCE WITH AWWA STANDARD SPECIFICATIONS. LEAKAGE MUST NOT EXCEED 10 GAL/INCH DIAMETER PER MILE PER 24 HOURS AT 150 PSI TESTING PRESSURE.
- e. 252:626-19-2(f) DISINFECTION AND TESTING DISINFECT ALL WATERLINES ACCORDING TO AWWA STANDARD SPECIFICATIONS. OBTAIN SAFE BACTERIOLOGICAL SAMPLES ON TWO CONSECUTIVE DAYS BEFORE PLACING THE WATERLINE INTO SERVICE.
- f. 252:626-19-2(j) TRACER WIRE INSTALL METAL TRACER WIRE ON ALL NON-FERROUS PIPING USED FOR PUBLIC WATER SUPPLY MAIN.


NOTE: TRACER WIRE REQUIRED WITH WATERLINE EXTENSION

NOTE: ALL FITTINGS SHALL BE RESTRAINED. REFER TO CITY OF MOORE DETAILS THAT SHOW MIN. RESTRAINED LENGTH.



405-778-3385 www.cedarcreekinc.com OK CA 5

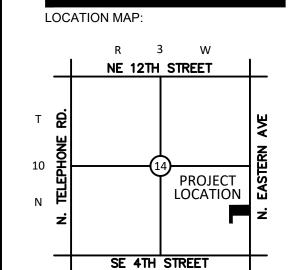

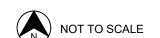

PROJECT:

MPS DAYCARE

201 N. EASTERN MOORE OK

PROJECT NUMBER: 24110 DRAWING DATE: 11.05.24 ISSUE DATE: 11.05.24



PERMIT SET

| | ISIONS: | |
|-------------|----------|-------------|
| \triangle | 01.07.25 | CB #1 |
| | | |
| | | |
| | | |
| | | |
| MARK | DATE | DESCRIPTION |

REPRODUCED, CHANGED OR COPIED IN ANY FORM OR MANNER WHATSOEVER WITHOUT FIRST OBTAINING THE WRITTEN PERMISSION AND CONSENT OF CEDAR CREEK CONSULTING INC. THIS SHEET IS NOT TO BE USED FOR CONSTRUCTION UNLESS THE ISSUE DATE IN THE TITLE BLOCK COINCIDES WITH OR POST DATES THE DRAWING DATE. ANY CHANGES MADE FROM THESE PLANS WITHOUT CONSENT OF CEDAR CREEK CONSULTING INC. ARE UNAUTHORIZED, AND SHALL RELIEVE CEDAR CREEK CONSULTING OF RESPONSIBILITY FOR ALL CONSEQUENCES ARRIVING OUT OF SUCH CHANGES.


THESE PLANS AND DRAWINGS ARE NOT TO BE

DRAWING TITLE:

COVER SHEET

CHEET.

C0.00

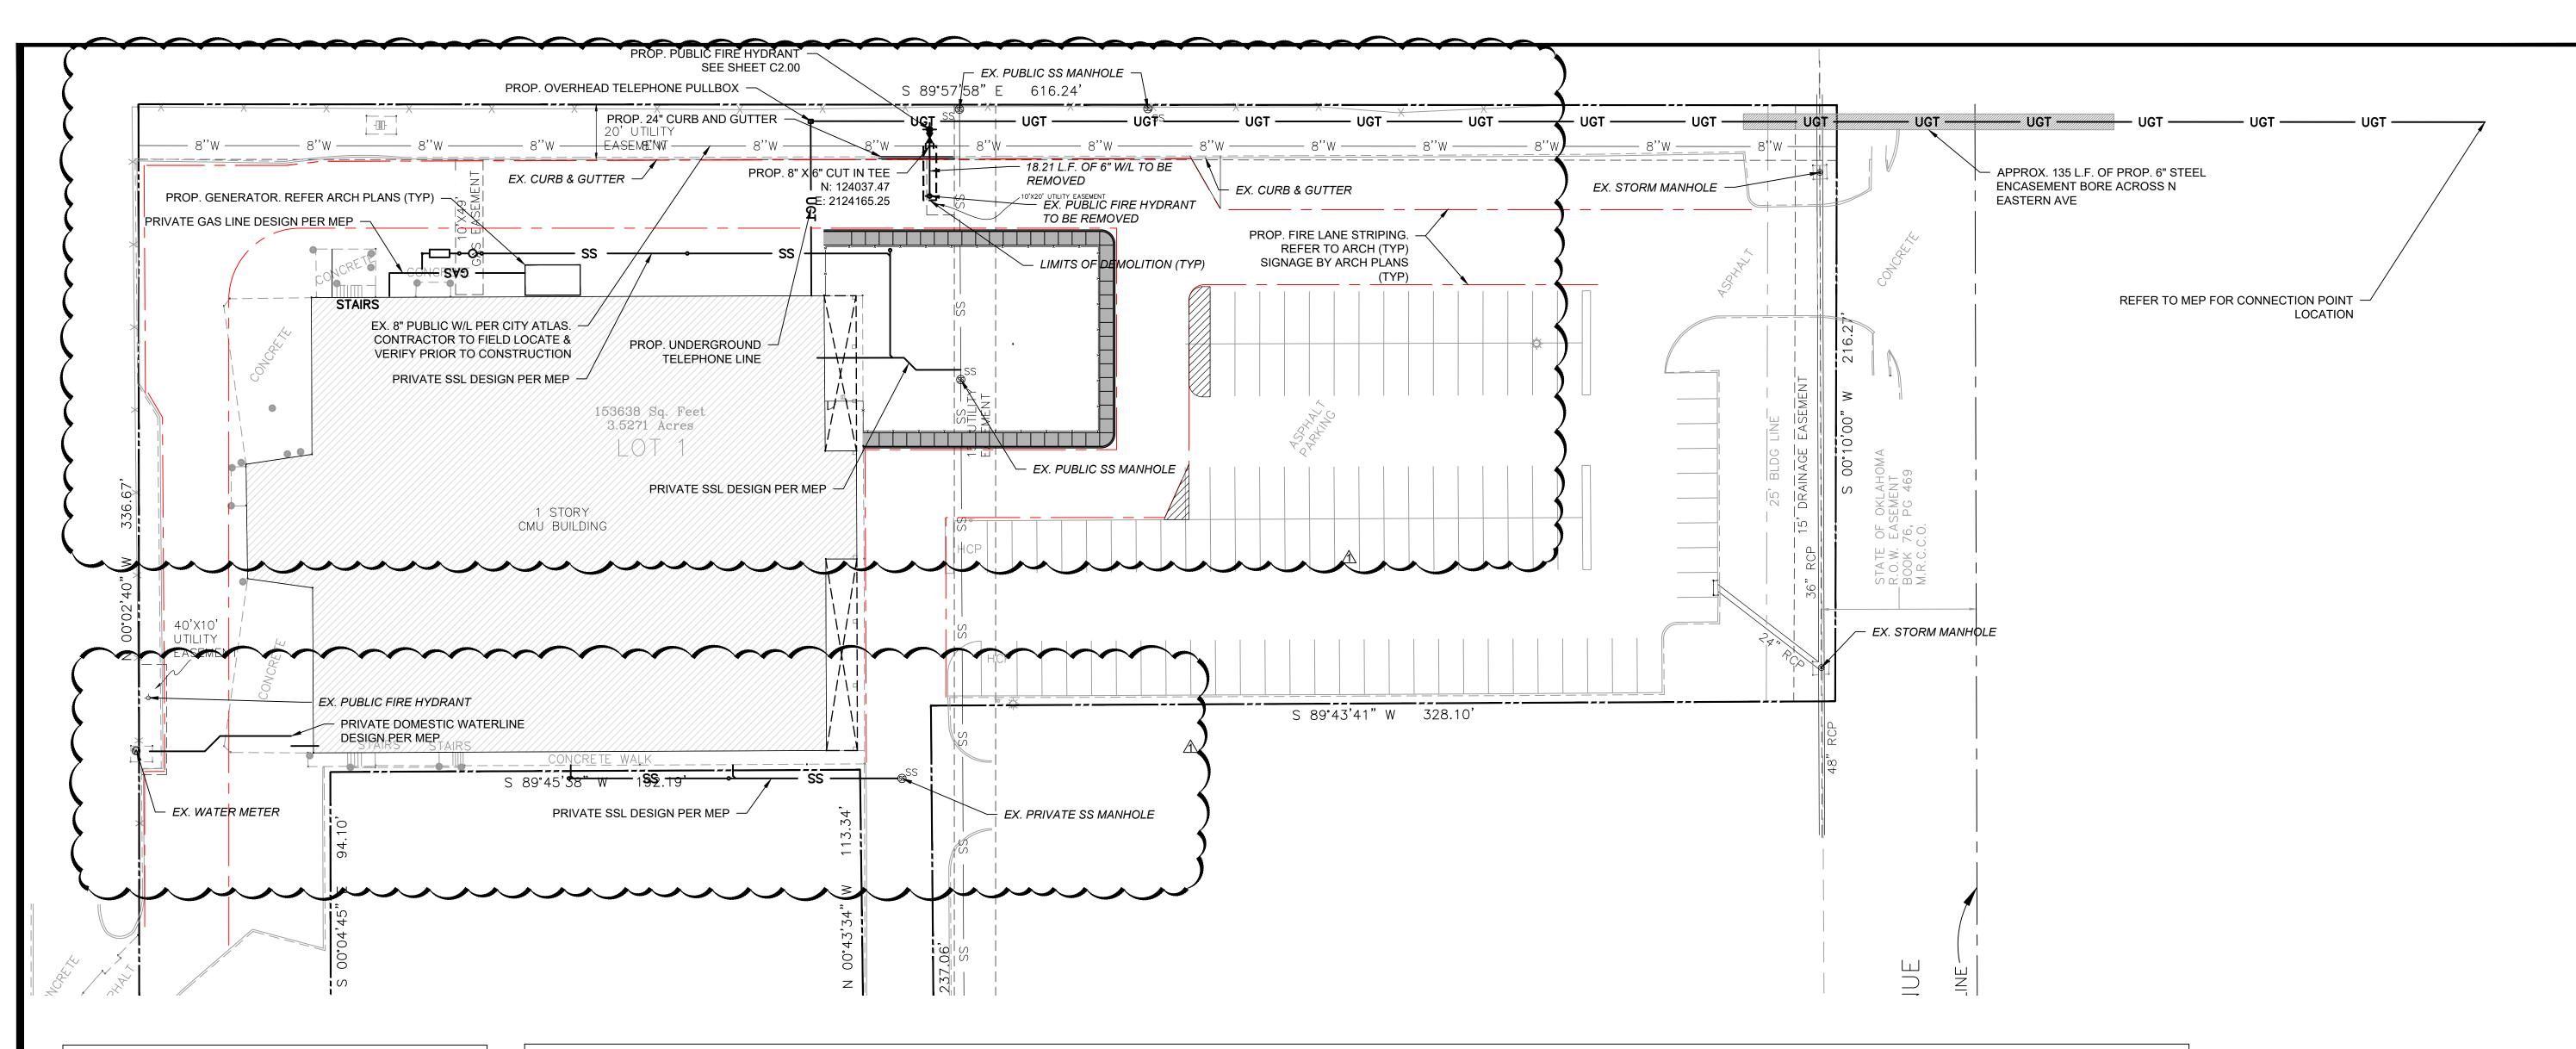

EXISTING 1' CONTOUR EXISTING 5' CONTOUR PROPOSED 1' CONTOUR PROPOSED 5' CONTOUR **BOUNDARY LINE** RIGHT OF WAY LINE EASEMENT LINE _____ EXISTING CURB AND GUTTER PROPOSED CURB AND GUTTER PROPOSED FIRE LANE STRIPING OVERHEAD ELECTRIC LINE UNDERGROUND ELECTRIC LINE UNDERGROUND TELEPHONE LINE UNDERGROUND FIBER OPTIC LINE

LEGEND

SANITARY SEWER LINE WATERLINE **RETAINING WALL** SCREEN WALL ____X___X___ WIRE FENCE _____ CHAIN LINK FENCE BENCHMARK

▲ PROP. GAS METER


- PROP. FIRE HYDRANT PROP. WHEEL STOP
- PROP. WATER VALVE ■ PROP. FES PROP. HC RAMP PROP. WATER METER
- PROP. ELECT. METER **Ø** PROP. POWER POLE **G** PROP. LIGHT POLE S PROP. SS MANHOLE
- PROP. TRANSFORMER TO PROP. SIGN PROP. PARKING COUNT
 O PROP. FIRE ROUTE SIGN
- PROP. INLETS (SEE GRADING PLAN FOR TYPE)
- VS: VERTICAL SEPARATION REQUIREMENT

PROP. BOLLARD

*NOTE: REFER TO SURVEYING LEGEND FOR EXISTING STRUCTURES IDENTIFICATION

UTILITY NOTES

- A. CONTRACTOR SHALL REFER TO THE CONSTRUCTION DOCUMENTS INCLUDING BUT NOT LIMITED TO THE WRITTEN SPECIFICATIONS. CONSTRUCTION DRAWINGS, STORM WATER POLLUTION PLAN, AND GEOTECHNICAL REPORT.
- B. ALL CONSTRUCTION SHALL BE IN STRICT ACCORDANCE WITH THE OWNERS DESIGN GUIDELINES AND SPECIFICATIONS, AND WHERE APPLICABLE SHALL MEET THE REQUIREMENTS OF THE GOVERNING/PERMITTING AUTHORITY HAVING JURISDICTION.
- C. CONTRACTOR IS RESPONSIBLE FOR THEIR OWN HORIZONTAL AND VERTICAL CONTROL, REFERENCE POINTS AND CONSTRUCTION STAKING AS INCIDENTAL TO THE PROJECT.
- D. THE CONTRACTOR SHALL FIELD VERIFY EXISTING ELEVATIONS/PROPERTY LINES/UTILITIES/DRAINAGE PRIOR TO CONSTRUCTION START.
- E. ALL WORK NOT CLASSIFIED AS A CONTRACT PAY ITEM SHALL BE CONSIDERED AS INCIDENTAL AND THE COST THEREOF SHALL BE INCLUDED IN THE UNIT PRICE BID FOR ITEMS WHICH ARE CLASSIFIED FOR PAYMENT.
- F. CONTRACTOR SHALL REFER TO THE ARCHITECTURAL AND MEP PLANS AND SPECIFICATIONS BEING A PART OF THE CONSTRUCTION DOCUMENTS FOR THE EXACT LOCATIONS AND DIMENSIONS OF ENTRY, EXIT PORCHES, PRECISE BUILDING DIMENSIONS, EXACT BUILDING UTILITY ENTRANCE, AND DOWNSPOUT LOCATIONS/SPECIFICATIONS/DETAILS.
- G. REFER TO ARCHITECTURE PLANS FOR SITE LIGHTING/LIGHT POLE BASES AND ELECTRICAL CONDUIT PLACEMENT AND SPECIFICATIONS. POLE LOCATIONS ARE SHOWN ON THIS SHEET FOR REFERENCE ONLY. IT IS THE CONTRACTOR'S RESPONSIBILITY TO IDENTIFY AND ADJUST ANY CONSTRUCTED CONFLICTS WITH UNDERGROUND UTILITIES, SIDEWALKS, ETC.
- H. CONTRACTOR IS REQUIRED TO CALL ONE CALL AS WELL AS THE APPROPRIATE UTILITY COMPANY AT LEAST 48 HOURS BEFORE ANY EXCAVATION/CONSTRUCTION ACTIVITIES TAKE PLACE. IT SHALL BE THE RESPONSIBILITY OF THE CONTRACTOR TO RELOCATE ALL EXISTING UTILITIES WHICH ARE IN CONFLICT WITH PROPOSED IMPROVEMENTS.
- CONTRACTOR SHALL ENSURE ALL CONSTRUCTED UTILITIES MEET THE MINIMUM SEPARATION AND COVER REQUIREMENTS SET FORTH BY THE PROVIDER, FEDERAL/STATE/LOCAL REGULATIONS, OR SPECIFICATIONS. IN THE EVENT THERE IS A CONFLICT THE MOST STRINGENT SHALL APPLY.
- J. GENERAL CONTRACTOR TO PROVIDE 2'X2'X6" THICK CONCRETE APRON AT ALL CLEANOUTS, VALVES AND METERS OUTSIDE OF BUILDING.
- K. GENERAL CONTRACTOR SHALL BE RESPONSIBLE FOR ALL TAP AND TIE ON FEES REQUIRED, AS WELL AS COST OF UNDERGROUND SERVICE CONNECTIONS TO THE BUILDINGS.
- L. THRUST BLOCKING SHALL BE PROVIDED AT ALL BENDS, TEES, AND FIRE HYDRANTS.
- M. DIMENSIONS SHOWN ARE TO CENTERLINE OF PIPE OR FITTING.
- N. ALL WATER AND SANITARY SEWER LEADS TO BUILDING SHALL END 5' OUTSIDE THE BUILDING LIMITS AS SHOWN ON PLAN AND SHALL BE PROVIDED WITH A TEMPORARY PLUG AT END.
- O. ALL FIRE HYDRANTS SHALL BE PROVIDED WITH AN APPROVED GATE VALVE A MAXIMUM OF 5'(UNLESS OTHERWISE SPECIFIED BY CITY OFFICIAL) FROM HYDRANT.
- P. CONTRACTOR SHALL COMPLY COMPLETELY WITH THE LATEST STANDARDS OF OSHA DIRECTIVES OR ANY OTHER AGENCY HAVING JURISDICTION FOR EXCAVATION AND TRENCHING PROCEDURES. THE CONTRACTOR SHALL USE SUPPORT SYSTEMS, SLOPING, BENCHING AND OTHER MEANS OF PROTECTION. THIS IS TO INCLUDE, BUT NOT LIMITED FOR ACCESS AND EGRESS FROM ALL EXCAVATION AND TRENCHING. CONTRACTOR IS RESPONSIBLE FOR COMPLYING WITH PERFORMANCE CRITERIA AS REQUIRED BY OSHA.
- Q. REFER TO FIRE PROTECTION SHEETS FOR LOCATION AND DETAIL OF FIRE LINE LEAD IN. FIRE LINE SHALL BE STUBBED UP 1' ABOVE FFE IN SPRINKLER ROOM.
- R. REFER TO PLUMBING SHEETS FOR LOCATION AND DETAILS OF SEWER, DOMESTIC, AND IRRIGATION CONNECTIONS.
- S. CONTRACTOR SHALL REFER TO IRRIGATION PLANS FOR ACTUAL LOCATION, SIZE, LENGTH AND DEPTH. TEMPORARILY PLUG BOTH ENDS. IRRIGATION CONTRACTOR WILL REMOVE TEMPORARY PLUGS, INSTALL LINES AND PROPERLY SEAL BOTH ENDS.
- T. THE FIRE DEPARTMENT CONNECTION (FDC) SHALL BE LOCATED ON THE STREET SIDE OF ANY STRUCTURE. THE FDC SHALL BE LOCATED AND ARRANGED SO THAT THE HOSE LINES CAN BE READILY ATTACHED TO THE INLETS WITHOUT INTERFERENCE FROM OBJECTS.
- U. IT IS THE CONTRACTOR'S RESPONSIBILITY TO COORDINATE THE EXTENSIONS OF ALL UTILITY SERVICE LINES TO THE MAIN UTILITY LINES.
- V. ALL CONDUIT SHALL BE SCHEDULE 40 PVC, UNLESS OTHERWISE NOTED.
- W. CONTRACTOR SHALL REFER TO LANDSCAPE AND IRRIGATION PLAN FOR LOCATION AND CONSTRUCTION DETAILS OF LANDSCAPING AND IRRIGATION.

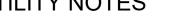



Engineering • Planning • Consulting

P.O. Box 14534 Oklahoma City, OK 73113

405-778-3385

www.cedarcreekinc.com

NE 12TH STREET

SE 4TH STREET

NOT TO SCALE

MPS DAYCARE

201 N. EASTERN **MOORE OK**

11.05.24

11.05.24

PROJECT NUMBER:

DRAWING DATE: ISSUE DATE:

PROJECT

LOCATION

LOCATION MAP:

PERMIT SET

| REV | ISIONS: | | |
|-------------|----------|-------|---|
| \triangle | 01.07.25 | CB #1 | |
| | | | _ |
| | | _ | _ |
| | | | _ |
| | | | - |
| | | | _ |
| | | | |

THESE PLANS AND DRAWINGS ARE NOT TO BE OR MANNER WHATSOEVER WITHOUT FIRST OBTAINING THE WRITTEN PERMISSION AND CONSEN F CEDAR CREEK CONSULTING INC. THIS SHEET IS NOT TO BE USED FOR CONSTRUCTION UNLESS THE ISSUE DATE IN THE TITLE BLOCK COINCIDES WITH OR POST DATES THE DRAWING DATE. ANY CHANGES MADE FROM THESE PLANS WITHOUT CONSENT OF CEDAR CREEK CONSULTING INC. ARE CONSULTING OF RESPONSIBILITY FOR ALL

CONSEQUENCES ARRIVING OUT OF SUCH CHANGES.

DRAWING TITLE:


UTILITY PLAN

WATERLINE '1'


10 STA. 10+00.00 CONST. (1) 8" X 6" CUT IN TEE W/ MECHANICAL JOINTS FL = 1241.37

11 STA. 10+03.00 CONST. (1) 6" GATE VALVE & BOX FL = 1241.37

12 STA. 10+06.00 CONST. (1) FIRE HYDRANT CONST. (1) FIRE HYDRANT RISER (IF NEEDED) FL=1241.37

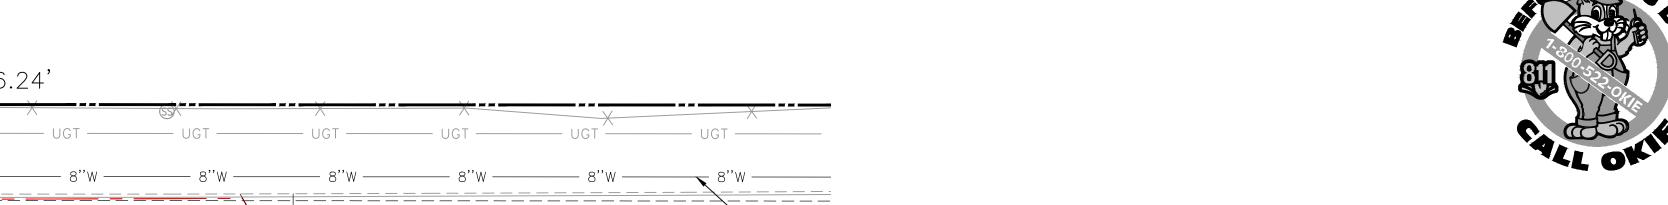




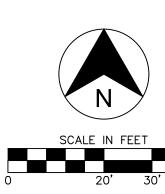


- SHALL BE PLACED AND COMPACTED IN SIX (6) INCH LIFTS FOR HAND-TAMPED EQUIPMENT AND THIRTY (30) INCH LIFTS FOR POWER-DRIVEN EQUIPMENT TO 95%
- CONTRACTOR SHALL FIELD LOCATE AND VERIFY

ENGINEERING • PLANNING • CONSULTING P.O. Box 14534 Oklahoma City, OK 73113 405-778-3385 www.cedarcreekinc.com OK CA 5864

LOCATION MAP:

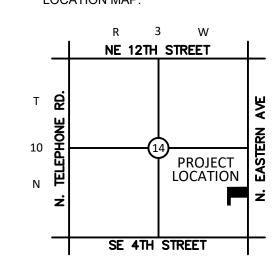

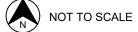

PROJECT:

MPS DAYCARE

201 N. EASTERN MOORE OK

PROJECT NUMBER: DRAWING DATE: 11.05.24 ISSUE DATE: 11.05.24



SUBMITTAL:

PERMIT SET

REVISIONS:


⚠ 01.07.25 CB #1

THESE PLANS AND DRAWINGS ARE NOT TO BE REPRODUCED, CHANGED OR COPIED IN ANY FORM OR MANNER WHATSOEVER WITHOUT FIRST OBTAINING THE WRITTEN PERMISSION AND CONSENT OF CEDAR CREEK CONSULTING INC. THIS SHEET IS NOT TO BE USED FOR CONSTRUCTION UNLESS THE ISSUE DATE IN THE TITLE BLOCK COINCIDES WITH OR POST DATES THE DRAWING DATE. ANY CHANGES MADE FROM THESE PLANS WITHOUT CONSENT OF CEDAR CREEK CONSULTING INC. ARE UNAUTHORIZED, AND SHALL RELIEVE CEDAR CREEK CONSULTING OF RESPONSIBILITY FOR ALL

CONSEQUENCES ARRIVING OUT OF SUCH CHANGES.

DRAWING TITLE:


WATERLINE '1' PLAN & **PROFILE**

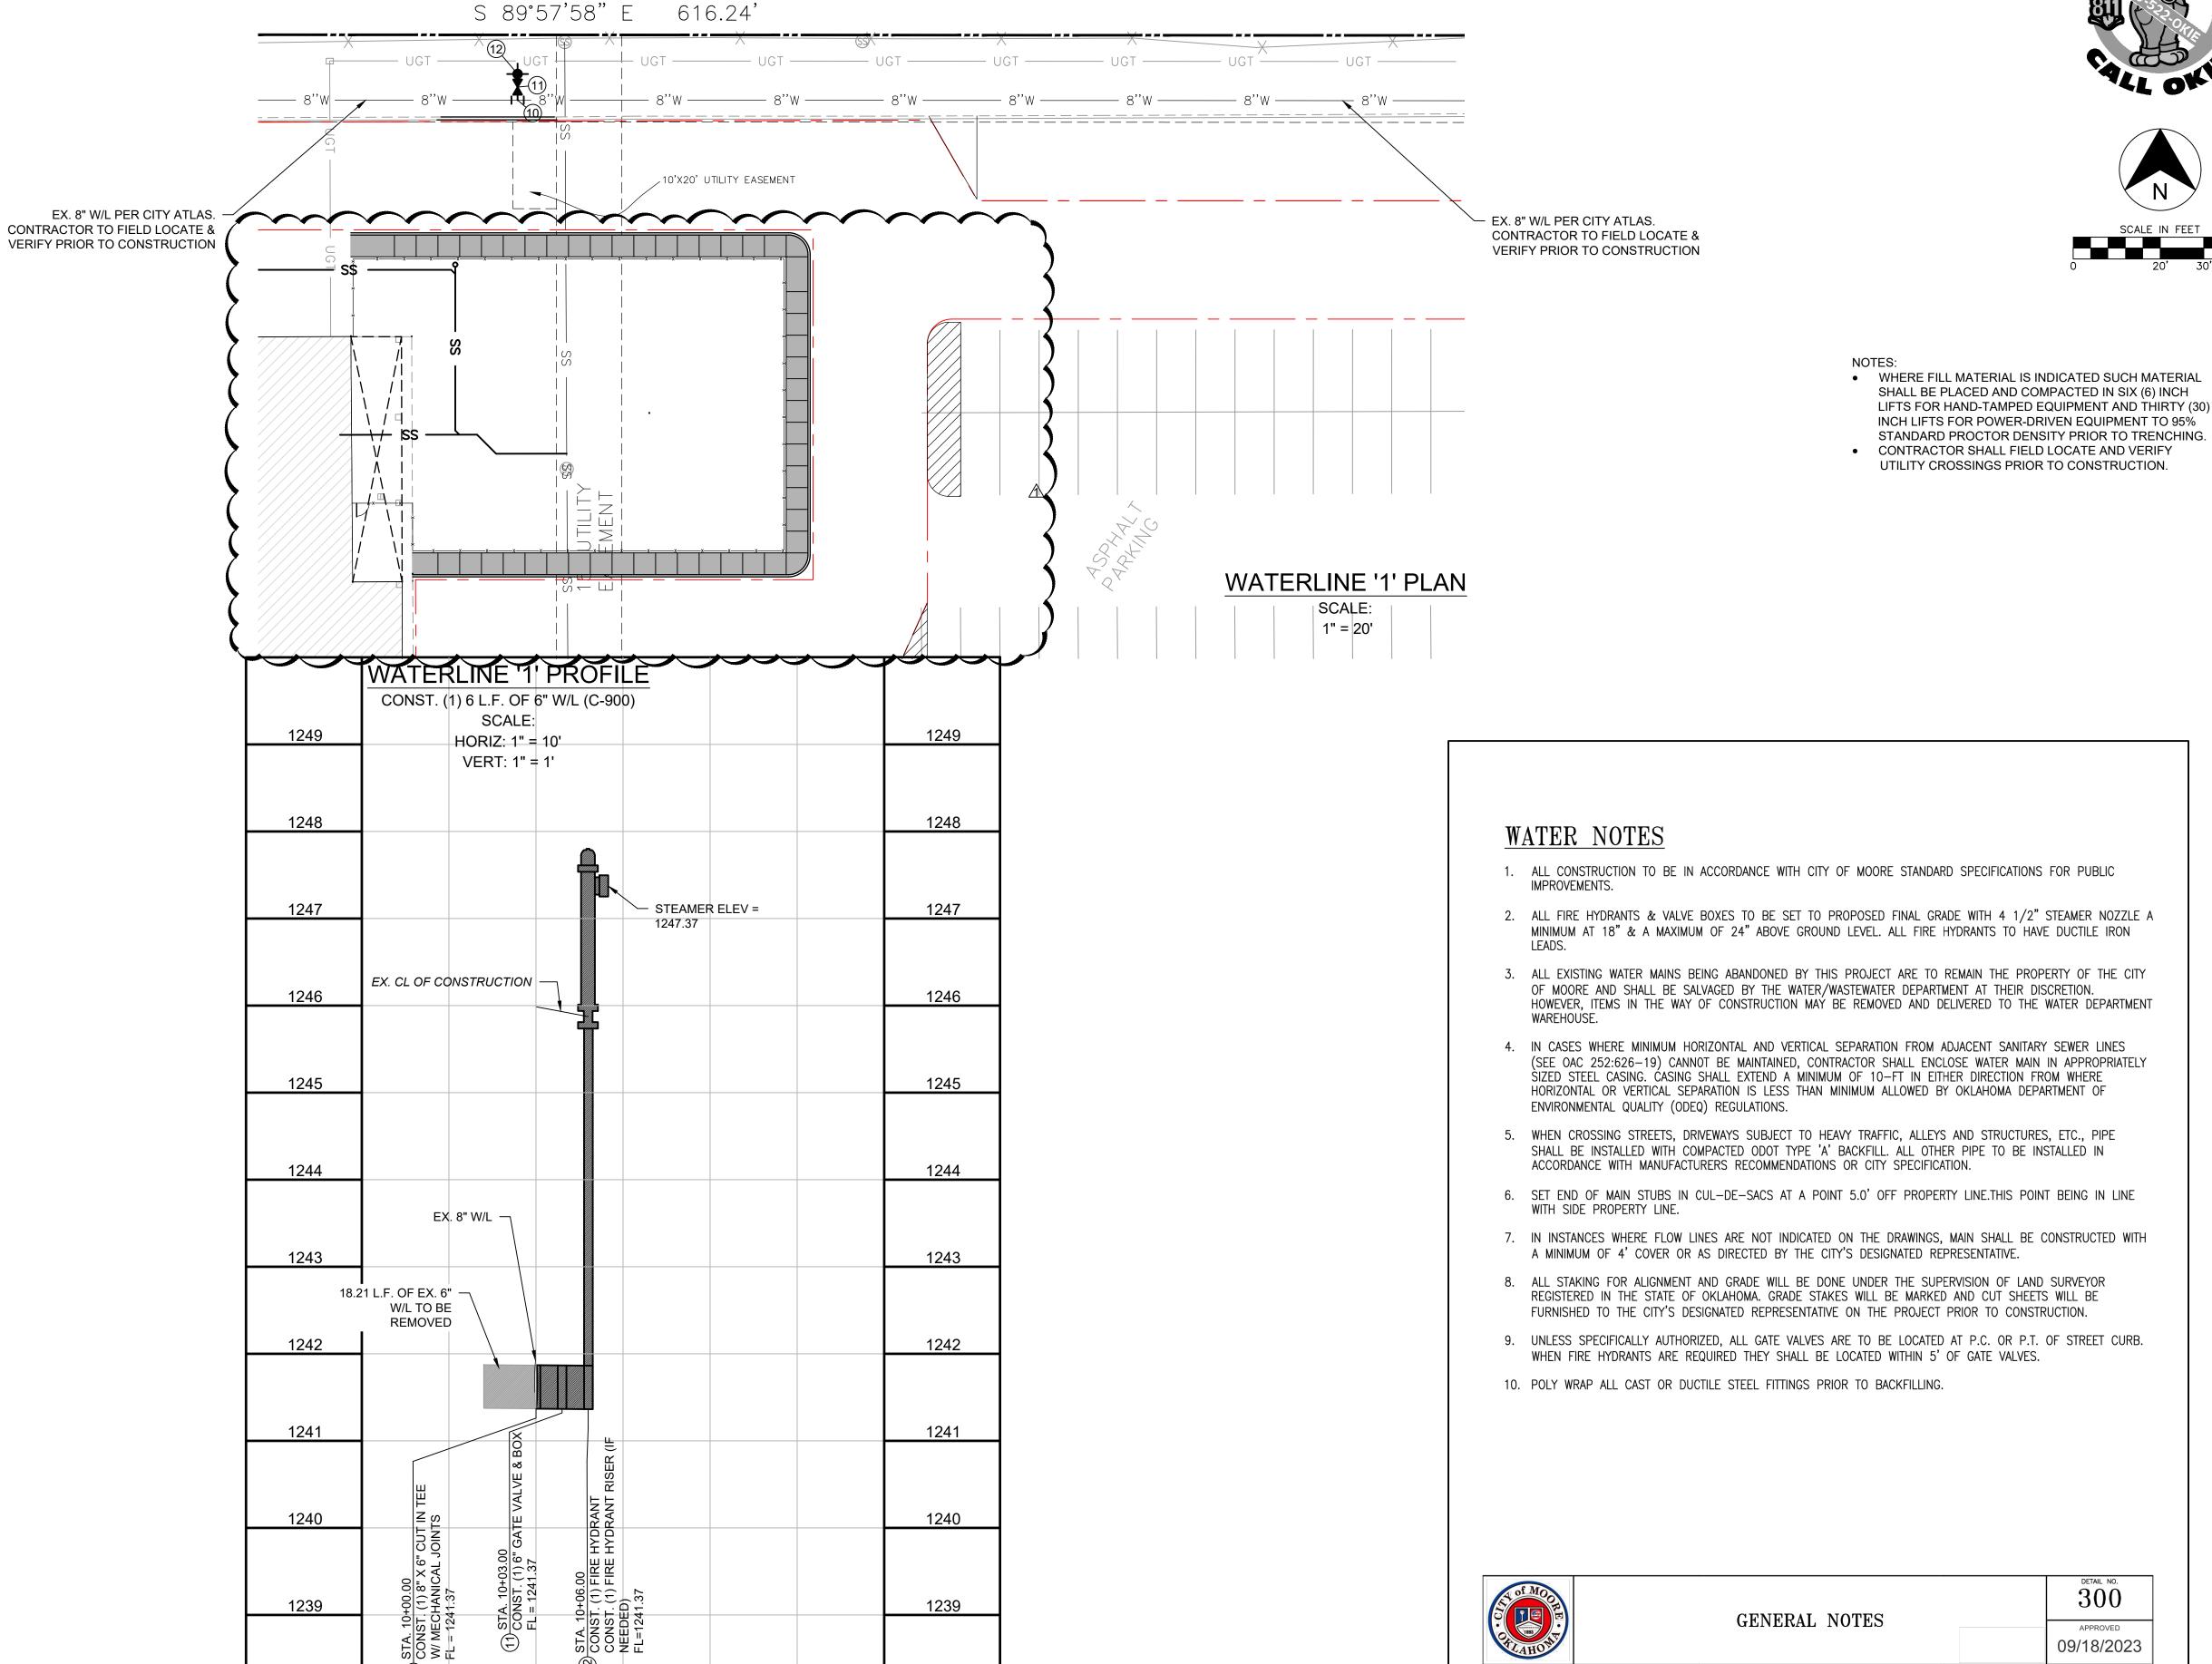


1238

10+20


10+30

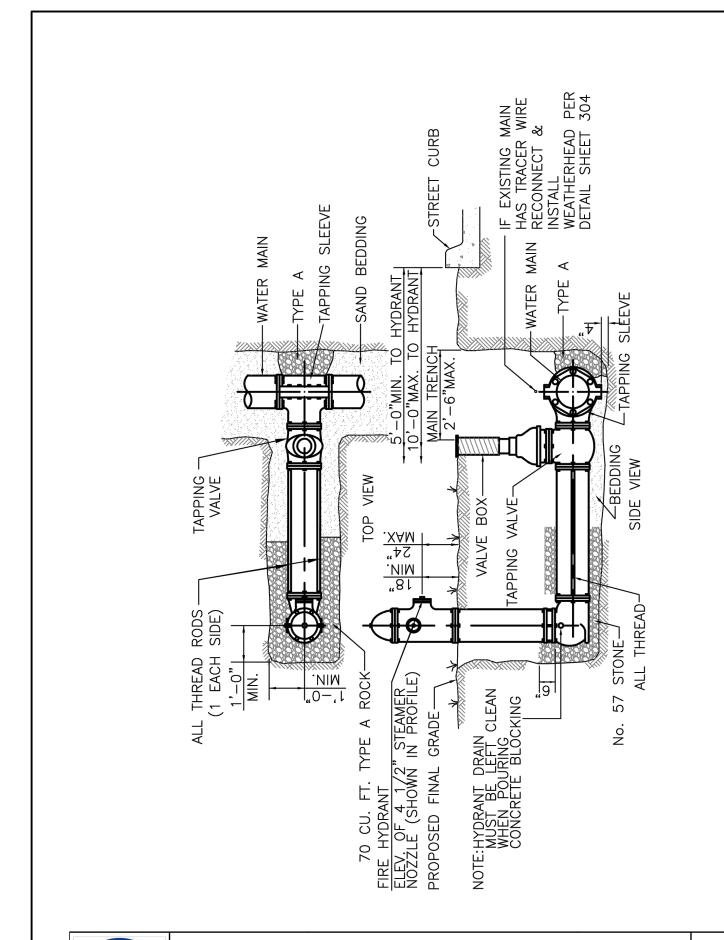

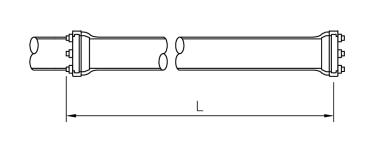

L = LENGTH TO BERESTRAINED.

| RESTRAINED | LENGTHS FOR DEAD ENDS |
|---------------------|------------------------|
| PIPE SIZE (INCH) | RESTRAINED LENGTH (FT) |
| 6 | 90 |
| 8 | 118 |
| 12 | 167 |
| 16 | 222 |

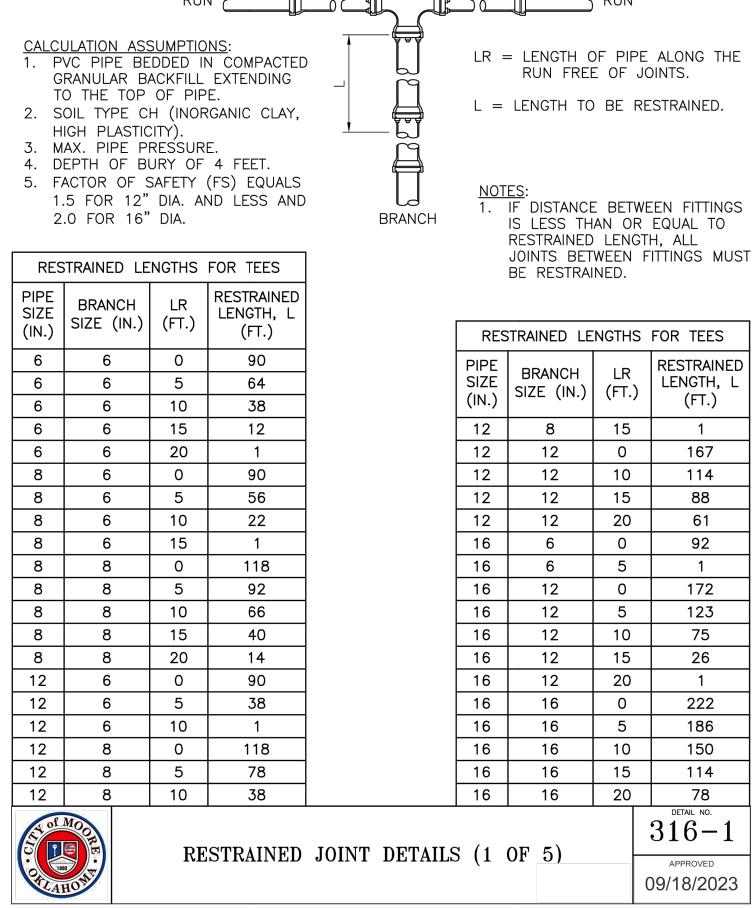




301 - 1

09/18/2023

RESTRAINED JOINT DETAILS (2 OF 5)


316-209/18/2023


09/18/2023

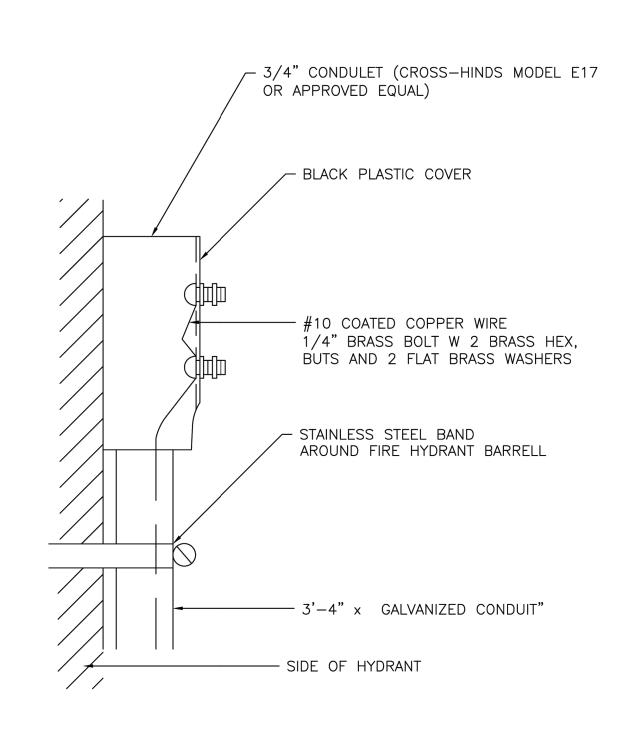


INSTALLATION OF HYDRANT ON EXISTING MAIN


| A Of MOOR | TRACER WIRE WEATHER HEAD DETAILS | 304 |
|-----------|----------------------------------|------------|
| CALAHONY | TRACER WIRE WEATHER HEAD DETAILS | 09/18/2023 |

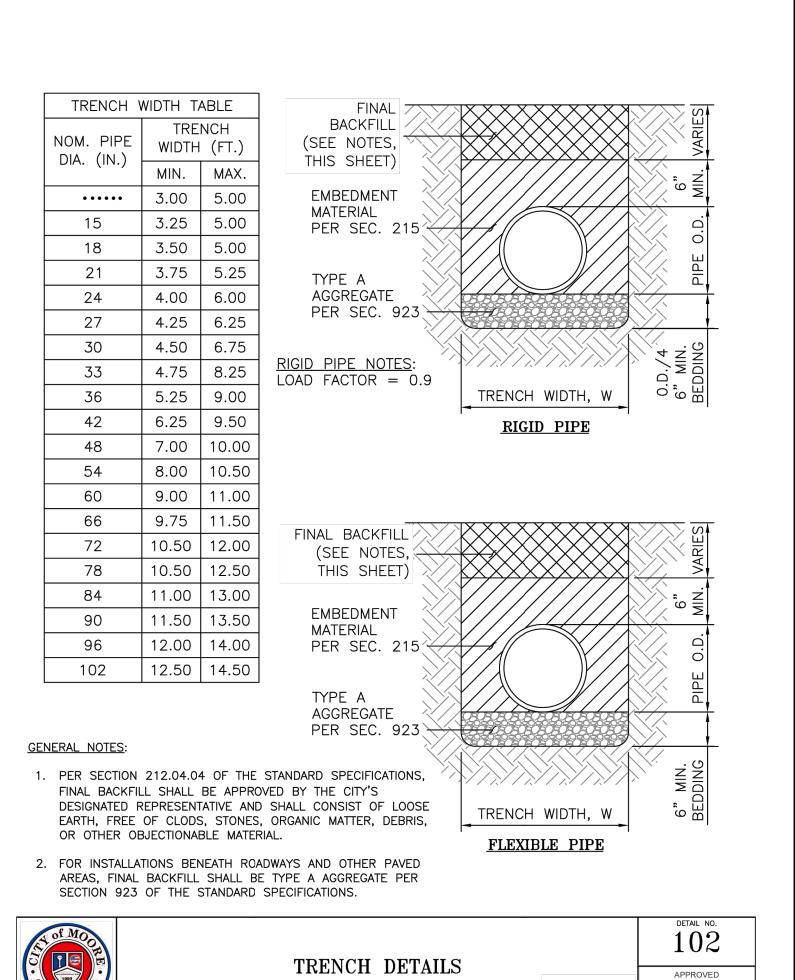

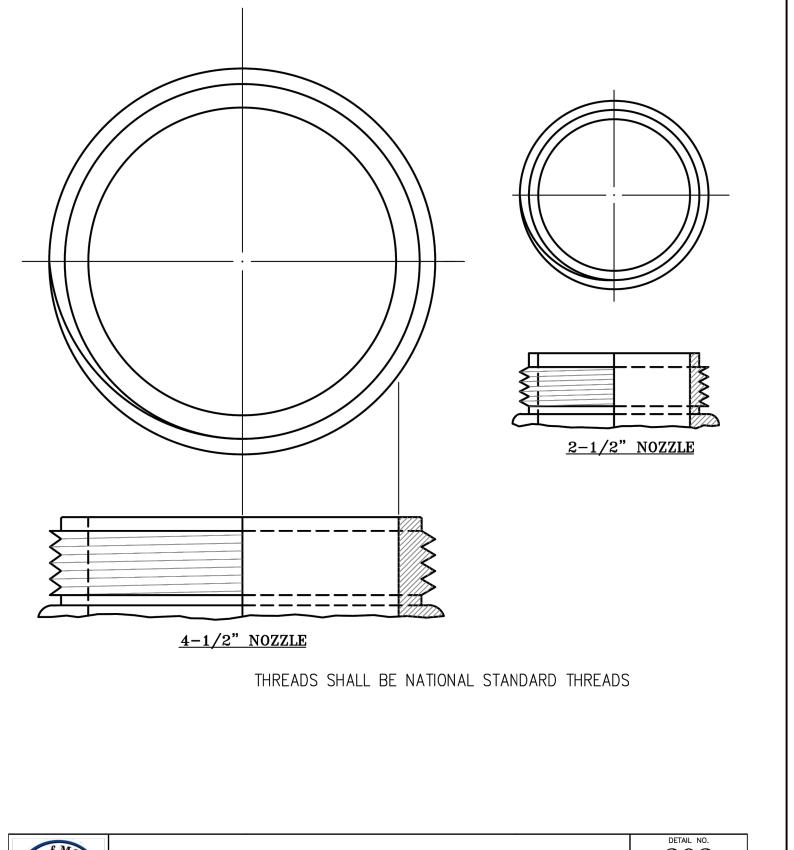

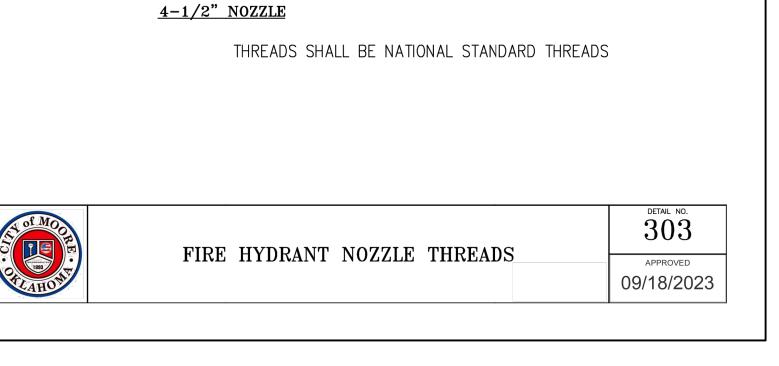



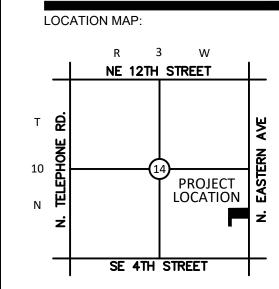

PROJECT:


MPS DAYCARE

201 N. EASTERN MOORE OK

11.05.24

11.05.24

PROJECT NUMBER: DRAWING DATE: ISSUE DATE:

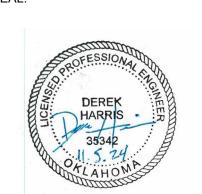

SUBMITTAL:


PERMIT SET


| | | |
|----------|-------------|--|
| | | |
| | | |
| DATE | DESCRIPTION | |

THESE PLANS AND DRAWINGS ARE NOT TO BE REPRODUCED, CHANGED OR COPIED IN ANY FORM OR MANNER WHATSOEVER WITHOUT FIRST OBTAINING THE WRITTEN PERMISSION AND CONSENT OF CEDAR CREEK CONSULTING INC. THIS SHEET IS NOT TO BE USED FOR CONSTRUCTION UNLESS THE ISSUE DATE IN THE TITLE BLOCK COINCIDES WITH OR POST DATES THE DRAWING DATE. ANY CHANGES MADE FROM THESE PLANS WITHOUT CONSENT OF CEDAR CREEK CONSULTING INC. ARE UNAUTHORIZED, AND SHALL RELIEVE CEDAR CREEK CONSULTING OF RESPONSIBILITY FOR ALL CONSEQUENCES ARRIVING OUT OF SUCH CHANGES.

DRAWING TITLE:

WATERLINE **DETAILS**

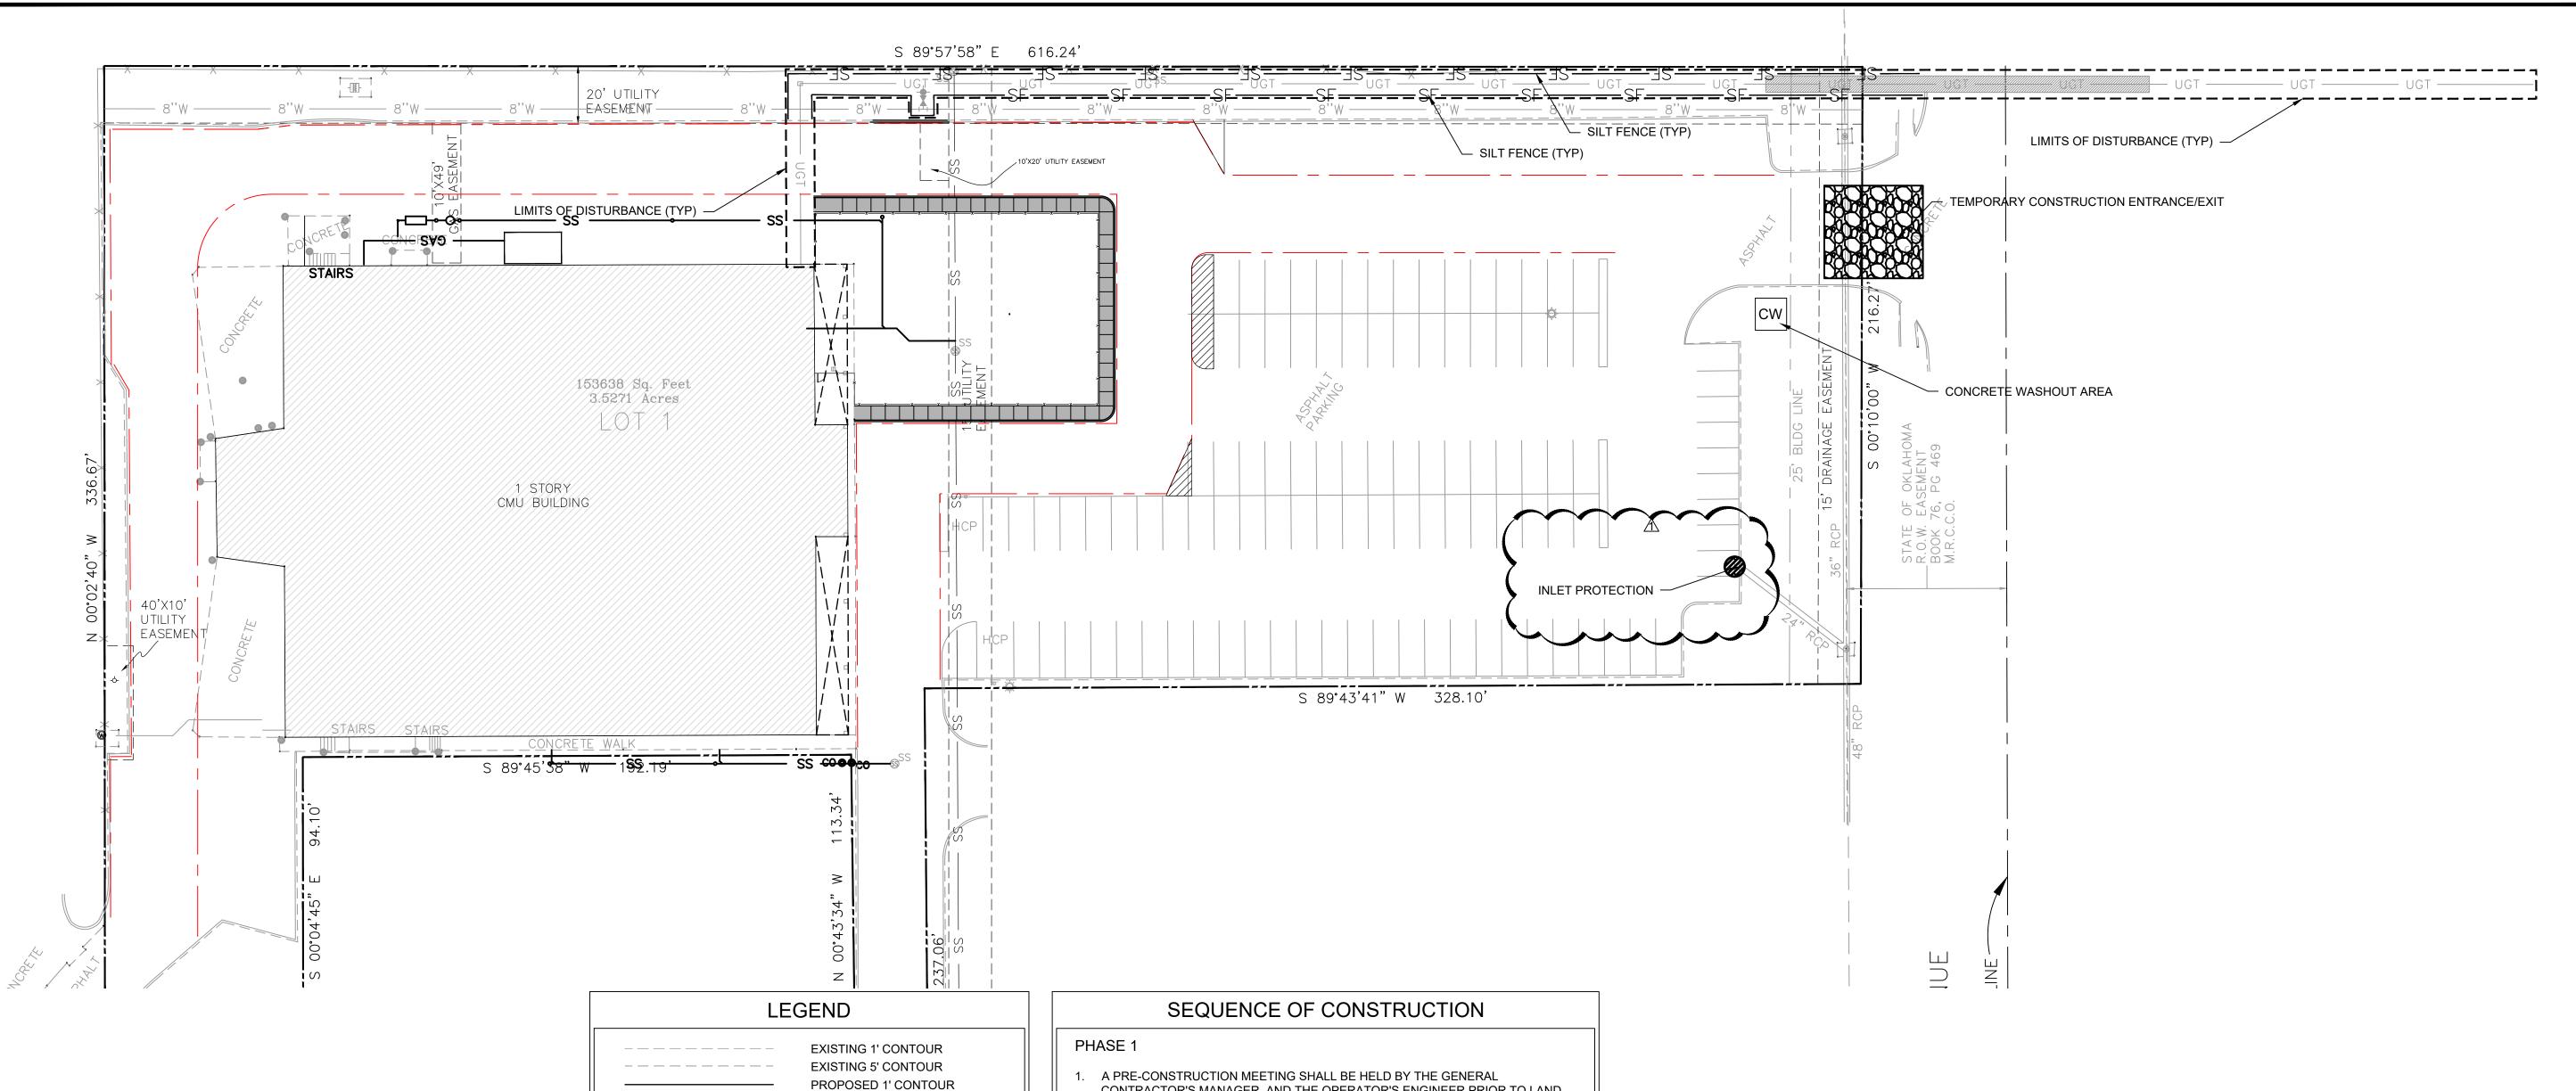

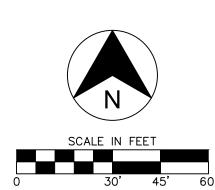

SITE DATA

TOTAL AREA OF CONSTRUCTION SITE: 0.156 (ACRES) TOTAL AREA TO BE DISTURBED: 0.156 (ACRES) CURRENT (EXISTING) IMPERVIOUS AREA: 0.029 (ACRES) POST-CONSTRUCTION IMPERVIOUS AREA: 0.029 (ACRES) POST CONSTRUCTION RUNOFF COEFFICIENT: 0.584 [IMPERVIOUS(0.95)]+PERVIOUS(.50)] \ OVERALL = C

- CONTRACTOR'S MANAGER, AND THE OPERATOR'S ENGINEER PRIOR TO LAND DISTURBING ACTIVITIES.
- 2. PREPARE AND PULL ALL NECESSARY PERMITS.
- CONSTRUCT TEMPORARY CONSTRUCTION EXITS AT LOCATIONS SHOWN ON THE SWPPP PLANS AND PREPARE TEMPORARY PARKING AND STORAGE AREA. UPON IMPLEMENTATION AND INSTALLATION OF THE FOLLOWING AREAS: TRAILER, PARKING, LAY DOWN, PORTA-POTTY, WELL WASH, CONCRETE WASHOUT, MASONS AREA, FUEL AND MATERIAL STORAGE CONTAINERS, SOLID WASTE CONTAINERS, ETC., DENOTE THEM ON THE SITE MAPS IMMEDIATELY AND NOTE ANY CHANGE IN THE LOCATIONS AS THEY OCCUR THROUGHOUT THE CONSTRUCTION PROCESS.
- CONSTRUCT THE SILT FENCES ON THE SITE. HALT ALL ACTIVITIES AND CONTACT THE CIVIL ENGINEERING CONSULTANT TO PERFORM INSPECTION AND CERTIFICATION OF BMP'S. GENERAL CONTRACTOR SHALL SCHEDULE AND CONDUCT STORMWATER PRE-CONSTRUCTION MEETING WITH ENGINEER AND ALL GROUND-DISTURBING CONTRACTORS BEFORE PROCEEDING WITH CONSTRUCTION.
- 5. INSTALL PUBLIC WATER, SEWER AND BOX CULVERT
- 6. DEMO, CLEAR AND GRUB THE SITE.
- 7. BEGIN GRADING THE SITE.
- 8. START CONSTRUCTION OF BUILDING PAD AND STRUCTURES.
- 9. DISTURBED AREAS OF THE SITE WHERE CONSTRUCTION ACTIVITY HAS CEASED FOR MORE THAN 14 DAYS SHALL BE TEMPORARILY SEEDED AND WATERED.

PHASE 2

PROPOSED 5' CONTOUR

EXISTING CURB AND GUTTER

OVERHEAD ELECTRIC LINE

SANITARY SEWER LINE

PROPOSED CURB AND GUTTER

PROPOSED FIRE LANE STRIPING

UNDERGROUND ELECTRIC LINE

UNDERGROUND TELEPHONE LINE

UNDERGROUND FIBER OPTIC LINE

BOUNDARY LINE

EASEMENT LINE

GAS LINE

WATERLINE

RETAINING WALL

CHAIN LINK FENCE

PROP. FES

PROP. HC RAMP

PROP. WHEEL STOP

Ø PROP. POWER POLE

S PROP. SS MANHOLE

▲ PROP. GAS METER

LIMITS OF DISTURBANCE

INLET PROTECTION

TEMPORARY DIVERSION DIKE

CONCRETE WASHOUT AREA

SCREEN WALL

WIRE FENCE

BENCHMARK

=========

----- OHE -----

____X____X____

→ PROP. FIRE HYDRANT

PROP. WATER VALVE

PROP. WATER METER

■ PROP. ELECT. METER

_____ TD-->>_____

STRUCTURES IDENTIFICATION

*NOTE: REFER TO SURVEYING LEGEND FOR EXISTING

© PROP. PARKING COUNT O PROP. FIRE ROUTE SIGN

PROP. INLETS (SEE GRADING PLAN FOR TYPE)

SILT FENCE

SODDING

PROP. LIGHT POLE

O PROP. BOLLARD

RIGHT OF WAY LINE

- 1. INSTALL UTILITIES, UNDER DRAINS, STORM SEWERS, CURB AND GUTTERS.
- 2. INSTALL INLET PROTECTION DEVICES.
- 3. INSTALL RIP RAP AROUND OUTLET STRUCTURES.
- 4. FINALIZE PAVEMENT SUBGRADE PREPARATION.
- 5. INSTALL BASE MATERIAL AS REQUIRED FOR PAVEMENT.
- 6. PAVE LOT.
- 7. REMOVE TEMPORARY CONSTRUCTION EXITS ONLY PRIOR TO PAVEMENT CONSTRUCTION IN THESE AREAS. (THESE AREAS TO BE PAVED LAST)
- 8. DISTURBED AREAS OF THE SITE WHERE CONSTRUCTION ACTIVITY HAS CEASED FOR MORE THAN 14 DAYS SHALL BE TEMPORARILY SEEDED AND WATERED.
- 9. FINE GRADE AND INSTALL PERMANENT SEEDING AND PLANTINGS.
- 10. REMOVE ALL TEMPORARY EROSION AND SEDIMENT CONTROLS DEVISED. (ONLY IF SITE IS STABILIZED)
- 11. REMOVE INLET PROTECTIONS AROUND INLETS AND MANHOLES NO MORE THAN 48 HOURS PRIOR TO PLACING STABILIZED BASE COURSE.


EROSION CONTROL NOTES


- SEDIMENT BASINS ARE ATTRACTIVE TO CHILDREN AND CAN BE VERY DANGEROUS. IN ALL CASES, LOCAL ORDINANCES AND REGULATIONS REGARDING HEALTH AND SAFETY MUST BE ADHERED TO.
- B. ALL CONTRACTORS AND SUBCONTRACTORS INVOLVED WITH STORM WATER POLLUTION PREVENTION SHALL OBTAIN A COPY OF THE STORM WATER POLLUTION PREVENTION PLAN AND THE STATE OF OKLAHOMA NATIONAL POLLUTANT DISCHARGE ELIMINATION SYSTEM GENERAL PERMIT (NPDES PERMIT) AND BECOME FAMILIAR WITH THEIR CONTENTS.
- C. ALL TEMPORARY EROSION AND SEDIMENT CONTROL MEASURES SHALL BE DISPOSED OF WITHIN 30 DAYS AFTER FINAL STABILIZATION. FINAL STABILIZATION HAS OCCURRED WHEN ALL SOIL DISTURBING ACTIVITIES ARE COMPLETED AND A UNIFORM PERENNIAL VEGETATIVE COVER WITH A DENSITY OF 70% OF THE COVER FOR UNPAVED AREAS AND AREAS NOT COVERED BY PERMANENT STRUCTURES HAS BEEN EMPLOYED.
- BEST MANAGEMENT PRACTICES (BMP'S) AND CONTROLS SHALL CONFORM TO FEDERAL, STATE, OR LOCAL REQUIREMENTS OR MANUAL OF PRACTICE, AS APPLICABLE CONTRACTOR SHALL IMPLEMENT ADDITIONAL CONTROLS AS DIRECTED BY PERMITTING AGENCY OR OWNER.
- CONTRACTOR SHALL MINIMIZE CLEARING TO THE MAXIMUM EXTENT PRACTICAL OR AS REQUIRED BY THE GENERAL PERMIT.
- GENERAL CONTRACTOR SHALL DENOTE ON PLAN THE TEMPORARY PARKING AND STORAGE AREA WHICH SHALL ALSO BE USED AS THE EQUIPMENT MAINTENANCE AND CLEANING AREA, EMPLOYEE PARKING AREA, AND AREA FOR LOCATING PORTABLE FACILITIES, OFFICE TRAILERS, AND TOILET FACILITIES.
- G. ALL WASH WATER (CONCRETE TRUCKS, VEHICLE CLEANING, EQUIPMENT CLEANING, ETC.) SHALL BE DETAINED AND PROPERLY TREATED OR DISPOSED.
- SUFFICIENT OIL AND GREASE ABSORBING MATERIALS AND FLOTATION BOOMS SHALL BE MAINTAINED ON SITE OR READILY AVAILABLE TO CONTAIN AND CLEAN-UP FUEL OR CHEMICAL SPILLS AND LEAKS.
- DUST ON THE SITE SHALL BE CONTROLLED. THE USE OF MOTOR OILS AND OTHER PETROLEUM BASED OR TOXIC LIQUIDS FOR DUST SUPPRESSION OPERATIONS IS PROHIBITED.
- RUBBISH, TRASH, GARBAGE, LITTER, OR OTHER SUCH MATERIALS SHALL BE DEPOSITED INTO SEALED CONTAINERS. MATERIALS SHALL BE PREVENTED FROM LEAVING THE PREMISES THROUGH THE ACTION OF WIND OR STORMWATER DISCHARGE INTO DRAINAGE DITCHES OR WATERS OF THE STATE.
- K. ALL STORM WATER POLLUTION PREVENTION MEASURES PRESENTED ON THIS PLAN, AND IN THE STORM WATER POLLUTION PREVENTION PLAN. SHALL BE INITIATED AS SOON AS PRACTICABLE.

- L. DISTURBED PORTIONS OF THE SITE WHERE CONSTRUCTION ACTIVITY HAS STOPPED FOR AT LEAST 14 DAYS, SHALL BE TEMPORARILY SEEDED. THESE AREAS SHALL BE SEEDED NO LATER THAN 14 DAYS FROM THE LAST CONSTRUCTION ACTIVITY OCCURRING IN THESE AREAS.
- M. DISTURBED PORTIONS OF THE SITE WHERE CONSTRUCTION ACTIVITY HAS PERMANENTLY STOPPED SHALL BE PERMANENTLY SEEDED. THESE AREAS SHALL BE SEEDED NO LATER THAN 14 DAYS AFTER THE LAST CONSTRUCTION ACTIVITY OCCURRING IN THESE AREAS. REFER TO THE GRADING PLAN AND/OR LANDSCAPE PLAN.
- N. IF THE ACTION OF VEHICLES TRAVELING OVER THE GRAVEL CONSTRUCTION ENTRANCES IS NOT SUFFICIENT TO REMOVE THE MAJORITY OF DIRT OR MUD, THEN THE TIRES MUST BE WASHED BEFORE THE VEHICLES ENTER A PUBLIC ROAD. IF WASHING IS USED, PROVISIONS MUST BE MADE TO INTERCEPT THE WASH WATER AND TRAP THE SEDIMENT BEFORE IT IS CARRIED OFF THE SITE.
- O. ALL MATERIALS SPILLED, DROPPED, WASHED, OR TRACKED FROM VEHICLES ONTO ROADWAYS OR INTO STORM DRAINS MUST BE REMOVED IMMEDIATELY.
- P. CONTRACTORS OR SUBCONTRACTORS WILL BE RESPONSIBLE FOR REMOVING SEDIMENT IN THE DETENTION POND AND ANY SEDIMENT THAT MAY HAVE COLLECTED IN THE STORM SEWER DRAINAGE SYSTEMS IN CONJUNCTION WITH THE STABILIZATION OF THE SITE.
- Q. ON-SITE & OFFSITE SOIL STOCKPILE AND BORROW AREAS SHALL BE PROTECTED FROM EROSION AND SEDIMENTATION THROUGH IMPLEMENTATION OF BEST MANAGEMENT PRACTICES. STOCKPILE AND BORROW AREA LOCATIONS SHALL BE NOTED ON THE SITE PLAN AND PERMITTED IN ACCORDANCE WITH GENERAL PERMIT REQUIREMENTS.
- R. SLOPES SHALL BE LEFT IN A ROUGHENED CONDITION DURING THE GRADING PHASE TO REDUCE RUNOFF VELOCITIES AND EROSION.
- S. DUE TO THE GRADE CHANGES DURING THE DEVELOPMENT OF THE PROJECT, THE CONTRACTOR SHALL BE RESPONSIBLE FOR ADJUSTING THE EROSION CONTROL MEASURES (SILT FENCES, STRAW BALES, ETC.) TO PREVENT EROSION.
- T. ALL CONSTRUCTION SHALL BE STABILIZED AT THE END OF EACH WORKING DAY, THIS INCLUDES BACKFILLING OF TRENCHES FOR UTILITY CONSTRUCTION AND PLACEMENT OF GRAVEL OR BITUMINOUS PAVING FOR ROAD CONSTRUCTION.
- U. A 3' STRIP OF SOD SHALL BE PLACED ALONG THE EDGE OF ALL PAVING TO ACT AS A SEDIMENT BUFFER AND AID IN THE ESTABLISHMENT OF VEGETATION.



LOCATION MAP:

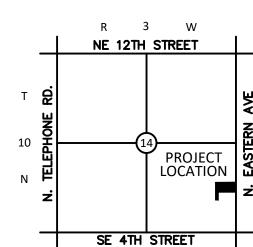


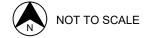

MPS DAYCARE

201 N. EASTERN **MOORE OK**

PROJECT NUMBER: DRAWING DATE: 11.05.24 ISSUE DATE: 11.05.24

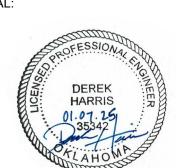

SUBMITTAL: PERMIT SET

| ΞVI | SI | ЛС | IS: | |
|-----|----|----|-----|--|

↑ 01.07.25 CB #1


| | |
|------|--|
| | |
| | |
THESE PLANS AND DRAWINGS ARE NOT TO BE REPRODUCED, CHANGED OR COPIED IN ANY FORM OR MANNER WHATSOEVER WITHOUT FIRST OBTAINING THE WRITTEN PERMISSION AND CONSENT F CEDAR CREEK CONSULTING INC. THIS SHEET IS NOT TO BE USED FOR CONSTRUCTION UNLESS THE ISSUE DATE IN THE TITLE BLOCK COINCIDES WITH OR OST DATES THE DRAWING DATE. ANY CHANGES MADE FROM THESE PLANS WITHOUT CONSENT OF CEDAR CREEK CONSULTING INC. ARE CONSULTING OF RESPONSIBILITY FOR ALL


CONSEQUENCES ARRIVING OUT OF SUCH CHANGES.

DRAWING TITLE:

EROSION

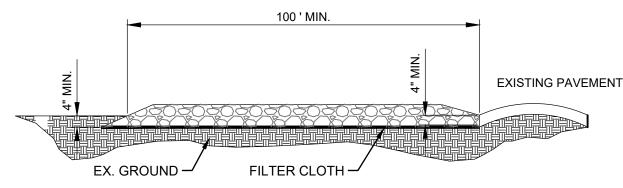


SIDE ELEVATION

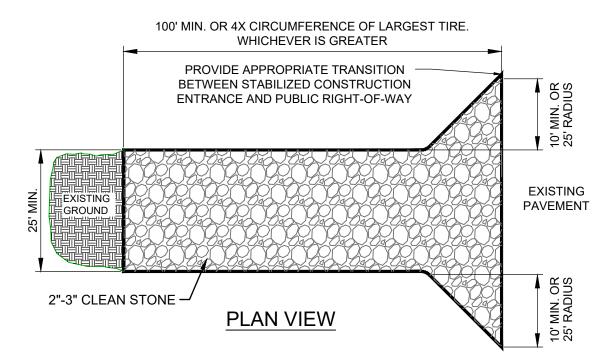


- 1. STONE USE COARSE AGGREGATE (2 3 INCH STONE)
- 2. LENGTH AS EFFECTIVE, BUT NOT LESS THAN 100 FEET.
- 3. THICKNESS NOT LESS THAN EIGHT (8) INCHES.
- 4. WIDTH NOT LESS THAN FULL WIDTH OF ALL POINTS OF INGRESS OR EGRESS.
- 5. WASHING WHEN NECESSARY, WHEELS SHALL BE CLEANED TO REMOVE SEDIMENT PRIOR TO ENTRANCE ONTO PUBLIC RIGHT-OF-WAY. WHEN WASHING IS REQUIRED, IT SHALL BE DONE ON AN AREA STABILIZED WITH CRUSHED STONE WHICH DRAINS INTO AN APPROVED SEDIMENT TRAP OR SEDIMENT BASIN. ALL SEDIMENT SHALL BE PREVENTED FROM ENTERING ANY STORM DRAIN, DITCH, OR WATERCOURSE THROUGH USE OF SAND BAGS, GRAVEL, BOARDS OR OTHER APPROVED METHODS.
- 6. MAINTENANCE THE ENTRANCE SHALL BE MAINTAINED IN A CONDITION WHICH WILL PREVENT TRACKING OR FLOWING OF SEDIMENT ONTO PUBLIC RIGHT-OF-WAY. THIS MAY REQUIRE PERIODIC TOP DRESSING WITH ADDITIONAL STONE AS CONDITIONS DEMAND AND REPAIR AND/OR CLEANOUT OF ANY MEASURES USED TO TRAP SEDIMENT. ALL SEDIMENT SPILLED, DROPPED, WASHED OR TRACKED ONTO PUBLIC RIGHTS-OF-WAY MUST BE REMOVED IMMEDIATELY.
- 7. 12' X 24' METAL GRATE MAY BE USED. GRATE SHALL BE 25' AWAY FROM PAVEMENT AND APPROPRIATE SEDIMENT CONTROL TRAPPING DEVICE SHALL BE USED AT GRATE OUTLET POINT.

STABILIZED CONSTRUCTION ENTRANCE

NOT TO SCALE

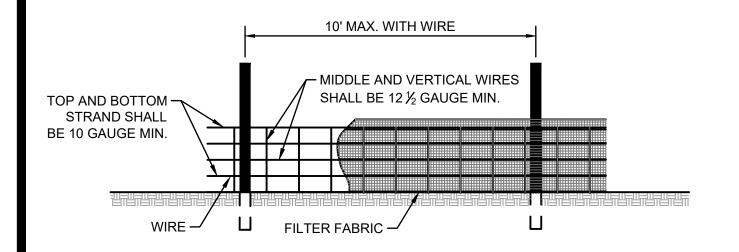

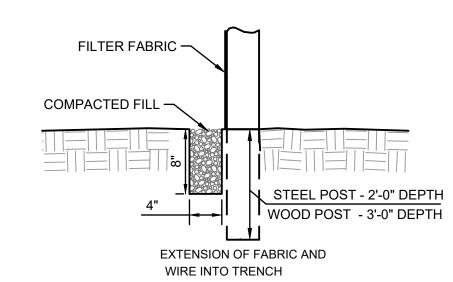

NOTES:


- 1. WIRE SHALL BE A MINIMUM OF 32" IN WIDTH AND SHALL HAVE A MINIMUM OF 6
- LINE WIRES WITH 12" STAY SPACING.
- 2. FILTER FABRIC SHALL BE A MINIMUM OF 36" IN WIDTH AND SHALL BE


SILT FENCE DETAIL

FASTENED ADEQUATELY TO THE WIRE.

NOT TO SCALE

- 3. STEEL POST SHALL BE 5'-0" IN HEIGHT AND BE OF THE SELF-FASTENER ANGLE STEEL TYPE.
- 4. WOOD POST SHALL BE 6'-0" IN HEIGHT AND 3" IN DIAMETER.

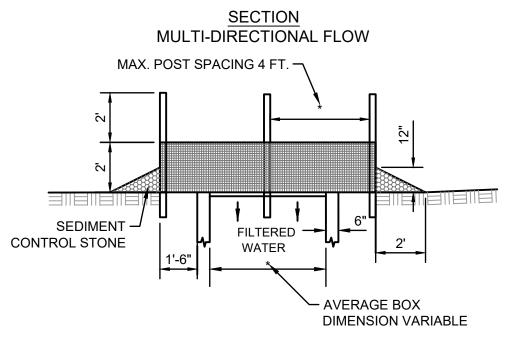


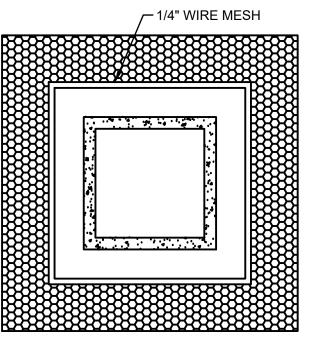

MULTI-DIRECTIONAL FLOW


- 1. SEDIMENT CONTROL STONE SHALL BE 3/4" WASHED STONE.
- 2. WIRE MESH SHALL BE HARDWARE CLOTH 23 GAUGE MIN. AND SHALL HAVE 1/4 INCH MESH OPENINGS.
- 3. TOP OF WIRE MESH SHALL BE A MINIMUM OF ONE FOOT BELOW THE SHOULDER OR ANY DIVERSION POINT.
- 4. STEEL POST SHALL BE 5 FT. IN HEIGHT, BE INSTALLED 1.5 FT. DEEP
- MINIMUM, AND BE OF THE SELF-FASTENER ANGLE STEEL TYPE. 5. WOOD POST SHALL BE 6 FT. IN HEIGHT, BE INSTALLED TO 1.5 FT.
- DEEP MINIMUM, AND BE 3 INCHES IN DIAMETER.
- 6. POST SPACING SHALL BE A MAXIMUM OF 4 FT.

INLET PROTECTION DETAIL

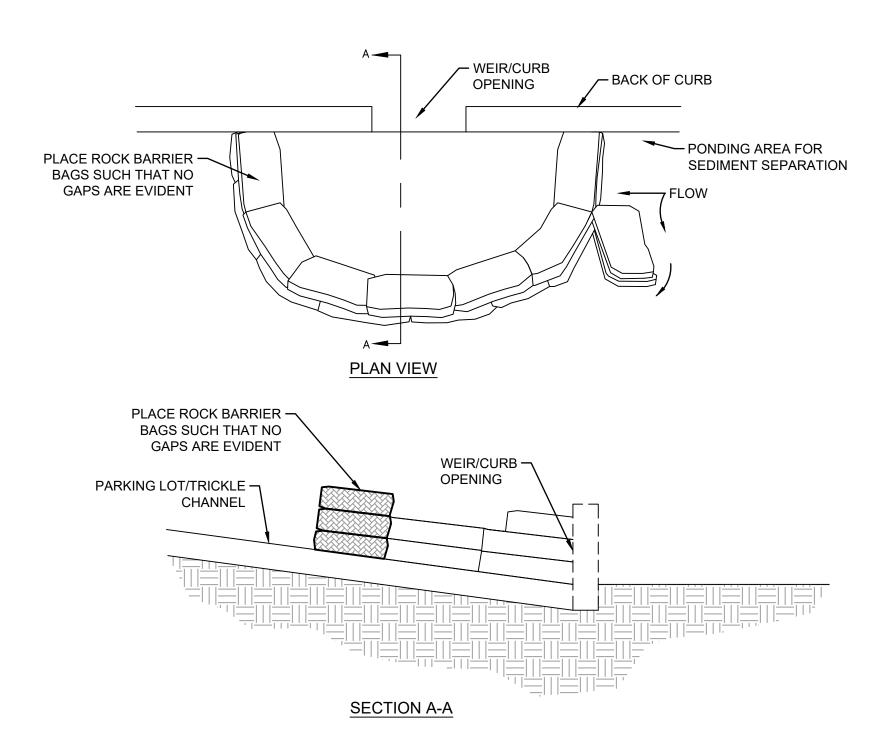

CURB INLET PROTECTION DETAIL


NOT TO SCALE

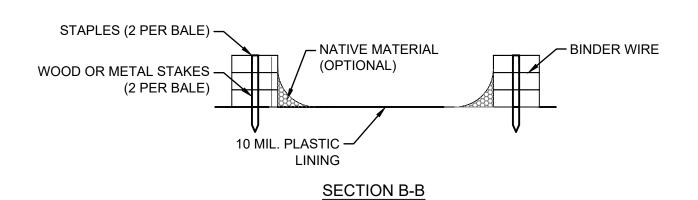


10' MIN.

TYPE 'ABOVE GRADE' WITH STRAW BALES

CONCRETE WASHOUT SIGN DETAIL

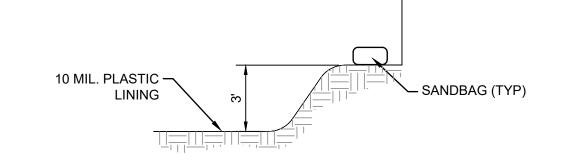

SECTION A-A

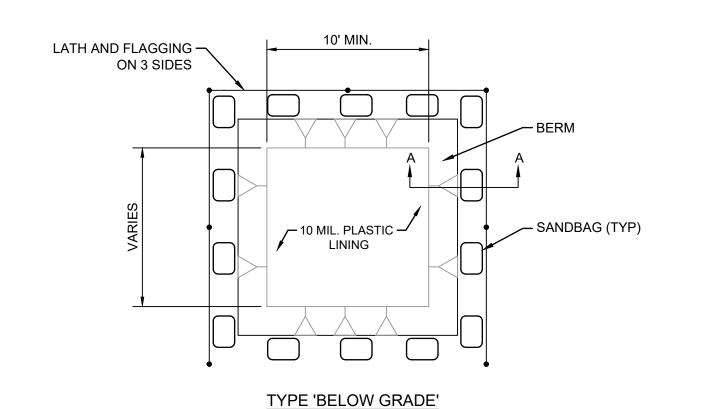



2'x4' PLYWOOD -PAINTED WHITE - BLACK LETTERS 6" HEIGHT ■ CONCRETE ■ WASHOUT | LAG SCREWS (TYP) — WOOD POST 3.5'x3.5'x8'

- WOOD OR METAL STAKES

(2 PER BALE)

STRAW BALE (TYP)

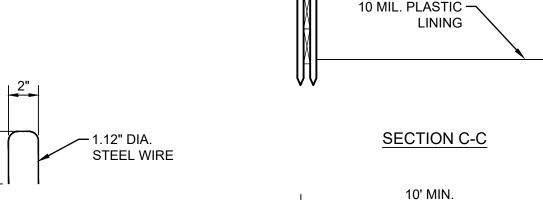

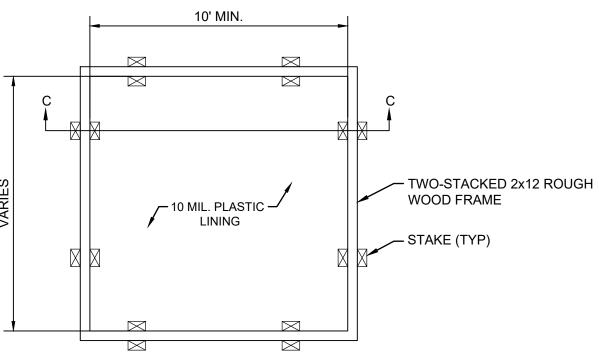

TYPE 'ABOVE GRADE' WITH WOOD PLANKS

- 1. ACTUAL LAYOUT TO BE DETERMINED IN THE FIELD.
- 2. A CONCRETE WASHOUT SIGN SHALL BE INSTALLED WITHIN 30' OF THE TEMPORARY CONCRETE WASHOUT FACILITY
- 3. MATERIALS USED TO CONSTRUCT TEMPORARY CONCRETE WASHOUT FACILITIES SHALL BE REMOVED FROM THE SITE OF THE WORK AND DISPOSED OF OR RECYCLED.
- 4. HOLES, DEPRESSIONS OR OTHER GROUND DISTURBANCE CAUSE BY THE REMOVAL OF THE TEMPORARY CONCRETE WASHOUT FACILITIES SHALL BE BACKFILLED, REPAIRED AND STABILIZED TO PREVENT EROSION.


CONCRETE WASHOUT DETAIL


NOT TO SCALE

STAPLE DETAIL



OK CA 5864 EXP. 06/30/26

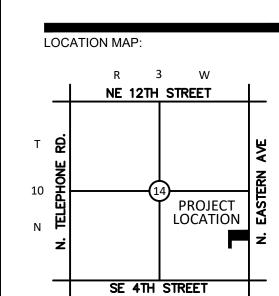

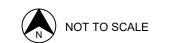

PROJECT:

- WOOD FRAME SECURELY

PERIMETER WITH TWO


STAKES (TYP)

FASTENED AROUND ENTIRE

MPS DAYCARE

201 N. EASTERN MOORE OK

| PROJECT NUMBER: | 24110 |
|-----------------|----------|
| DRAWING DATE: | 11.05.24 |
| ISSUE DATE: | 11.05.24 |
| | |

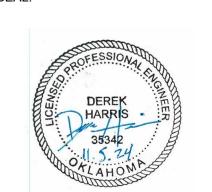


PERMIT SET

| REV | ISIONS: | |
|------|---------|-------------|
| | | |
| | | |
| MARK | DATE | DESCRIPTION |

THESE PLANS AND DRAWINGS ARE NOT TO BE REPRODUCED, CHANGED OR COPIED IN ANY FORM OR MANNER WHATSOEVER WITHOUT FIRST OBTAINING THE WRITTEN PERMISSION AND CONSENT OF CEDAR CREEK CONSULTING INC. THIS SHEET IS NOT TO BE USED FOR CONSTRUCTION UNLESS THE ISSUE DATE IN THE TITLE BLOCK COINCIDES WITH OR POST DATES THE DRAWING DATE. ANY CHANGES MADE FROM THESE PLANS WITHOUT CONSENT OF CEDAR CREEK CONSULTING INC. ARE UNAUTHORIZED, AND SHALL RELIEVE CEDAR CREEK CONSULTING OF RESPONSIBILITY FOR ALL CONSEQUENCES ARRIVING OUT OF SUCH CHANGES.

DRAWING TITLE:

EROSION CONTROL **DETAILS**

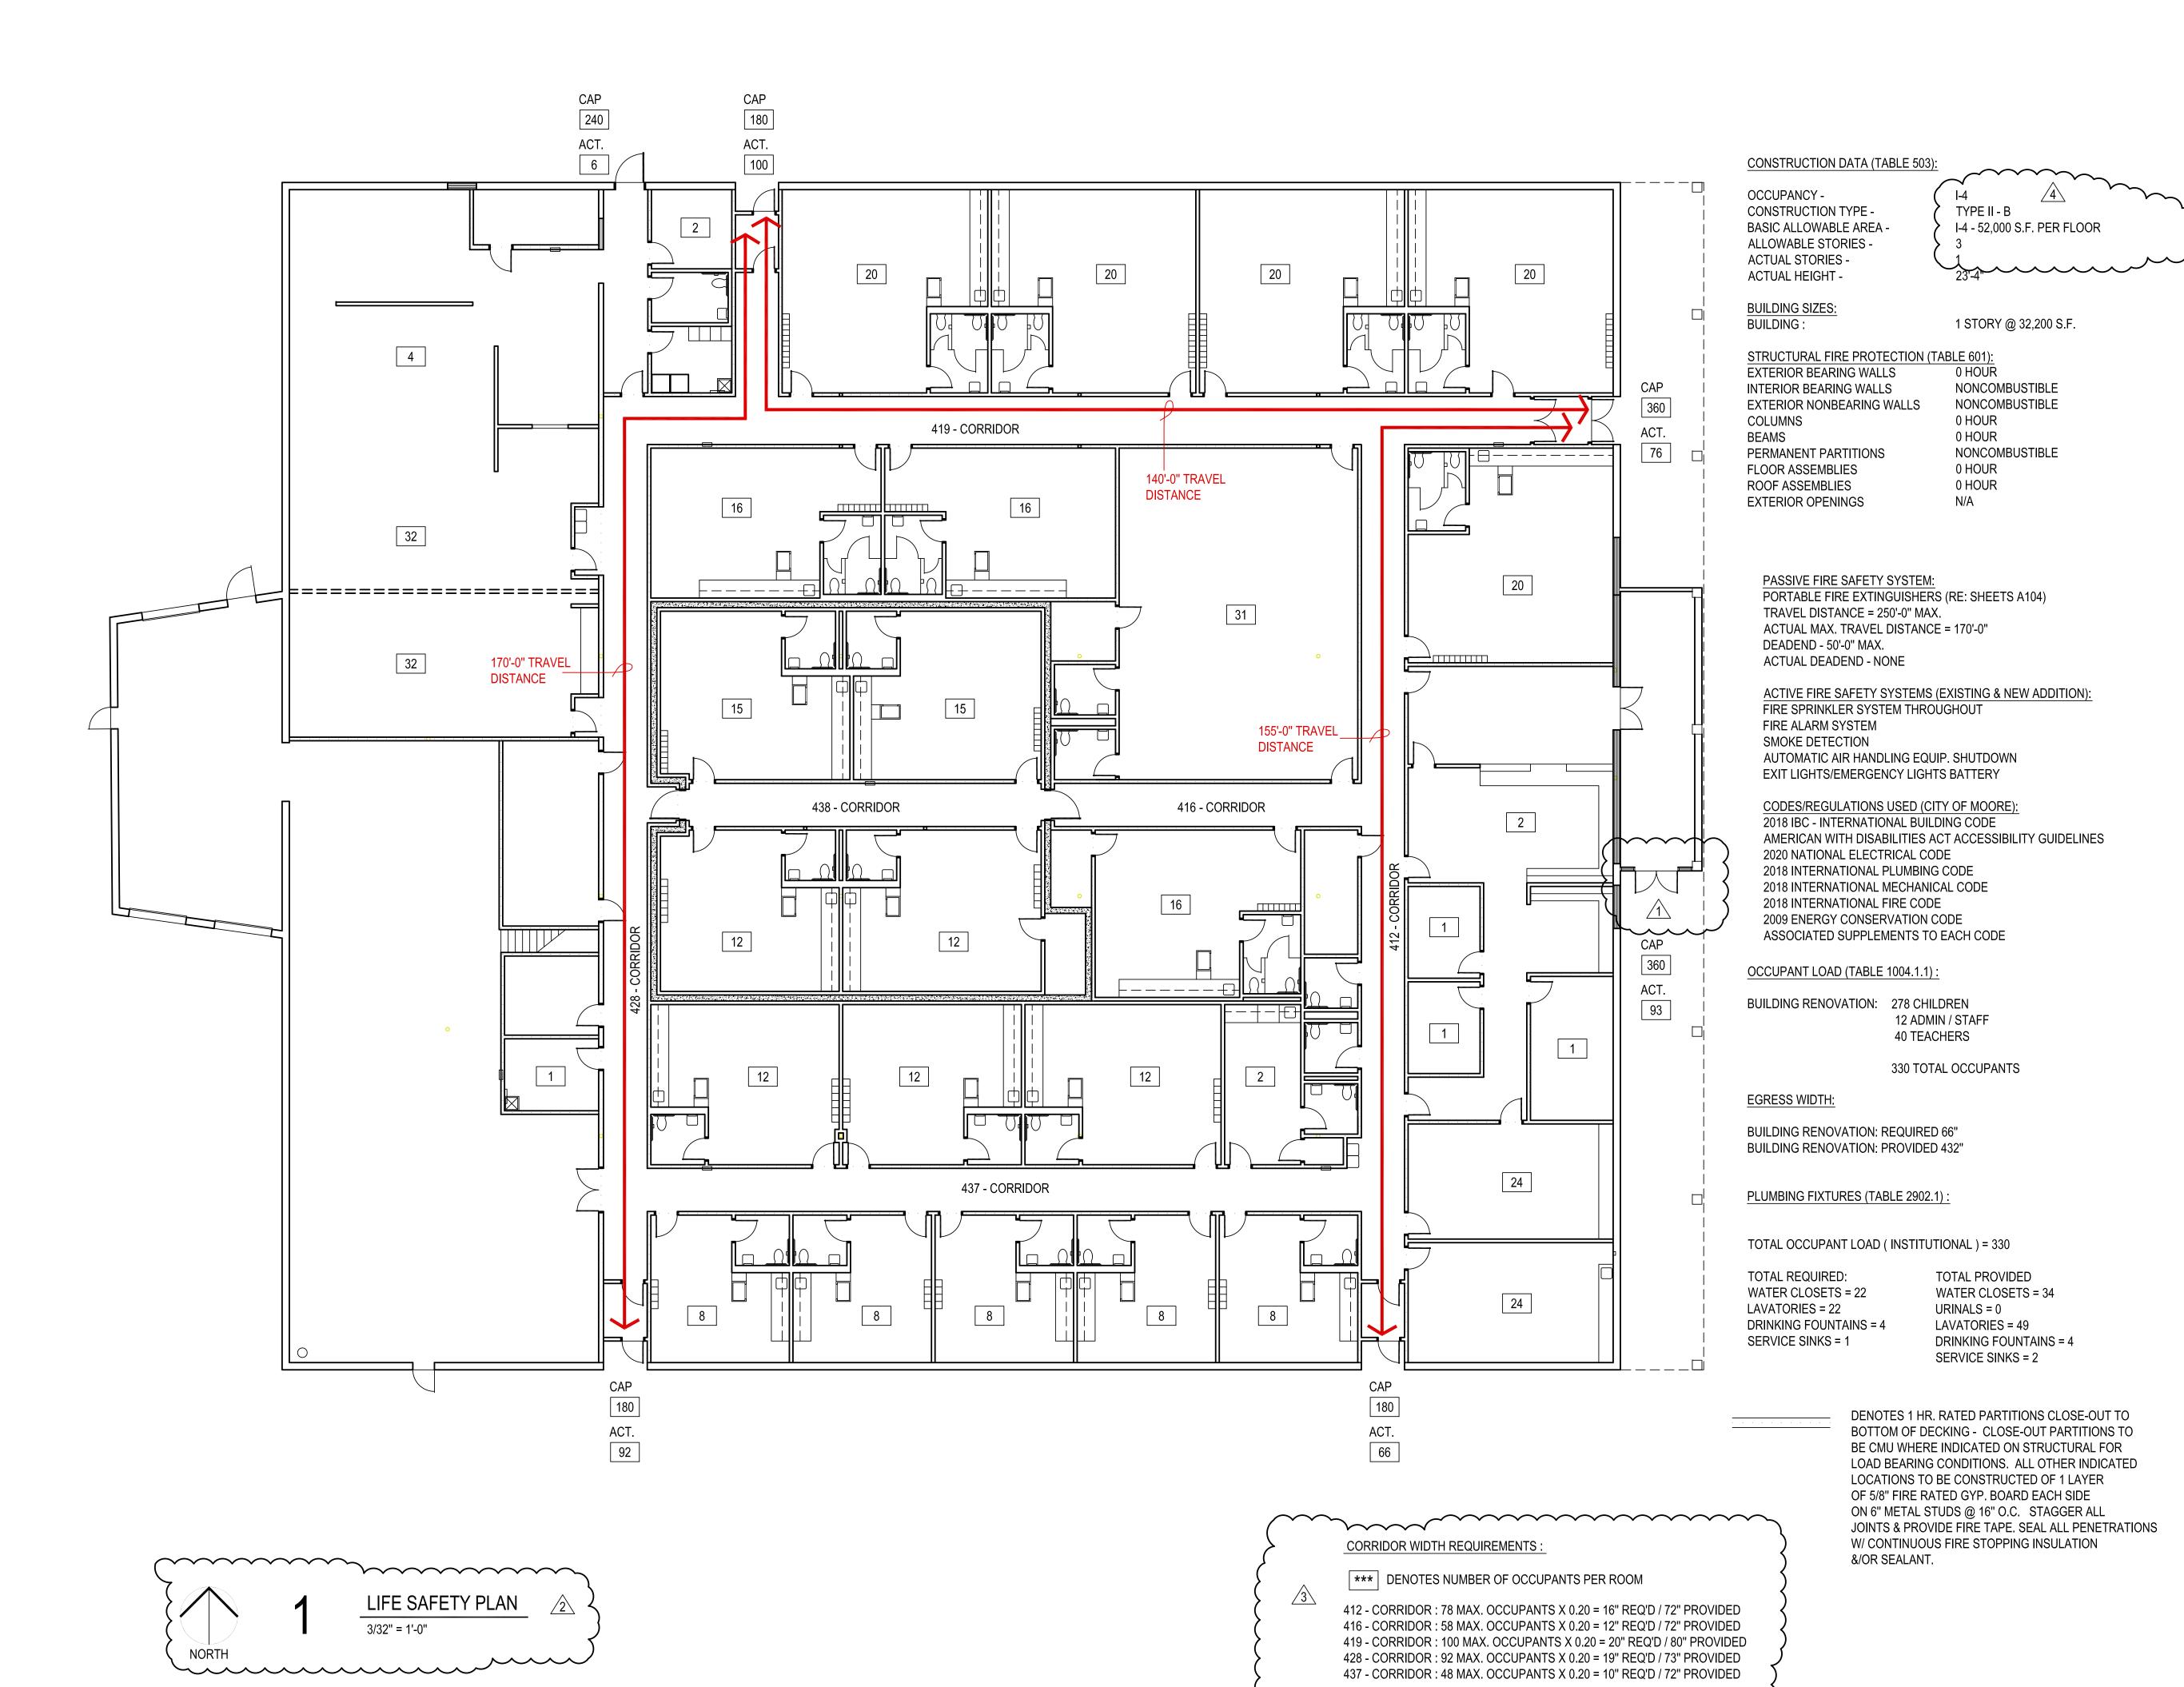

437 - CORRIDOR : 48 MAX. OCCUPANTS X 0.20 = 10" REQ'D / 72" PROVIDED

ALL CORRIDORS & EXIT DOORS EXCEED MINIMUM

CLEARANCES AS REQUIRED BY IBC & ADA

the Abla Griffin Partnership L.L.C.

> 313 S. E. 5th Street MOORE, OK. 73160 405.735.3477 AGP@theAGP.net www.theAGP.net


CEDAR CREEK

CIVIL

KFC ENGINEERING

STRUCTURAL

SALAS O'BRIEN MECHANICAL / ELECTRICAL

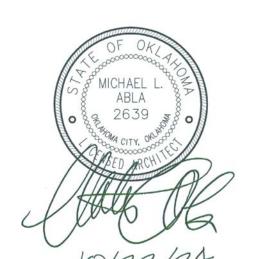

1 ADDENDUM #1

ADDENDUM #2 ADDENDUM #3

<u>4</u> CB-1




CHILD CARE FACILITY 201 N. EASTERN AVE.

A102

OWNERSHIP USE OF DOCUMENTS:

AGP EXPRESSLY RESERVES ITS COPYRIGHT AND OTHER PROPERTY RIGHTS OF ALL PLANS AND DRAWINGS DESIGNED AND/OR PRODUCED, PLANS AND DRAWINGS ARE NOT TO BE REPRODUCED IN ANY FORM OR MANNER WITHOUT THE EXPRESSED WRITTEN CONSENT OF AGP.

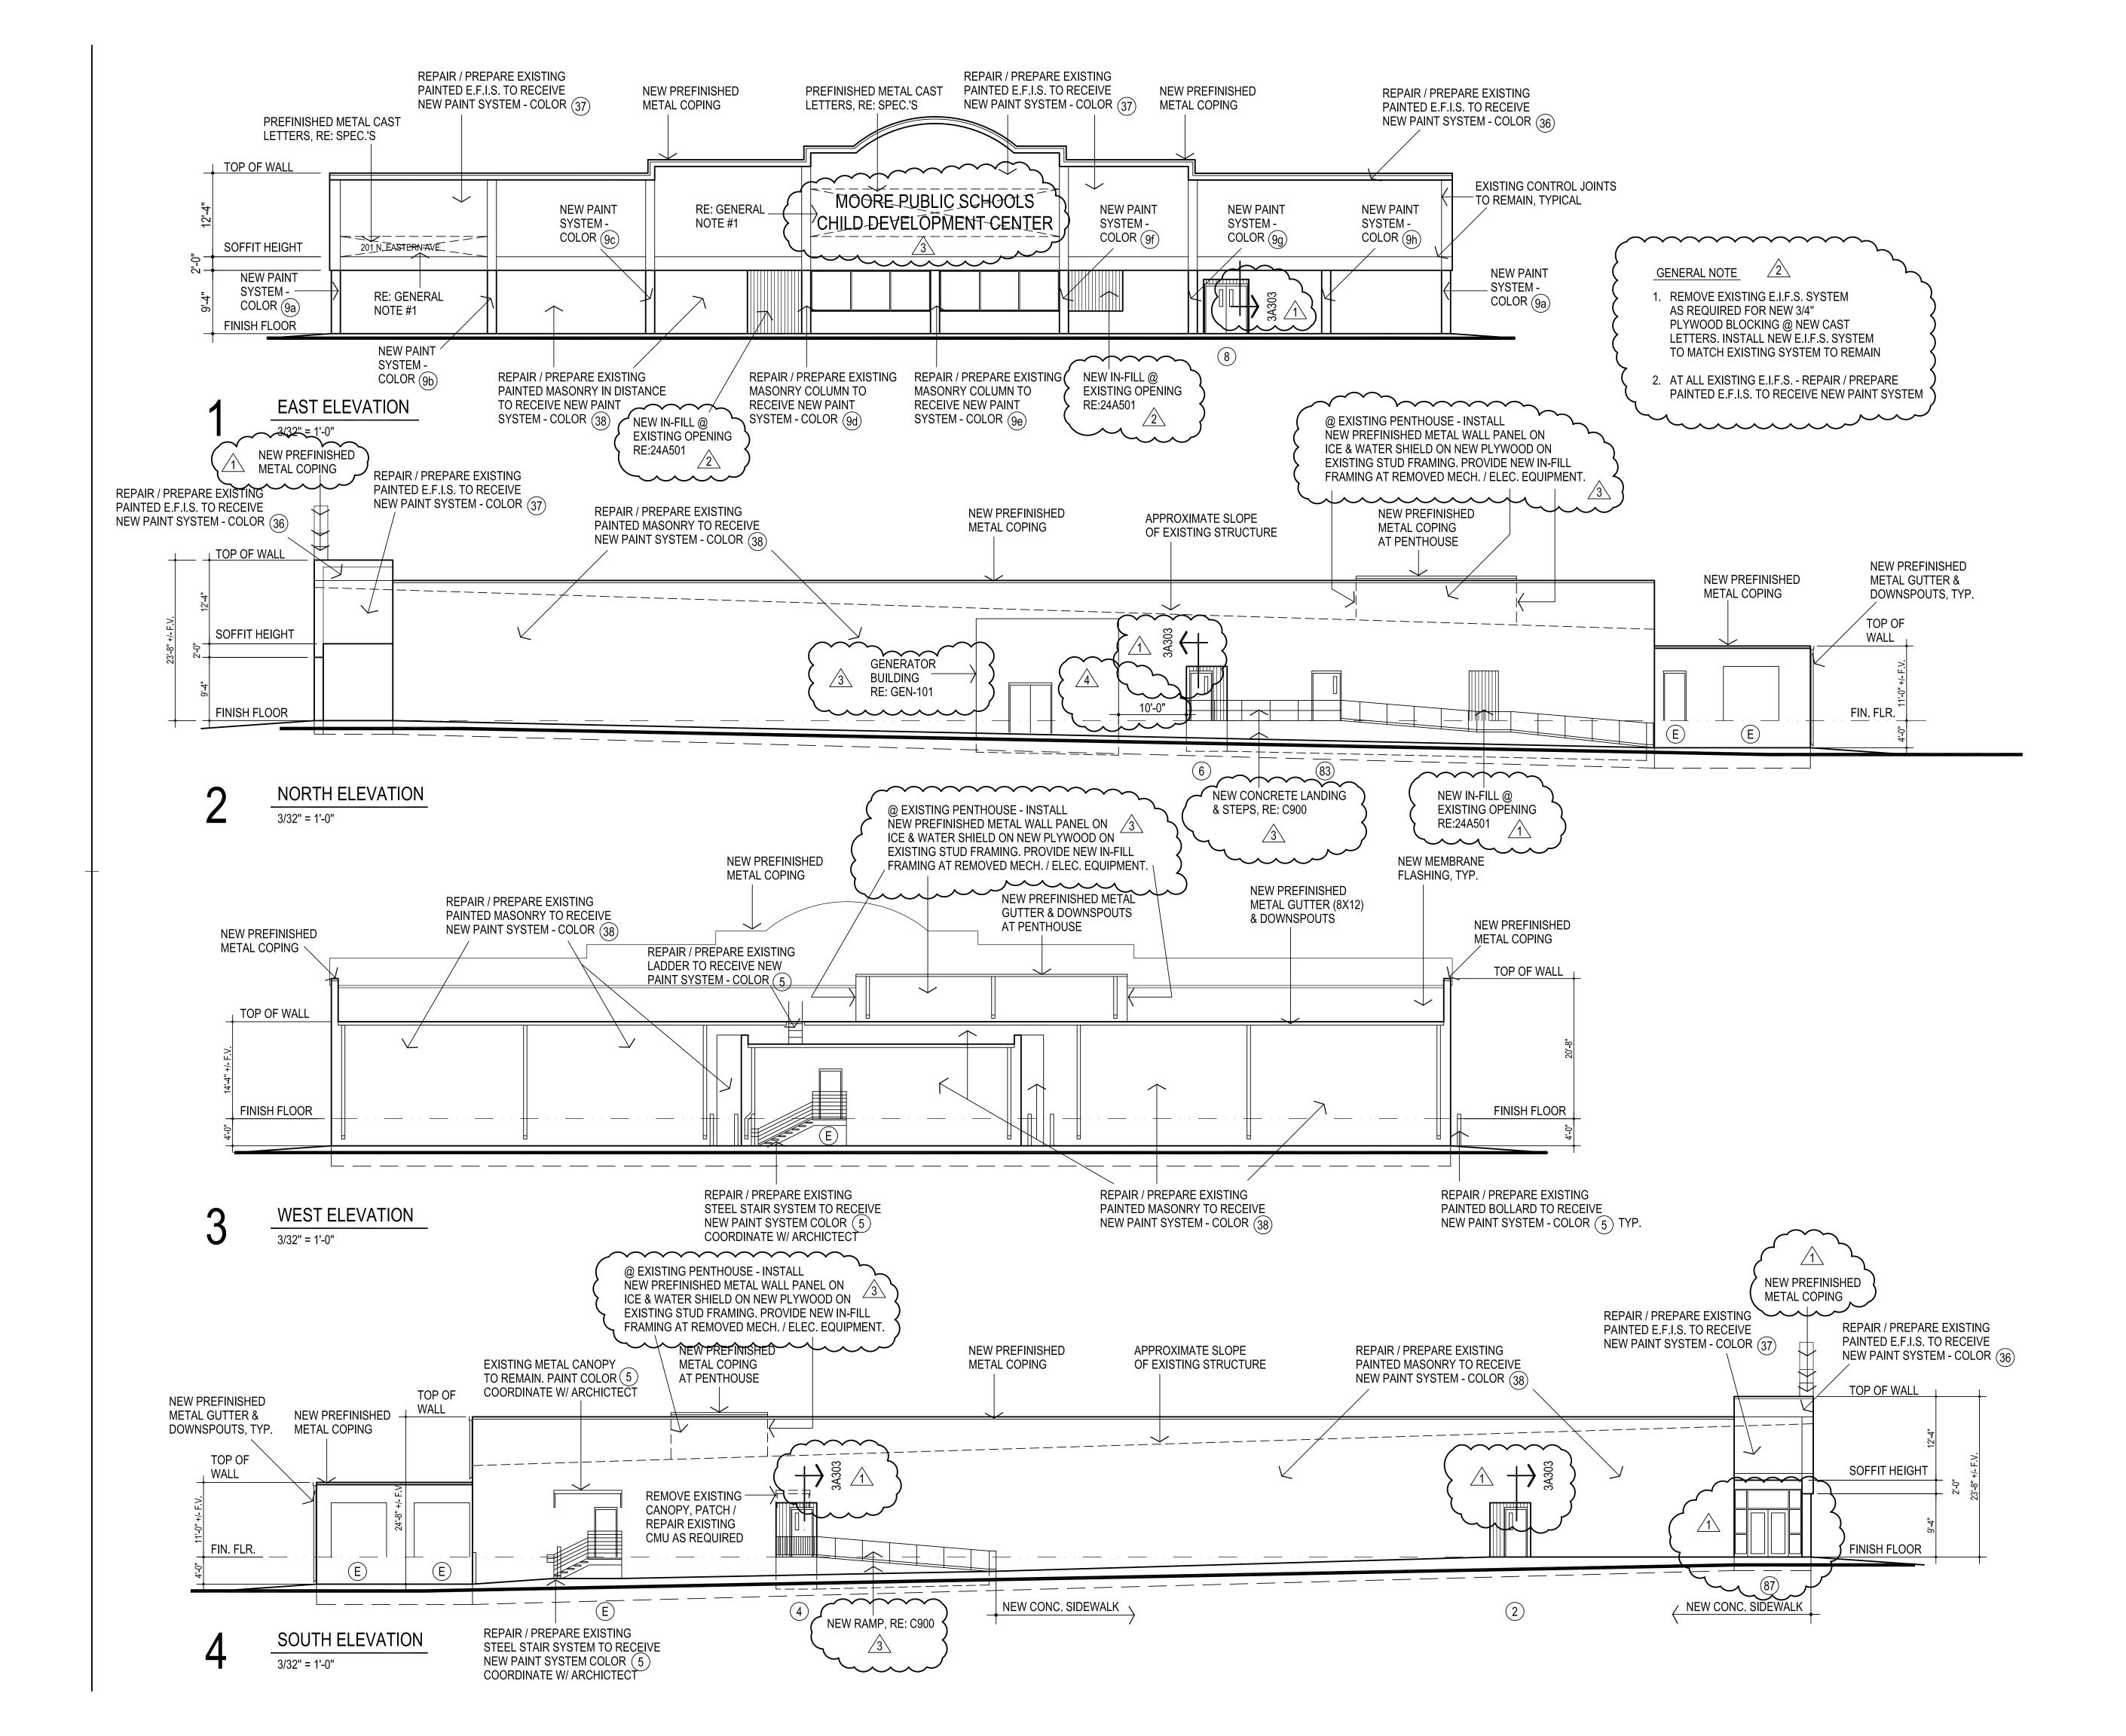



313 S. E. 5th Street MOORE, OK. 73160 405.735.3477 AGP@theAGP.net www.theAGP.net

CEDAR CREEK

CIVIL

KFC ENGINEERING

STRUCTURAL

SALAS O'BRIEN

MECHANICAL / ELECTRICAL



CG drawn by

checked by

revisions

1 ADDENDUM #1

2 ADDENDUM #2

3 ADDENDUM #3

4 CB-1



CHILD CARE FACILITY 201 N. EASTERN AVE.

sheet no

A201

OWNERSHIP USE OF DOCUMENTS:

AGP EXPRESSLY RESERVES ITS
COPYRIGHT AND OTHER PROPERTY
RIGHTS OF ALL PLANS AND DRAWINGS
DESIGNED AND/OR PRODUCED. PLANS
AND DRAWINGS ARE NOT TO BE
REPRODUCED IN ANY FORM OR MANNER
WITHOUT THE EXPRESSED WRITTEN
CONSENT OF AGP.