

**MOORE PUBLIC SCHOOLS -
OLD SCHOOL REPLACEMENT**

Moore Public Schools - Moore, Oklahoma
AGP - Moore, Oklahoma

CONSTRUCTION BULLETIN NO. 3

July 29, 2026


1. UPDATED FOUNDATION PLAN NOTES AS PER ATTACHED REVISED SHEET S201.
2. UPDATED SECTIONS AS PER ATTACHED REVISED SHEET S501.
3. SEE ATTACHED 2530-0265-GEOTECHNICAL ADDENDUM LETTER.

END OF CONSTRUCTION BULLETIN NO. 3



CC
drawn by
BB
checked by
NOVEMBER 2025
date

revisions
1 CB #1 07/29/2026

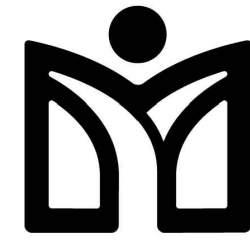

MOORE
PUBLIC SCHOOLS

OLD SCHOOL
UPGRADES

sheet no:


S201

OWNERSHIP USE OF DOCUMENTS:

AGP EXPRESSLY RESERVES ITS
COPYRIGHT AND OTHER PROPERTY
RIGHTS OF ALL PLANS AND DRAWINGS
DESIGNED AND/OR PRODUCED. PLANS
AND DRAWINGS ARE NOT TO BE
REPRODUCED IN ANY FORM OR MANNER
WITHOUT THE EXPRESSED WRITTEN
CONSENT OF AGP.

KFC engineering
Kirkpatrick Forest Curtis PC
Structural Engineering
OK CA #3888, EXP. 06/30/27
1300 N. Walker, Suite 200
Oklahoma City, OK 73103
405.528.4596 | kfcengr.com


FOUNDATION PLAN LEGEND:

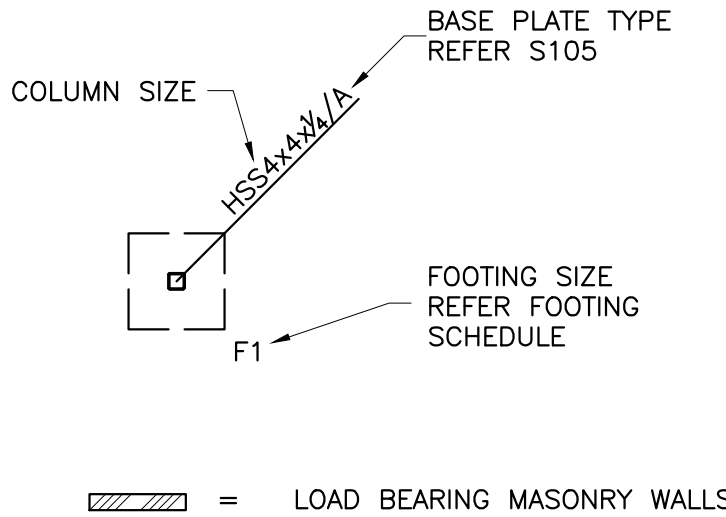

MARK	SIZE			REINFORCEMENT
	WIDTH	LENGTH	DEPTH	
F1	5'-0"	5'-0"	2'-0"	(6) - #5 TOP AND BOT EA. WAY
F2	6'-0"	6'-0"	2'-0"	(7) - #5 TOP AND BOT EA. WAY
F3	9'-0"	9'-0"	2'-0"	(10) - #5 TOP AND BOT EA. WAY
F4	7'-0"	7'-0"	3'-0"	(8) - #6 TOP AND BOT EA. WAY


FOUNDATION PLAN NOTES:

1. FOUNDATION AND SLAB SUBGRADE SHALL BE PREPARED AS OUTLINED IN THE STRUCTURAL GENERAL NOTES. EXISTING BASEMENT SHALL BE PREPARED PER DEEP FILL RECOMMENDATIONS IN THE GEOTECHNICAL REPORT AND FOUNDATIONS FOR SHELTER SHALL BE PREPARED PER GEOTECHNICAL ADDENDUM LETTER DATED JULY 27, 2026.
2. REFERENCE ELEVATION OF 100'-0" EQUALS DATUM FINISHED FLOOR ELEVATION OF 1251.00 FEET FOR THE NEW BUILDING.
3. EXCEPT WHERE SHOWN OTHERWISE, SLABS-ON-GRADE SHALL BE 4" THICK CONCRETE REINFORCED WITH #3 BARS AT 15" ON CENTER EACH WAY OVER A 15 MIL VAPOR RETARDER OVER A 4" AGGREGATE BASE COURSE. REINFORCING BARS SHALL BE PLACED 1 1/2" CLEAR FROM TOP OF SLAB USING CHAIRS OR SLAB BOLSTERS COMPLYING WITH CRSI'S "MANUAL OF STANDARD PRACTICE".
4. SLABS-ON-GRADE SHALL BE WATER CURED FOR A MINIMUM OF 7 DAYS BY PONDING, SPRAYING, SPRINKLING OR BY USE OF SATURATED COVERINGS. THE USE OF CURING COMPOUNDS FOR SLABS-ON-GRADE IS PROHIBITED.
5. SAWED JOINTS (S.J.) AND REQUIRED CONSTRUCTION JOINTS (C.J.) ARE SHOWN ON THE DRAWINGS. AT THE CONTRACTOR'S OPTION, ADDITIONAL CONSTRUCTION JOINTS MAY BE PLACED AT LOCATIONS INDICATED TO BE SAWED JOINTS.
6. // INDICATES (2)#4 BARSx4'-0" TO BE PLACED IN SLAB-ON-GRADE AT ALL RE-ENTRANT CORNERS. RE-ENTRANT CORNERS ARE DEFINED AS INTERIOR CORNERS WHERE JOINTS DO NOT OCCUR IN BOTH DIRECTIONS. SIMILAR BARS SHALL BE PLACED AT ANY DISCONTINUOUS ENDS OF SAWED JOINTS OR CONSTRUCTION JOINTS.
7. REFER MECHANICAL FOR FLOOR DRAIN (F.D.) INFORMATION.
8. EXTERIOR STAIRS CAN ATTACH TO 12" CMU WALL AND/OR USE POSTS FOR SUPPORT. GC TO COORDINATE WITH DELEGATED STAIR ENGINEER/STEEL FABRICATOR AND PROVIDE FOUNDATIONS PER DETAIL 4A/S502 FOR POSTS AS REQUIRED.

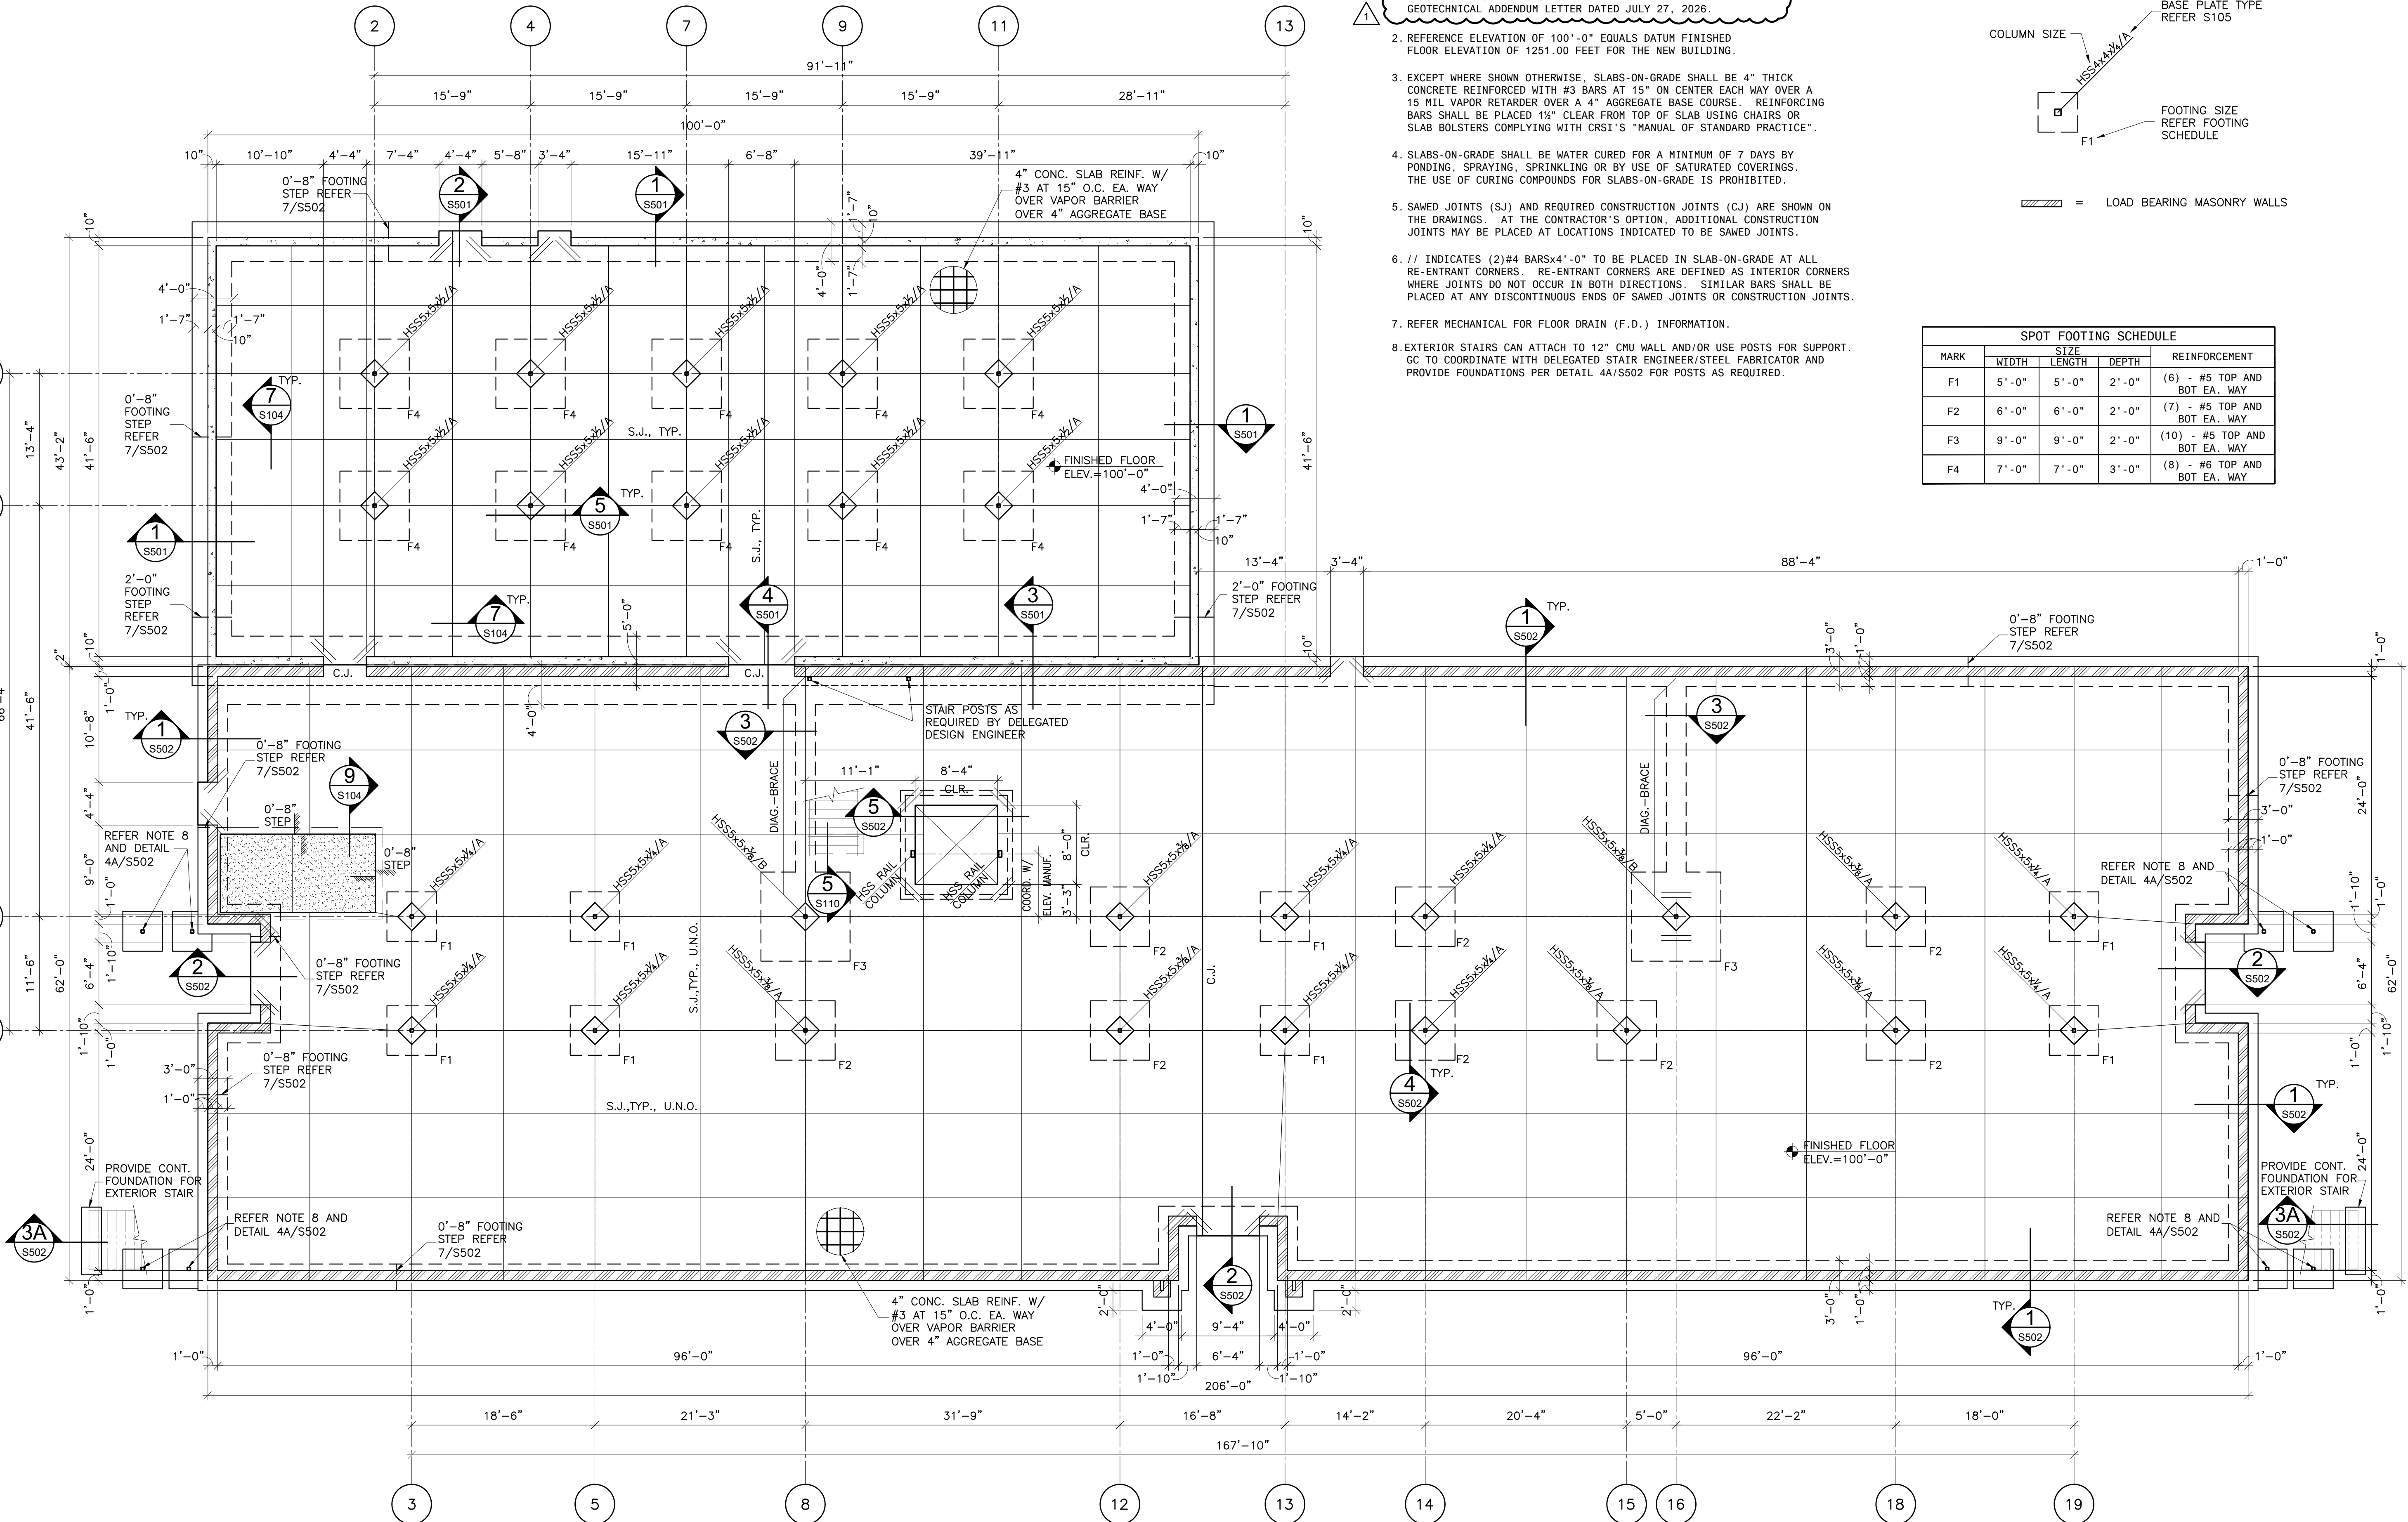


1 FOUNDATION PLAN

SCALE: 1/8"=1'-0"

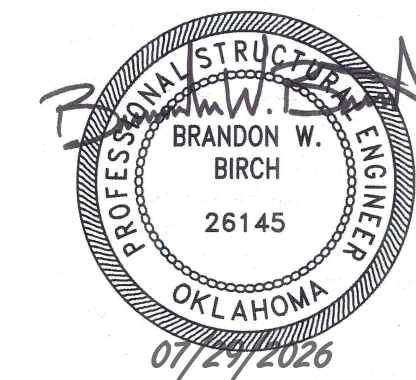

CC	drawn by
BB	checked by
NOVEMBER 2025	date

revisions
1 CB #3 07/29/2026

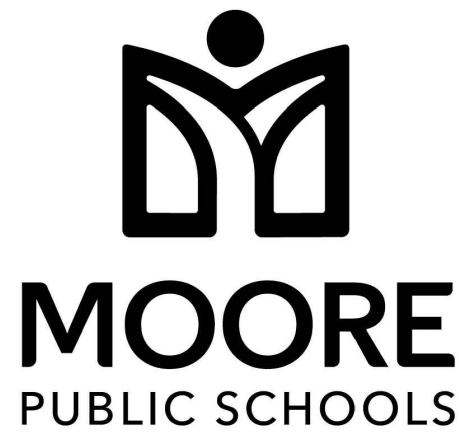


OLD SCHOOL
UPGRADES

sheet no:

S501

OWNERSHIP USE OF DOCUMENTS:


AGP EXPRESSLY RESERVES ITS
COPYRIGHT AND OTHER PROPERTY
RIGHTS OF ALL PLANS AND DRAWINGS
DESIGNED AND/OR PRODUCED. PLANS
AND DRAWINGS ARE NOT TO BE
REPRODUCED IN ANY FORM OR MANNER
WITHOUT THE EXPRESSED WRITTEN
CONSENT OF AGP.

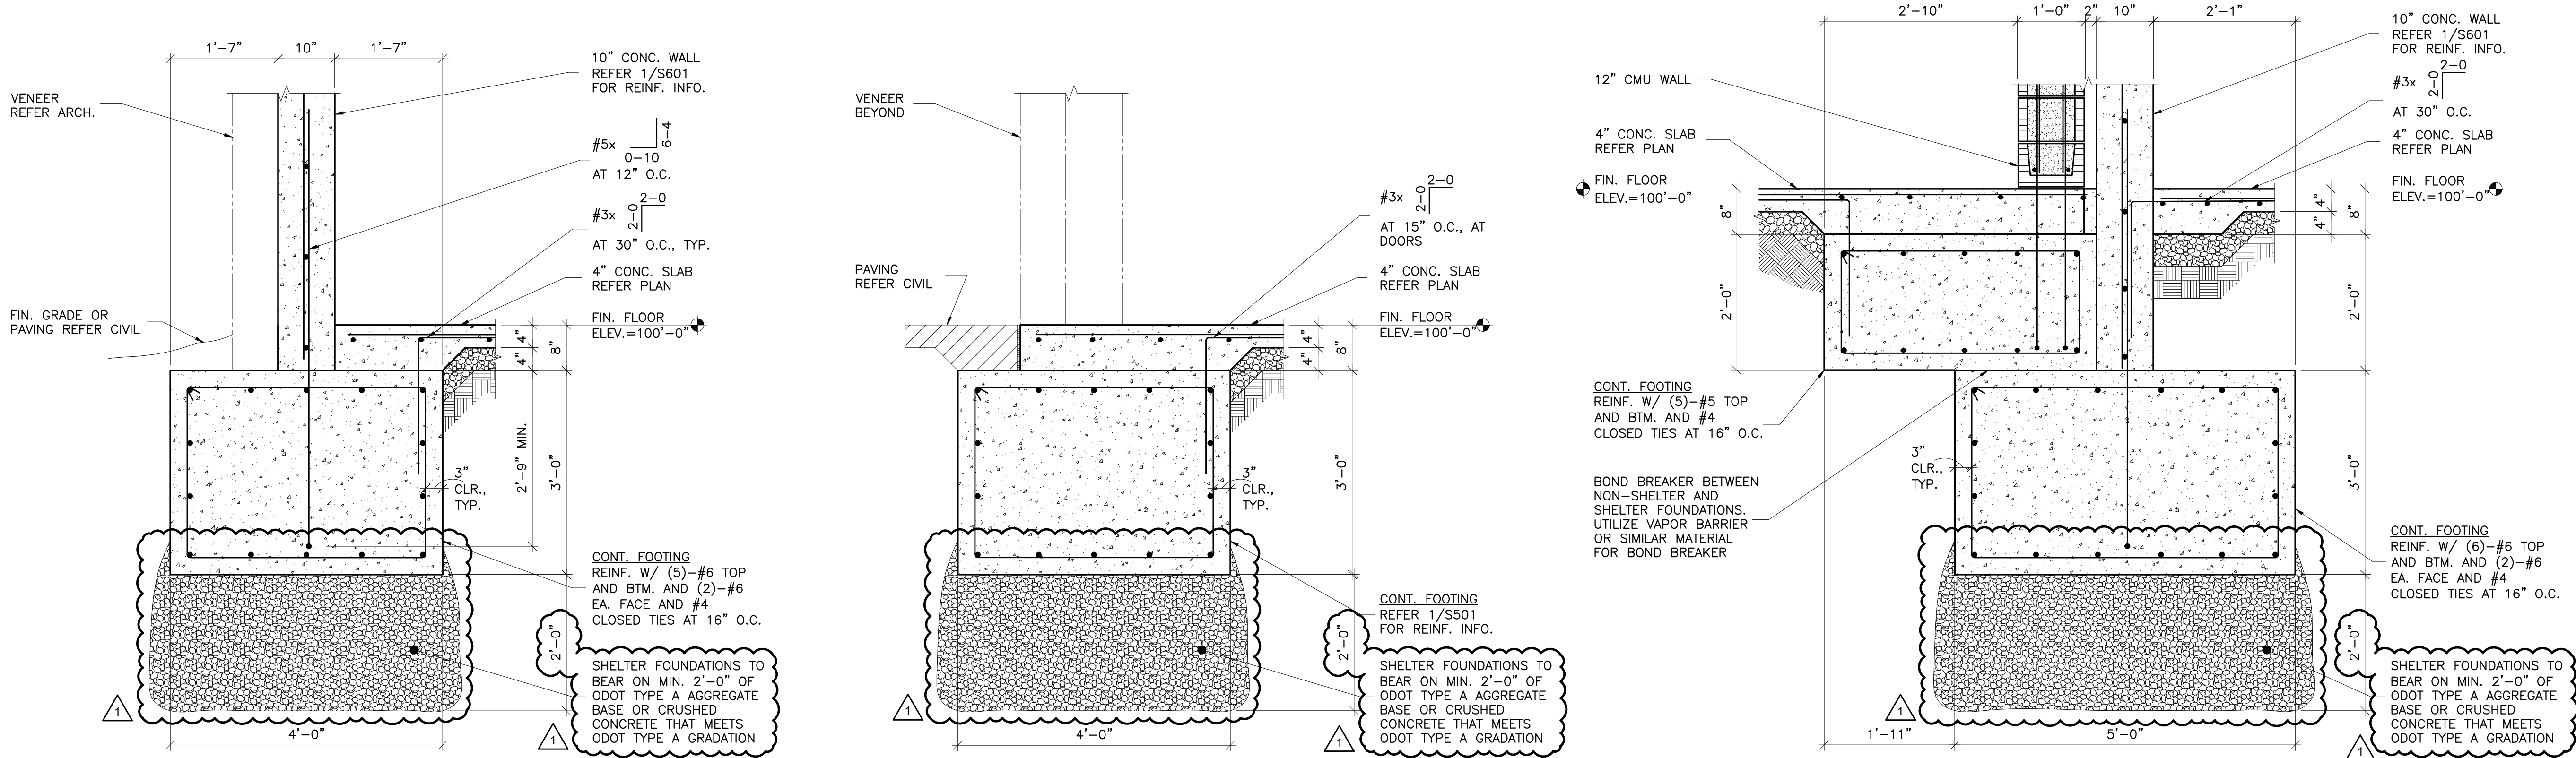


1 SECTION
S501 SCALE: 3/4"=1'-0"

2 SECTION
S501 SCALE: 3/4"=1'-0"

3 SECTION
S501 SCALE: 3/4"=1'-0"

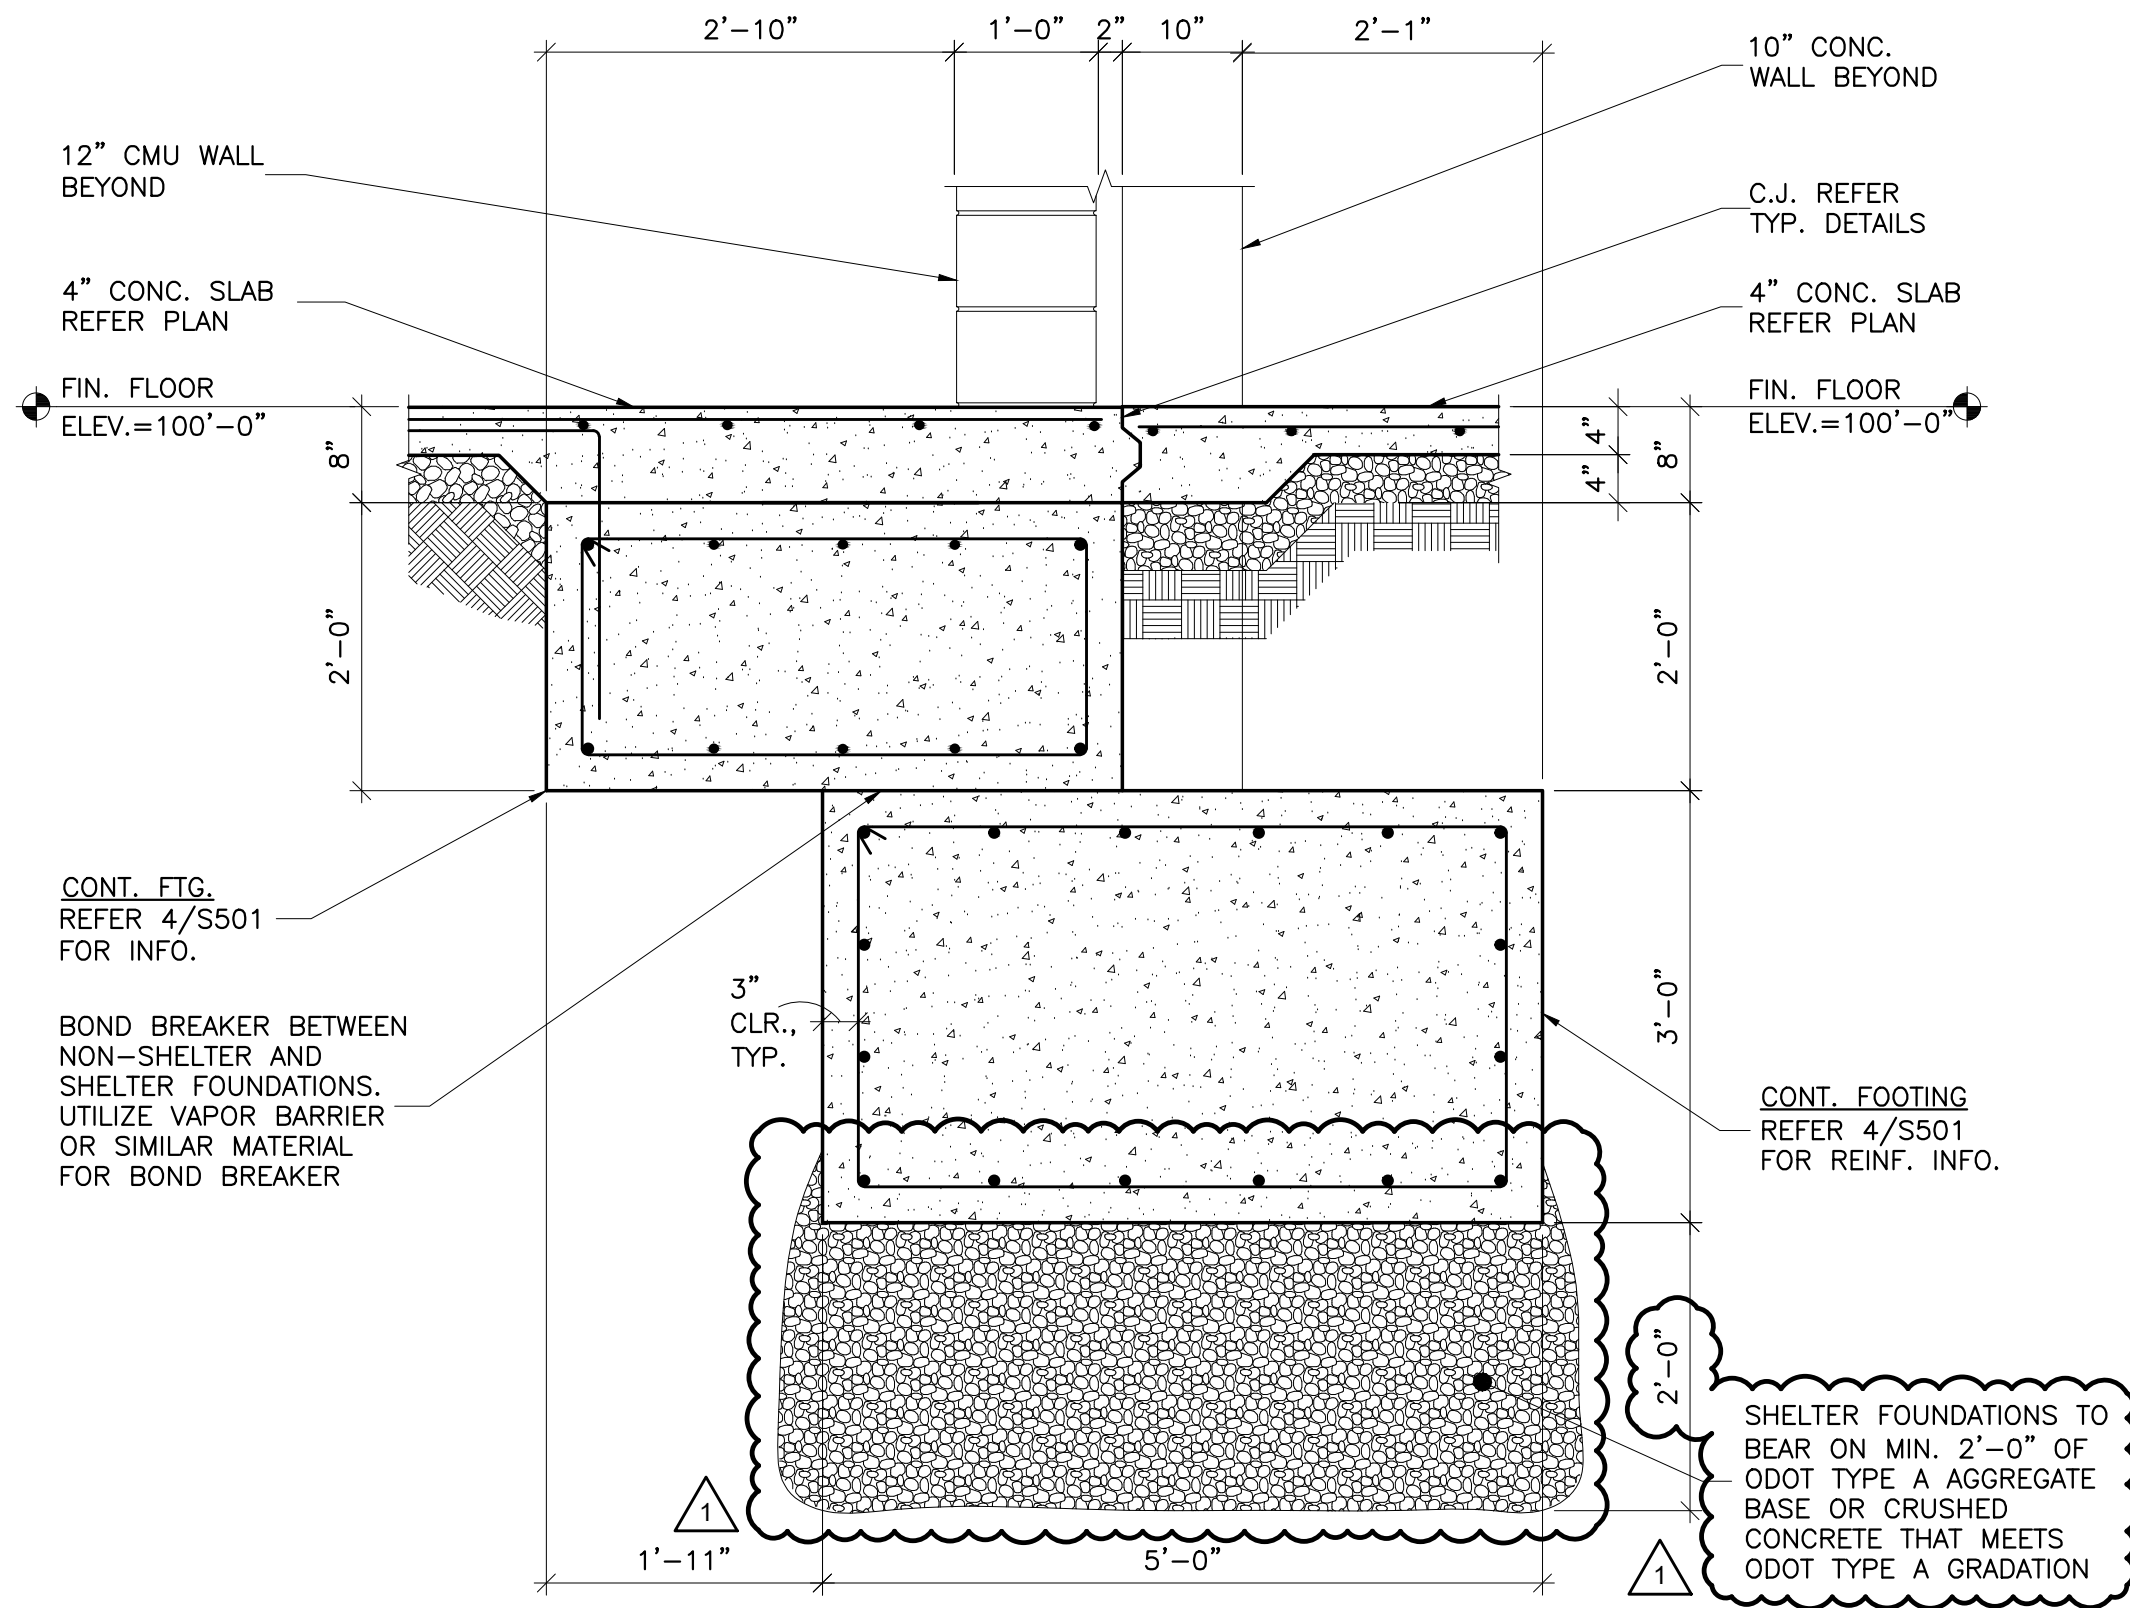

4 SECTION
S501 SCALE: 3/4"=1'-0"

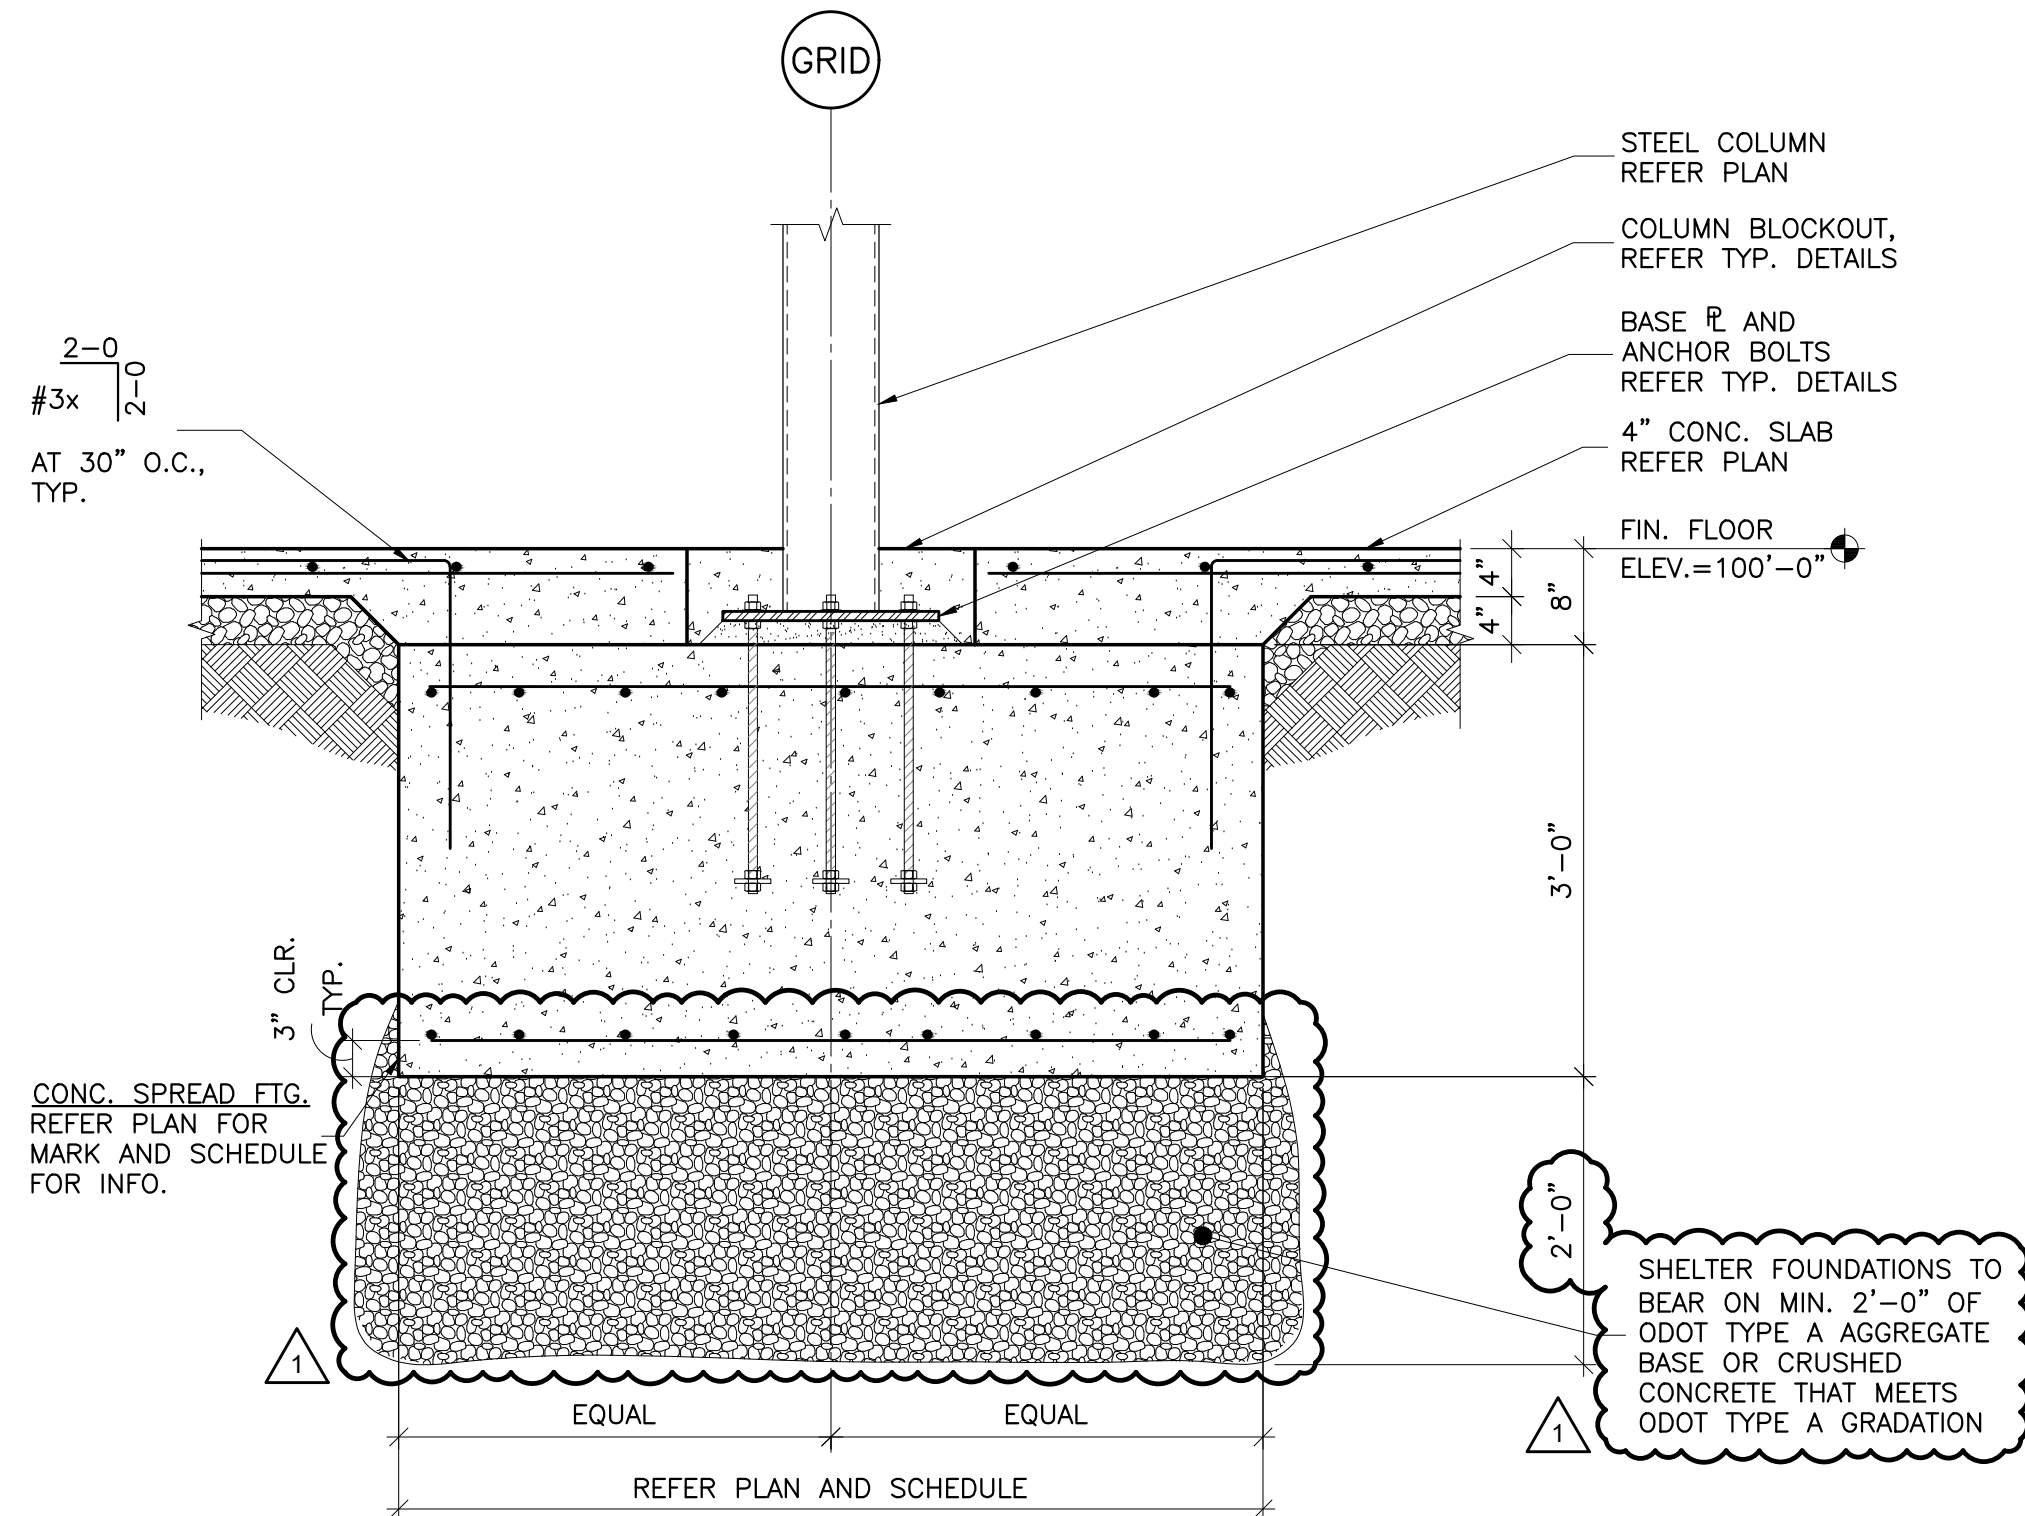

5 SECTION
S501 SCALE: 3/4"=1'-0"



CORPORATE OFFICE • OKLAHOMA CITY
3400 N Lincoln Blvd • Oklahoma City, OK 73105-5493
(405) 528-0541 • (800) 725-0541 • (405) 528-0559 FAX

902 Trails West Loop
Enid, OK 73703
(580) 237-3130
(800) 725-3130

202 SE "J" Ave
Lawton, OK 73501
(580) 353-0872
(800) 725-0872

10203 E 61st St
Tulsa, OK 74133
(918) 289-0005
(800) 725-0541

July 27th, 2026

The Abila Griffin Partnership, LLC
313 SE 5th Street
Moore, OK 73160

Attn: Mr. Clay Griffin

Re: Subsurface Exploration: Standard Engineering Report 2530-0265
Old School Elementary School Kitchen Addition
201 North Broadway Avenue
Moore, Oklahoma

Dear Mr. Griffin:

Standard Engineering & Field Services, LLC (Standard) is pleased to present the following addendum letter for the subject project. Per the request of Mr. Clay Griffin, of The Abila Griffin Partnership, the following recommendations regarding deep fill and foundation bearing conditions are contained within this addendum letter.

Recommendations for General Basement Fill Sections

The existence of a basement area that needs to be filled in has been indicated within the revised construction area for this project. It is our understanding that this basement has an approximate depth of twelve (12) feet, although the depth may vary in places. To mitigate the potential for self-settlement of the fill section, we advise following the recommendations in the Earthwork Recommendation Section 4.5, subsection "Deep Fill Sections" of Standard Engineering's Report 2530-0265. Generally, for this basement, that would mean approximately 7 feet of properly compacted ODOT Type A Aggregate Base, followed by 5 feet of properly compacted Inert Fill. This aggregate base layer may be comprised of crushed concrete as long as it meets the specifications of ODOT Type A Aggregate Base.

Old School Elementary School Kitchen Addition
Moore, Oklahoma

Recommendations for Foundations

It is our understanding that footings of different bearing depths will be placed both within the basement area and outside the basement area. The locations of these have been provided by the client in Figure 1 below.

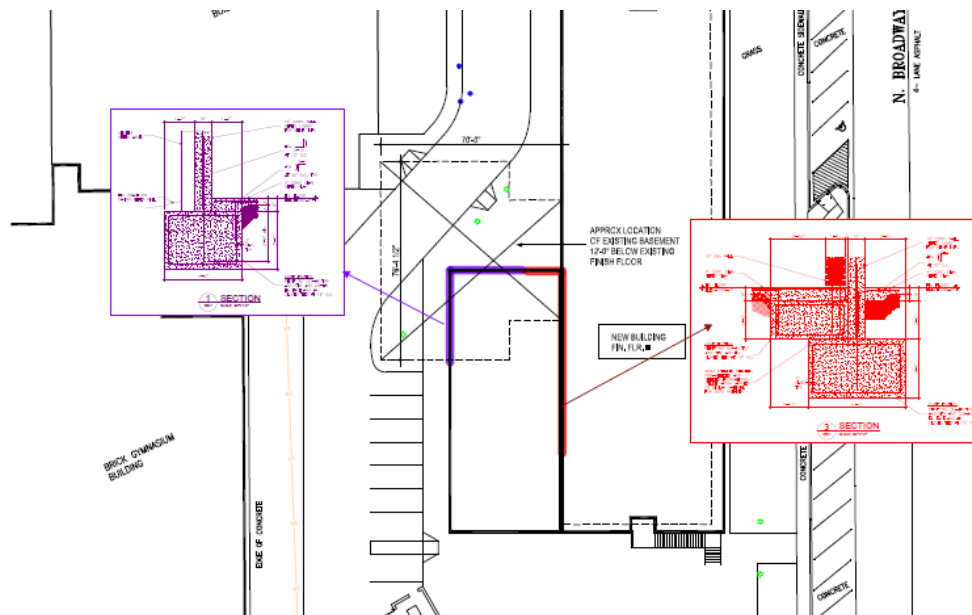


Figure 1: Plans for Basement Footing Area

It is our opinion that all foundations should bear on a minimum of 2 feet of properly compacted ODOT Type A Aggregate Base to mitigate issues of differential settlement. This aggregate base layer may be comprised of crushed concrete as long as it meets the specifications of ODOT Type A Aggregate Base.

The foundations present for this broadly consist of 3 types:

Type 1: Foundations with a bottom of footing of 3' and 8" below finished floor elevation. These foundations are represented by the purple line in the diagram above.

Type 2: Foundations with a bottom of footing of 5' and 8" below finished floor elevation AND are **within** the footprint of the basement.

These foundations are represented by the red line while in the basement area.

*Old School Elementary School Kitchen Addition
Moore, Oklahoma*

Type 3: Foundations with a bottom of footing of 5' and 8" below finished floor elevation AND are **outside** the footprint of the basement.

These foundations are represented by the red line while outside of the basement area.

Type 1 foundations bear within the basement excavation, which is approximately 12 feet deep. To satisfy the filling of the basement and the 2-foot minimum of aggregate bearing material, the foundations will be placed upon approximately 8.3 feet of aggregate base. This represents the bottom 7 feet of the basement fill with aggregate base, and then another 1.3* feet to meet the bottom of the footing.

Type 2 foundations bear within the basement excavation, which is approximately 12 feet deep. To satisfy the filling of the basement and the 2-foot minimum of aggregate bearing material, the foundations will be placed upon approximately 6.7* feet of aggregate base. This represents the bottom 7 feet of the basement fill with aggregate base, which has been excavated out a few inches to meet the bearing depth of the foundation.

Type 3 foundations bear outside the basement excavation, and the bearing depth presented would put the bottom of footing below the building pad. To ensure similar bearing conditions, the depth of footing should be excavated, and then excavated an additional 2 feet, and filled with properly compacted aggregate base.

*It should be noted that these values are estimates and may vary depending on exact depth of the basement and excavation. In all locations the footings must bear on at least 2 feet of aggregate base as discussed above.

Recommendations for Fill outside of Foundation Areas

Any area of the basement that will have structural elements is recommended to be filled in accordance with the Earthwork Recommendation Section 4.5, subsection "Deep Fill Sections" of Standard Engineering's Report 2530-0265. For non-structural areas, a stair-stepped slope of 45 degrees, phasing out the aggregate base bottom may be used, although the risk of self-settlement is inherently higher in such a case.

*Old School Elementary School Kitchen Addition
Moore, Oklahoma*

We appreciate the opportunity to assist on this project. Please call on us if we can be of further service.

Respectfully submitted,
STANDARD ENGINEERING AND FIELD SERVICES

Prepared By:

Donovan

Donovan Bradshaw, E.I.
Geotechnical Staff Engineer



Reviewed By:

Roy Khalife

Roy Khalife, P.E.
Geotechnical Engineer

I certify my e-signature for the study entitled "Subsurface Exploration"

Dated 07/27/2026

Certificate of Authorization No. 7933
Expiration 6/30/2027