## MOORE PUBLIC SCHOOLS -SOUTHGATE ELEMENTARY SCHOOL – OFFICE ADDITION

Moore Public Schools - Moore, Oklahoma AGP - Moore, Oklahoma

CONSTRUCTION BULLETIN NO. 2 February 27, 2024 REVISED 2-28-24

- 1. OMIT DOOR #6 IN ITS ENTIRETY.
- 2. REVISE DOOR HARDWARE FOR DOORS #5 (4a) AND #8 (5a) AS PER ATTACHED SETS. VERIFY CHANGES WITH OWNER'S HARDWARE COORDINATOR / CONTACT.
- 3. REVISE DOOR SWING FOR DOOR #8 AS PER ATTACHED DRAWINGS.

END OF CONSTRUCTION BULLETIN NO. 2

## SECTION 08700 - FINISH HARDWARE

REVISIONS NOTED IN RED - CONSTRUCTION BULLETIN CB-2 - REVISED 2-28-24

2.02 Hardware Sets:

			Provide each SGL door(s) Model Number	with the Finish	following: Mfr
3	EA	HINGE	5BB1 4.5 X 4.5	652	IVE
1	ΕA	OFFICE LOCK	L9050T 03N	626	SCH
1	EA	CLASSIC CORE	23-030	626	SCH
1	ΕA	STOP	WS407CCV OR FS436 AS REQU	UIRED 628	IVE
3	ΕA	SILENCER	SR64	GRY	IVE
1	EA	SURFACE CLOSER	4041 OR P4041 MTG BRKTS,	SPCRS & PI 689	LATES AS REQ LCN
1	EA	KICK PLATE	8400 10" X 1" LDW	630	IVE

REFER TO ELECTRICAL FOR ACCESS, CARD READER, ETC. INFORMATION.


		Group No. 004a: Description	Provide each SGL door( Model Number	-	following: Mfr
3	EA	HINGE	5BB1 4.5 X 4.5		IVE
1	EA	OFFICE LOCK	L9050T 03N	626	SCH
1	EA	CLASSIC CORE	40-100	626	SCH
1	EA	STOP	WS407CCV OR FS436 AS RE	QUIRED 628	IVE
3	EA	SILENCER	SR64	GRY	IVE
1	EA	SURFACE CLOSER	4041 OR P4041 MTG BRKTS,	SPCRS & PLA	ATES AS REQ
				689	LCN
1	EA	KICK PLATE	8400 10" X 1" LDW	630	IVE

REFER TO ELECTRICAL FOR ACCESS, CARD READER, ETC. INFORMATION.

			Provide each SGL door(s)	with the	following:
Quar	ntity	Description	Model Number	Finish	Mfr
3	ΕA	HINGE	5BB1 4.5 X 4.5	652	IVE
1	ΕA	OFFICE LOCK	L9050T 03N	626	SCH
1	EA	CLASSIC CORE	23-030	626	SCH
1	ΕA	STOP	WS407CCV OR FS436 AS REQ	UIRED 628	IVE
3	ΕA	SILENCER	SR64	GRY	IVE

		-	Provide each SGL d		following:
Quan	tity	Description	Model Number	Finish	Mfr
3	ΕA	HINGE	5BB1 4.5 X 4.5	652	IVE
1	ΕA	LOCKSET	ND66C RHO 10-025	626	SCH
1	ΕA	CLASSIC CORE	40-100	626	SCH
1	ΕA	STOP	WS407CCV OR FS436 A	AS REQUIRED 628	IVE
3	ΕA	SILENCER	SR64	GRY	IVE

Please note - CM to provide ALL connections required to the fire alarm, security, and electrical systems necessary for fully functioning devices meeting all applicable codes and standards.

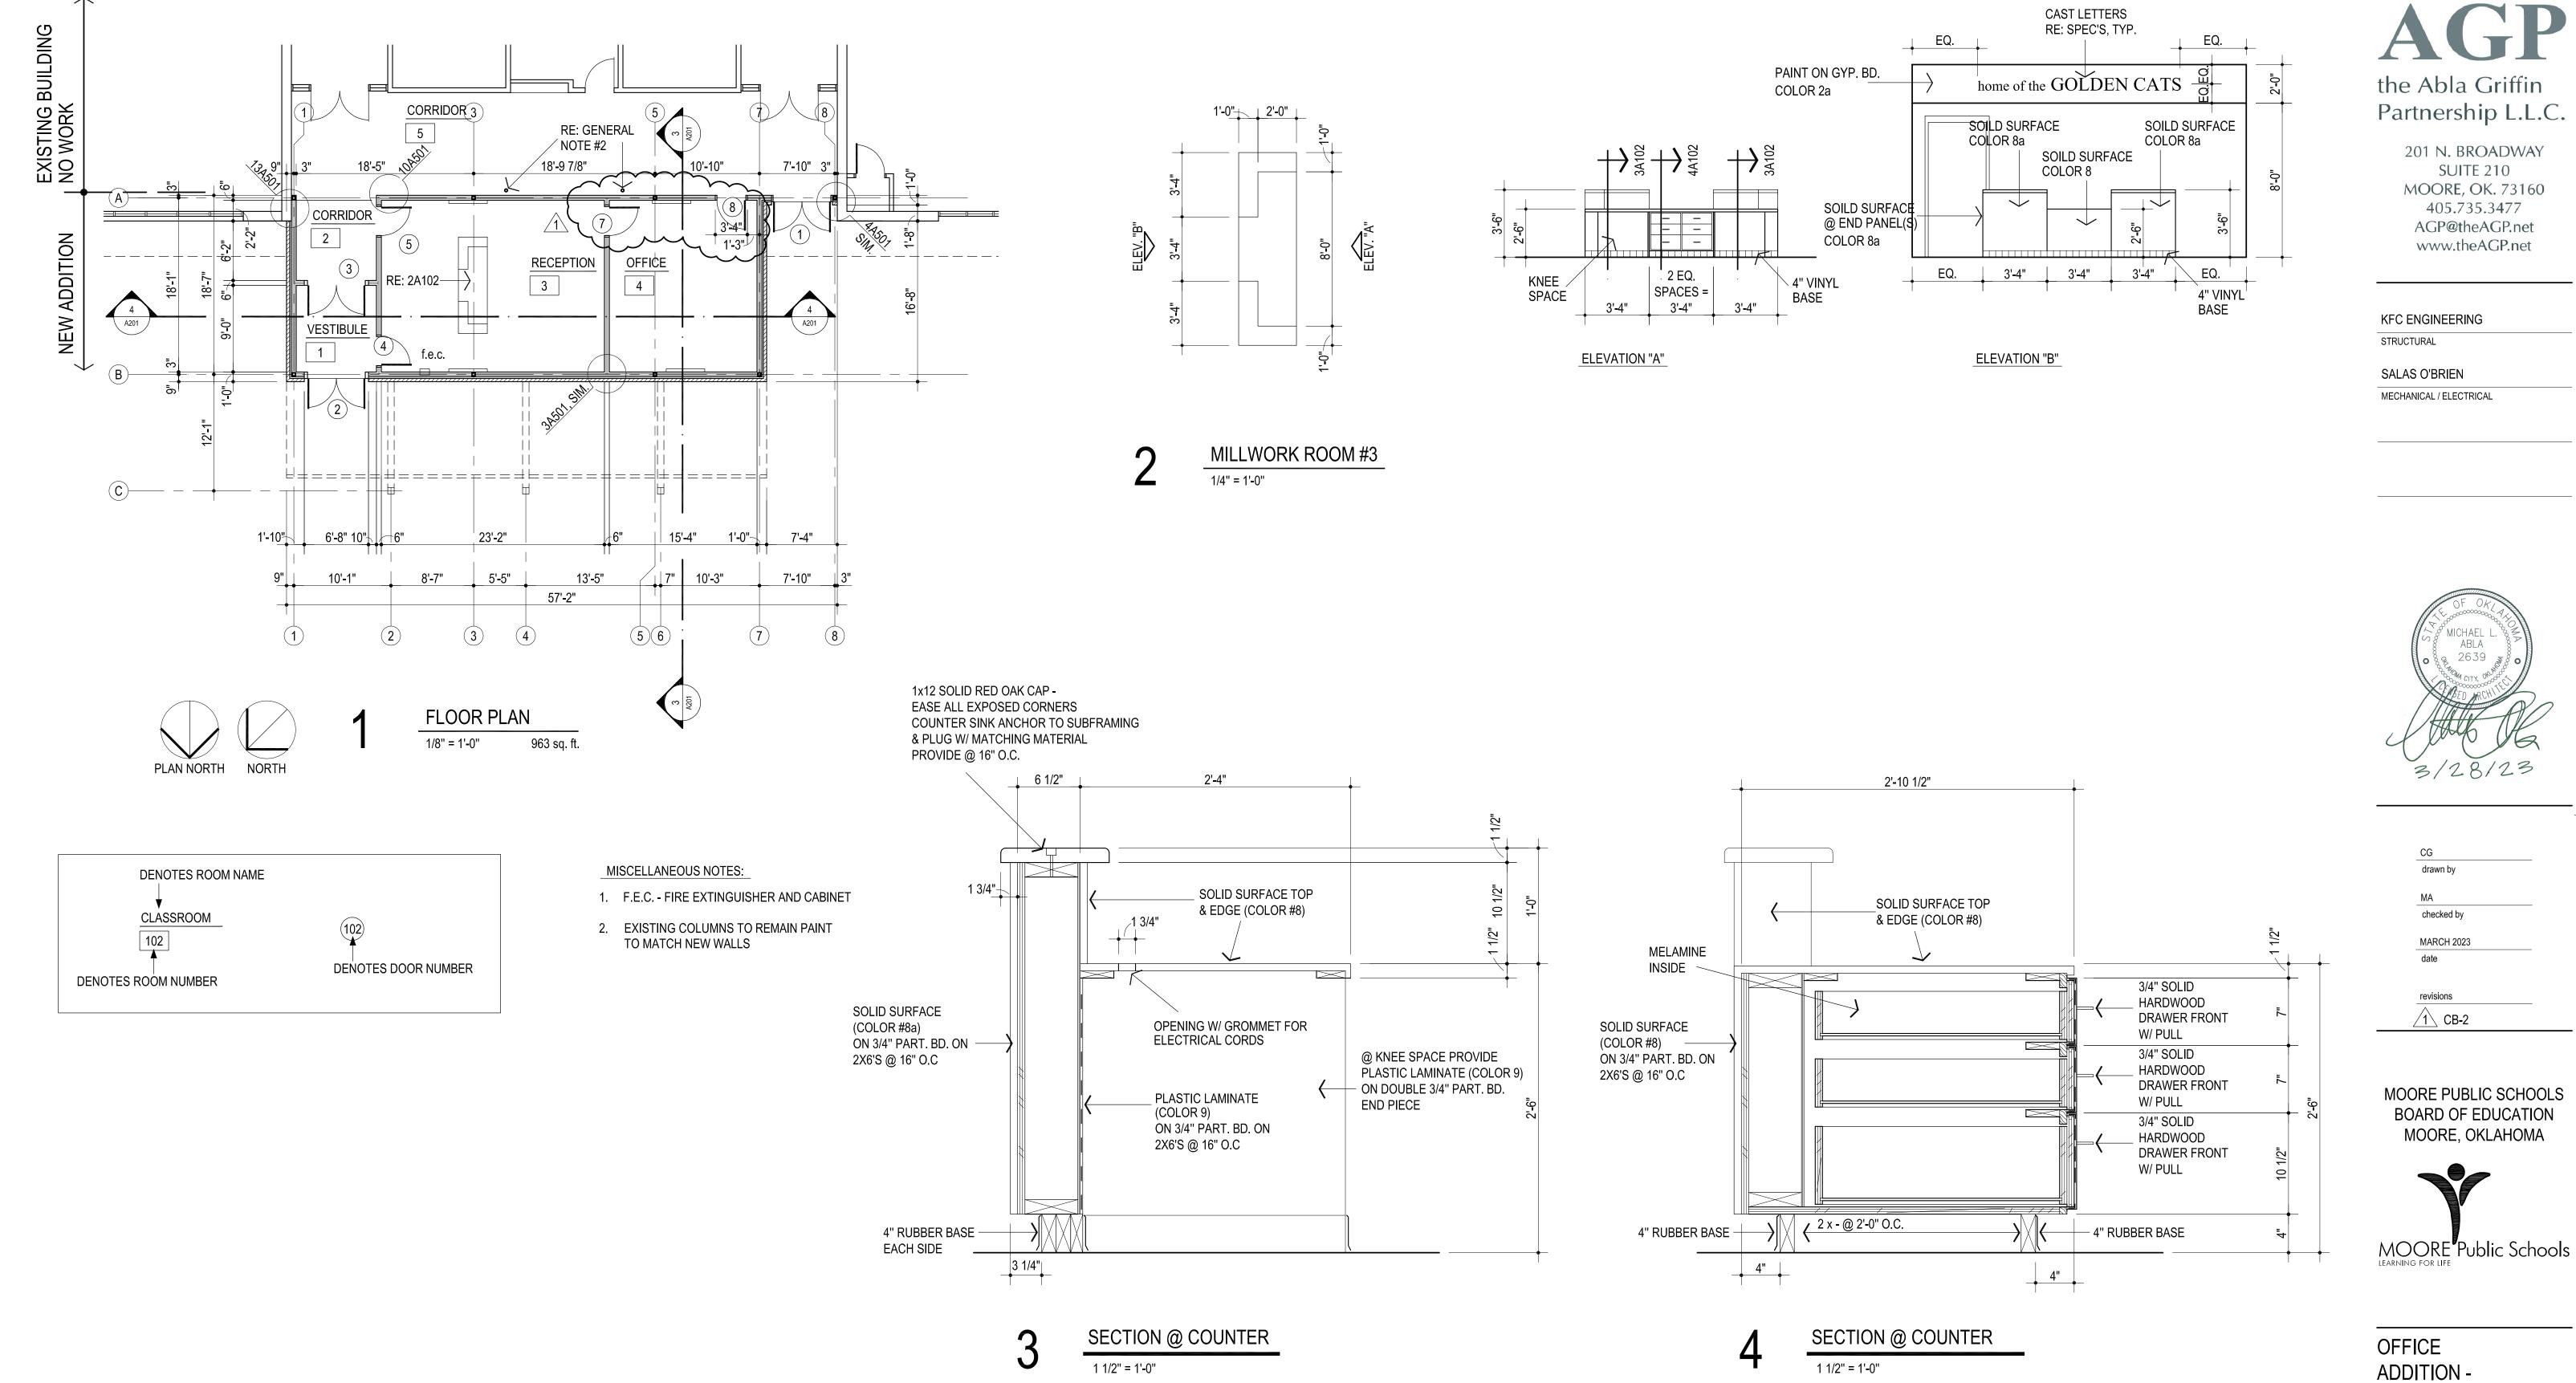



201 N. BROADWAY SUITE 210 MOORE, OK. 73160 405.735.3477 AGP@theAGP.net www.theAGP.net

SOUTHGATE ELEMENTARY SCHOOL

sheet no:



OWNERSHIP USE OF DOCUMENTS:

AGP EXPRESSLY RESERVES ITS COPYRIGHT AND OTHER PROPERTY RIGHTS OF ALL PLANS AND DRAWINGS DESIGNED AND/OR PRODUCED. PLANS AND DRAWINGS ARE NOT TO BE REPRODUCED IN ANY FORM OR MANNER WITHOUT THE EXPRESSED WRITTEN CONSENT OF AGP.

DESCRIPTI	ON	RM. NO.	FLOOR	BASE	CEILING	CLG. HT.	REMARKS	RM. NO. W	ALLS
			VINYL TILE CARPET TILE EXISTING VINYL TILE	) RUBBER NONE	2 X 2 ACOUT. LAY-IN (TEG) GYP. BOARD			CONCRETE MASONRY UNIT	
VESTIBULE CORRIDOR RECEPTION OFFICE CORRIDOR		1 2 3 4 5				9'-4" 10'-0" 10'-0"/9'-4"/ 9'-0" 8'-8" 10'-0"		1 • • • 2 • • 3 • 4 • 5 •	
	ROC	OM FII	NISH SCHE	DULE	SAME AS P	MATERIAL IN	SURFA	IAL ON ALL CES IAL ON EACH DUAL SURFACE	
	<ul> <li>WALLS -</li> <li>WALLS -</li> <li>WALLS -</li> <li>WALLS -</li> <li>WALLS -</li> <li>H.M. DOC</li> <li>MISCELL</li> </ul>	FIELD: S ACCENT ACCENT DRS & FF ANEOUS	HERWIN-WILLIA : SHERWIN-WILI : SHERWIN-WILI RAMES : SHERW S METALS / PAIN	N-WILLIAMS - SW700 MS - SW7008 - ALAB/ LIAMS - TO BE SELEC LIAMS - TO BE SELEC 'IN-WILLIAMS - SW69 TED EXTERIOR CAN CHITECTURAL WOOI	ASTER CTED BY ARCHITE CTED BY ARCHITE 92 - INKWELL OPIES: SHERWIN-	CT. WILLIAMS - SW	'6992 -INKWELL		
	<ul> <li>7 RUBBER W</li> <li>8 SOLID SUR</li> <li>8 SOLID SUR</li> <li>9 PLASTIC LA</li> <li>10 VINYL "T" E</li> <li>11 MELAMINE</li> <li>12 NUMBER N</li> <li>13 2 X 2 ACOL</li> <li>14 INTERIOR S</li> <li>15 MARKERB</li> <li>16 TACKBOAR</li> </ul>	LES: INT ALL BAS FACE (C FACE (C AMINATE DGING: TO BE S OT USEI ISTICAL SIGNAGE OARD: E D: BEST	GE: ROPPE - BLA COUNTERTOPS) COUNTERTOPS) COUNTERTOPS) E (FACING AND E - TO BE SELECT SELECTED FRO D LAY - IN TILES - E: MOHAWK SIG BEST-RITE- WH F-RITE CHALKBO	: CORIAN - DEEP CA : CORIAN - EVENING EDGING) : WILSONAR ED FROM MFR'S STA M MFR'S STANDARD TEGULAR EDGE : RE N SYSTEMS - TO BE	VIAR PRIMA / JUNIPER T - D315 - PLATINU ANDARD COLORS COLORS EFER SPECIFICATI SELECTED BY AR NTIQUE WHITE	JM IONS CHITECT	202		
	(19) MASONI	Shed Mi Ry Brich		TO BE VERIFIED WI IE BRICK : - TO BE VE					NG

LLS	PAINT / COLOR SCHEDULE	DOOR NO.	LOCATION	−l ⊠ ⊡	DOOR MAT'L		DOR SIZE		FRAME ELEV.	HEAD	DOOR D	ETAILS	JAMB	REMARKS	HDWR. SET NO.	
		1 2	5 EX	Т. A	H.M.	PR. 3'-0" PR. 3'-0"	7'-0"	1 3/4" 1 3/4"	B C		. 15A501	8A501, SIM 8A501			1 2	
	WALLS	3 4	2 1 1 3	B	_	PR. 3'-0" 3'-0"			C A	1A501, SIM 2A501	. 16A501	8A501, SIM 9A501		20 MIN DOOR & FRAME	3 4	
	CLG.         N         E         S         W         REMARKS           ①         ②a         ②a         ③a         ⑦ ①	5 6	2 3 NUMBER	B NOT USED	WD				$\uparrow$	2A501		9A501	9A501	20 MIN DOOR & FRAME NUMBER NOT USED	(4a)	
	$ \begin{array}{c ccccccccccccccccccccccccccccccccccc$	7 8	3 $4$ $5$ $4$	C ) C	WD WD	3'-0"	7'-0"	1 3/4"	A	2A501 2A501	_	9A501 9A501	9A501 9A501	20 MIN DOOR & FRAME	5 (5a)	
	$ \begin{array}{c ccccccccccccccccccccccccccccccccccc$															
T O IF	F CIRCLE IS BLACKENED - SURFACE TO RECEIVE PAINTER'S FINISH F CIRCLE IS BLANK - SURFACE OR MATERIAL IS PREFINISHED OR NOT PAINTED		3	DO	OR SC	HEDU	_E									
			G2 1. G3 1. G3 6.	/8" NOM. TI ISULATING /4" CLEAR /4" IMPACT LASS GLAZIN	rempere Resistai	D NT			5	<b>H</b>	1 15/16"	2" 2" 5 5 7 7 7 7 7 7 7 7 7 7 7 7 7			GLAZIN	5/8" G 2 3/4 G 2 3/4 F C 2 J 12/10 I 12/1
3			F <u>I</u>	. FLR.	1 HOL	DR. DIM. 3		7'-0" 4" 2"		@ IN <sup>-</sup>	) (T. ) T.	8:9" F.V.		6'-8" 4" DR. DIM. ■ 4" DR. DIM. G1 @ EXT. G2 @ INT. C ALUMINUM		
					(A G3) @ DF	" ق م ج. #1, 4 & 5 	- (G3		- - - - - - - - - - - - - -		С					




201 N. BROADWAY SUITE 210 MOORE, OK. 73160 405.735.3477 AGP@theAGP.net www.theAGP.net


KFC ENGINEERING

STRUCTURAL

SALAS O'BRIEN MECHANICAL / ELECTRICAL

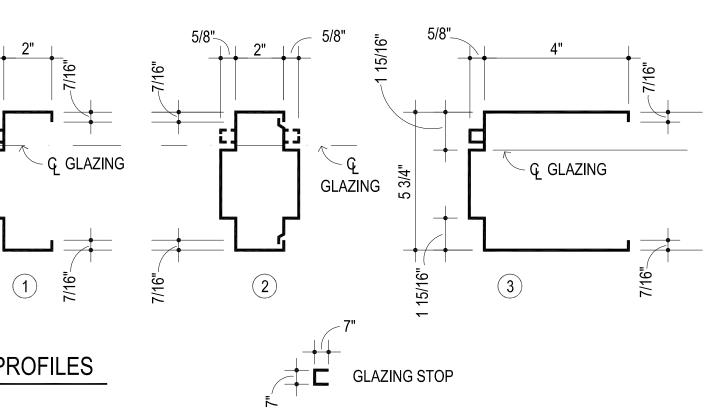



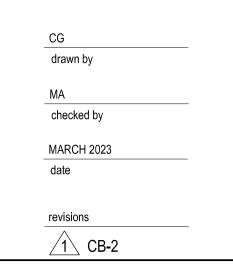


MOORE PUBLIC SCHOOLS BOARD OF EDUCATION MOORE, OKLAHOMA



OFFICE ADDITION -SOUTHGATE ELEMENTARY SCHOOL

-----

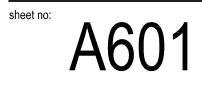

OWNERSHIP USE OF DOCUMENTS:

AGP EXPRESSLY RESERVES ITS COPYRIGHT AND OTHER PROPERTY RIGHTS OF ALL PLANS AND DRAWINGS DESIGNED AND/OR PRODUCED. PLANS AND DRAWINGS ARE NOT TO BE REPRODUCED IN ANY FORM OR MANNER WITHOUT THE EXPRESSED WRITTEN CONSENT OF AGP.

