

1/28/26

CG
drawn by
MA
checked by
JANUARY 2026
date

revisions
1 ADDENDUM #1
2 ADDENDUM #2



WAYLAND BONDS
2025 HVAC


sheet no:

C100


COOLING TOWER PLAN

OWNERSHIP USE OF DOCUMENTS:


AGP EXPRESSLY RESERVES ITS
COPYRIGHT AND OTHER PROPERTY
RIGHTS OF ALL PLANS AND DRAWINGS
DESIGNED AND/OR PRODUCED. PLANS
AND DRAWINGS ARE NOT TO BE
REPRODUCED IN ANY FORM OR MANNER
WITHOUT THE EXPRESSED WRITTEN
CONSENT OF AGP.

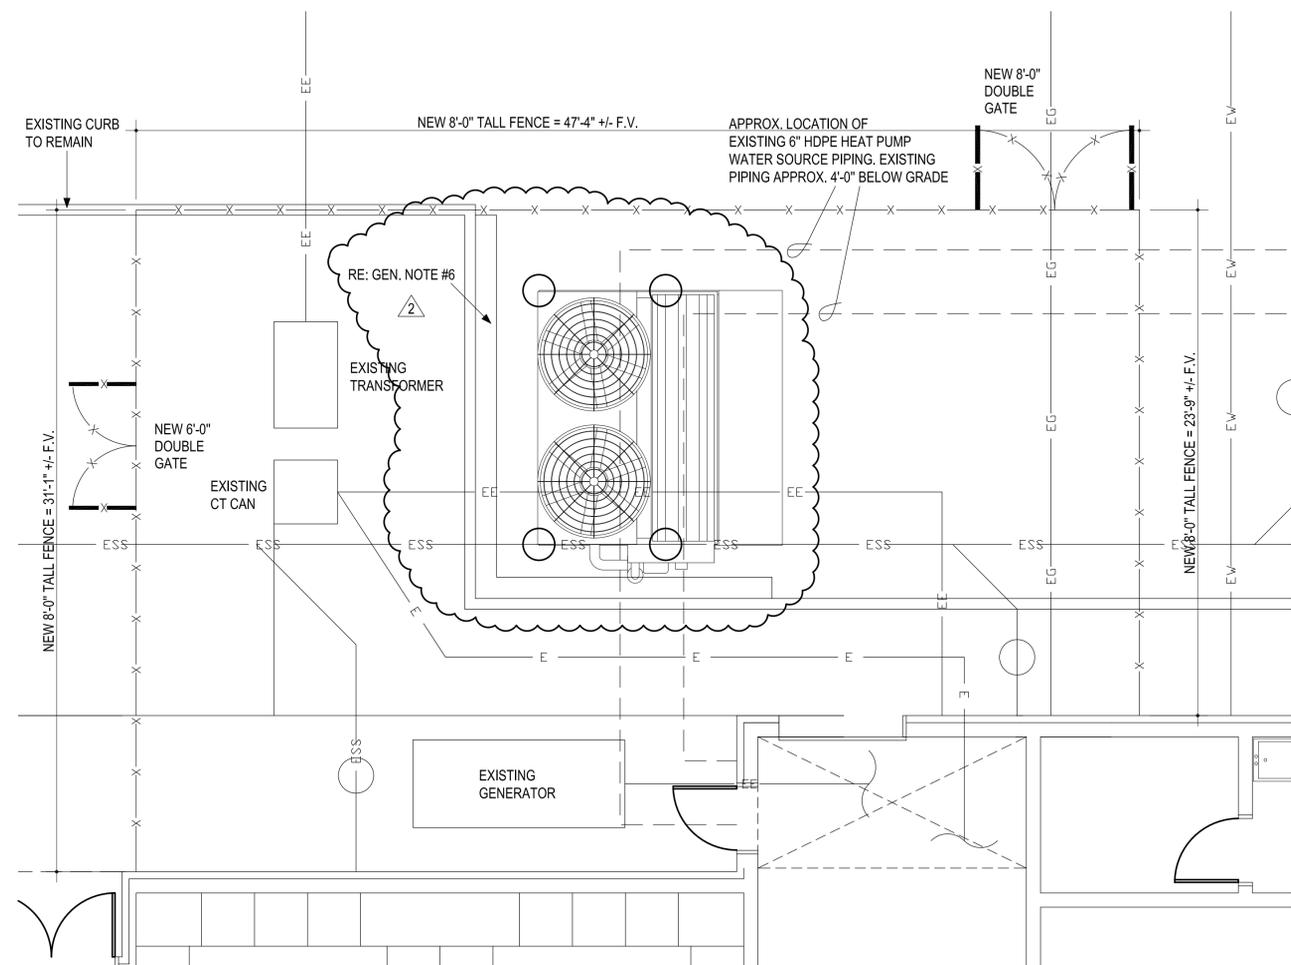

2 FENCE PLAN
1/4" = 1'-0"

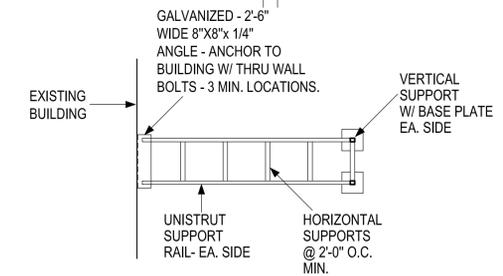


PIPE SUPPORT PLAN
1/4" = 1'-0"

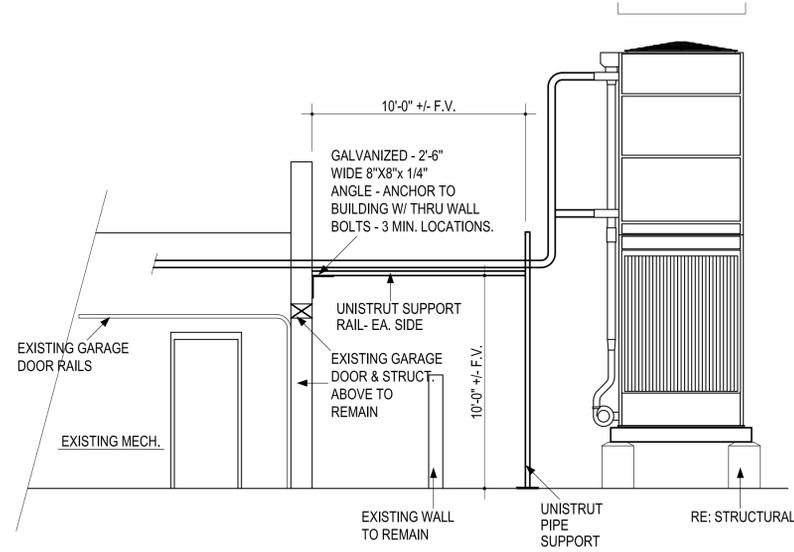

GENERAL NOTES:

- CORE DRILL EXISTING CMU / VENEER WALL AS REQUIRED. VERIFY HEIGHT AND CLEARANCE REQUIRED FOR A COMPLETE INSTALLATION. SEAL AND INSULATE TO WATERTIGHT.
- ATTACH UNISTRUT SUPPORT TO WALL ANGLE
- ALL UNISTRUT MATERIALS TO BE 12 GAUGE PRE-GALVANIZED

3 PIPE SUPPORT ELEVATION
1/4" = 1'-0"

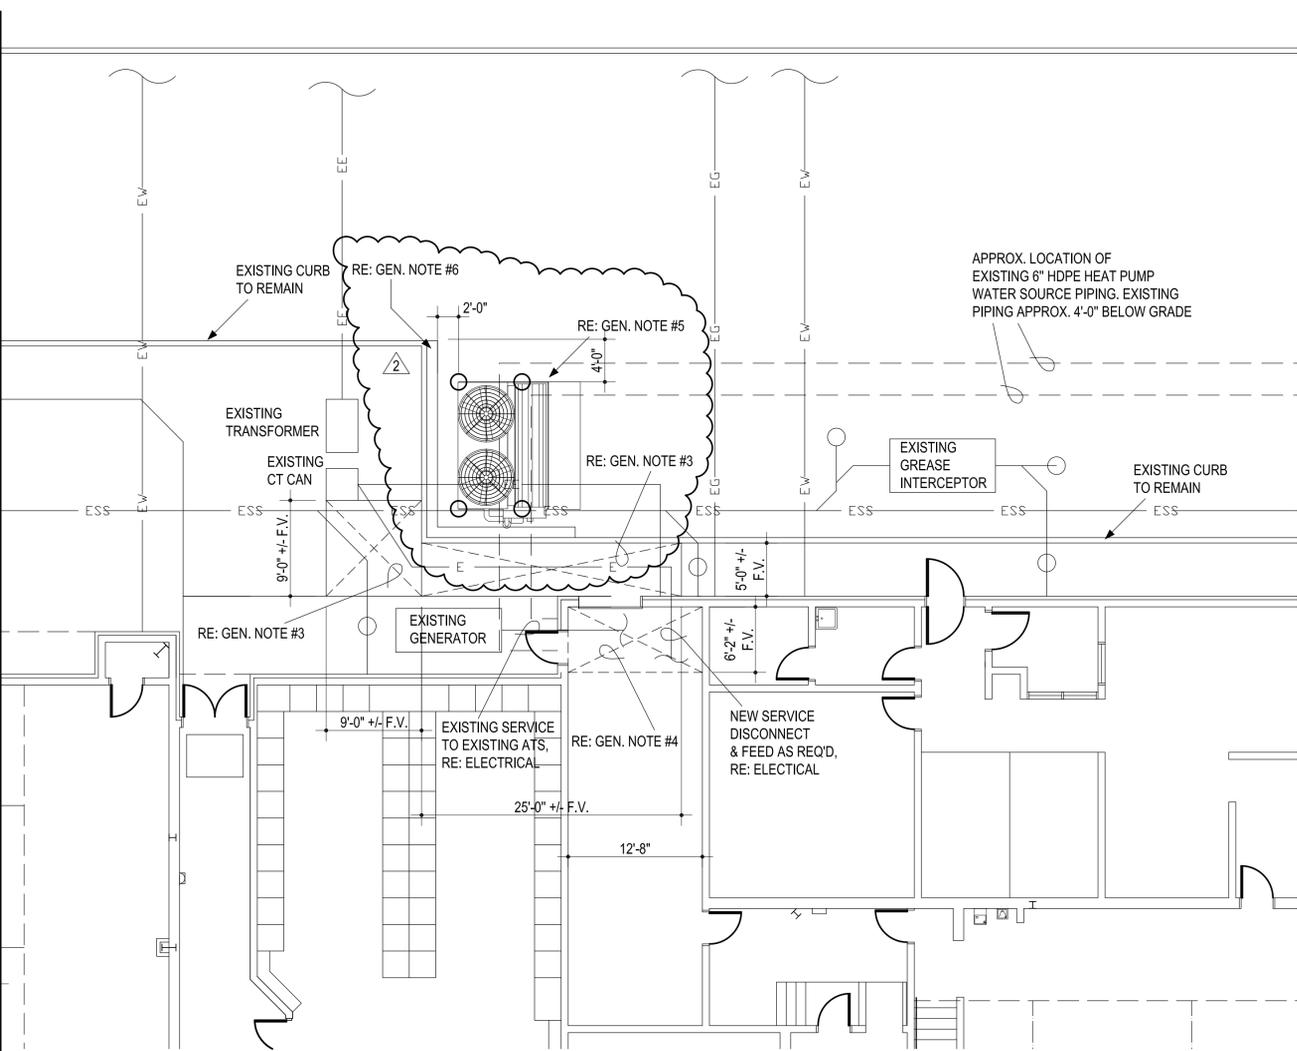

1 COOLING TOWER PLAN
1/8" = 1'-0"

GENERAL NOTES:

- EXISTING UNDERGROUND UTILITY LOCATIONS HAVE BEEN OBTAINED FROM THE BEST AVAILABLE SOURCES. THE CONTRACTOR SHALL FIELD VERIFY ALL EXISTING CONDITIONS PRIOR TO COMMENCING WORK & COORDINATE W/ ARCHITECT.
- LOCATE & PROTECT EXISTING UNDERGROUND UTILITIES TO REMAIN.
- DEMO EXISTING SIDEWALK AS INDICATED. PROVIDE NEW CONC. SIDEWALK AS REQ'D - MATCH EXISTING
- DEMO EXISTING SLAB AS INDICATED. PROVIDE NEW CONC. SLAB AS REQ'D - MATCH EXISTING
- NEW COOLING TOWER RE: STRUCTURAL FOR NEW FOUNDATION. RE: MECHANICAL & ELECTRICAL. ADJUST LOCATION AS REQUIRED DUE TO EXISTING UTILITIES. COORDINATE WITH ARCHITECT.
- DEMO EXISTING SCREEN WALL AND FOOTING. PROVIDE NEW CONC. CURB & SIDEWALK MATCH EXISTING. COORDINATE WITH ARCHITECT. COMPACT & FILL AS REQUIRED.

LEGEND :

- ESS — EXISTING SANITARY SEWER
- EW — EXISTING WATERLINE
- EE — EXISTING ELECTRICAL SERVICE
- EG — EXISTING GAS LINE
- E — NEW ELECTRICAL



Wayland Bonds Elementary Fencing

14025 S. May Ave.
Oklahoma City, OK 73170

Legend

FENCE AREA

Google Earth

Image Landsat / Copernicus



100 ft

